

PERMIT

SEWAGE DISPOSAL SYSTEM

MARYLAND STATE DEPARTMENT OF HEALTH*

HOWARD COUNTY

ELLICOTT CITY

DISTRICT 1st

DATE 12/12/78

INDEXED

Pat Lendrim

IS PERMITTED TO INSTALL X ALTER

ADDRESS

PHONE

SUBDIVISION

ROAD 6548 Montgomery Road LOT 2

PROPERTY OWNER Peter Bakunas

ADDRESS 4417 Manorview Road, Balto., Md. 21229

SPECIFICATIONS 3 bedrooms

SEPTIC TANK CAPACITY 1000 GALLONS

DRAIN FIELD DEPTH FEET, BOTTOM AREA SQ. FT.

DEEP TRENCH DEPTH FEET, BOTTOM AREA SQ. FT.

SEEPAGE PITS ABSORBENT SIDE-WALL AREA 200 SQ. FT. total area in dry well.

INLET PIPE 2 FT. BELOW ORIGINAL GRADE. MAXIMUM DEPTH 7 FT. BELOW ORIGINAL GRADE

EFFECTIVE DEPTH AT FT. BELOW ORIGINAL GRADE.

LOCATE DISPOSAL AREA 110 FT. FROM front LOT LINE AND 20 FT. FROM left LOT LINE AS SEEN WHEN
FACING LOT FROM Montgomery Road.

DITCH-200 sq. ft. sidewall area on one side. Ditch to be 7½ ft. deep with 5 ft. of
stone and 40 ft. long. Run ditch off dry well along level ground.

PLANS APPROVED BY Raymond Hodges

DATE 9/15/78

COVER NO WORK UNTIL INSPECTED AND APPROVED.

NEITHER THE HOWARD COUNTY COUNCIL NOR THE HEALTH DEPARTMENT IS RESPONSIBLE FOR THE SUCCESSFUL OPERATION OF ANY SYSTEM.

NOTE: IF TRENCH IS USED CALL FOR INSPECTION BEFORE PLACING GRAVEL IN TRENCH.

NOTE: NO DRY WELL SHALL EXCEED 15 FOOT IN DIAMETER.

NOTE: ALL PIPE FROM HOUSE TO DISPOSAL AREA MUST BE CAST IRON.

PERMIT VOID AFTER THREE YEARS.

NOTE: INSTALL STAND PIPE ON SEPTIC TANK AND DRY WELL. STAND PIPES MUST BE 6 INCHES IN DIAMETER. CAST IRON, CONCRETE OR TERRA
COTTA ACCEPTED.

*INSTALLER IS RESPONSIBLE FOR OBTAINING FINAL APPROVAL ON THIS PERMIT.


01-188534

P 29331

A 25421

PERMIT SIGNED
AND RETURNED 9/22/80
Serial # 72893
addition

A 25421

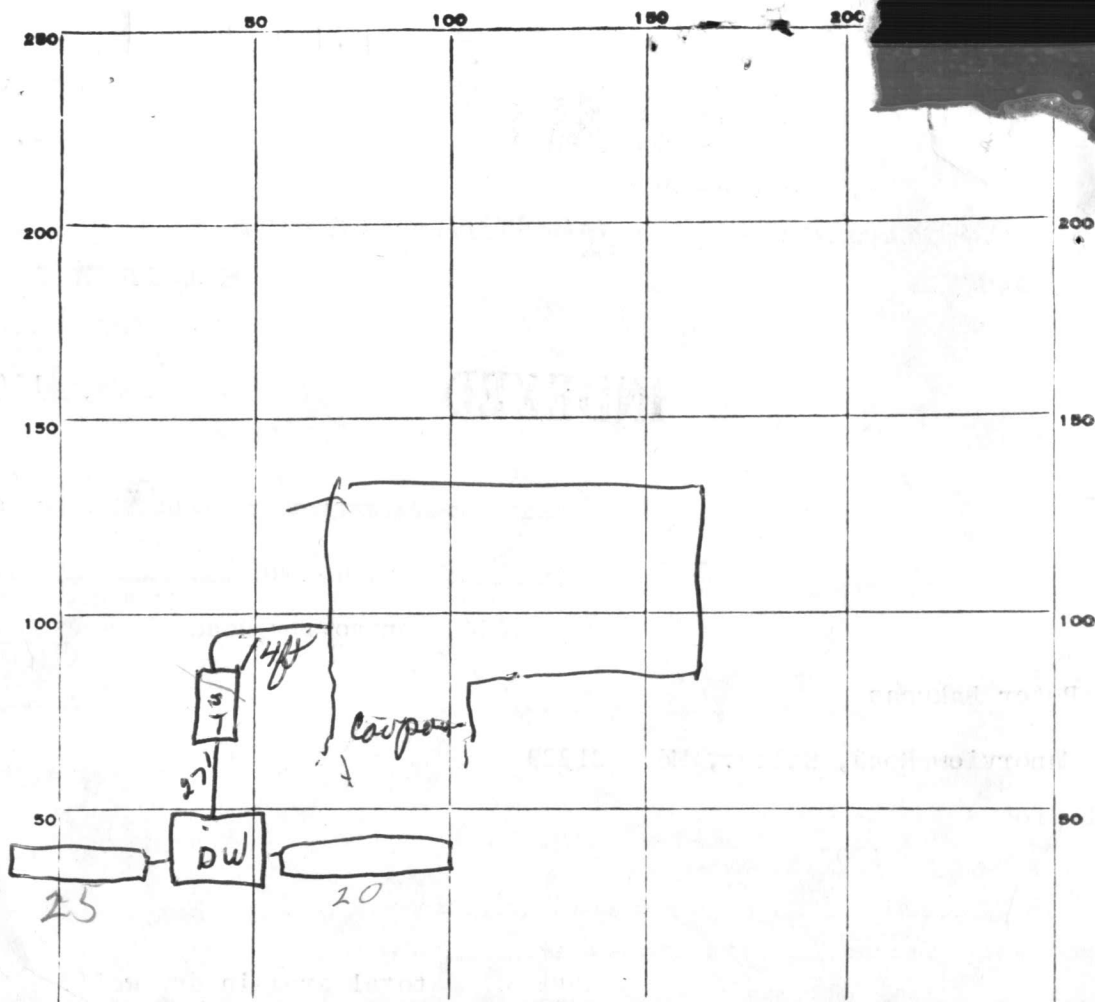

INDICATE NORTH. - NAME ADJOINING ROADWAY AS BASE LINE.

Montgomery Rd

PERMIT CARD NP

SEPTIC TANK, LEVEL _____

CLEANOUTS _____

DISTRIBUTION BOX, LEVEL _____

TILE FIELD, DEPTH 9 FT. TRENCH WIDTH 2-5 FT.

GRAVEL DEPTH ? IN. TOTAL LENGTH 45 FT.

NUMBER OF TRENCHES 2 TOTAL BOTTOM AREA _____

SEEPAGE PITS, INSIDE DIAMETER PERIMETER 40 FT. DEPTH BELOW INLET 5 FT.

ABSORBENT AREA 200 SQ. FT.

REMARKS 12/24/78 OK to gravel in trenches OK to cover from tank to DW

1/3/79 DW INLET 3 FT BELOW GRADE

DATE SYSTEM APPROVED

1/3/79

INSPECTOR

Raymond Hodges

APPLICATION

SEWAGE DISPOSAL TESTING

STATE OF MARYLAND - DEPARTMENT OF HEALTH AND MENTAL HYGIENE

HOWARD COUNTY HEALTH DEPARTMENT
ENVIRONMENTAL HEALTH SERVICES

P. O. BOX 476, ELLICOTT CITY, MARYLAND 21043
TELEPHONE: 465-5000, EXT. 356

DISTRICT 1st

DATE 3/17/77

3/29/77
6 ft
3/29/77
9:30 am
1st
DRY WELL 200 SFT SIDEWALL AREA BELOW INLET
DRY WELL INLET TO BE 2 FT DEEP AND
11 FT DEEP
DITCH - 200 SFT SIDEWALL AREA ON ONE SIDE
DITCH TO BE 1/2 FT DEEP WITH 5 FT OF STONE
AND 40 FT LONG RUN DITCH OFF DRY
WELL, ALONG LEVEL GROUND

TO: THE COUNTY HEALTH OFFICER
ELLICOTT CITY, MARYLAND

I, HEREBY, APPLY FOR THE NECESSARY TEST IN ORDER TO CONSTRUCT (OR RECONSTRUCT) A SEWAGE DISPOSAL SYSTEM.

PLACE THE DRY WELL 110 FT
FROM THE FRONT LOT LINE
AND 20 FT FROM THE
LEFT SIDE OF THE
LOT AS SEEN WHEN
FACING THE LOT FROM MONTGOMERY RD
Peter Bakunas
PROPERTY OWNER HELEN A. O'CONNOR
ADDRESS 4417 Marrowee Road
6540 MONTGOMERY RD
Balt., Md. 21229
PROPERTY LOCATION:

SUBDIVISION Property of Helen A. O'Connor **LOT NO.** Lot #2

ROAD AND DESCRIPTION 6540 MONTGOMERY RD ABOVE FOR 3 BR

ELKRIDGE MD 21227

SIZE OF LOT 1/2 acre + **TYPE BLDG.** 3 bedrooms
RESIDENTIAL
NUMBER OF BEDROOMS

IF NOT SINGLE RESIDENCE DESCRIBE _____

THE SYSTEM INSTALLED UNDER THIS APPLICATION IS ACCEPTABLE ONLY UNTIL PUBLIC FACILITIES BECOME AVAILABLE.

SIGNATURE OF APPLICANT Helen A. O'Connor **BLDG. PERMIT SIGNED**
AND RETURNED 9/15/78
Serial No. 36862

APPROVED BY Raymond Hodge **FOR** Dry Well **DATE** 2 AUG 77
(KIND OF SYSTEM)

REJECTED BY _____ **FOR** _____ **DATE** _____
(KIND OF SYSTEM)

HOLD PENDING FURTHER TESTS _____ **DATE** _____

REASONS FOR REJECTION OR HOLDING 3/30/77 - Held for Review With IM

Per OK Out System First and Plat needs more work Plat should
show the lot & Residue Lot both RH. 4/11/77 TOLD T. O'CONNOR
THAT PERC IS OK 5/2/77 Plat looks OK (Final)
8/2/77 Final Plat OK by RH

THIS IS NOT A PERMIT

See
Reaches
Plot

INDICATE NORTH. - NAME ADJOINING ROADWAY AS BASE LINE.

DATE	TEST NO.	DEPTH	PRE-WET		TEST - 1" DROP		TIME
			START	STOP	START	STOP	
3/29/77	1S	5 1/2	1038	1038 1/2	1038 1/2	1039	1/2
	2S	4	1057	1057 1/2	1057 1/2	1058	1/2
	3S	3	1104	1104 1/2	1104 1/2	1105	1/2
3/29/77	4S	3 1/2	1108	1120	little perc		
	4M	5	1124	1124 1/2	1124 1/2	1125	1/2
	5S	5	1133	1133 1/2	1133 1/2	1134	1/2
	5D	12	ALL SAND				
	6V	11.5	water trickle @ 8 ft possibly due to				
	4		road see note *				
	TV	12 1/2	SANDY		CLAY BOTTOM		

LOWEST

LOW

HIGH

REMARKS

TYPE OF SOIL

TESTED BY R. HODGES & R. BIGGS

ALSO PRESENT: TOM O'CONNOR
MR BAKER

NOTE LEFT OVER LOT ON

*
BANK
ROAD
clay at
11.5

Present Address:
Mr Peter Bakunas
4417 Manorview Rd.
Baltimore Md. 21229


Building address:
6548 Montgomery Rd
Elkridge Md. 21227

Phone: 685 5423

I certify the above
measurements and
elevations are actual
and correct for this
Property

Thomas Rayne

OK
sum
9/14/78
D.

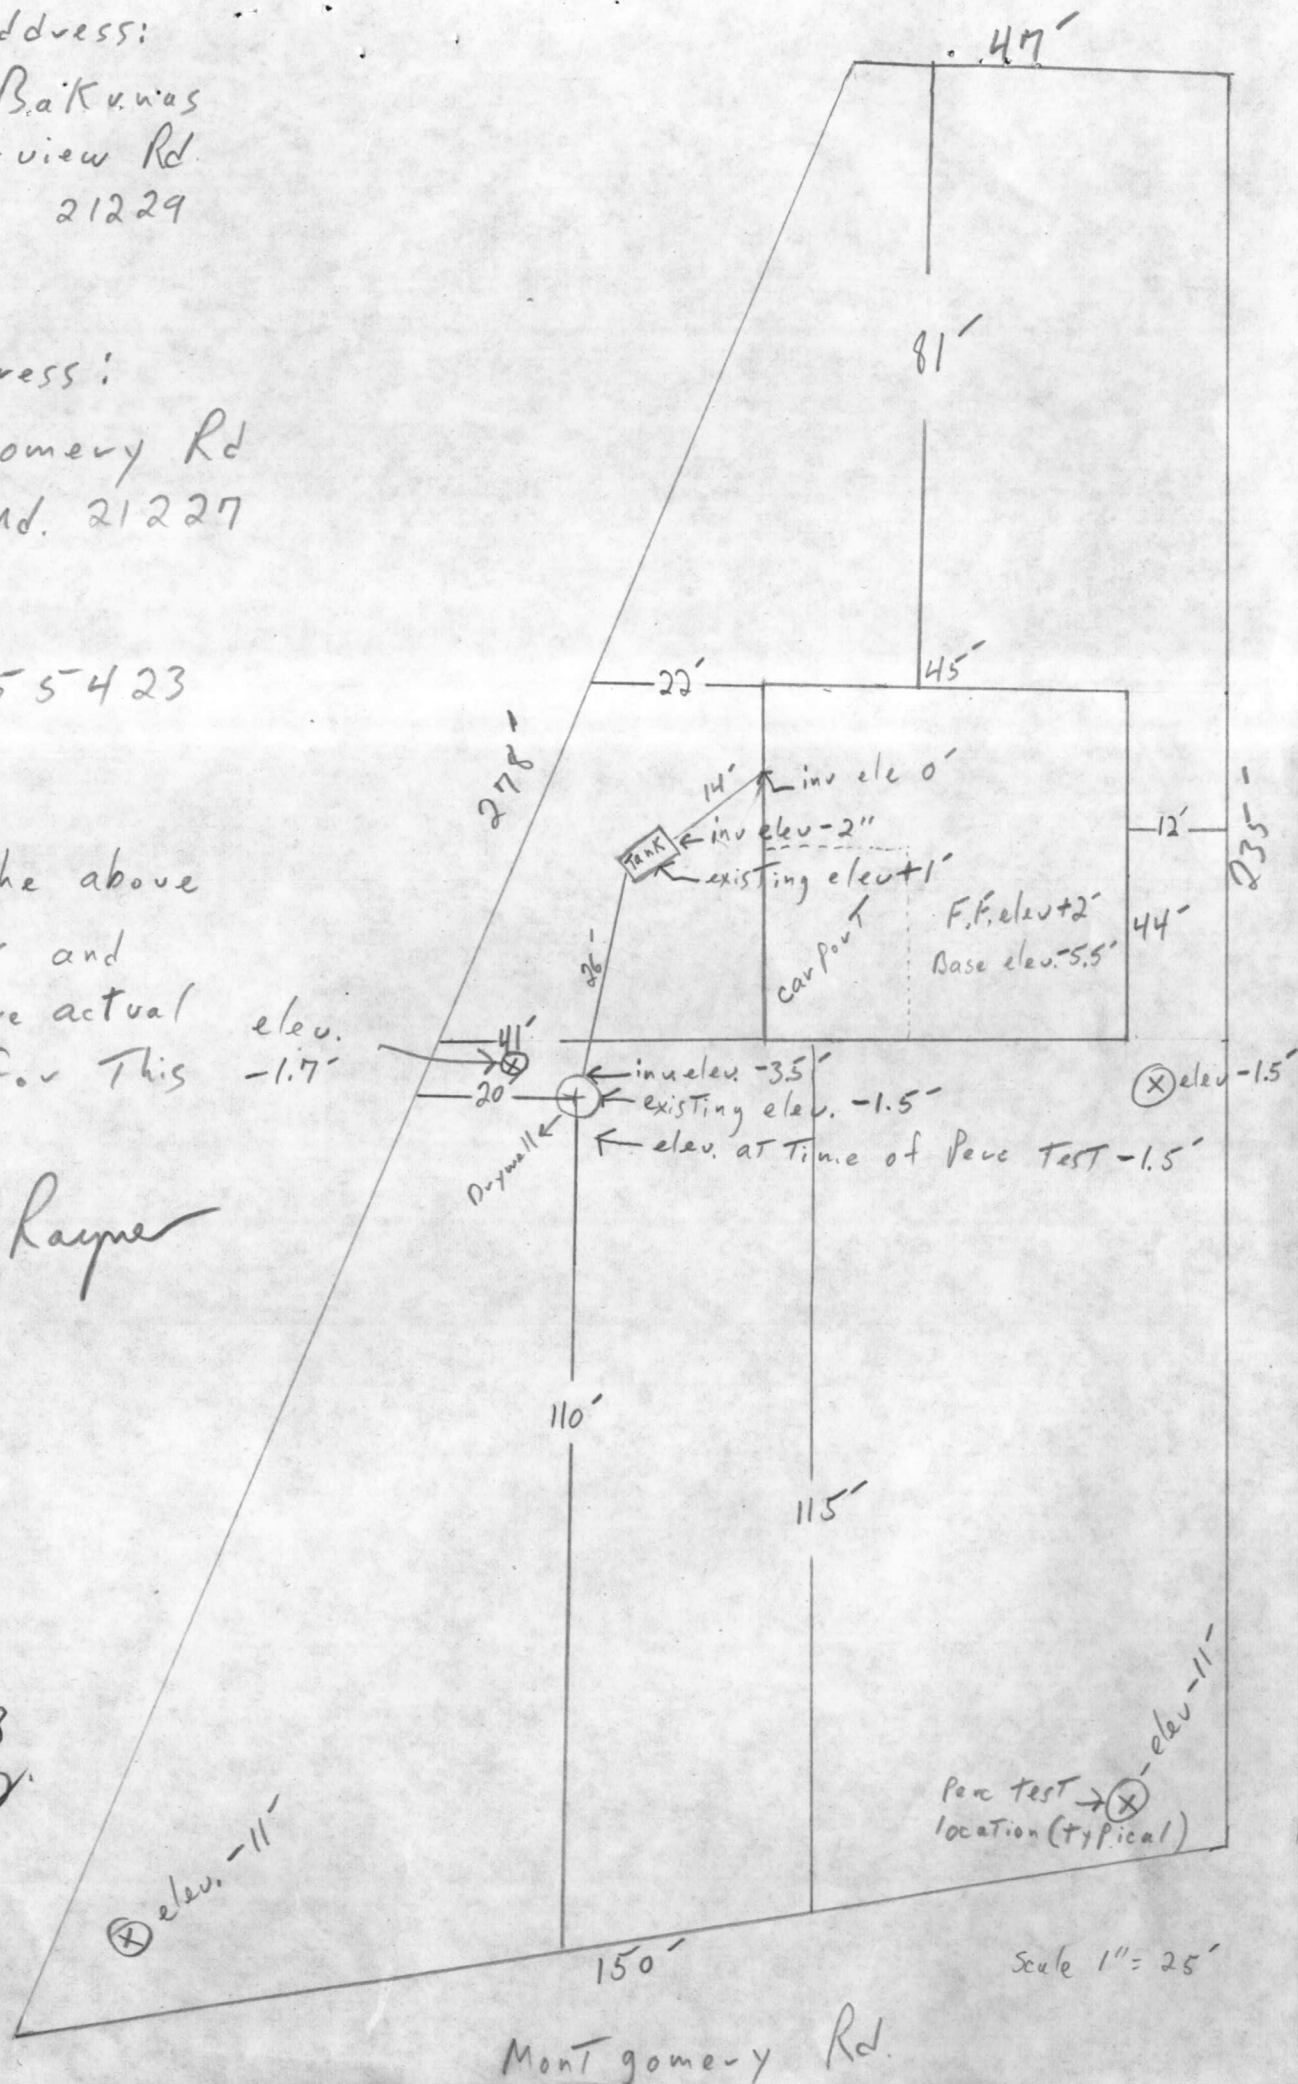

Helen A O'Connor
Montgomery, Pa

Re 8/16/78 - Reject Plans

① Plans do not show whether the lot or adjacent lots have wells or city water (I think they have city water)

② Plans Do not show the ditch running off the DW
Plans Call for a ditch off DW

③ The septic system for this lot must be installed before Bldg Permit issued
1/16/78

Called RAYNER 685 5423

& left message to call PH
Baltimore 685 5423

8/17/78 - Discussed Plans with Rayner He is will to do correct plans but wants to start house before septic system must check with DM before exception made so that house can be started before septic system
see other side

8/17/78 Discussed With DM
& FF

OK TO start house
w/ before Septer Syster
installed but
House must be moved
& New Plat submitted
House must be at least
50 FT from Back Line
per zoning requirements
called Rayner

8/30/78 OK Revised plan

RA met with Rayner at building
site & measured House
& Septer system location

9/5/78 - Ed Burkus met at
office & discussed moving
D.R.Y WELL & House
Closer to Front lot line
I said on this lot that
that was impossible
& House must be 25 ft
from Sewage Disposal Area
& Higher than that area


9/1/78 DM said OK to move house
20 FT down Hill BUT NEW PLANS

STEPHEN PROVENZA
344/562


Dedicated To
 County, Maryland
 Use Of Public Road
 978#

MONTGOMERY ROAD

Grid North

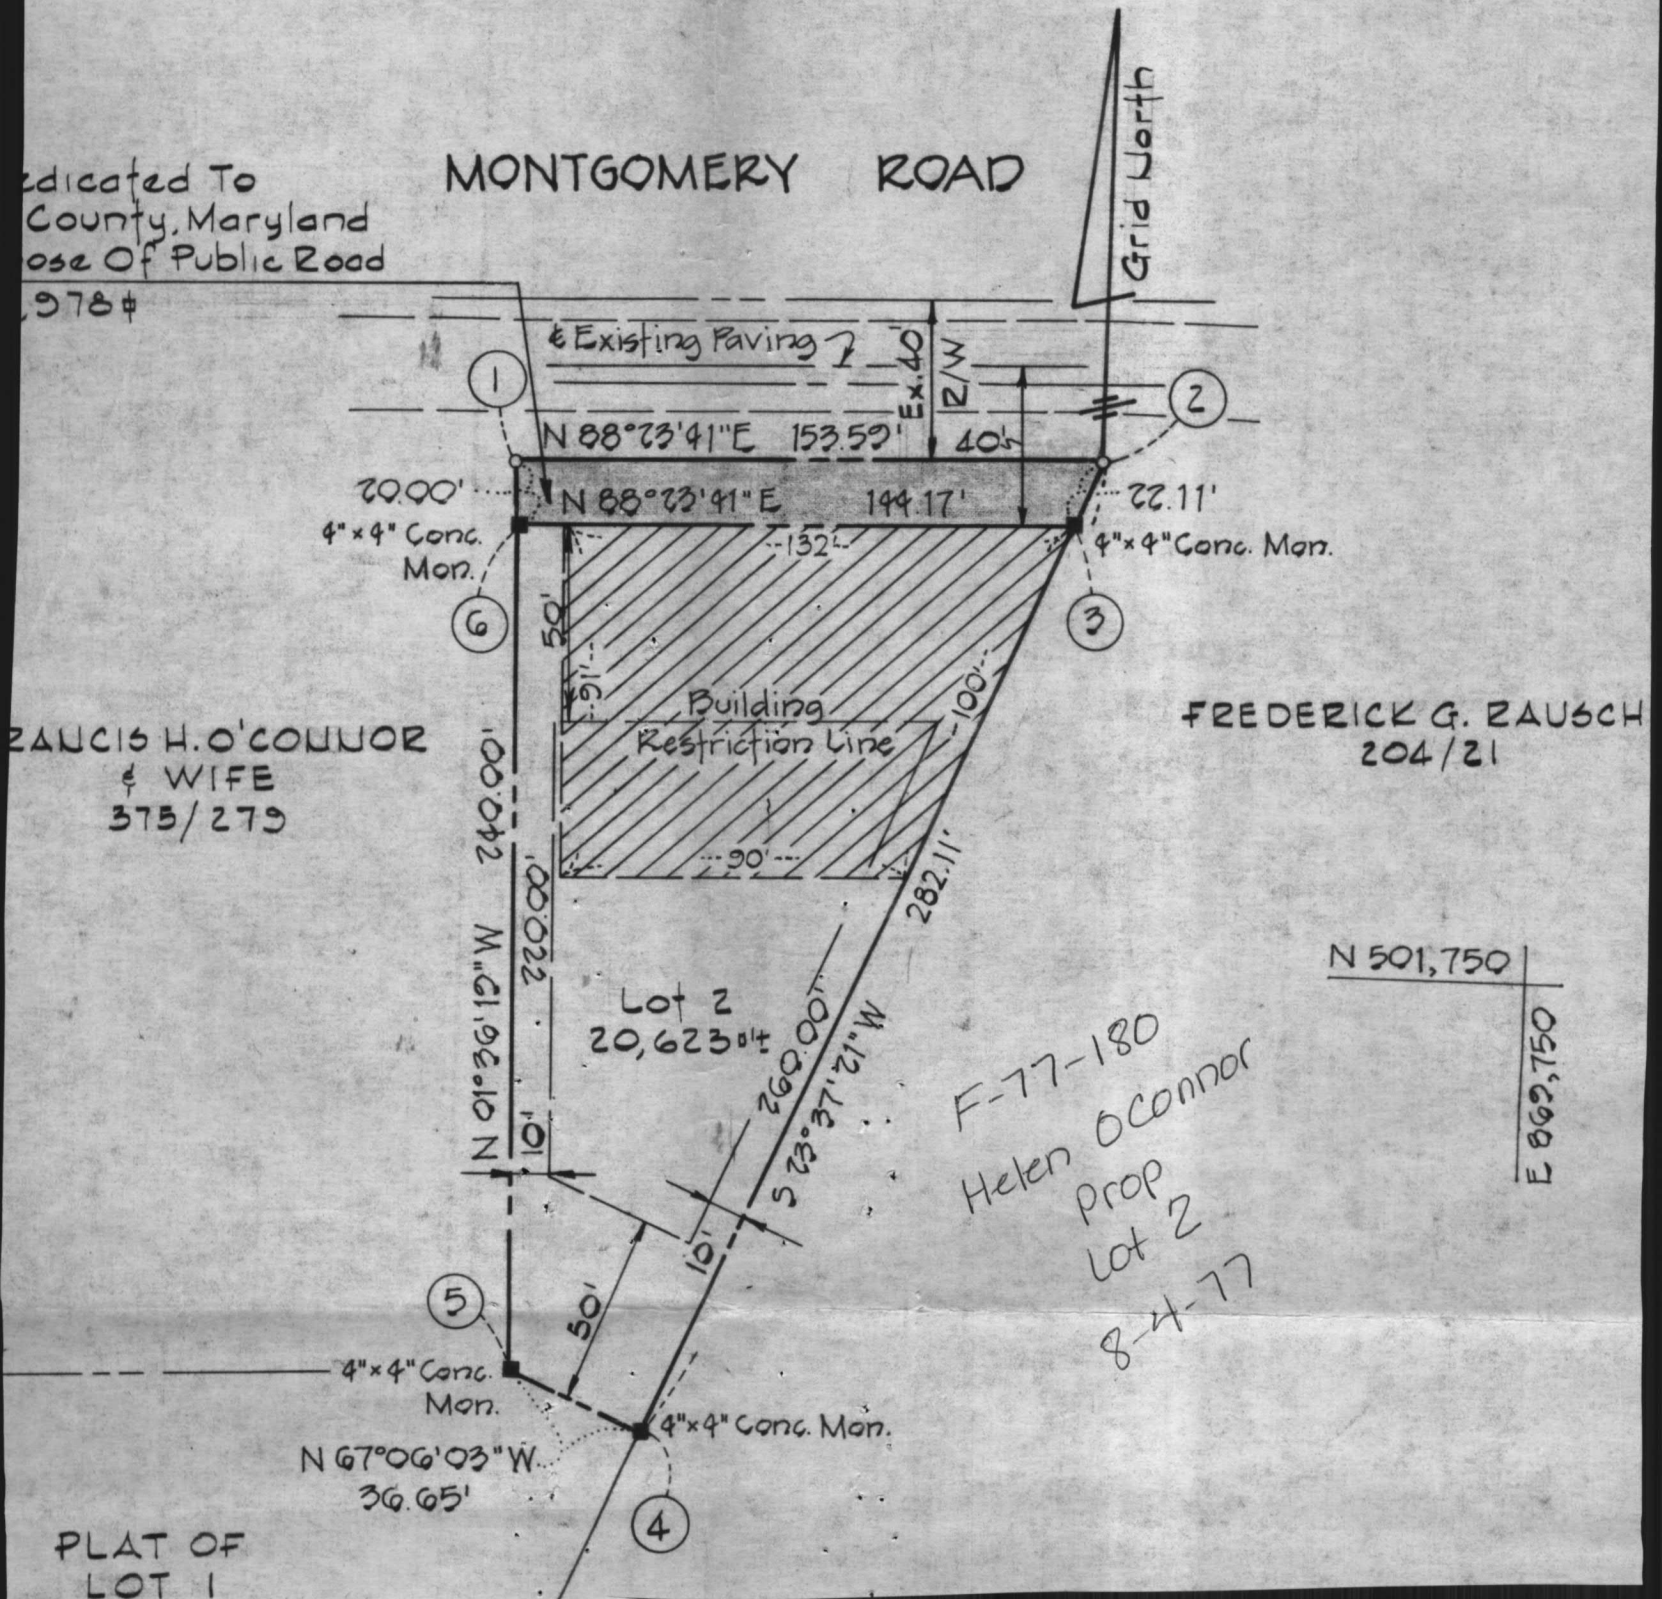

MONTGOMERY ROAD
(MD. ROUTE 103)

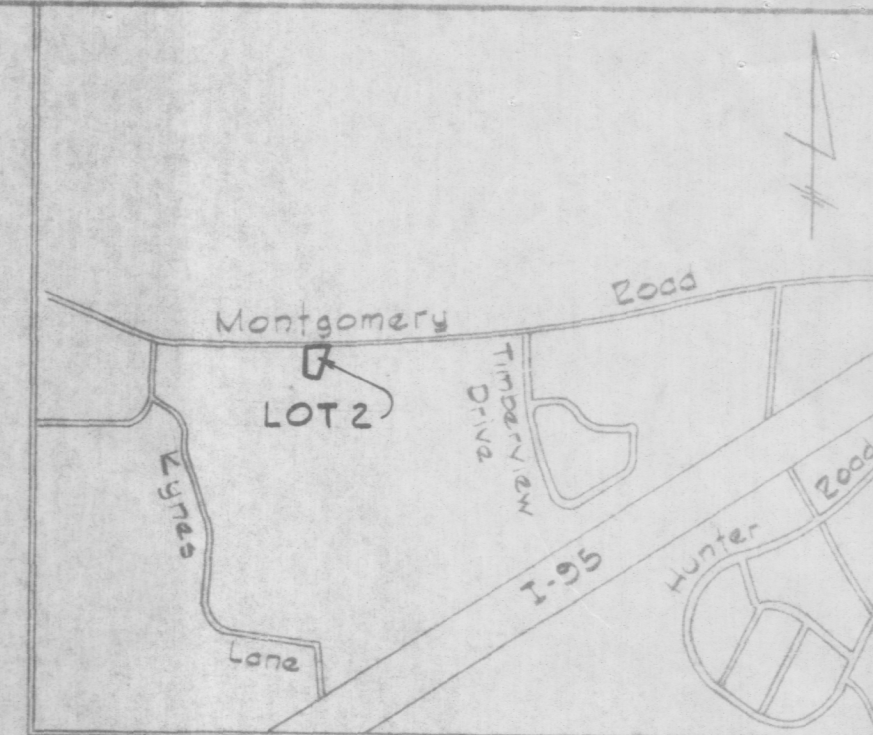

NOTES: 1. Public Water to be used for development of this lot.

2. The lot shown hereon complies with minimum ownership width and lot area as required by the Maryland State Department of Health and Mental Hygiene.

3. Grades shown hereon do not exceed 25%.

Date 4/77

LOT 2
PROPERTY OF
HELEN A.
O'CONNOR

1ST ELECTION DISTRICT
HOWARD COUNTY, MD.
SCALE: 1"=50' FEB. 10, 1977

MONTGOMERY RD

To Route 1 →

PAVING

N 88° 23' 41" E 155.59

WIDENING LINE

MIN Bldg LINE

No. 6546

LOT 1

9/14/86

SS LOCATED
NO EVIDENCE OF FAILURE
ADDITION HAS NO IMPACT
RECOMMEND APPROVAL

S. Adel

WE HAVE SURVEYED THE LOT SHOWN ON
THIS PLAN AND THE HOUSE IS LOCATED
AS SHOWN

Russell M. Newhart
SURVEYOR

1st CMP No 3764

DEED 375/279

SCALE 1" = 50'

TAX MAP 37
BLOCK 6

OCTOBER 17, 1978

LOCATION SURVEY
6548 MONTGOMERY RD.
HOWARD CO., MD.
DISTRICT No. 1



EDWARD V. COONAN & CO
CIVIL ENGINEERS & SURVEYORS
1209 E 36TH ST
BALTIMORE - MARYLAND
21218

E-5252