

# PERMIT

SEWAGE DISPOSAL SYSTEM

MARYLAND STATE DEPARTMENT OF HEALTH\*

HOWARD COUNTY

ELLICOTT CITY

DISTRICT 5th

DATE 6/16/81

Jack Fyock

IS PERMITTED TO INSTALL ☒ ALTER

ADDRESS 13775 Triadelphia Rd, Glenelg, Md. 21737

PHONE 988-9270

SUBDIVISION Simpson Woods

ROAD 7250 Meadow Wood Way LOT 5 Sec. 2

PROPERTY OWNER Joseph E. & Elizabeth Shimek

ADDRESS 7904 Arbroath Court, Clinton, Md. 20735

SPECIFICATIONS 3 Bedrooms

(Total absorbant area in dry well 375ft.)

SEPTIC TANK CAPACITY 1000 GALLONS

DRAIN FIELD \_\_\_\_\_ DEPTH \_\_\_\_\_ FEET, BOTTOM AREA \_\_\_\_\_ SQ. FT.

DEEP TRENCH \_\_\_\_\_ DEPTH \_\_\_\_\_ FEET, BOTTOM AREA \_\_\_\_\_ SQ. FT.

SEEPAGE PITS ☒ ABSORBENT SIDE-WALL AREA 125 SQ. FT. per bedroom

INLET PIPE 3 FT. BELOW ORIGINAL GRADE. MAXIMUM DEPTH 11 FT. BELOW ORIGINAL GRADE

EFFECTIVE DEPTH AT \_\_\_\_\_ FT. BELOW ORIGINAL GRADE.

LOCATE DISPOSAL AREA 25 FT. FROM left LOT LINE AND 120 FT. FROM rear LOT LINE AS SEEN WHEN

FACING LOT FROM Meadow Wood Way.

DRY WELL

~~AND~~  
~~TRENCH~~

~~XXXXXXXXXXXXXXXXXXXXXXXXXXXX~~

PLANS APPROVED BY William W. Zepp

DATE 1/7/78

COVER NO WORK UNTIL INSPECTED AND APPROVED.

NEITHER THE HOWARD COUNTY COUNCIL NOR THE HEALTH DEPARTMENT IS RESPONSIBLE FOR THE SUCCESSFUL OPERATION OF ANY SYSTEM.

NOTE: IF TRENCH IS USED CALL FOR INSPECTION BEFORE PLACING GRAVEL IN TRENCH.

NOTE: NO DRY WELL SHALL EXCEED 15 FOOT IN DIAMETER.

NOTE: ALL PIPE FROM HOUSE TO DISPOSAL AREA MUST BE CAST IRON.

PERMIT VOID AFTER THREE YEARS.

NOTE: INSTALL STAND PIPE ON SEPTIC TANK AND DRY WELL. STAND PIPES MUST BE 6 INCHES IN DIAMETER. CAST IRON, CONCRETE OR TERRA COTTA ACCEPTED.

\*INSTALLER IS RESPONSIBLE FOR OBTAINING FINAL APPROVAL ON THIS PERMIT.


BLDG. PERMIT SIGNED

AND RETURNED 3/16/82

Serial # 48924  
Prd.

EH-2-1079

A  
25718

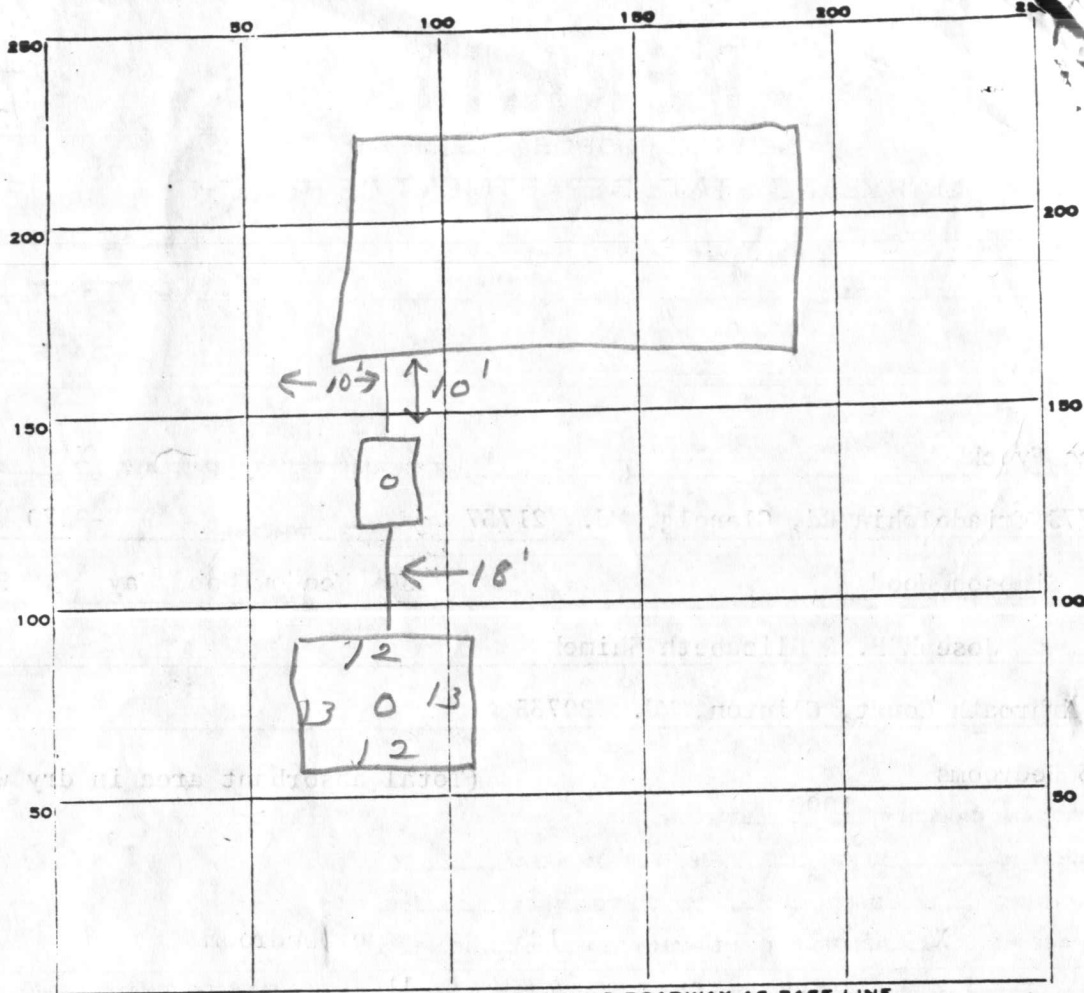

PERMIT CARD ☒

SEPTIC TANK, LEVEL ☒

CLEANOUTS

ST DW  
☒ ☒

DISTRIBUTION BOX, LEVEL

TILE FIELD, DEPTH \_\_\_\_\_ FT. TRENCH WIDTH \_\_\_\_\_ FT.

GRAVEL DEPTH \_\_\_\_\_ IN. TOTAL LENGTH \_\_\_\_\_ FT.

NUMBER OF TRENCHES \_\_\_\_\_ TOTAL BOTTOM AREA \_\_\_\_\_

SEEPAGE PITS, INSIDE DIAMETER 50 FT. DEPTH BELOW INLET 8 FT.

ABSORBENT AREA 400 SQ. FT.

REMARKS

7/1/81 OK to cover all work. js

DATE SYSTEM APPROVED

7/1/81

INSPECTOR

Stayer

C 1	41	SEQUENCE NO. (WRA USE ONLY)	<b>STATE OF MARYLAND</b> <b>WATER RESOURCES ADMINISTRATION</b> <b>TAWES STATE OFFICE BLDG., ANNAPOLIS, MD. 21401</b> <b>WELL COMPLETION REPORT</b>	THIS REPORT MUST BE SUBMITTED WITHIN 30 DAYS AFTER WELL COMPLETION FILL IN THIS FORM COMPLETELY COUNTY NUMBER <u>          </u>
1 2 3 4 5 6 (THIS NUMBER BE PUNCHED IN COLS. 3-6 ON ALL CARDS)	DATE RECEIVED (WRA USE ONLY)		DEPTH OF WELL 22 (TO NEAREST FOOT) 26	PERMIT NO. FROM "PERMIT TO DRILL WELL"
DATE WELL COMPLETED		300		40-73-315
8-13		15 20		28 29 30 31 32 33 34 35 36 37
		DRILLERS IDENTIFICATION NO.		238

OWNER Lanberg LAST NAME 304 STREET OR RFD Geachess Building POST OFFICE Columbia Md.

WELL DESCRIPTION			C 3			
WELL LOG STATE THE KIND OF FORMATIONS PENETRATED, THEIR COLOR, DEPTH, THICKNESS AND IF WATER BEARING			1 2 3 (SEQ. NO.) 6			
DESCRIPTION (USE ADDITIONAL SHEETS IF NECESSARY)	FEET FROM TO	CHECK IF WATER BEARING	PUMPING TEST			
Sand  Gray mica rock	0 44 44 300 ✓	✓	GROUTING RECORD WELL HAS BEEN GROUTED (CIRCLE APPROPRIATE BOX) YES <input checked="" type="checkbox"/> Y NO <input type="checkbox"/> N TYPE OF GROUTING MATERIAL (CIRCLE BOX) CEMENT <input checked="" type="checkbox"/> CM BENTONITE CLAY <input type="checkbox"/> BC NO. OF BAGS <u>12</u> NO. OF POUNDS <u>1128</u> GALLONS OF WATER <u>72</u> DEPTH OF GROUT SEAL (TO NEAREST FOOT) FROM <u>0</u> FT. TO <u>45</u> FT. (ENTER 0 IF FROM SURFACE)		HOURS PUMPED (TO NEAREST HOUR) <u>4</u> PUMPING RATE (GALLONS PER MINUTE TO NEAREST GALLON) <u>2</u> METHOD USED TO MEASURE PUMPING RATE <u>air</u> WATER LEVEL: (DISTANCE FROM LAND SURFACE) BEFORE PUMPING <u>65</u> (NEAREST FOOT) WHEN PUMPING <u>5</u> (NEAREST FOOT)	
			CASING RECORD INSERT APPROPRIATE CODE BELOW STEEL <input type="checkbox"/> ST CONCRETE <input type="checkbox"/> CO PLASTIC <input type="checkbox"/> PL OTHER <input type="checkbox"/> OT MAIN CASING TYPE <u>ST</u> NOMINAL DIAMETER TOP (MAIN) CASING (NEAREST INCH) <u>6</u> TOTAL DEPTH OF MAIN CASING (NEAREST FOOT) <u>50</u>		TYPE OF PUMPED USED (CIRCLE APPROPRIATE BOX) (FOR PUMPING TEST) <input checked="" type="checkbox"/> A AIR <input type="checkbox"/> P PISTON <input type="checkbox"/> T TURBINE <input type="checkbox"/> C CENTRIFUGAL <input type="checkbox"/> R ROTARY <input type="checkbox"/> O OTHER (DESCRIBE BELOW) <input type="checkbox"/> J JET <input type="checkbox"/> S SUBMERSIBLE	
			OTHER CASING (IF USED) DIAMETER (INCH) FROM TO <input type="checkbox"/> <input type="checkbox"/> <input type="checkbox"/> <input type="checkbox"/> <input type="checkbox"/> <input type="checkbox"/>		PUMP INSTALLED TYPE OF PUMP (WRITE APPROPRIATE LETTER IN BOX - SEE ABOVE: A, C, J, P, R, S, T, O) <u>          </u>	
			SCREEN TYPE OR OPEN HOLE INSERT APPROPRIATE CODE BELOW STEEL <input type="checkbox"/> ST BRASS OR BRONZE <input type="checkbox"/> BR OPEN HOLE <input type="checkbox"/> HO PLASTIC <input type="checkbox"/> PL OTHER <input type="checkbox"/> OT		DRILLER WILL INSTALL PUMP (CIRCLE APPROPRIATE BOX) YES <input type="checkbox"/> Y NO <input checked="" type="checkbox"/> N CAPACITY: GALLONS PER MINUTE (TO NEAREST GALLON) <u>31</u> <u>35</u> PUMP HORSE POWER <u>37</u> <u>41</u> PUMP COLUMN LENGTH (NEAREST FOOT) <u>43</u> <u>47</u>	
			C 2 1 2 3 (SEQ. NO.) 6 DEPTH (NEAREST WHOLE FOOT) FROM <u>48</u> TO <u>300</u> 1 8 9 11 15 17 21 2 23 24 26 30 32 36 3 38 39 41 45 47 51 SLOTSIZE 1, <u>          </u> 2, <u>          </u> 3, <u>          </u>		CASING HEIGHT (CIRCLE APPROPRIATE BOX AND ENTER CASING HEIGHT) <input checked="" type="checkbox"/> + ABOVE } LAND SURFACE (NEAREST FOOT) <input type="checkbox"/> - BELOW } <u>2</u>	
			CIRCLE APPROPRIATE BOXES <input type="checkbox"/> A A WELL WAS ABANDONED AND SEALED WHEN THIS WELL WAS COMPLETED <input type="checkbox"/> E ELECTRIC LOG OBTAINED <input type="checkbox"/> P TEST WELL CONVERTED TO PRODUCTION WELL I HEREBY CERTIFY THAT I HAVE COMPLIED WITH ALL CONDITIONS STATED ON THE ABOVE-CAPTIONED "PERMIT TO DRILL WELL", AND THAT INFORMATION CONTAINED IN THIS REPORT IS TRUE, ACCURATE, AND COMPLETE TO THE BEST OF MY KNOWLEDGE, INFORMATION AND BELIEF. DRILLERS NAME <u>Joseph L. Mayne</u>		LOCATION OF WELL ON LOT SHOW PERMANENT STRUCTURE SUCH AS BUILDINGS, SEPTIC TANKS, AND/OR OTHER LAND MARKS AND INDICATE NOT LESS THAN TWO DISTANCES (MEASUREMENTS TO WELL). <u>Back lot line</u> <u>1540 ft</u> <u>60 ft</u> <u>Left lot line</u>	
			DRILLERS NAME (PLEASE PRINT) <u>Joseph L. Mayne</u> SIGNATURE <u>Joseph L. Mayne</u>		WRA USE ONLY (NOT TO BE FILLED IN BY DRILLER) (E.R.O.S.) T <input type="checkbox"/> 70 W <input type="checkbox"/> 72 Q <input type="checkbox"/> 74 75 76 TELESCOPE CASING LOG INDICATOR OTHER DATA AVAILABLE	



RECEIVED

JUN 8 9 15 AM '79

HOWARD COUNTY  
HEALTH DEPT.  
ELLCOTT CITY, MD.



RECEIVED




RECEIVED



RECEIVED

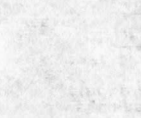

# APPLICATION

A 25718

## SEWAGE DISPOSAL TESTING

P \_\_\_\_\_

STATE OF MARYLAND - DEPARTMENT OF HEALTH AND MENTAL HYGIENE

HOWARD COUNTY HEALTH DEPARTMENT  
ENVIRONMENTAL HEALTH SERVICES

DISTRICT 5th

P. O. BOX 476, ELLICOTT CITY, MARYLAND 21043  
TELEPHONE: 465-5000, EXT. 356

DATE 4-21-77

$t = 6\sqrt{33} \rightarrow 6 \text{ min}$

TO: THE COUNTY HEALTH OFFICER  
ELLICOTT CITY, MARYLAND

I, HEREBY, APPLY FOR THE NECESSARY TEST IN ORDER TO CONSTRUCT (OR RECONSTRUCT) A SEWAGE DISPOSAL SYSTEM.

PROPERTY OWNER Phase II Ltd. Joseph F. & Elizabeth Skimik  
7904 Oak Arboretum Court  
ADDRESS c/o Landborg, Inc., 1000 Century Plaza PHONE 730-0500  
Clinton, Mo. 20735

PROPERTY LOCATION:  
SUBDIVISION Simpson Woods Section Two LOT NO. NEW LOT 5, SEC 2  
7250 Meadow Wood Way 3, Block D  
ROAD AND DESCRIPTION West Side of Road A; North of Johns Hopkins Road

SIZE OF LOT 40,000 square feet TYPE BLDG. 3 or 4  
IF NOT SINGLE RESIDENCE DESCRIBE \_\_\_\_\_ BLDG. PERMIT SIGNED \_\_\_\_\_  
AND RETURNED 8/20/80 NUMBER OF BEDROOMS \_\_\_\_\_  
Series No. 44102

THE SYSTEM INSTALLED UNDER THIS APPLICATION IS ACCEPTABLE ONLY UNTIL PUBLIC FACILITIES BECOME AVAILABLE.

SIGNATURE OF APPLICANT Phase II, Ltd., Alon C. Berg, Pres.


APPROVED BY William H. Zipp FOR DW & trench DATE 1/7/78  
(KIND OF SYSTEM)

REJECTED BY \_\_\_\_\_ FOR \_\_\_\_\_ DATE \_\_\_\_\_  
(KIND OF SYSTEM)

HOLD PENDING FURTHER TESTS WW2 DATE 5/2/77

REASONS FOR REJECTION OR HOLDING prelim. plat, certified test holes.

# THIS IS NOT A PERMIT

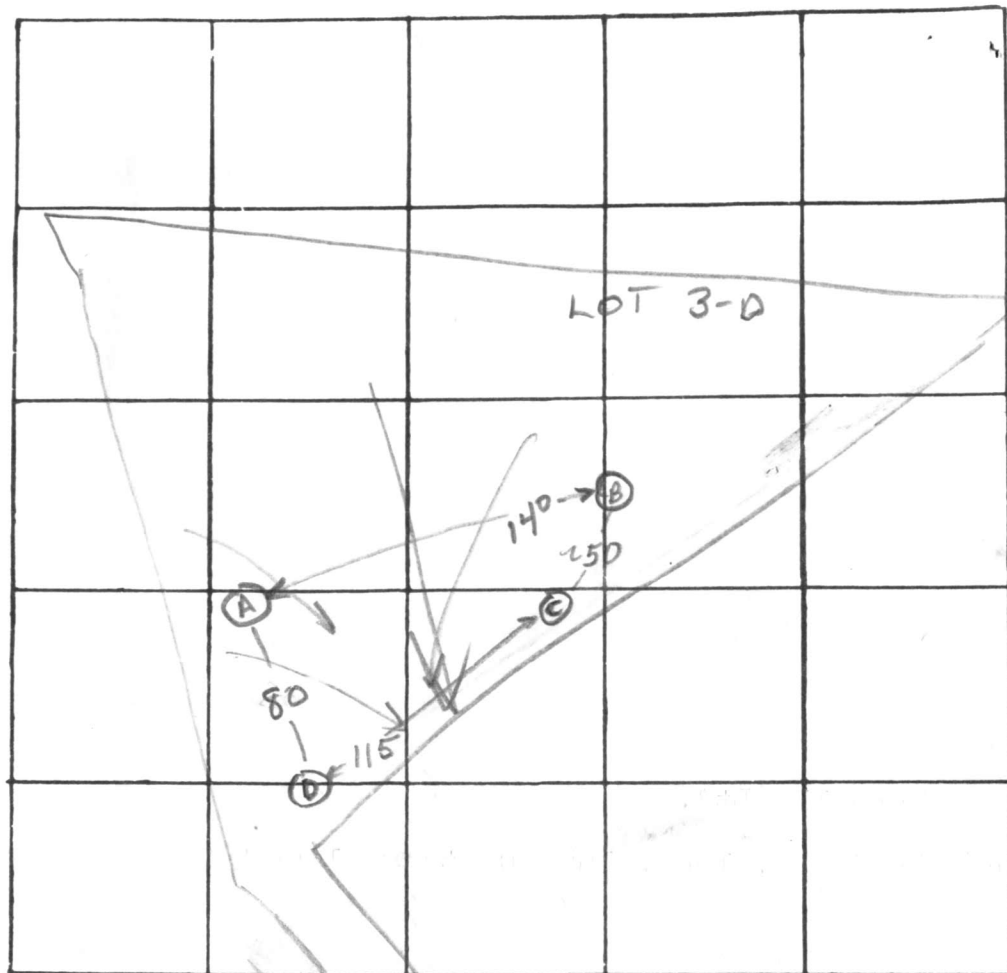

DATE	TEST NO.	DEPTH	PRE-WET		TEST - 1" DROP		TIME
			START	STOP	START	STOP	
4/29/77	LOW D-1	2 1/2	5:13	5:14	5:14	5:16	2
		12	5:11	5:15	5:15	5:22	7
	C	2 1/2	5:28	5:29	5:29	5:32	3
	C-1	11	5:28	5:32	5:32	5:45	13
HIGH	B	3	5:52	5:53	5:53	5:55	2
	B-1	11 1/2	5:51	5:57	5:57	6:05	8
	A	12 1/2	VISUAL; similar to rest; dry				

9  
16  
10  
35

REMARKS System in B → A

TYPE OF SOIL Sandy

TESTED BY NWE


ALSO PRESENT: Kellum Co  
Borg

7/19/04

A25718  
P 31439

^

ingr. Pool in back

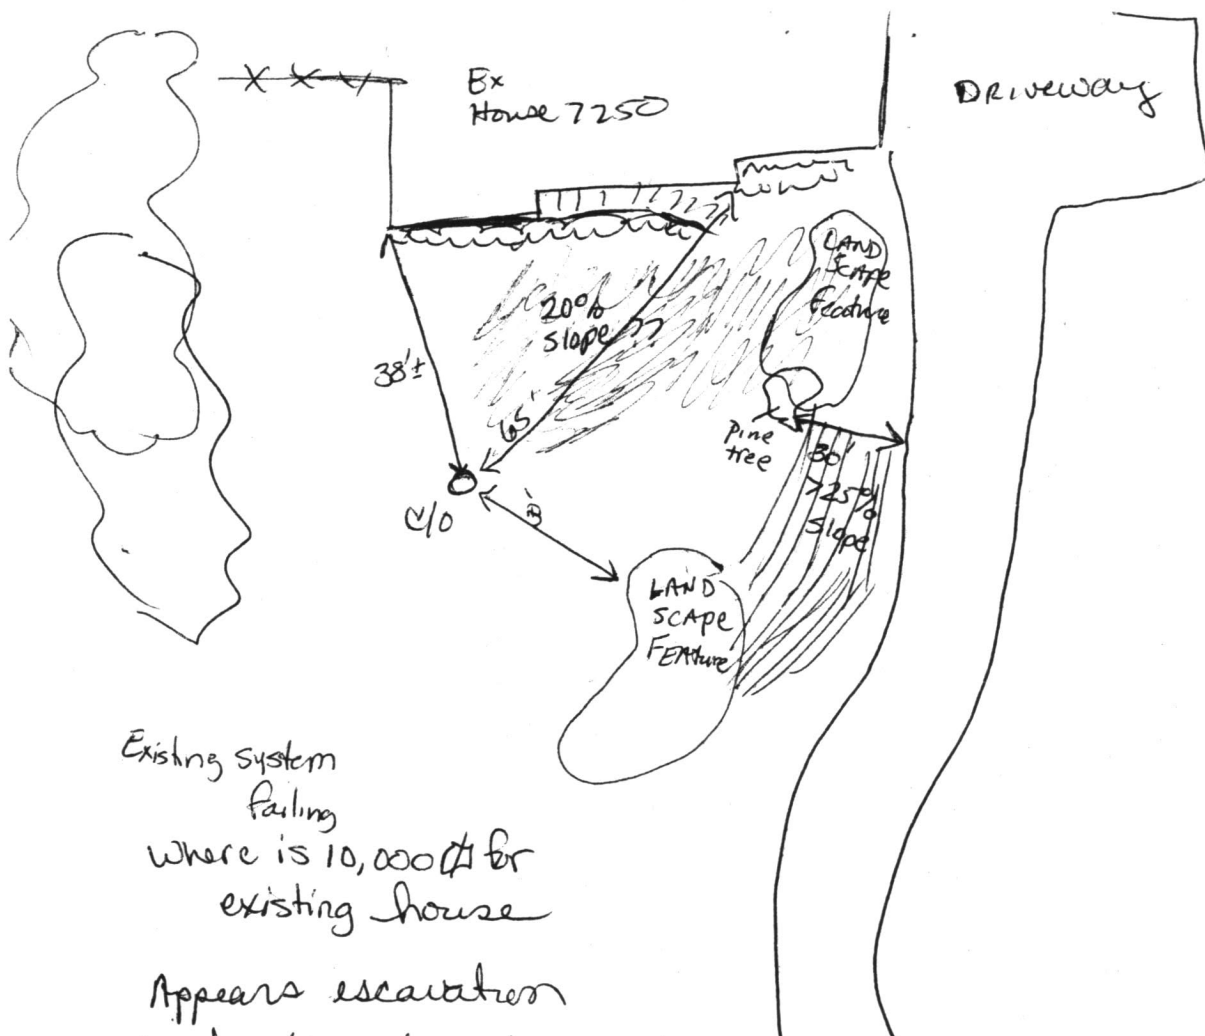


Existing system  
failing  
where is 10,000 \$ for  
existing house

Appears excavation  
in backyard - soils  
placed on existing SDA,  
Cable @ end of SDA / slightly  
in / driveway over SDA??




3 FT WIDE STEPS AT  
CORNER OF TERRACES  
TO LEAD UP FROM  
PATIO TO GRADE.  
(RAILING AS REQ'D)

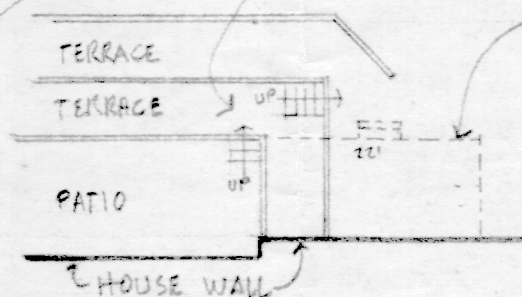

FIRST FLOOR LEVEL DECK &  
STEPS TO GROUND SHOWN DOTTED

CREATE TERRACES IN BACK YARD AND SIDE YARD WITH RETAINING WALLS. THESE TERRACES ARE INTENDED FOR PLANTING PURPOSES. USE PRESSURE TREATED 'LANDSCAPE TIES' FOR RETAINING WALLS (USE A 'DEADMAN' TIEBACK AT 10'-0" ± APART.) PATIO SHALL HAVE WALK SURFACE OF 2x6 S, 1/4" ± APART, SECURED TO 2x4 SLEEPERS @ 24" O.C. SLEEPERS SHALL REST ON TOP OF 12" OF GRAVEL FILL. USE AT LEAST 2-4" DIA DRAINTILE (SPACED EQUALLY FROM SIDES) AT BOTTOM OF GRAVEL FILL FOR THE FULL LENGTH OF THE PATIO AT REAR AND SIDE OF HOUSE; AND EXTEND BOTH DRAINTILES TOWARD STREET, TO DISCHARGE AT GRADE LEVEL. USE RIP-RAP @ DISCHARGE AREA TO AVOID EROSION.


PLAN VIEW DETAIL @ PATIO & DECK DO NOT SCALE

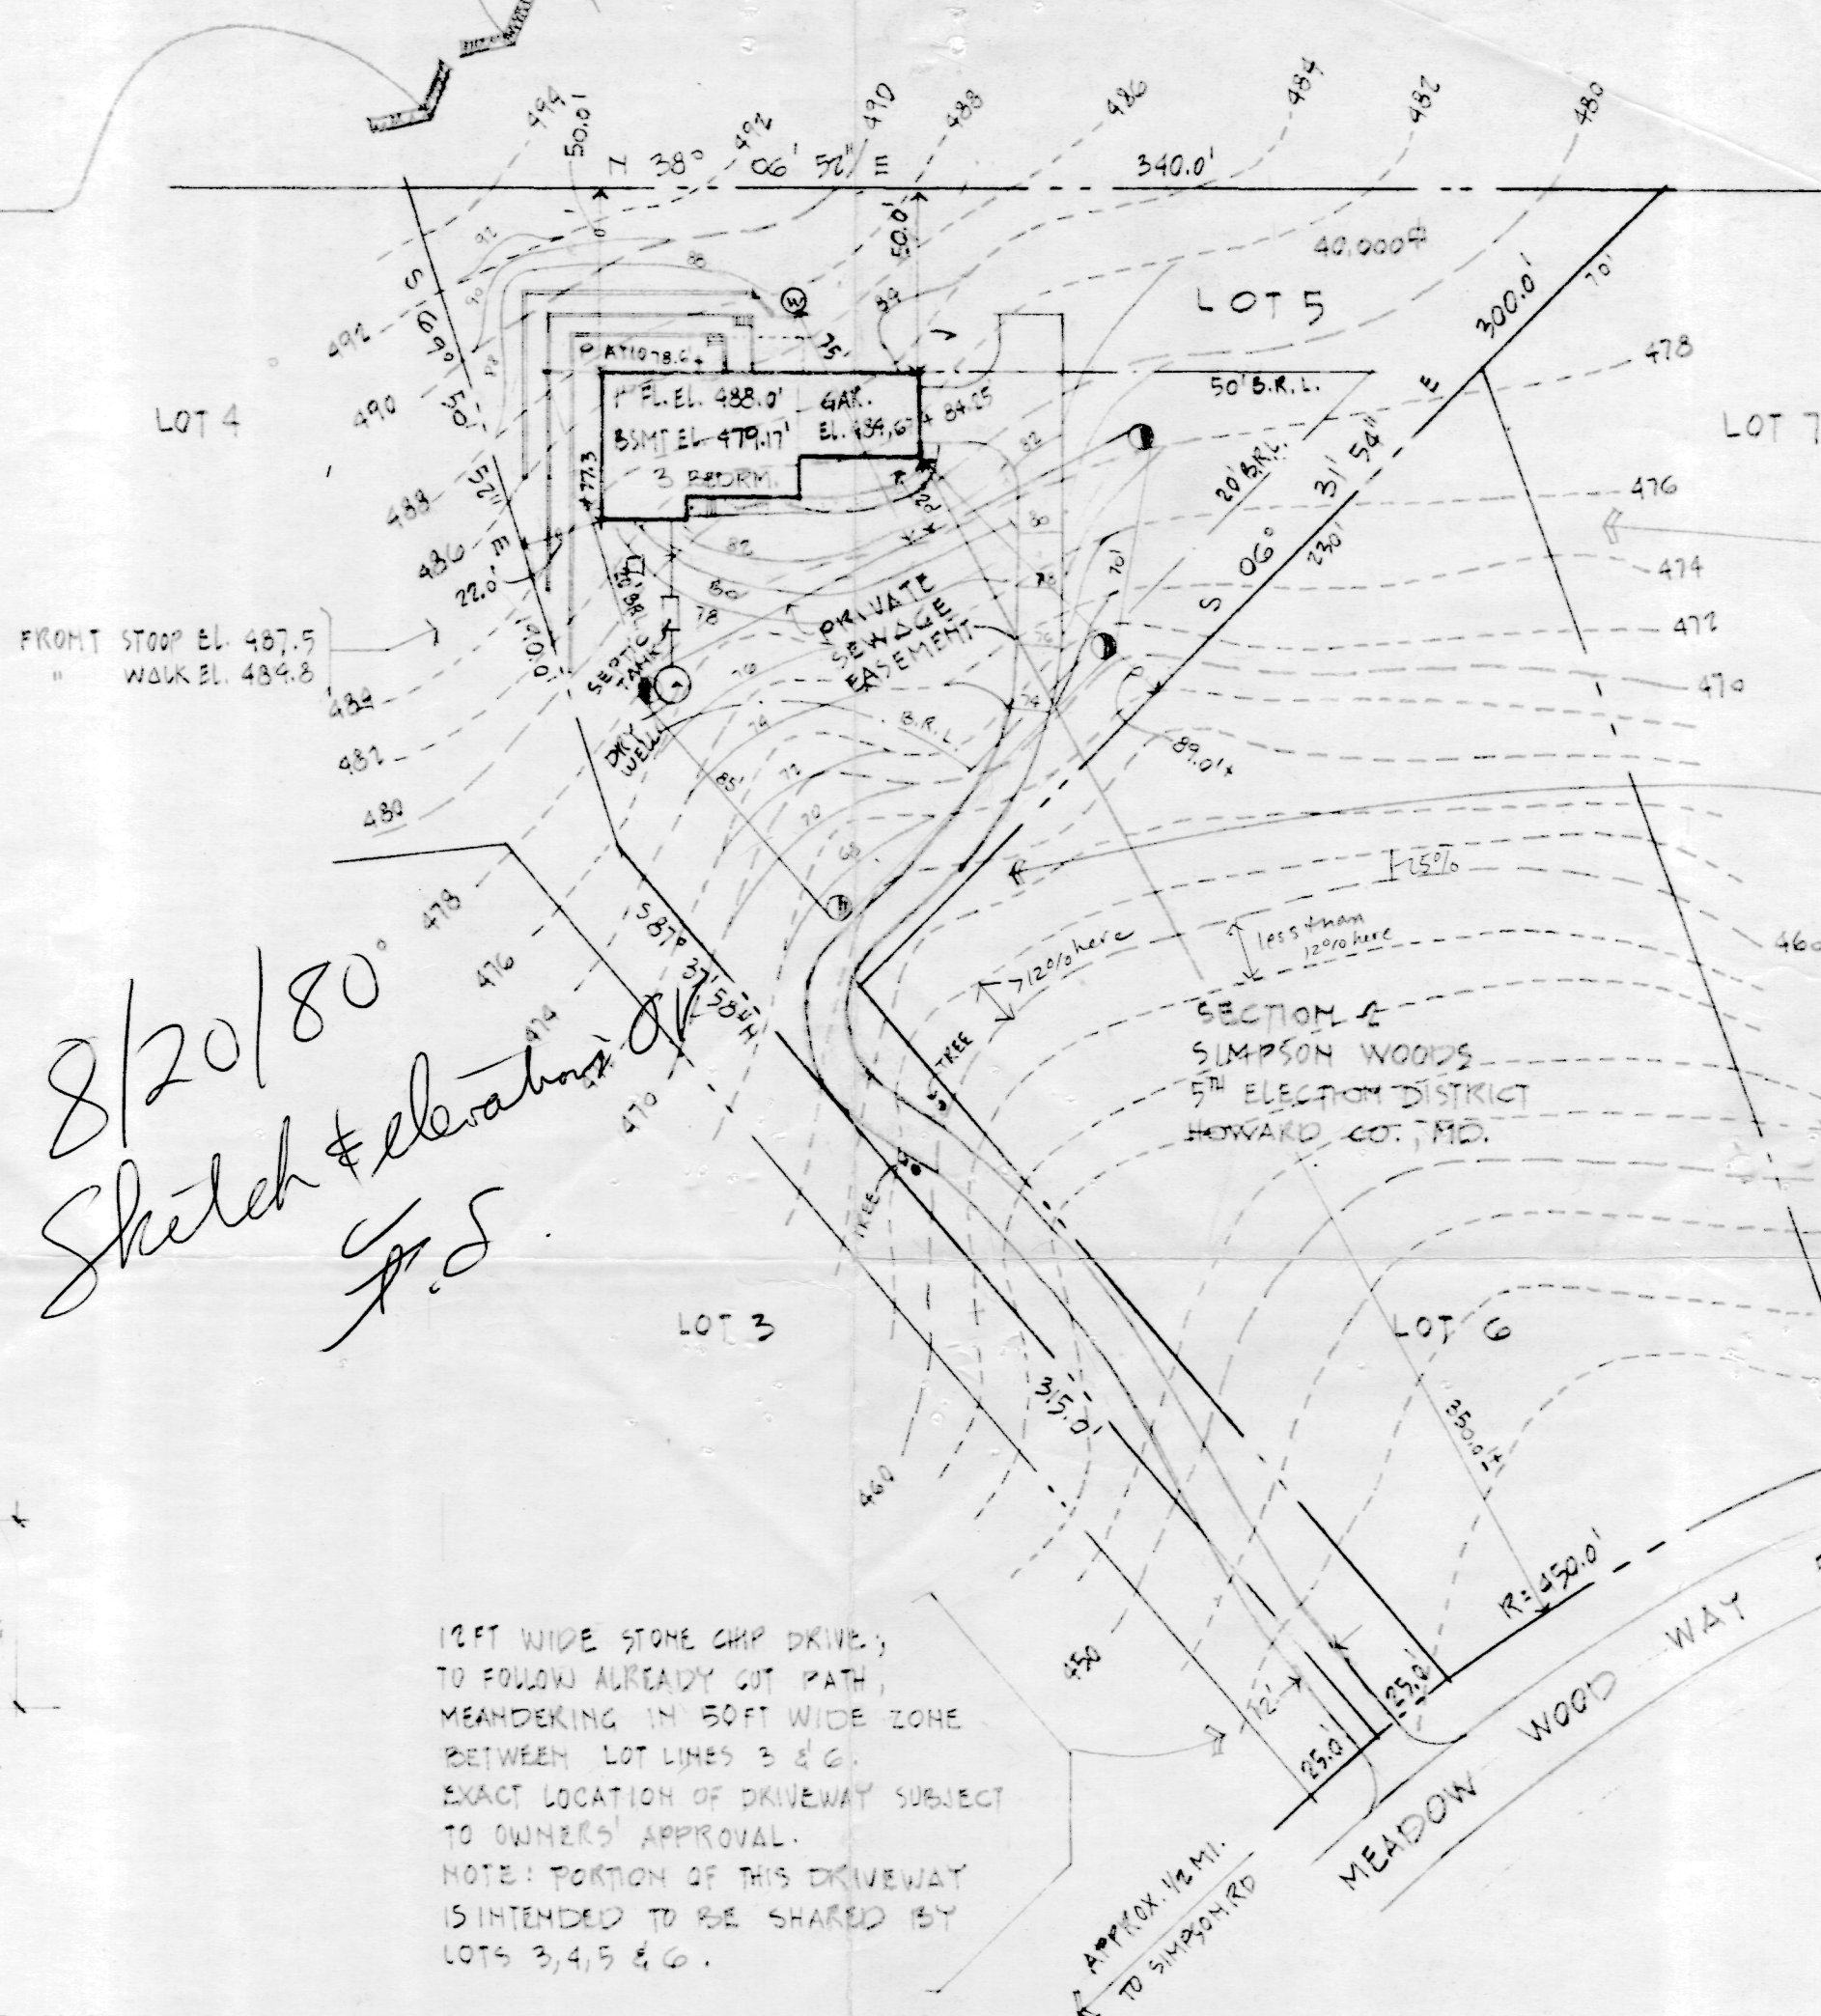


NOTE: ADJUST PROPOSED GRADE ELEVATIONS FOR DRIVEWAY FOR AS LOW A SLOPE AS ACTUAL GRADE CONDITIONS ALLOW. KEEP SLOPE TO 11/2% OR LESS WITHIN ROFT OF GARAGE DOOR. - ALL SLOPES, DRIVEWAY AND TURNAROUND LOCATIONS SUBJECT TO OWNER'S APPROVAL.

NOTE: NEW GRADE ELEVATIONS ARE NOT SHOWN FOR DRIVEWAY ALONG LOT 6 PROP. LINE, BUT GRADE SITE AS REQUIRED FOR A GENTLY WINDING AND SLOPING DRIVEWAY. INSTALL DRAINTILES UNDER ROAD AS REQUIRED TO MAINTAIN EXISTING DRAINAGE PATTERN

8/20/80  
Sketch & elevations  
P.S.

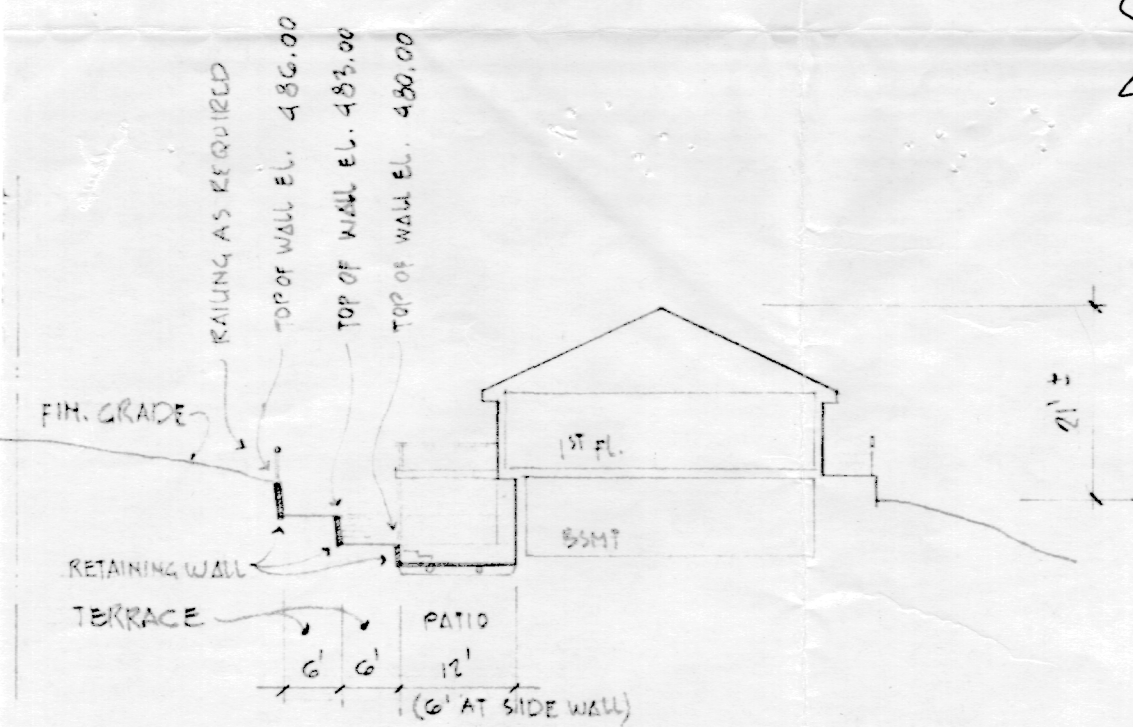


SECTION THRU HOUSE @ FRONT STOOP DO NOT SCALE

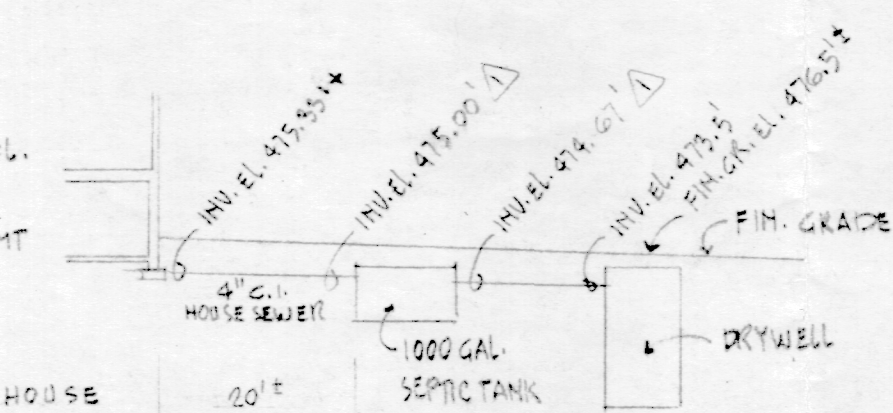


# SITE PLAN 1" = 30'

NOTE: ALL EXISTING CONDITIONS TO BE VERIFIED IN FIELD.

- LEGEND:
- - - 470 EXISTING CONTOUR (2 FT INTERVALS)
  - TO PROPOSED NEW CONTOUR
  - + 84.25 " " SPOT ELEVATION
  - DIRECTION OF DRAINAGE/SWALE

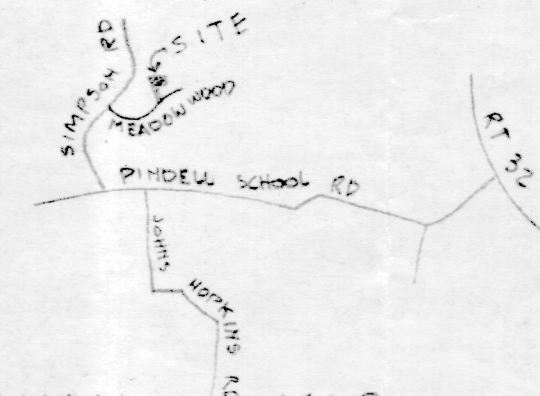



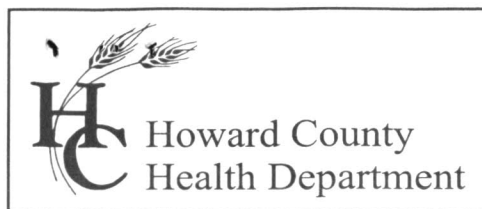

3525 H Ellicott Mills Drive, Ellicott City, MD 21043  
(410) 313-2640 Fax (410) 313-2648  
TDD (410) 313-2323 Toll Free 1-866-313-6300  
website: [www.hchealth.org](http://www.hchealth.org)

---

Penny E. Borenstein, M.D., M.P.H., Health Officer

October 5, 2004

Mr. Tom D'Amato  
7250 Meadow Wood Way  
Ellicott City, MD 21042


Re: Failing Septic System Notice  
7250 Meadow Wood Way  
Simpson Woods, Lot 5

Dear Mr. D'Amato:

During percolation testing of Lot 6, it was brought to our attention that your existing property, Lot 5, is showing signs of failure. Upon percolation testing, it is mandatory for the sanitarian to confirm that the identified septic and well locations are accurate as shown on the engineer's plan. Enclosed is a copy of our letter sent to you including field inspection results during percolation testing for Lot 6.


It is pertinent that the failing septic system is repaired immediately. Due to the severe slopes in the front yard (greater than 25%) created by compromising the recorded septic area, a trench repair is not an option at this time. Refer back to the letter dated July 21, 2004 for possible solutions. Any other possible solutions for proper repair of the existing failing system, other than our recommendation as stated in the July 21, 2004 letter, is welcomed.

Have a licensed engineer submit a plan showing a possible repair location for your existing property. If we have not received a percolation application to rectify the situation in 15 days, we will follow up with proper legal action.

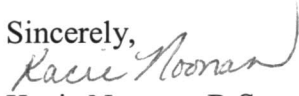Sincerely,  
  
Kacie Noonan, R.S.  
Well and Septic Program

KN

Cc: file

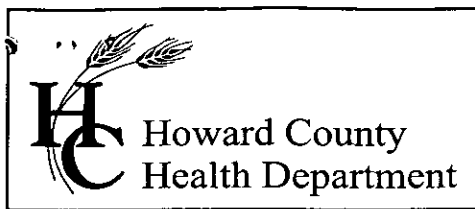

3525 H Ellicott Mills Drive, Ellicott City, MD 21043  
(410) 313-2640 Fax (410) 313-2648  
TDD (410) 313-2323 Toll Free 1-866-313-6300  
website: [www.hchealth.org](http://www.hchealth.org)

Penny E. Borenstein, M.D., M.P.H., Health Officer

July 21, 2004

Mr. Tom D'Amato  
7250 Meadow Wood Way  
Ellicott City, Maryland 21042

RE: **Percolation Test Results**  
Application: A518517  
Proposal: Percolation Testing of Non-buildable Lot  
Simpson Woods, Lot 6  
Tax Map: 41 Parcel: 423

Dear Mr. D'Amato:

Percolation testing was conducted on the above referenced property July 19, 2004. A copy of the test results is enclosed for your records. The test holes evaluated were found to be unsatisfactory due to drainage swales created by natural surface drainage, hydric mottles near ground surface down to standing water, and saturated soils around 10 feet containing water seepage.

Inspection of surrounding topography within view of the excavated test holes indicates future proposed percolation testing for conventional septic systems will provide the same results due to the large area of high water table located in the vicinity. Although soils near the surface are conducive for absorbing effluent in test hole #A, slopes greater than 12 percent prevents any future testing for sand mound systems. Percolation test hole #B is conducive for sand mound testing; however, enough area with less than 12 percent slopes must be avail for three sand mound systems.

Should you wish to further pursue an attempt to subdivide the above referenced property, it shall be necessary for a licensed surveyor to submit a revised percolation test plan. This test plan should include actual locations and elevations of all excavated test holes, relevant landscape features and field-matched topography, along with a revised proposal.

As an additional, important note, the current septic system for the existing house, Simpson Woods, Lot 5, Section 2, address 7250 Meadow Wood Way, is currently failing. Inspection of the dry well shows septic effluent one foot below grade and evidence of septic discharge reaching above grade into the cleanout pipe. It also appears that natural grade for the existing septic system has been greatly compromised by additional fill added on top creating some slopes of 20 and 25 percent, and a cable easement runs through the septic area as well. COMAR regulation 26.04.02.04(F) states that the septic easement shall be void of other easements, rights-of-way, and any other physical or permanent objects.



Our office understands that a lot line has been established for the above mentioned lots, however, we strongly recommend revising the location of the lot line to incorporate the highest elevation of soils on lot six to be used for your septic repair currently in need or for future repair.

Sincerely,


A handwritten signature in cursive script that reads "Kacie Noonan".

Kacie Noonan, R.S.  
Water and Sewerage Program

KN

Enclosure

Cc: file

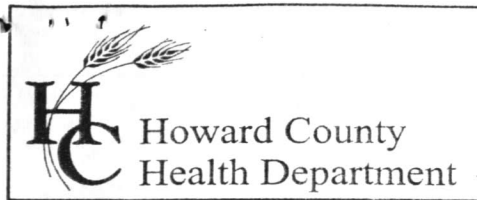

7178 Columbia Gateway Drive, Columbia, MD 21046  
(410) 313-2640 Fax (410) 313-2648  
TDD (410) 313-2323 Toll Free 1-866-313-6300  
website: [www.hchealth.org](http://www.hchealth.org)

Penny E. Borenstein, M.D., M.P.H., Health Officer

December 23, 2004

Mr. Tom D'Amato  
7250 Meadow Wood Way  
Clarksville, MD 21029

Re: Site Inspection Results  
7250 Meadow Wood Way  
Simpson Woods, Lot 5

Dear Mr. D'Amato,

Site inspection was done for the existing septic system on December 20, 2004. Effluent levels in the dry well were acceptable and did not indicate soil supersaturation. Auger results indicate a sandy, micaceous loam and loam. However, refusal occurred at approximately 2 1/2'. It is unclear if piping was incurred or schist. In conclusion, the inspection did not indicate any septic failure occurring at this time.

In order to finalize this case, our office is requesting receipt of contractor's work done around October 2004. You may fax your repair receipt to 410-313-2648. Any future permits for the above address will allow our office to request a backhoe contractor and percolation testing to be done to verify depths sufficient for a repair septic system.

Thank you for your time in this important matter.

Sincerely,


Kacie Noonan, R.S.  
Well and Septic Program

Cc: file ✓

# SITE INSPECTION SHEET

OWNER: Tom D'Amato PHONE #: \_\_\_\_\_  
ADDRESS: 7250 MEADOW Wood Way CONTRACTOR: \_\_\_\_\_  
CLARKSVILLE WELL TAG #: \_\_\_\_\_  
SUBDIVISION: Simpson Woods LOT: 5 Sec 2 COUNTY #: \_\_\_\_\_  
PROPOSAL: 12/20/04 Assess functionality of existing  
septic system.

### LOCATION DIAGRAM

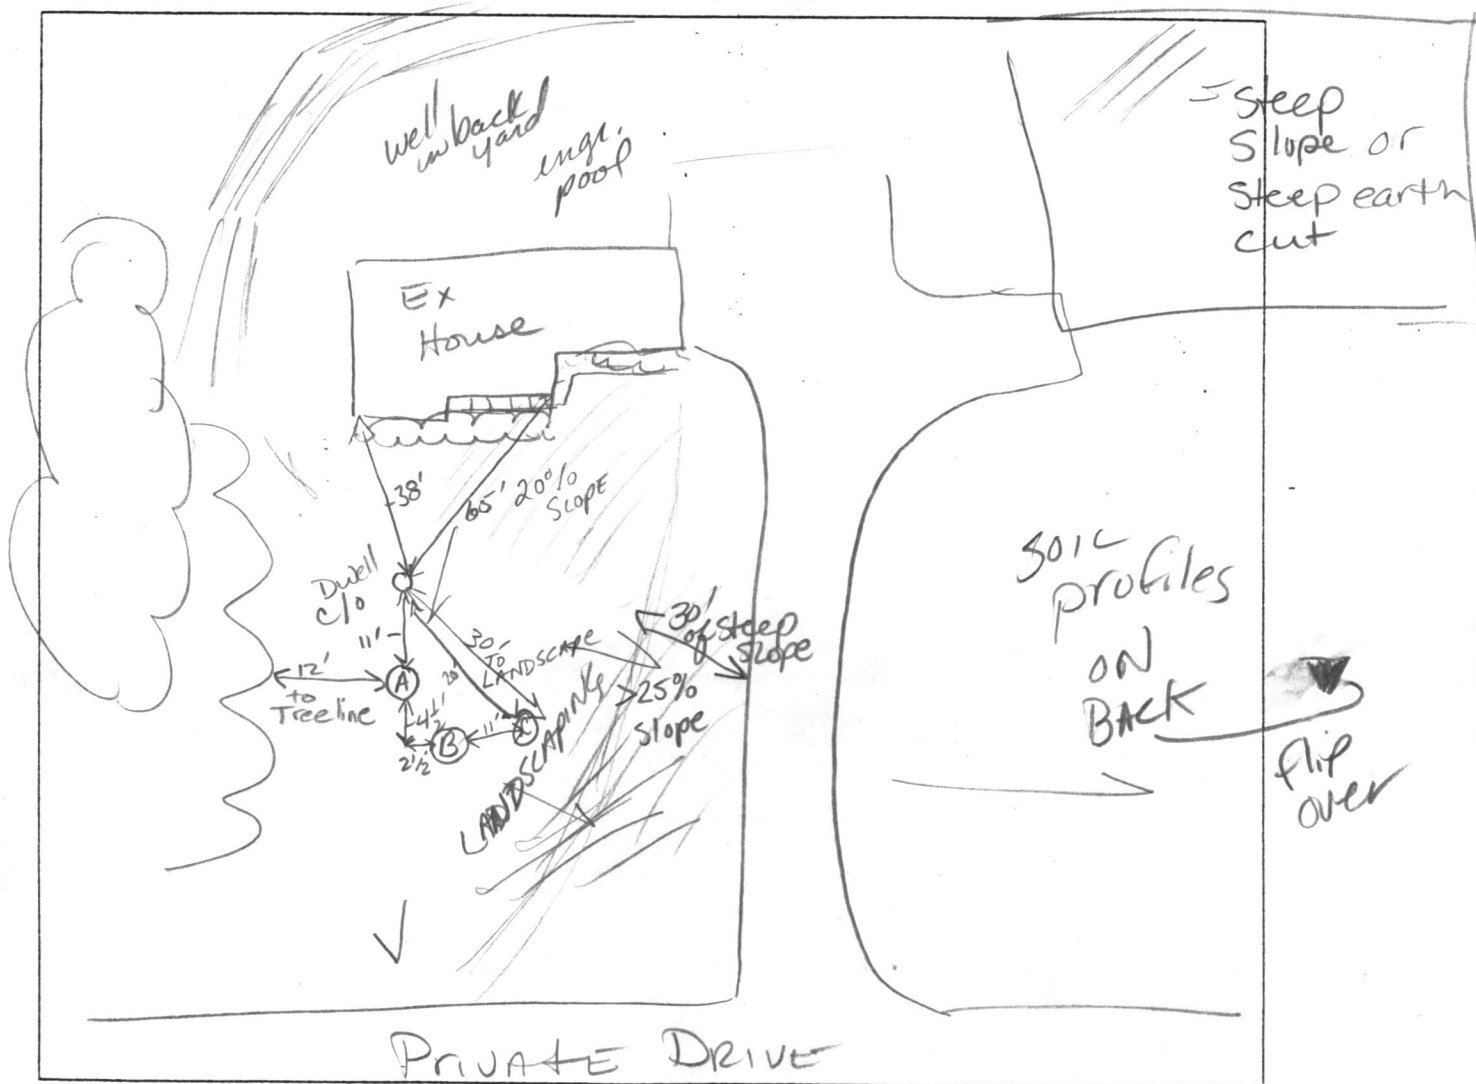

COMMENTS: 12-20-04 Percolation test holes in 1980 established septic area. However, due to excavation for driveway creating hillside w/ slopes  $>25\%$  at least 4,500 ft<sup>2</sup> has been compromised. Augered test holes today encountered shallow depths to 28" due to

DATE: 12-20-04 INSPECTOR: KN  
rock or pvc pipe? SEE SOIL DESCRIPTIONS EFFluent in dry well @ low level  
EST 26'



Angered in area  
of visible surface  
B / (A)

Frozen 3"  
brn  
wk rdbn  
micaceous  
granular  
Loam  
12"  
rd brn  
micae  $\approx 40\%$   
SL  
↓  
22"  
grey black  
dk brn  
rock  
frag  
organic  
in appearance  
No roots in  
this layer  
2mm thick +  
size of silver  
dollar  
LOAM  
26"  
tan  
wk rdbn  
moist  
Loam  
28"  
refusal -  
pvc pipe??  
hit hard surface  
sounds hollow


Angered hole out of wall ...  
20' from dry well c/o  
11' from hole (B)  
(C)

brn, tan,  
wk rdbn, 30-  
v. micae 40%  
Loam  
23"  
tan rdbn  
SL  
mica 45%±  
1 stone frag  
encountered  
28"  
Hard Rock?  
Sounded hollow,  
though.

A25718  
P 31439

ingr. pool in back

^N

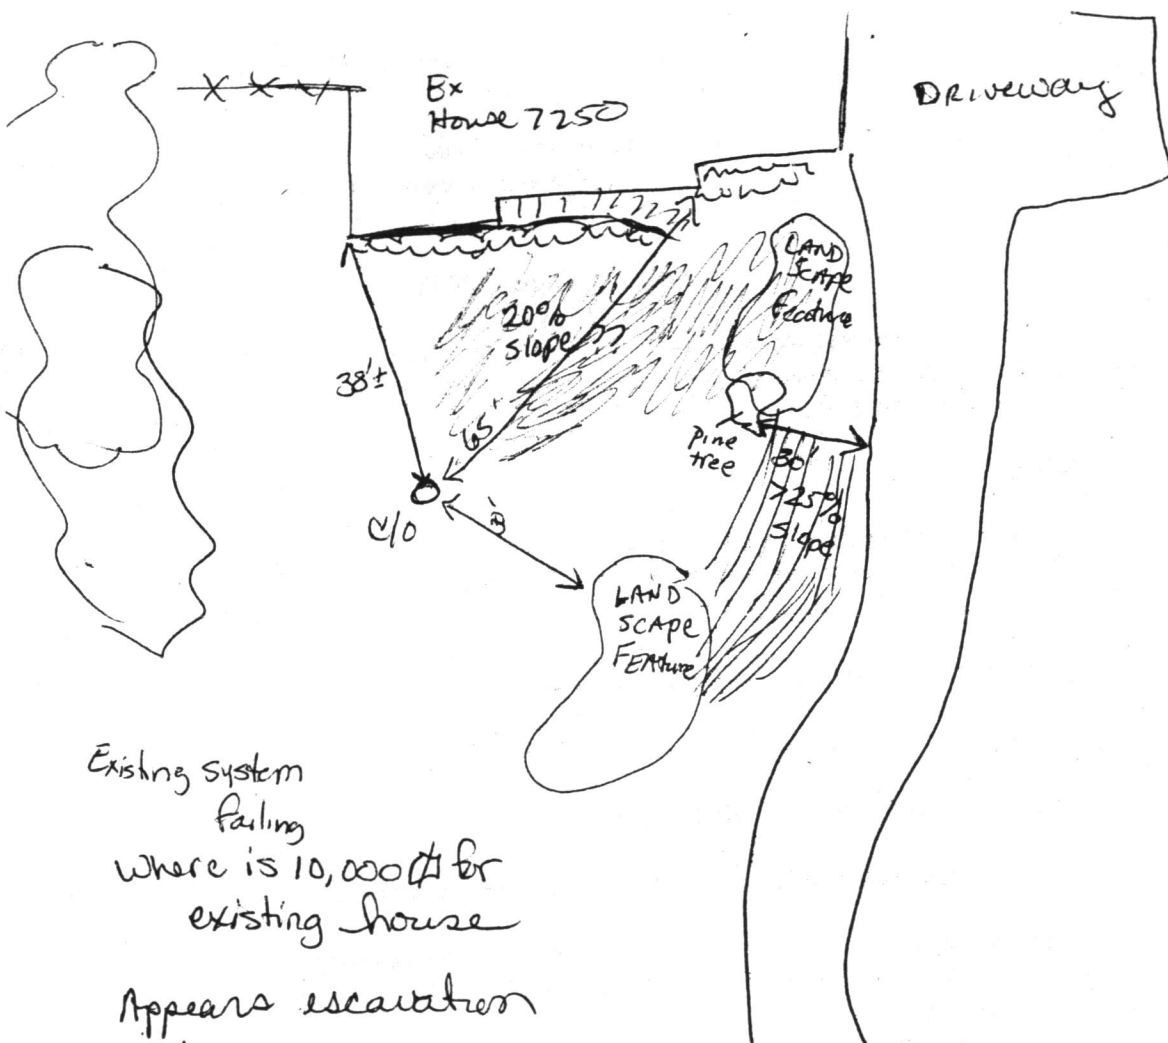

Existing system  
failing  
where is 10,000 \$ for  
existing house

Appears excavation  
in backyard - soils  
placed on existing SDA,  
Cable @ end of SDA / slightly  
in / driveway over SDA??