

5/11/79
p.m. search
5/4/79
final

File

PERMIT

SEWAGE DISPOSAL SYSTEM

MARYLAND STATE DEPARTMENT OF HEALTH*

HOWARD COUNTY

ELLICOTT CITY

DISTRICT 5th

DATE 4/25/79

INDEXED

P 29752
A 26377

Brantly Development IS PERMITTED TO INSTALL X ALTER
ADDRESS Suite 218, Teachers Bldg., Columbia, Md. 21044 PHONE _____
SUBDIVISION Hallmark ROAD Hallmark Road LOT 33, Sec. 2
PROPERTY OWNER Brantly Development
ADDRESS same as above

SPECIFICATIONS 4 bedrooms
SEPTIC TANK CAPACITY 1250 GALLONS
DRAIN FIELD _____ DEPTH _____ FEET, BOTTOM AREA _____ SQ. FT.
DEEP TRENCH _____ DEPTH _____ FEET, BOTTOM AREA _____ SQ. FT.
SEEPAGE PITS X ABSORBENT SIDE-WALL AREA 336 SQ. FT. total sidewall area in dry well.
INLET PIPE 2 FT. BELOW ORIGINAL GRADE. MAXIMUM DEPTH 9 FT. BELOW ORIGINAL GRADE
EFFECTIVE DEPTH AT _____ FT. BELOW ORIGINAL GRADE.
LOCATE DISPOSAL AREA 50 FT. FROM 290' LOT LINE AND 20 FT. FROM rear LOT LINE AS SEEN WHEN
FACING LOT FROM

Trench to be 40 ft. long. Inlet to trench between 2 to 4 ft. and maximum depth of
trench between 9 ft. and 11 ft. Trench to run from a point 70 ft. from 290 ft.
property line and run slightly upgrade towards center of front ~~ix~~ 165 ft. lot line.

PLANS APPROVED BY David J. O'Neill DATE 12/1/77

COVER NO WORK UNTIL INSPECTED AND APPROVED.
NEITHER THE HOWARD COUNTY COUNCIL NOR THE HEALTH DEPARTMENT IS RESPONSIBLE FOR THE SUCCESSFUL OPERATION OF ANY SYSTEM.
NOTE: IF TRENCH IS USED CALL FOR INSPECTION BEFORE PLACING GRAVEL IN TRENCH.
NOTE: NO DRY WELL SHALL EXCEED 15 FOOT IN DIAMETER.
NOTE: ALL PIPE FROM HOUSE TO DISPOSAL AREA MUST BE CAST IRON.
PERMIT VOID AFTER THREE YEARS.
NOTE: INSTALL STAND PIPE ON SEPTIC TANK AND DRY WELL. STAND PIPES MUST BE 6 INCHES IN DIAMETER. CAST IRON, CONCRETE OR TERRA
COTTA ACCEPTED.


*INSTALLER IS RESPONSIBLE FOR OBTAINING FINAL APPROVAL ON THIS PERMIT.

A 26377

#33

48.0

360
315
45

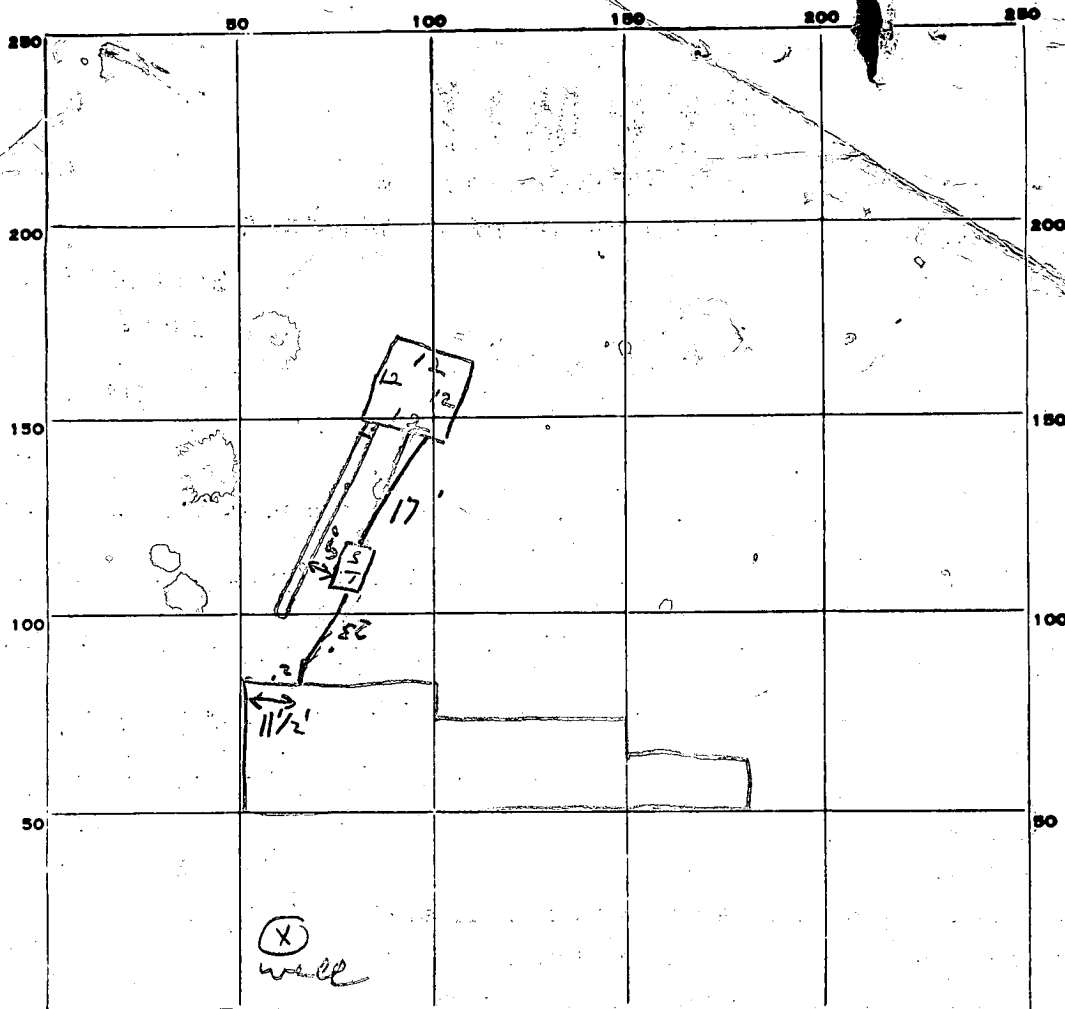

PERMIT CARD

SEPTIC TANK, LEVEL

DISTRIBUTION BOX, LEVEL

TILE FIELD, DEPTH 10 FT. TRENCH WIDTH 2 FT.

GRAVEL DEPTH 2 ± IN. TOTAL LENGTH 45 FT.

NUMBER OF TRENCHES 1 TOTAL BOTTOM AREA

SEEPAGE PITS, INSIDE DIAMETER 48 FT. DEPTH BELOW INLET 7 1/2 FT.

ABSORBENT AREA 675 SQ. FT.

REMARKS

5/1/79 OK to add gravel to trenches & dig well. Install
clean out to cast iron pipe to capture & dig well. If
5/4/79 Checked found - c. I all the way to D Wall; paper on
thick to 3' of grade. C.B.D.

DATE SYSTEM APPROVED

INSPECTOR

C.B. Thresh

APPLICATION

A 26377

SEWAGE DISPOSAL TESTING

P _____

STATE OF MARYLAND - DEPARTMENT OF HEALTH AND MENTAL HYGIENE

DISTRICT 5th

HOWARD COUNTY HEALTH DEPARTMENT
ENVIRONMENTAL HEALTH SERVICES
P. O. BOX 476, ELLICOTT CITY, MARYLAND 21043
TELEPHONE: 465-5000, EXT. 356

DATE JUNE 28, 1977

TO: THE COUNTY HEALTH OFFICER
ELLICOTT CITY, MARYLAND

I, HEREBY, APPLY FOR THE NECESSARY TEST IN ORDER TO CONSTRUCT (OR RECONSTRUCT) A SEWAGE DISPOSAL SYSTEM.

PROPERTY OWNER JOHN MIKOLASKO

ADDRESS 2205 FOXLEY ROAD PHONE 252-3478

PROPERTY LOCATION: TIMONIUM, MD, 21093

SUBDIVISION HALL MARK SECTION 2 LOT NO. 33
34

ROAD AND DESCRIPTION HALL MARK ROAD

SIZE OF LOT 1 ACRE (±) TYPE BLDG. 3 or 4
NUMBER OF BEDROOMS

IF NOT SINGLE RESIDENCE DESCRIBE _____

THE SYSTEM INSTALLED UNDER THIS APPLICATION IS ACCEPTABLE ONLY UNTIL PUBLIC FACILITIES BECOME AVAILABLE.

SIGNATURE OF APPLICANT JOHN MIKOLASKO by James L. Neuborn

APPROVED BY _____ FOR _____ DATE _____
(KIND OF SYSTEM)

REJECTED BY _____ FOR _____ DATE _____
(KIND OF SYSTEM)


HOLD PENDING FURTHER TESTS _____ DATE _____

REASONS FOR REJECTION OR HOLDING _____

BLDG. PERMIT SIGNED
AND RETURNED 2/23/79
serial # 38417

THIS IS NOT A PERMIT

32 33

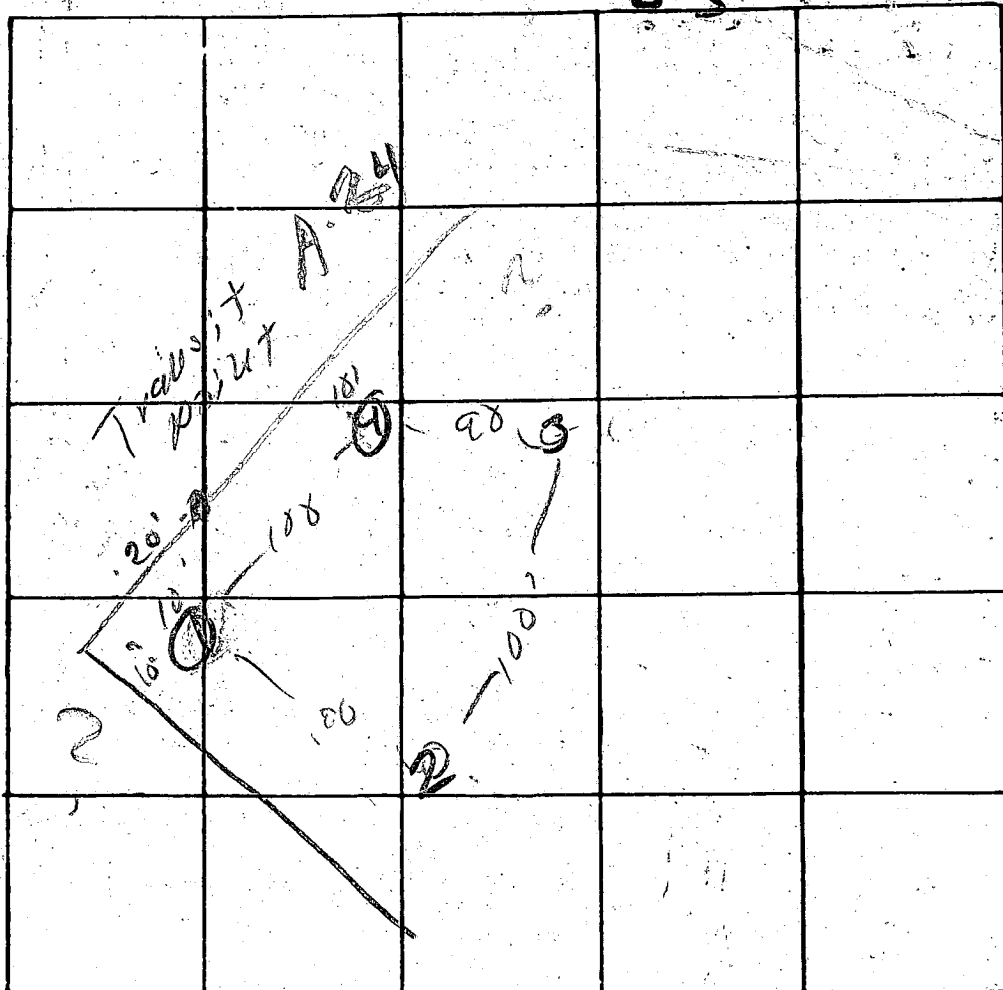

INDICATE NORTH - NAME ADJOINING ROADWAY AS BASE LINE

DATE	TEST NO.	DEPTH	PRE-WET		TEST - 1" DROP		TIME
			START	STOP	START	STOP	
2/19	15	41	344	346	346	348	2
	9	13'	400	402	402	405	5
	2	013	243	171			
	35	2'	346			351	3
	9	13'	346	350	350	358	8
	45	3'	351	352	352	354	2
	9	10'	351	353	353	355	2

REMARKS

TYPE OF SOIL

TESTED BY

ALSO PRESENT:

Dead End. Curricade

Drwg. D-103, Page 164

Extend Bituminous Mountable Curb around Tee
Turnaround to 2' Curb Opening

Limit of Submission - 17+10±

30 L.F. Parabolic Riprap Channel
Min. 59" Stone over Poly-Filter-X

20' Drainage
Easement

Parabolic Soddied Channel

Existing Swale

A. U. Oreville
878/253

1. Private w
utilized
2. Present i
3. Total num
4. Total num
5. Total ar
6. Total ar
7. Total ar
8. The lots
ownership
Maryland
Hygiene
9. Sediment
on the Fir
10. All constr
- County Ro
11. Lots 1 & 2

A. U. Oreville
878/253

OWNER

DONALD L. SIMPSON

STATE OF MARYLAND WATER RESOURCES ADMINISTRATION TAWES STATE OFFICE BLDG., ANNAPOLIS, MARYLAND 21401 APPLICATION FOR PERMIT TO DRILL WELL		WRA PERMIT NUMBER HO-23-2715 FILL IN THIS FORM COMPLETELY
1 2 3 (SEQ. NO.) 6 (THIS NUMBER IS TO BE PUNCHED IN COLS. 3-6 ON ALL CARDS) SEQUENCE NO. (WRA USE ONLY) DATE RECEIVED (WRA USE ONLY) 9/15/78 1:30 PM OWNER COL 15 LAST NAME Branth Development Corporation FIRST NAME 218 COL. 34 STREET OR RFD COL 36 Washington Building COL. 55 POST OFFICE COL 57 Columbia Md. COL. 76		
B 1 CONTINUED 1 2 3 (SEQ. NO.) 6 DATE April 6, 1978 LICENSE NUMBER 238 Joseph L. Mayne FIRST NAME DRILLER LAST NAME SIGNATURE Joseph L. Mayne DRILLER INFORMATION 1 2 3 (SEQ. NO.) 6 DATE April 6, 1978 LICENSE NUMBER 238 Joseph L. Mayne FIRST NAME DRILLER LAST NAME SIGNATURE Joseph L. Mayne		B 3 1 2 3 (SEQ. NO.) 6 COUNTY Howard SUBDIVISION Hall Mark SECTION E LOT 33 NEAREST TOWN Fulton MILES FROM TOWN (ENTER 0 IF IN TOWN) 2 1/2 LOCATION OF WELL 1 2 3 (SEQ. NO.) 6 COUNTY Howard SUBDIVISION Hall Mark SECTION E LOT 33 NEAREST TOWN Fulton MILES FROM TOWN (ENTER 0 IF IN TOWN) 2 1/2
B 2 1 2 3 (SEQ. NO.) 6 MAXIMUM PUMPING RATE (GALLONS PER MINUTE) 5 AVERAGE DAILY QUANTITY NEEDED (GALLONS PER DAY) 750 USE FOR WATER (CIRCLE APPROPRIATE BOX) ☒ HOME (SINGLE OR DOUBLE HOUSEHOLD UNIT ONLY) ☐ FARMING, AGRICULTURE, IRRIGATION ☐ INDUSTRIAL, COMMERCIAL, STATE AND FEDERAL GOVERNMENT. ☐ MUNICIPAL WATER SUPPLY ☐ PRIVATE WATER COMPANY ☐ TEST MUST HAVE STATE HEALTH DEPT. APPROVAL WELL INFORMATION 1 2 3 (SEQ. NO.) 6 MAXIMUM PUMPING RATE (GALLONS PER MINUTE) 5 AVERAGE DAILY QUANTITY NEEDED (GALLONS PER DAY) 750 USE FOR WATER (CIRCLE APPROPRIATE BOX) ☒ HOME (SINGLE OR DOUBLE HOUSEHOLD UNIT ONLY) ☐ FARMING, AGRICULTURE, IRRIGATION ☐ INDUSTRIAL, COMMERCIAL, STATE AND FEDERAL GOVERNMENT. ☐ MUNICIPAL WATER SUPPLY ☐ PRIVATE WATER COMPANY ☐ TEST MUST HAVE STATE HEALTH DEPT. APPROVAL		B 4 1 2 3 (SEQ. NO.) 6 COUNTY Howard SUBDIVISION Hall Mark SECTION E LOT 33 NEAREST TOWN Fulton MILES FROM TOWN (ENTER 0 IF IN TOWN) 2 1/2 DIRECTION FROM TOWN (CIRCLE APPROPRIATE BOX) ☒ NORTH ☐ EAST ☐ SOUTHEAST ☐ WEST ☐ SOUTH ☐ WEST ☐ NORTHWEST ☐ SOUTHWEST NEAR WHAT ROAD Hall Mark Rd ON WHICH SIDE OF ROAD (CIRCLE APPROPRIATE BOX) ☒ NORTH ☐ SOUTH ☐ EAST ☐ WEST DISTANCE FROM ROAD (ENTER DISTANCE AND CIRCLE APPROPRIATE BOX) 325
APPROXIMATE DEPTH OF WELL 500 FEET APPROXIMATE DIAMETER OF WELL 6 (NEAREST INCH) METHOD OF DRILLING USED (CIRCLE APPROPRIATE METHOD) ☒ BORED (OR AUGERED) ☐ JETTED ☐ DRIVEN ☒ AIR-ROTARY ☐ AIR-PERCUSSION ☐ ROTARY (HYDRAULIC ROTARY) ☐ CABLE ☐ REVERSE-ROTARY ☐ DRIVE-POINT OTHER (DESCRIBE) REPLACEMENT OR DEEPENED WELLS (CIRCLE APPROPRIATE BOX) ☒ THIS WELL WILL NOT REPLACE AN EXISTING WELL ☐ THIS WELL WILL REPLACE A WELL THAT WILL BE ABANDONED AND SEALED ☐ THIS WELL WILL REPLACE A WELL THAT WILL BE USED AS A STANDBY ☐ THIS WELL WILL DEEPEAN AN EXISTING WELL PERMIT NUMBER OF WELL TO BE REPLACED OR DEEPEANED (IF AVAILABLE)		B 4 1 2 3 (SEQ. NO.) 6 COUNTY Howard SUBDIVISION Hall Mark SECTION E LOT 33 NEAREST TOWN Fulton MILES FROM TOWN (ENTER 0 IF IN TOWN) 2 1/2 DIRECTION FROM TOWN (CIRCLE APPROPRIATE BOX) ☒ NORTH ☐ EAST ☐ SOUTHEAST ☐ WEST ☐ SOUTH ☐ WEST ☐ NORTHWEST ☐ SOUTHWEST NEAR WHAT ROAD Hall Mark Rd ON WHICH SIDE OF ROAD (CIRCLE APPROPRIATE BOX) ☒ NORTH ☐ SOUTH ☐ EAST ☐ WEST DISTANCE FROM ROAD (ENTER DISTANCE AND CIRCLE APPROPRIATE BOX) 325
NOT TO BE FILLED IN BY DRILLER (WRA USE ONLY) APPROPRIATION PERMIT NUMBER 54 ENGINEER REVIEW DISTRICT NO. 63 FORCE 67 WRITE INITIALS IN BOX 68 CONDITIONS 70 71 72 73 74 75 76 77 78 79 HEALTH DEPARTMENT APPROVAL 1 2 3 (SEQ. NO.) 6 COUNTY NAME Howard COUNTY NO. W27793 DATE 04 12 78 APPROVED BY Donald W. Monaghan, Sanitarian		B 5 1 2 3 (SEQ. NO.) 6 SPECIAL CONDITIONS 8-63 (WRA USE ONLY) BOX NUMBER E 830 N 480

OK
9/15/78
well
39'-OPEN HOLE
10'-BAGS CEMENT
3 1/10 mi
John Hopkins Rd
Fulton

NORTH COORDINATE 50 51 52 53 54 55 485000	EAST COORDINATE 57 58 59 60 61 62 63 0804000
ELEVATION AT WELL HEAD (FEET) 65 66 67 68 0/0	ELEVATION AT WELL HEAD (FEET) 65 66 67 68 5/0

C 1		9870		SEQUENCE NO. (WRA USE ONLY)		STATE OF MARYLAND WATER RESOURCES ADMINISTRATION TAWES STATE OFFICE BLDG., ANNAPOLIS, MD. 21401 WELL COMPLETION REPORT				THIS REPORT MUST BE SUBMITTED WITHIN 30 DAYS AFTER WELL COMPLETION. FILL IN THIS FORM COMPLETELY COUNTY NUMBER			
DATE RECEIVED (WRA USE ONLY)		DATE WELL COMPLETED		DEPTH OF WELL		PERMIT NO. FROM "PERMIT TO DRILL WELL"				DRILLERS IDENTIFICATION NO.			
1 2 3 (SEQ. NO.) 6		1 2 3 (SEQ. NO.) 6		22 (TO NEAREST FOOT) 26		40-73-2715				28 29 30 31 32 33 34 35 36 37			
OWNER		LAST NAME		STREET OR RFD		POST OFFICE		FIRST NAME					
WELL DESCRIPTION													
WELL LOG				GROUTING RECORD									
STATE THE KIND OF FORMATIONS PENETRATED, THEIR COLOR, DEPTH, THICKNESS AND IF WATER BEARING				WELL HAS BEEN GROUTED (CIRCLE APPROPRIATE BOX)									
DESCRIPTION (USE ADDITIONAL SHEETS IF NECESSARY)				TYPE OF GROUTING MATERIAL (CIRCLE BOX)									
FEET				CEMENT									
FROM TO				BENTONITE/CLAY									
CHECK IF WATER BEARING				NO. OF BAGS NO. OF POUNDS									
Sand 0 35				GALLONS OF WATER									
35 185				DEPTH OF GROUT SEAL (TO NEAREST FOOT)									
Op 1 very much to back				FROM FT. TO FT.									
				(ENTER 0 IF FROM SURFACE)									
				CASING RECORD									
				MAIN CASING TYPE									
				NOMINAL DIAMETER TOP (MAIN) CASING (NEAREST INCH)									
				TOTAL DEPTH OF MAIN CASING (NEAREST FOOT)									
				OTHER CASING (IF USED)									
				DIA. (INCH) DEPTH (FEET)									
				SCREEN RECORD									
				SCREEN TYPE OR OPEN HOLE									
				DEPTH (NEAREST WHOLE FOOT)									
				FROM TO									
				CIRCLING APPROPRIATE BOXES									
				A WELL WAS ABANDONED AND SEALED WHEN THIS WELL WAS COMPLETED									
				ELECTRIC LOG OBTAINED									
				TEST WELL CONVERTED TO PRODUCTION WELL									
				I HEREBY CERTIFY THAT I HAVE COMPLIED WITH ALL CONDITIONS STATED ON THE ABOVE-CAPTIONED "PERMIT TO DRILL WELL", AND THAT INFORMATION CONTAINED IN THIS REPORT IS TRUE, ACCURATE, AND COMPLETE TO THE BEST OF MY KNOWLEDGE, INFORMATION AND BELIEF.									
				DRILLERS NAME									
				WRA USE ONLY (NOT TO BE FILLED IN BY DRILLER)									
				TELESCOPE CASING LOG INDICATOR									
				LOCATION OF WELL ON LOT									
				SHOW PERMANENT STRUCTURE SUCH AS BUILDINGS, SEPTIC TANKS, AND/OR OTHER LAND MARKS AND INDICATE NOT LESS THAN TWO DISTANCES (MEASUREMENTS TO WELL).									

