

04-339495

app 5-29-80
D

PERMIT

SEWAGE DISPOSAL SYSTEM

MARYLAND STATE DEPARTMENT OF HEALTH

HOWARD COUNTY

P. 30183

A. 26584

ELLICOTT CITY

DISTRICT 4th

DATE 9/14/79

INDEXED

James Gue

IS PERMITTED TO INSTALL ☒ ALTER

ADDRESS Damascus, Maryland

PHONE 831-6288

SUBDIVISION Westcliffe Manor

ROAD 13759 Barberry Way

LOT 25

PROPERTY OWNER Gordon E. Jenkins James + Judith Pembroke

ADDRESS 504 Morelock School Road, Westminster, Md. 21157

Phone: 806-6896

SPECIFICATIONS 4 bedrooms

SEPTIC TANK CAPACITY 1250 GALLONS

DRAIN FIELD DEPTH FEET, BOTTOM AREA SQ. FT.

DEEP TRENCH DEPTH FEET, BOTTOM AREA SQ. FT.

SEEPAGE PITS ☒ ABSORBENT SIDE-WALL AREA 125 SQ. FT. per bedroom.

INLET PIPE 3 FT. BELOW ORIGINAL GRADE. MAXIMUM DEPTH 11 FT. BELOW ORIGINAL GRADE

EFFECTIVE DEPTH AT FT. BELOW ORIGINAL GRADE.

LOCATE DISPOSAL AREA 35 FT. FROM left LOT LINE AND 120 FT. FROM Barberry Way
FACING LOT FROM road.

PLANS APPROVED BY Charles B. Streaker

DATE 6/29/78

COVER NO WORK UNTIL INSPECTED AND APPROVED.

NEITHER THE HOWARD COUNTY COUNCIL NOR THE HEALTH DEPARTMENT IS RESPONSIBLE FOR THE SUCCESSFUL OPERATION OF ANY SYSTEM.

NOTE: IF TRENCH IS USED CALL FOR INSPECTION BEFORE PLACING GRAVEL IN TRENCH.

NOTE: NO DRY WELL SHALL EXCEED 15 FOOT IN DIAMETER.

NOTE: ALL PIPE FROM HOUSE TO DISPOSAL AREA MUST BE CAST IRON.

PERMIT VOID AFTER THREE YEARS.

NOTE: INSTALL STAND PIPE ON SEPTIC TANK AND DRY WELL. STAND PIPES MUST BE 6 INCHES IN DIAMETER. CAST IRON, CONCRETE OR TERRA
COTTA ACCEPTED.

*INSTALLER IS RESPONSIBLE FOR OBTAINING FINAL APPROVAL ON THIS PERMIT.

HD - 23

BLDG. PERMIT SIGNED

AND RETURNED 3/18/82

Serial # 48974


Profl.

A 26584

13759 Barbary Way
West Cliff Manor lot 25

(A26584)

BARBERRY WAY

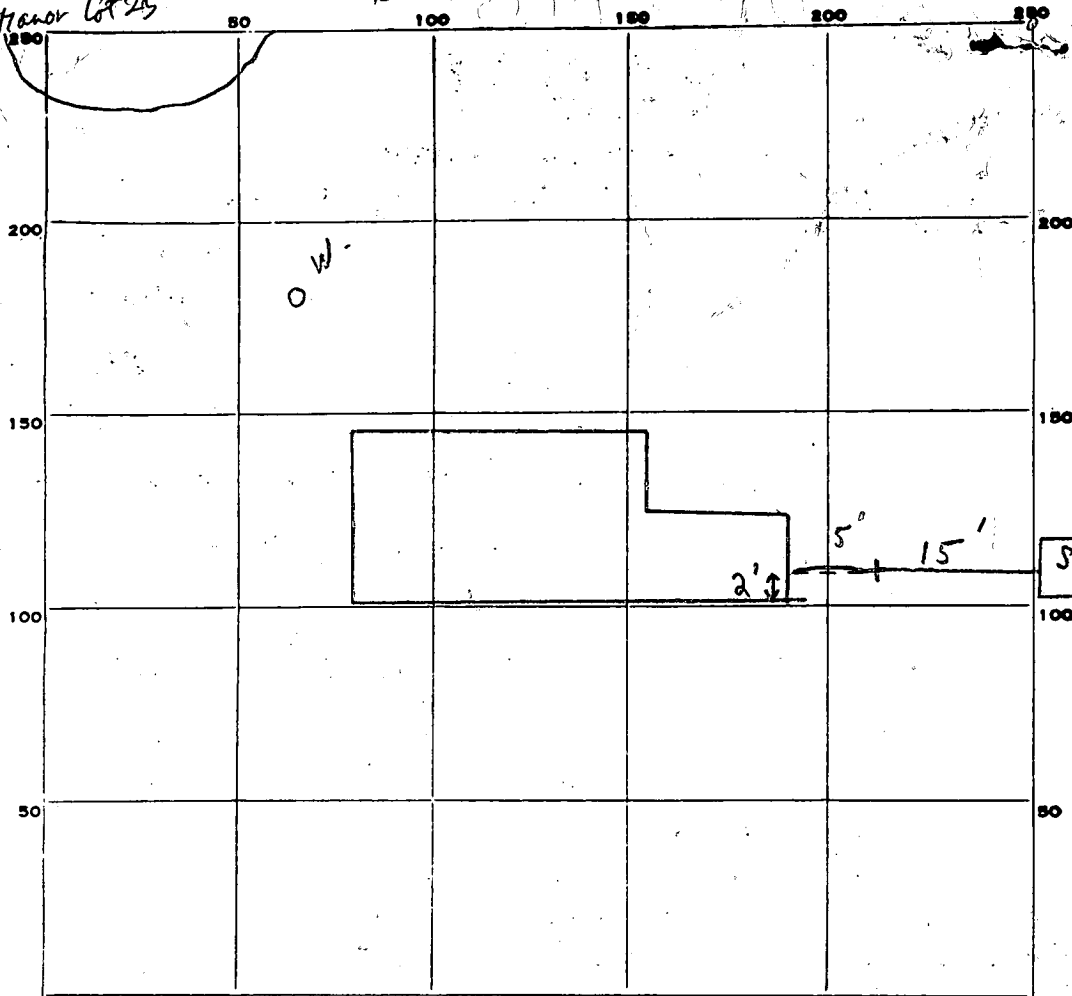

INDICATE NORTH. - NAME ADJOINING ROADWAY AS BASE LINE.

PERMIT CARD ☒

SEPTIC TANK, LEVEL ☒

CLEANOUTS ☒ S.T. ☒ D.W. ☒

DISTRIBUTION BOX, LEVEL _____

TILE FIELD, DEPTH _____ FT. TRENCH WIDTH _____ FT.

GRAVEL DEPTH _____ IN. TOTAL LENGTH _____ FT.

NUMBER OF TRENCHES _____ TOTAL BOTTOM AREA _____

SEEPAGE PITS, INSIDE DIAMETER 60.5 FT. DEPTH BELOW INLET 8 ⁺ FT.

ABSORBENT AREA 484 ⁺ SQ. FT.

REMARKS 11/27/79 PARTIAL - OK TO COVER FROM DRY WELL TO 8' OF
HOUSE. NEED HOUSE CONNECTION.
C.B.S.

5/29/80 OK per letter

DATE SYSTEM APPROVED 5/29/80

INSPECTOR SLW. Manup

PRELIMINARY

C.B. *write specs.*

APPLICATION

New #25
OK

26584
~~26586~~

SEWAGE DISPOSAL TESTING

STATE OF MARYLAND - DEPARTMENT OF HEALTH AND MENTAL HYGIENE

HOWARD COUNTY HEALTH DEPARTMENT
ENVIRONMENTAL HEALTH SERVICES

P. O. BOX 476, ELLICOTT CITY, MARYLAND 21043
TELEPHONE: 465-5000, EXT. 356

1-3 Bedrooms { 1000 gallons
4 Bedrooms { 1250
DATE 8/15/77

Septic Tank
Dry well to have 125 sq ft. effective
absorbent sidewall area per bedroom below inlet.
Below original inlet 3' and maximum depth 11'. Location per plat:
35' off left property and 120' off Barbary Way
when facing lot from road.

TO: THE COUNTY HEALTH OFFICER
ELLICOTT CITY, MARYLAND

BLDG. PERMIT SIGNED
AND RETURNED 8-28-78

I, HEREBY, APPLY FOR THE NECESSARY TEST IN ORDER TO CONSTRUCT (OR RECONSTRUCT) A SEWAGE
DISPOSAL SYSTEM.

Gordon E. Jenkins

PROPERTY OWNER *J. & B Partnership*

ADDRESS *504 Monelock School Rd.* 876-6896
5632 Stevens Forest Rd., Apt. 254, Columbia 21045 PHONE *Ron Carter - 837-0194*
Westminster, Md 21157

PROPERTY LOCATION:

SUBDIVISION *Westcliffe Manor*

ROAD AND DESCRIPTION *off Underwood Road 13759 Barbary Way*
Sykesville, Md 21784

SIZE OF LOT *68,000 sq. ft.* TYPE BLDG. *3 or 4 bedrooms*
NUMBER OF BEDROOMS

IF NOT SINGLE RESIDENCE DESCRIBE

THE SYSTEM INSTALLED UNDER THIS APPLICATION IS ACCEPTABLE ONLY UNTIL PUBLIC
FACILITIES BECOME AVAILABLE.

SIGNATURE OF APPLICANT */s/ Ron Carter*


APPROVED BY *C. B. Streaker* FOR *dry well & trench* DATE *6/29/78*
(KIND OF SYSTEM)

REJECTED BY FOR DATE
(KIND OF SYSTEM)

HOLD PENDING FURTHER TESTS DATE

REASONS FOR REJECTION OR HOLDING

THIS IS NOT A PERMIT

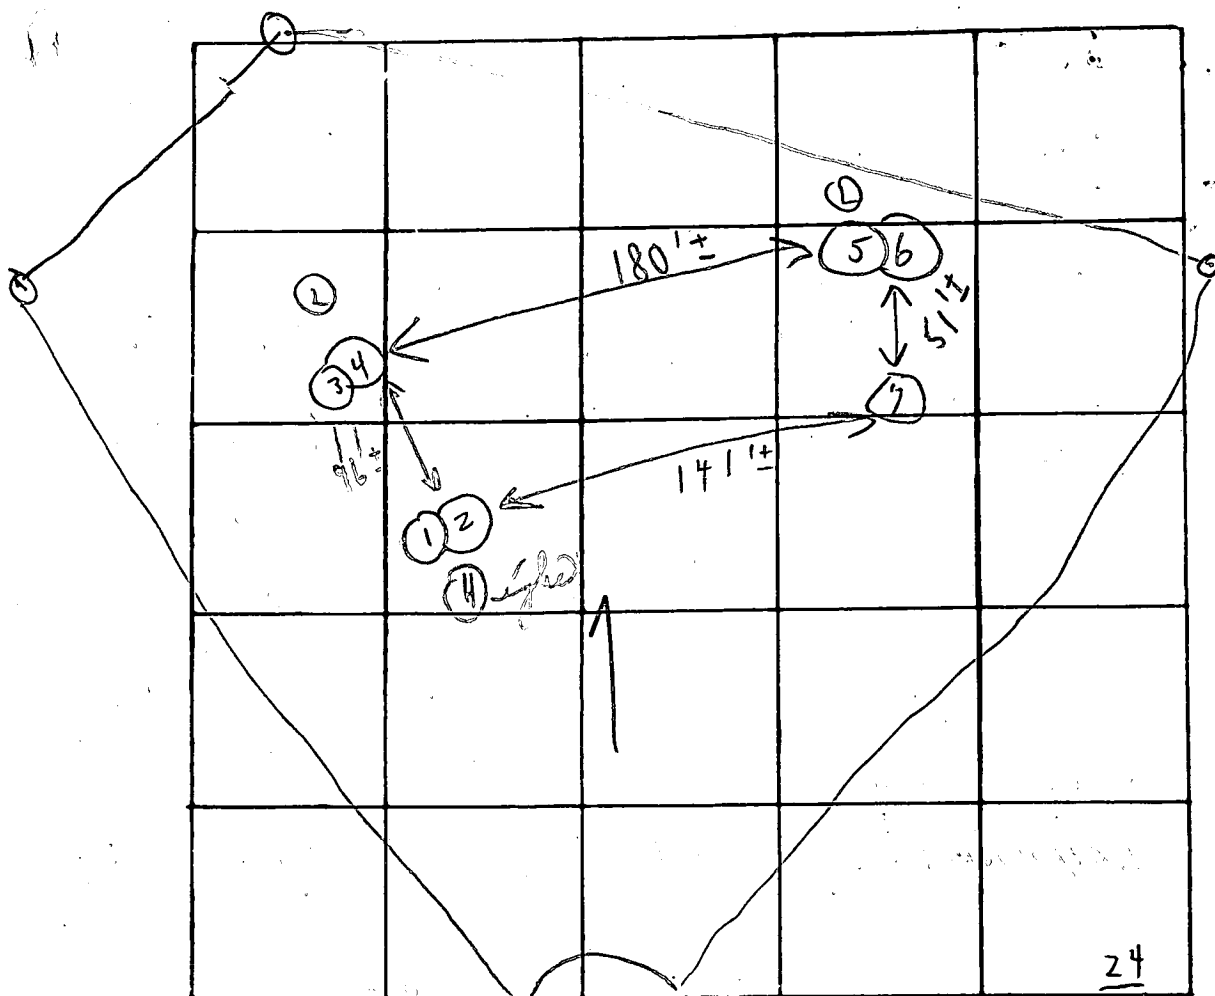

INDICATE NORTH. - NAME ADJOINING ROADWAY AS BASE LINE

DATE	TEST NO.	DEPTH	PRE-WET		TEST - 1" DROP		TIME
			START	STOP	START	STOP	
9/2/77	1	2 1/2'	10:47	10:51	10:51	10:56	5m
	2	12'	10:47	10:48	10:48	10:51	3m
	3	4'	10:48	10:50	10:50	10:53	3m
	4	14'	10:49	10:52	10:52	10:57	5m
	5	4 1/2'	10:40	10:43	10:43	10:54	11m
	6	13'	10:40	10:43	10:43	10:54	11m
	7	9'	Visual	Hold	for	super	2'-3'
						6	38

REMARKS

TYPE OF SOIL

TESTED BY

ALSO PRESENT:

Sid Profile

form below city

Under 2 1/2'

Good soil 2'-3' 7m

Open

C B A

Fryck + men

PRELIMINARY

APPLICATION

26583
A ~~26585~~

SEWAGE DISPOSAL TESTING

P _____

STATE OF MARYLAND - DEPARTMENT OF HEALTH AND MENTAL HYGIENE

HOWARD COUNTY HEALTH DEPARTMENT
ENVIRONMENTAL HEALTH SERVICES

P O. BOX 476, ELLICOTT CITY, MARYLAND 21043
TELEPHONE: 465-5000, EXT. 356

DISTRICT 4th
DATE 8/15/77

TO: THE COUNTY HEALTH OFFICER
ELLICOTT CITY, MARYLAND

I, HEREBY, APPLY FOR THE NECESSARY TEST IN ORDER TO CONSTRUCT (OR RECONSTRUCT) A SEWAGE DISPOSAL SYSTEM.

PROPERTY OWNER J & B Partnership

ADDRESS 5632 Stevens Forest Rd., Apt. 254, Columbia, 21045 Any questions call
PHONE Ron Carter - 837-0194

PROPERTY LOCATION:

SUBDIVISION Westcliffe Manor

ROAD AND DESCRIPTION off Underwood Road

SIZE OF LOT 56,500 sq. ft. TYPE BLDG. 3 or 4 bedrooms

NUMBER OF BEDROOMS

IF NOT SINGLE RESIDENCE DESCRIBE _____

THE SYSTEM INSTALLED UNDER THIS APPLICATION IS ACCEPTABLE ONLY UNTIL PUBLIC FACILITIES BECOME AVAILABLE.

SIGNATURE OF APPLICANT /s/ Ron Carter


APPROVED BY _____ FOR _____ DATE _____
(KIND OF SYSTEM)

REJECTED BY _____ FOR _____ DATE _____
(KIND OF SYSTEM)

HOLD PENDING FURTHER TESTS _____ DATE _____

REASONS FOR REJECTION OR HOLDING _____

THIS IS NOT A PERMIT

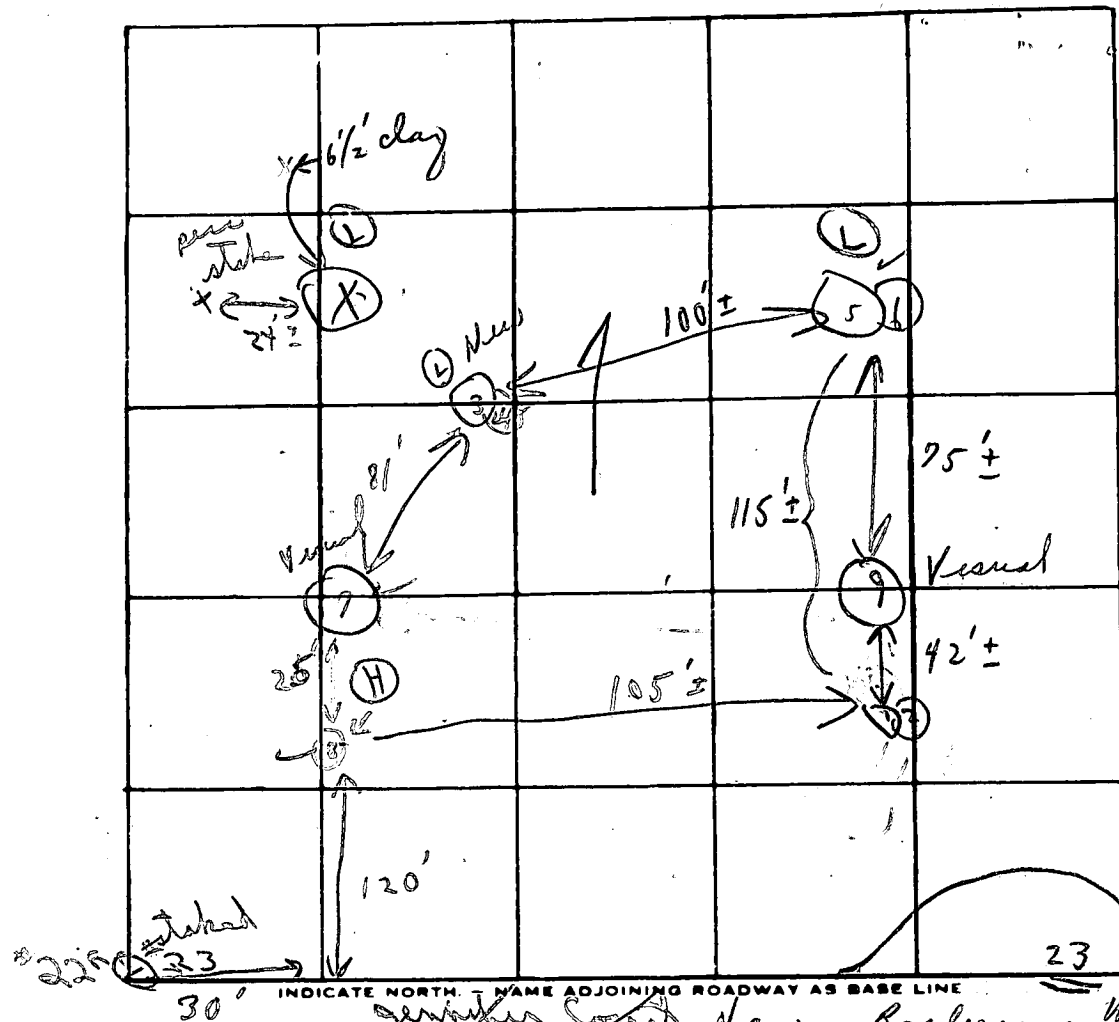

New #25

Use

DATE	TEST NO.	DEPTH	PRE-WET		TEST - 1" DROP		TIME
			START	STOP	START	STOP	
7/2/77	1	3'	1:38	1:43	1:43	1:50	7m
	(H) 2	12 1/2'	1:38	1:40	1:40	1:44	4m
	3	3'	1:36	1:37	1:37	1:40	3m
	4	12'	1:36	1:40	1:40	1:47	7m
	5	3'	1:34	1:36	1:36	1:40	4m
	6	12'	1:34	1:36	1:36	1:40	4m
	7	11 1/2'	Visual sandy loam				129
	8	11'	Visual sandy loam				
	9	12 1/2'	Visual sandy loam				

REMARKS

Open field

TYPE OF SOIL

TESTED BY

C. B. D.

ALSO PRESENT:

F. Gock + men

Sail Profile


from below


5m

Indel 3'

5m average

125 sq ft per bedroom

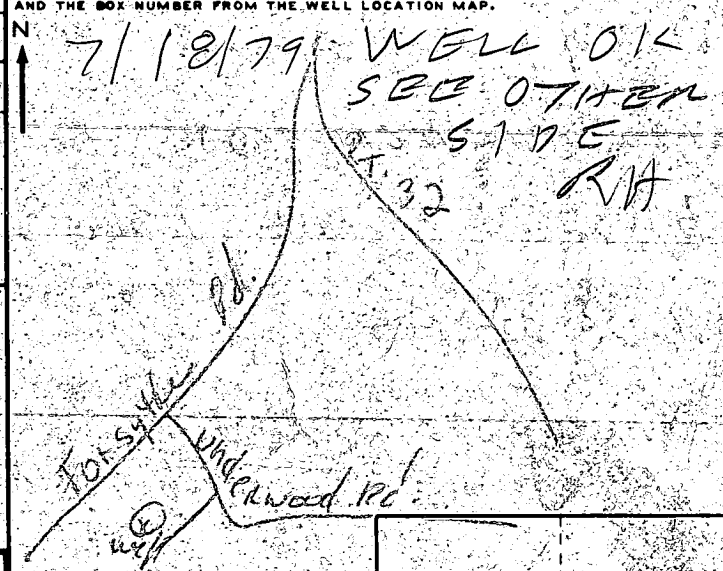B 1 7703 SEQUENCE NO. (WRA USE ONLY)		STATE OF MARYLAND WATER RESOURCES ADMINISTRATION TAWES STATE OFFICE BLDG., ANNAPOLIS, MARYLAND 21401 APPLICATION FOR PERMIT TO DRILL WELL				WRA PERMIT NUMBER 40-73-3371 FILL IN THIS FORM COMPLETELY	
DATE RECEIVED (WRA USE ONLY) 7/18/79 1:00 P.M.		OWNER <u>Toshine Gordon</u> COL 15 LAST NAME FIRST NAME COL. 34 STREET OR RFD <u>218 E. Main St.</u> COL 36 COL. 55 POST OFFICE <u>Westminster, Md 21157</u> COL 57 COL. 76					
B 1 CONTINUED 1 2 3 (SEQ. NO.) 6 DATE <u>June 20, 1970</u> LICENSE NUMBER <u>200</u> 77 80 <u>C. C. Campbell & Co. Inc.</u> FIRST NAME DRILLER LAST NAME SIGNATURE <u>Charles C. Campbell</u>		B 3 LOCATION OF WELL 1 2 3 (SEQ. NO.) 6 COUNTY <u>Howard</u> (DO NOT ABBREVIATE COUNTY NAME) 21 SUBDIVISION <u>Westcliff Manor</u> 23 42 SECTION <u>44</u> 46 LOT <u>25</u> 48 50 NEAREST TOWN <u>Sylva</u> 52 71 MILES FROM TOWN (ENTER 0 IF IN TOWN) <u>3</u> 73 76 77 78				B 4 DIRECTION FROM TOWN (CIRCLE APPROPRIATE BOX) 1 2 3 (SEQ. NO.) 6 N NORTH E EAST NE NORTHEAST SE SOUTHEAST S SOUTH W WEST NW NORTHWEST SW SOUTHWEST NEAR WHAT ROAD <u>Underwood Rd</u> NORTH SOUTH EAST WEST 30 ON WHICH SIDE OF ROAD (CIRCLE APPROPRIATE BOX) N 32 S 32 E 32 W 32 DISTANCE FROM ROAD (ENTER DISTANCE AND CIRCLE APPROPRIATE BOX) <u>100'</u> 34 37 38 39	
B 2 WELL INFORMATION 1 2 3 (SEQ. NO.) 6 MAXIMUM PUMPING RATE (GALLONS PER MINUTE) <u>5</u> 8 12 AVERAGE DAILY QUANTITY NEEDED (GALLONS PER DAY) <u>500</u> 14 20 USE FOR WATER (CIRCLE APPROPRIATE BOX) ☒ HOME (SINGLE OR DOUBLE HOUSEHOLD UNIT ONLY) ☐ FARMING, AGRICULTURE, IRRIGATION ☐ INDUSTRIAL, COMMERCIAL, STATE AND FEDERAL GOVERNMENT. ☐ MUNICIPAL WATER SUPPLY ☐ PRIVATE WATER COMPANY } MUST HAVE STATE HEALTH DEPT. APPROVAL ☐ TEST		APPROXIMATE DEPTH OF WELL <u>200</u> 24 28 FEET APPROXIMATE DIAMETER OF WELL <u>6</u> (NEAREST INCH) METHOD OF DRILLING USED (CIRCLE APPROPRIATE METHOD) BORED (OR AUGURED) JETTED DRIVEN 30-37 AIR-ROTARY AIR-PERCUSSION ROTARY (HYDRAULIC ROTARY) CABLE REVERSE-ROTARY DRIVE-POINT OTHER (DESCRIBE)				DRAW A SKETCH BELOW SHOWING LOCATION OF WELL IN RELATION TO NEARBY TOWNS, ROADS AND STREAMS WITH NORTH IN THE DIRECTION OF THE ARROW, AND GIVE DISTANCE FROM WELL TO NEAREST ROAD JUNCTION OR STREAM CROSSING SHOWN ON THE SKETCH. ALSO SHOW, BY MEANS OF AN "X", THE WELL LOCATION IN THE BOX BELOW AND THE BOX NUMBER FROM THE WELL LOCATION MAP. N ↑ 7/18/79 WELL OK SEE OTHER SIDE T. 32 RH 	
REPLACEMENT OR DEEPEMED WELLS (CIRCLE APPROPRIATE BOX) ☒ THIS WELL WILL NOT REPLACE AN EXISTING WELL. ☐ THIS WELL WILL REPLACE A WELL THAT WILL BE ABANDONED AND SEALED ☐ THIS WELL WILL REPLACE A WELL THAT WILL BE USED AS A STANDBY ☐ THIS WELL WILL DEEPM AN EXISTING WELL. PERMIT NUMBER OF WELL TO BE REPLACED OR DEEPEMED (IF AVAILABLE) <u>41</u> 52		NOT TO BE FILLED IN BY DRILLER (WRA USE ONLY) APPROPRIATION PERMIT NUMBER <u>54</u> 63 65 ENGINEER REVIEW DISTRICT NO. <u>W26584</u> FORCE ☐ WRITE INITIALS IN BOX CONDITIONS ☐ A E N S G W Q C L U 67 68 70 71 72 73 74 75 76 77 78 79					
B 4 CONTINUED 1 2 3 (SEQ. NO.) 6 STATE HEALTH (CIRCLE BOX) <u>S</u> COUNTY NAME <u>Howard</u> COUNTY NO. <u>W26584</u> MO. DAY YR. <u>07</u> <u>05</u> <u>79</u> DATE <u>070579</u> APPROVED BY <u>Donald W. Monaghan, Sanitaria</u> 43 48		B 5 SPECIAL CONDITIONS 8-63 (WRA USE ONLY) 1 2 3 (SEQ. NO.) 6					

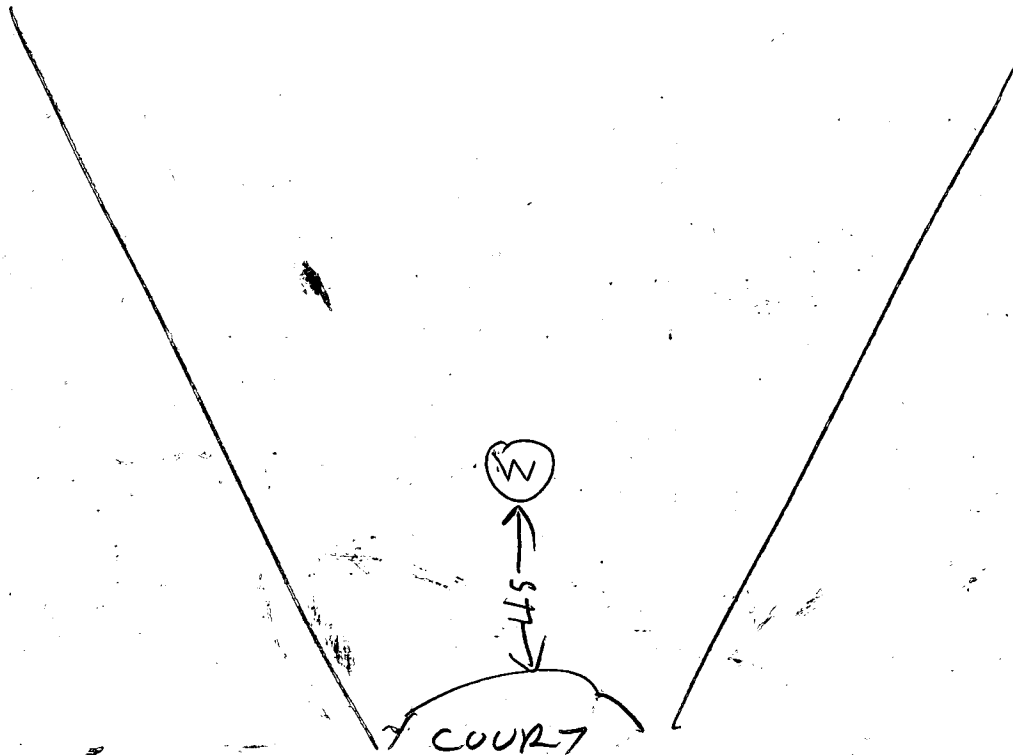

RECEIVED
HOWARD COUNTY
HEALTH DEPT.
ELLICOTT CITY, MD.

JUL 13 8 59 AM '79


- ① 34 FT CASING 2 FT ABOVE GROUND
- ② LOCATION OK
- ③ 32 FT OPEN HOLE MEASURED WITH A STRING
- ④ 6 BAGS
- ⑤ Well OK

7/12/79
Raymond Hodge

PLOT PLAN TO ACCOMPANY
APPLICATION FOR BUILDING PERMIT
LOT 25 - SECTION 2
WESTCLIFFE MANOR
4TH. ELECTION DISTRICT
HOWARD COUNTY, MARYLAND
SCALE: 1"=50' AUGUST 10, 1979

HEWITT
DRIVE

BARBERRY WAY

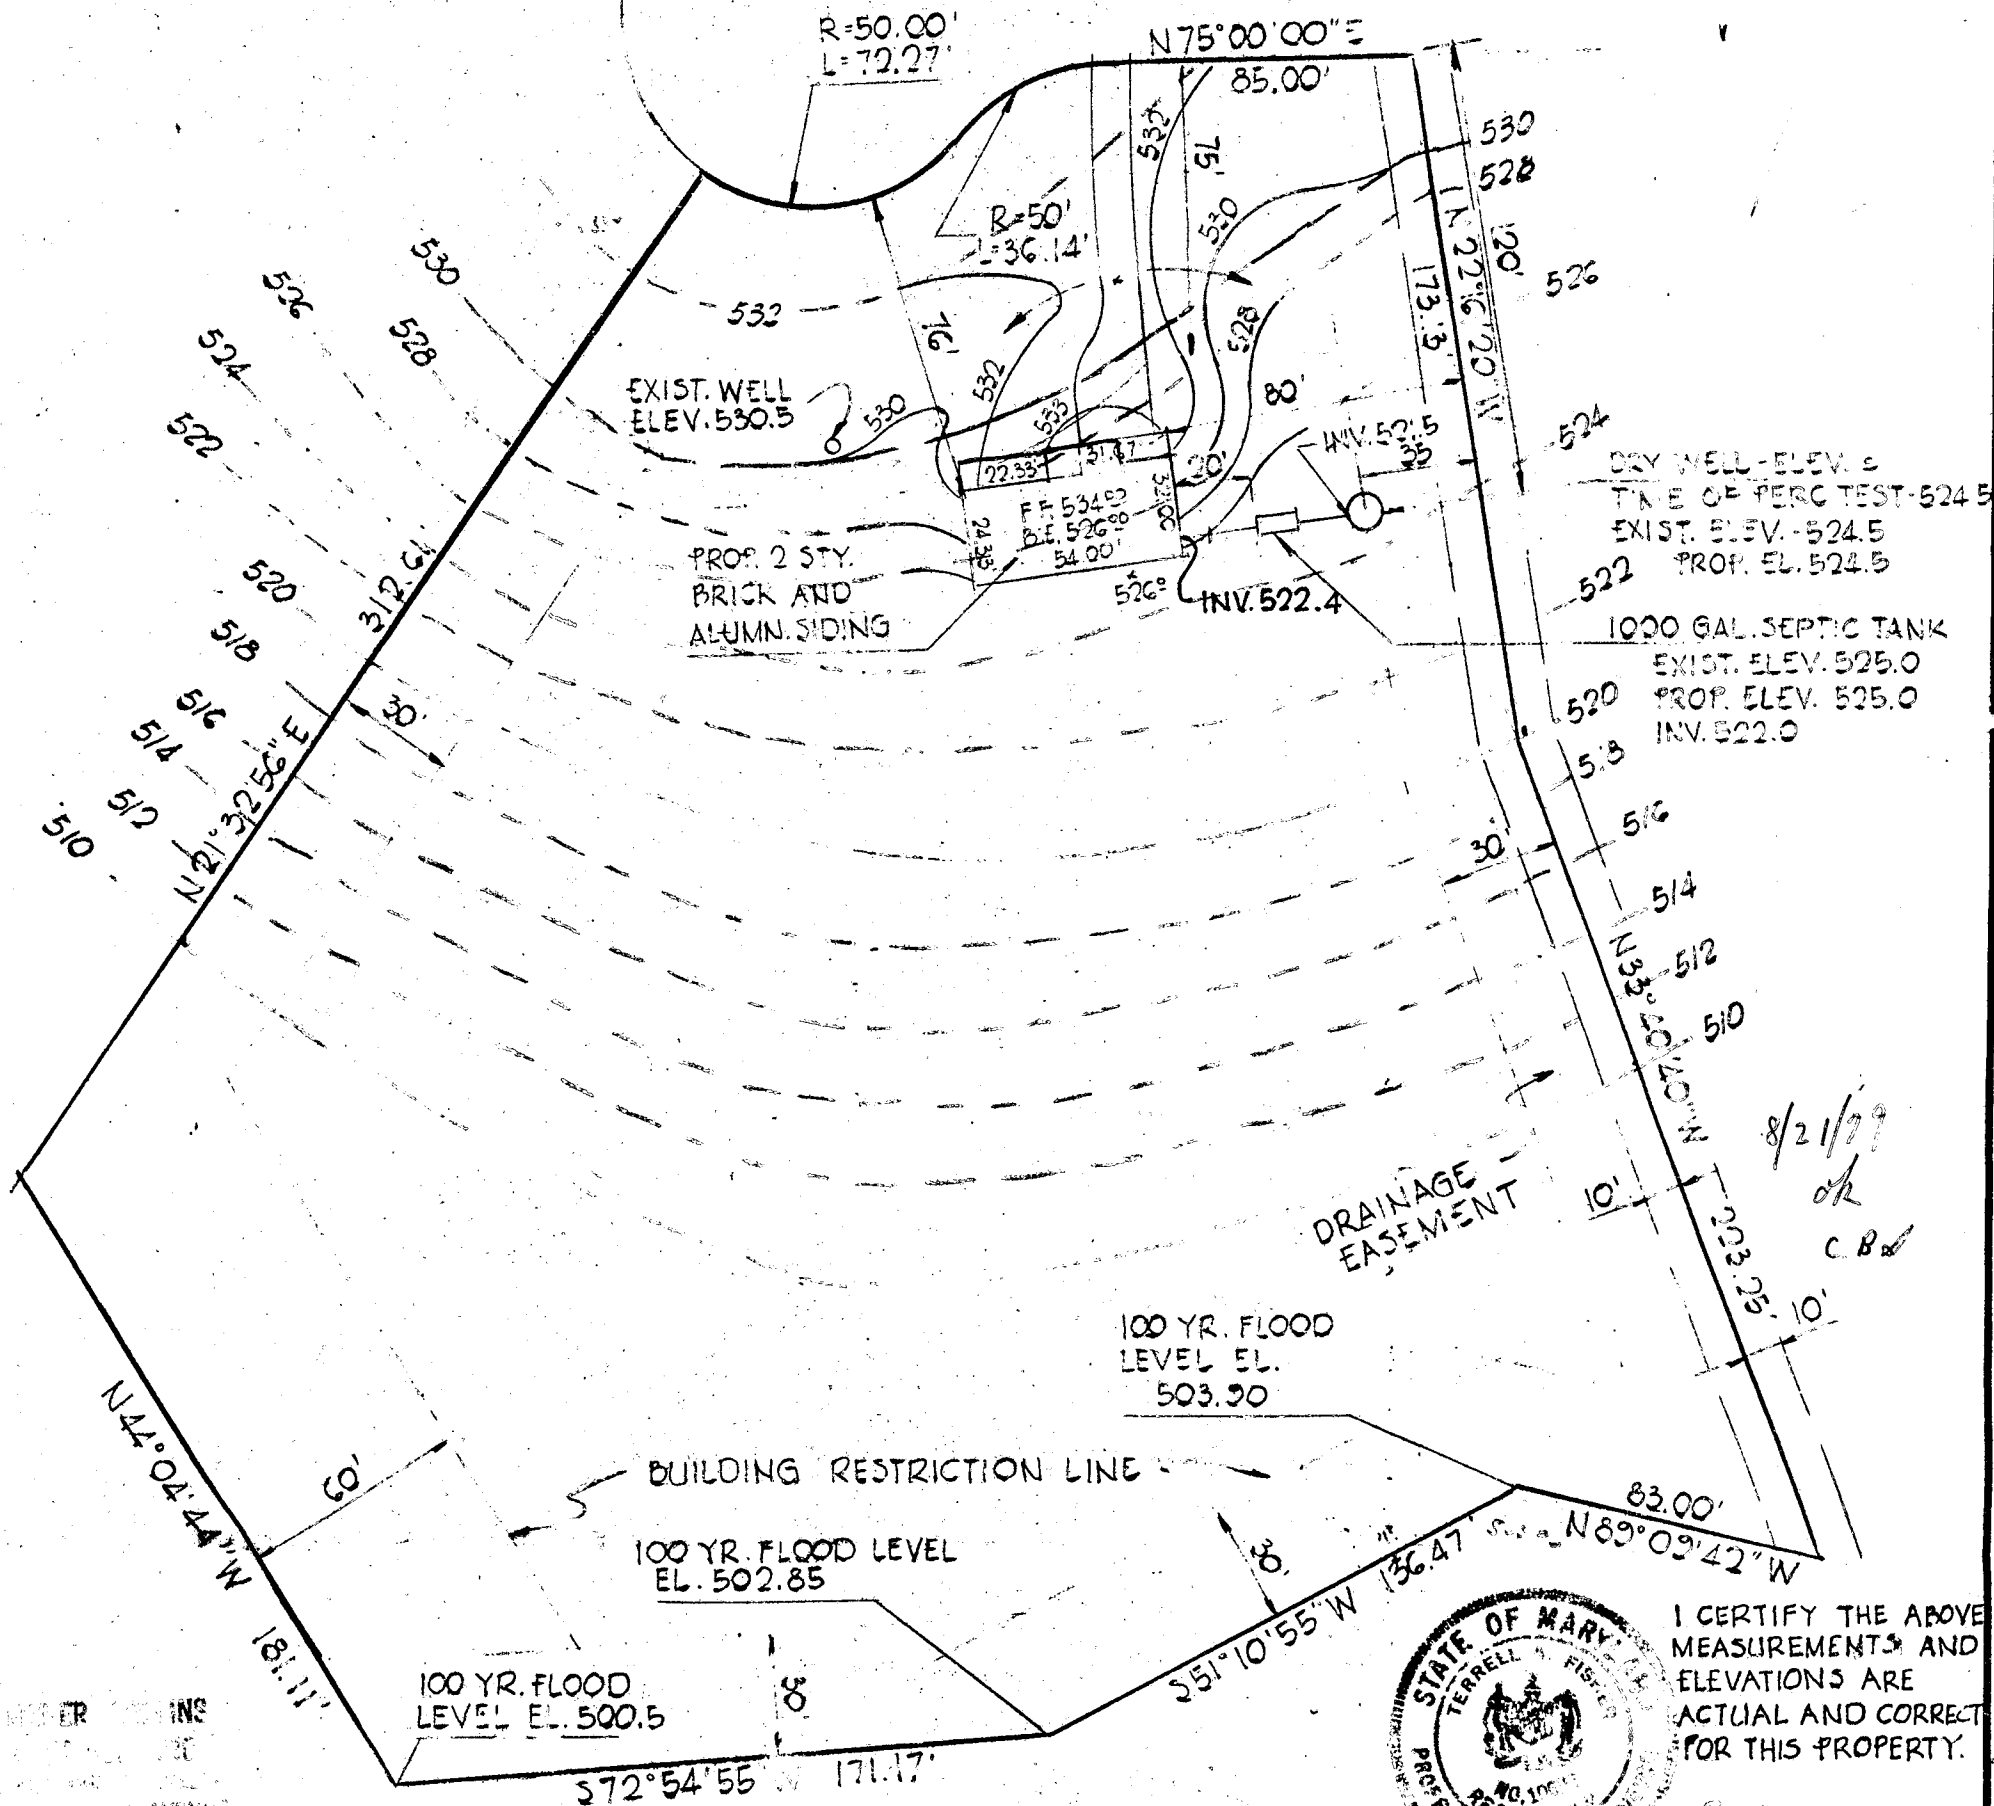

I CERTIFY THE ABOVE
MEASUREMENTS AND
ELEVATIONS ARE
ACTUAL AND CORRECT
FOR THIS PROPERTY.

TERRELL A. FISHER, #10692
AUG 10, 1979

1 2 3 (SEQ. NO.) 6
 (THIS NUMBER IS TO BE PUNCHED IN COLS. 3-6 ON ALL CARDS)

DATE RECEIVED (WRA USE ONLY)

DATE WELL COMPLETED

8-13

SEQUENCE NO.
(WRA USE ONLY)

STATE OF MARYLAND
 WATER RESOURCES ADMINISTRATION
 TAWES STATE OFFICE BLDG., ANNAPOLIS, MD. 21401
 WELL COMPLETION REPORT

THIS REPORT MUST BE SUBMITTED IN
IN 30 DAYS AFTER WELL COMPLETE

FILL IN THIS FORM COMPLETELY

COUNTY
NUMBER

PERMIT NO. FROM "PERMIT TO DRILL WELL"

40-72-3371

DRILLERS IDENTIFICATION NO. 240

OWNER: Inker LAST NAME: Inker FIRST NAME: William
 STREET OR RFD: 224 E Main St POST OFFICE: Westminster, MD 21157

WELL LOG

STATE THE KIND OF FORMATIONS PENETRATED, THEIR COLOR, DEPTH, THICKNESS AND IF WATER BEARING

DESCRIPTION (USE ADDITIONAL SHEETS IF NECESSARY)	FEET		CHECK IF WATER BEARING
	FROM	TO	
overburden	0	32	
gray rock	32	115	

WELL DESCRIPTION

GROUTING RECORD

WELL HAS BEEN GROUTED (CIRCLE APPROPRIATE "BOX")

YES ☒ Y NO ☐ N

TYPE OF GROUTING MATERIAL (CIRCLE BOX)

CEMENT ☒ CM BENTONITE CLAY ☐ BC

NO. OF BAGS 6 NO. OF POUNDS 504

GALLONS OF WATER 310

DEPTH OF GROUT SEAL (TO NEAREST FOOT)

FROM 0 FT. TO 32 FT.

(ENTER 0 IF FROM SURFACE)

CASING RECORD

INSERT APPROPRIATE CODE BELOW

STEEL ☒ ST CONCRETE ☐ CO

PLASTIC ☐ PL OTHER ☐ OT

MAIN CASING TYPE ☒ ST

NOMINAL DIAMETER TOP (MAIN) CASING (NEAREST INCH) 6

TOTAL DEPTH OF MAIN CASING (NEAREST FOOT) 34

OTHER CASING (IF USED)

DIAMETER (INCH) FROM TO

SCREEN RECORD

SCREEN TYPE OR OPEN HOLE

INSERT APPROPRIATE CODE BELOW

STEEL ☒ ST BRASS ☐ BR OPEN HOLE ☒ HO

PLASTIC ☐ PL OTHER ☐ OT

DEPTH (NEAREST WHOLE FOOT)

FROM 4 TO 175

SCREEN

DIAMETER OF SCREEN 56 (NEAREST INCH)

FROM 56 TO 60

GRAVEL PACK

IF WELL DRILLED WAS A FLOWING WELL CIRCLE BOX ☐ F

WRA USE ONLY (NOT TO BE FILLED IN BY DRILLER)

(E.R.O.S.)

TELESCOPE CASING ☐ T LOG INDICATOR ☐ L OTHER DATA AVAILABLE ☐ W O

PUMPING TEST

HOURS PUMPED (TO NEAREST HOUR) 6

PUMPING RATE (GALLONS PER MINUTE TO NEAREST GALLON) 15

METHOD USED TO MEASURE PUMPING RATE and bucket

WATER LEVEL: (DISTANCE FROM LAND SURFACE)

BEFORE PUMPING 35 (NEAREST FOOT)

WHEN PUMPING 70 (NEAREST FOOT)

TYPE OF PUMP USED (CIRCLE APPROPRIATE BOX) (FOR PUMPING TEST)

AIR ☐ A PISTON ☐ P TURBINE ☐ T

CENTRIFUGAL ☐ C ROTARY ☐ R OTHER (DESCRIBE BELOW) ☐ O

JET ☐ J SUBMERSIBLE ☒ S

PUMP INSTALLED

TYPE OF PUMP (WRITE APPROPRIATE LETTER IN BOX - SEE ABOVE: A, C, J, P, R, S, T, O)

DRILLER WILL INSTALL PUMP (CIRCLE APPROPRIATE BOX)

YES ☐ Y NO ☒ N

CAPACITY:

GALLONS PER MINUTE (TO NEAREST GALLON) 31

PUMP HORSE POWER 37

PUMP COLUMN LENGTH (NEAREST FOOT) 43

CASING HEIGHT (CIRCLE APPROPRIATE BOX AND ENTER CASING HEIGHT)

ABOVE ☒ + BELOW ☐ -

LAND SURFACE 2 (NEAREST FOOT)

LOCATION OF WELL ON LOT

SHOW PERMANENT STRUCTURE SUCH AS BUILDINGS, SEPTIC TANKS, AND/OR OTHER LAND MARKS AND INDICATE NOT LESS THAN TWO DISTANCES (MEASUREMENTS TO WELL).

CIRCLE APPROPRIATE BOXES

A A WELL WAS ABANDONED AND SEALED WHEN THIS WELL WAS COMPLETED

E ELECTRIC LOG OBTAINED

P TEST WELL CONVERTED TO PRODUCTION WELL

I HEREBY CERTIFY THAT I HAVE COMPLIED WITH ALL CONDITIONS STATED ON THE ABOVE-CAPTIONED "PERMIT TO DRILL WELL", AND THAT INFORMATION CONTAINED IN THIS REPORT IS TRUE, ACCURATE, AND COMPLETE TO THE BEST OF MY KNOWLEDGE, INFORMATION AND BELIEF.

DRILLERS NAME: Charles Campbell

SIGNATURE: Charles Campbell

NOTES:

- 1) DIG ASAP
- 2) DIET STAY
- 3) OWNER TO DETERMINE EXACT POOL LOCATION DAY OF EXCAVATION
- * 4) BAND OF TILE ON STEPS AND LOVESEAT

PLUMBING

- POOL
- A 28'-2" SUCTION
 - B 37'-1 1/2" SUCTION
 - C 23'-2" RETURN
 - D 6'-1 1/2" RETURN
- SUPER-VAC
- E 23'-1" ANTHOLY SUPER-VAC

GENERAL SPECIFICATIONS

SIZE	20' x 10' AREA	20' DEPTH 3' TO 8'
SHAPE	SAN CARLOS	PERIMETER 97
TEMPLATE NO.	0	CUSTOM 0
TILE SIZE	2" x 2" (NOE 4)	
TILE COLOR	SUNSHINE TEEBA BLUE	
COPING	ANTHOLY DELUXE	
COPING COLOR	TRAVERTINE	
POOL CAPACITY	20,000	GALS.
PUMP CAPACITY	113	G.P.M.
MOTOR H.P.	1	H.P.
FILTER	VA 52 PUSV	SO. FT.
FILTER RATE	104	G.P.M.
TURNOVER	30	HRS.
VACUUM LINE & SKIMMER	(1) 2" & (1) 1 1/2"	
RETURN LINE	(1) 2" & (1) 1 1/2"	
MAIN DRAIN	1 1/2"	
SKIMMER - MODEL	(2) AUTO-FLD	
BACKWASH TO	APOL	
	OF 1/2" FILL LINE	
ANTI-SYPHON VALVE	1 1/2"	
HEATER	0	SIZE 0 BTU
GASLINE BY	0	VENTED BY 0
LIGHT	(1) 500 WATT MARINE LIGHT	
CLOCK	(1) 220V STD	
ELECTRIC BY	OWNER-113	
ELECTRICAL BONDING BY		
POOL CLEANER	SUPER-VAC W/ VALVE & SKIMMER	
CHLORINATOR	THRU-SKIMMER	
BOARD-SIZE	6'	COLOR WHITE
BOARD SUPPORTS	605 SA	Title: S.T.B.
LADDER-Model	0	Title: 0
SLIDE-H	0	Color 0 SA GA 0 Water Hookup
ROPE RINGS	1 1/2"	W/ROPE & FLOATS 1 1/2"
GRADING	1 1/2"	DIRT WALK 0
STUB PLUMB	YES 0 NO 0	TRACTOR SIZE 941
TILE & COPING	0 ASAP 0 OTN	
DECK BY	OWNER-SUB	
TREES, ETC.	NONE	
CONCRETE REMOVAL BY	NONE	
RAISED BOND BEAM	YES 0 NO 0	HEIGHT 0 WIDTH 0
VAC W/ 36 HOSE MAINT KIT	6'	
LOVESEAT		

SWIMMING POOL

NAME JAMES & EDITH PEMROKE
 ADDRESS 13574 BARBERRY WAY
SYKESTOWN, MD 2084
 CROSS STREETS OLD FREDERICK - UNDERWOOD
 RES. PHONE 439-7384 BUS. PHONE 465-4686

ANTHONY POOLS
 a Division of Anthony Industries, Inc.

NOTE

SCALE 1/8" = 1' 0"

FROM D.C. BELTWAY TAKE
 RTE 95 (N) TO
 RTE 72 (N) CROSSING
 RTE 70 TO A (L) ON TO
 OLD FREDERICK RD TO
 A (R) ON TO UNDERWOOD
 TO A (L) ON TO BARBERRY
 WAY, HOUSE # 13574

SALES OFFICE BALTIMORE
 PHONE NO. (703) 451-3454
 JOB NO. F-7651
 MAP BOOK NO. 4 410
 LEGAL DESCRIPTION
4th DIST, SECT II
PLAT # 4045
 LOT NO. 25
 TRACT NO. WESTCLIFFE MAJOR
 BOOK PAGE BLOCK
 MAILING ADDRESS

PERMIT OFFICE HOWARD
 MGR. SPURILL
 SALESMAN KENNY

DATE 7/9/82
 DWN. BY \$
 CK'D. BY
 PRINTS S-
C-

BUYER:

TO DETERMINE APPROXIMATE ELEVATION OF POOL ON DAY OF EXCAVATION.

BUYER:

POOL AREA TO BE FENCED, PER COUNTY OR CITY ORDINANCE. GATES TO BE SELF CLOSING AND SELF LATCHING.
 BY BUYER

BUYER:

WET DOWN CONCRETE SHELL AT LEAST TWICE DAILY FOR 7 DAYS.
 DO NOT TURN ON POOL LIGHT WHEN POOL IS EMPTY.
 DO NOT USE RUBBER HOSE WHEN FILLING POOL AS IT WILL MARK PLASTER.

