

04-338847

approved 2/4/81
Stayer

PERMIT

P 31015

A 26598

SEWAGE DISPOSAL SYSTEM

MARYLAND STATE DEPARTMENT OF HEALTH

HOWARD COUNTY

ELLICOTT CITY

DISTRICT 4th

INDEXED

DATE 11/6/80

Robert Frye and Frank Peach

IS PERMITTED TO INSTALL ☒ ALTER

ADDRESS 6271 Oakland Mills Road, Sykesville, Md. 21784 PHONE 795-3115

SUBDIVISION Westcliffe Manor ROAD 13754 Barberry Way LOT 9

PROPERTY OWNER ~~Robert Frye and Frank Peach~~ Douglas

ADDRESS same as above

SPECIFICATIONS 4 bedrooms

SEPTIC TANK CAPACITY 1250 GALLONS

DRAIN FIELD DEPTH FEET, BOTTOM AREA SQ. FT.

DEEP TRENCH DEPTH FEET, BOTTOM AREA SQ. FT.

SEEPAGE PITS ☒ ABSORBENT SIDE-WALL AREA 120 SQ. FT. per bedroom below inlet.

INLET PIPE 4' C.P.S. FT. BELOW ORIGINAL GRADE. MAXIMUM DEPTH 10 1/2' C.P.S. FT. BELOW ORIGINAL GRADE

EFFECTIVE DEPTH AT FT. BELOW ORIGINAL GRADE.

LOCATE DISPOSAL AREA 100 FT. FROM left LOT LINE AND 150-160 FT. FROM rear AS SEEN WHEN

27' FROM REAR OF
OR A EXISTING HOUSE
C.B.O.

FACING LOT FROM Barberry Way. If trench needed, leave 5 ft. earth buffer between trench and dry well, and run the necessary distance to make up absorbent sidewall area. Trench to follow the contour of the land. NOTE: CALL FOR INSPECTION OF TRENCH BEFORE PLACING STONE IN TRENCH AND AFTER STONE IS INSTALLED.

PLANS APPROVED BY Charles B. Streaker

DATE 1/13/78

COVER NO WORK UNTIL INSPECTED AND APPROVED.

NEITHER THE HOWARD COUNTY COUNCIL NOR THE HEALTH DEPARTMENT IS RESPONSIBLE FOR THE SUCCESSFUL OPERATION OF ANY SYSTEM.

NOTE: IF TRENCH IS USED CALL FOR INSPECTION BEFORE PLACING GRAVEL IN TRENCH.

NOTE: NO DRY WELL SHALL EXCEED 15 FOOT IN DIAMETER.

NOTE: ALL PIPE FROM HOUSE TO DISPOSAL AREA MUST BE CAST IRON.

PERMIT VOID AFTER THREE YEARS.

NOTE: INSTALL STAND PIPE ON SEPTIC TANK AND DRY WELL. STAND. PIPES MUST BE 6 INCHES IN DIAMETER. CAST IRON, CONCRETE OR TERRA COTTA ACCEPTED.

BLDG. PERMIT SIGNED

AND RETURNED


Serial # 58039 Pmt.

*INSTALLER IS RESPONSIBLE FOR OBTAINING FINAL APPROVAL ON THIS PERMIT.

A 26598

65
30
1950

52
65
260
312
3480
195
543

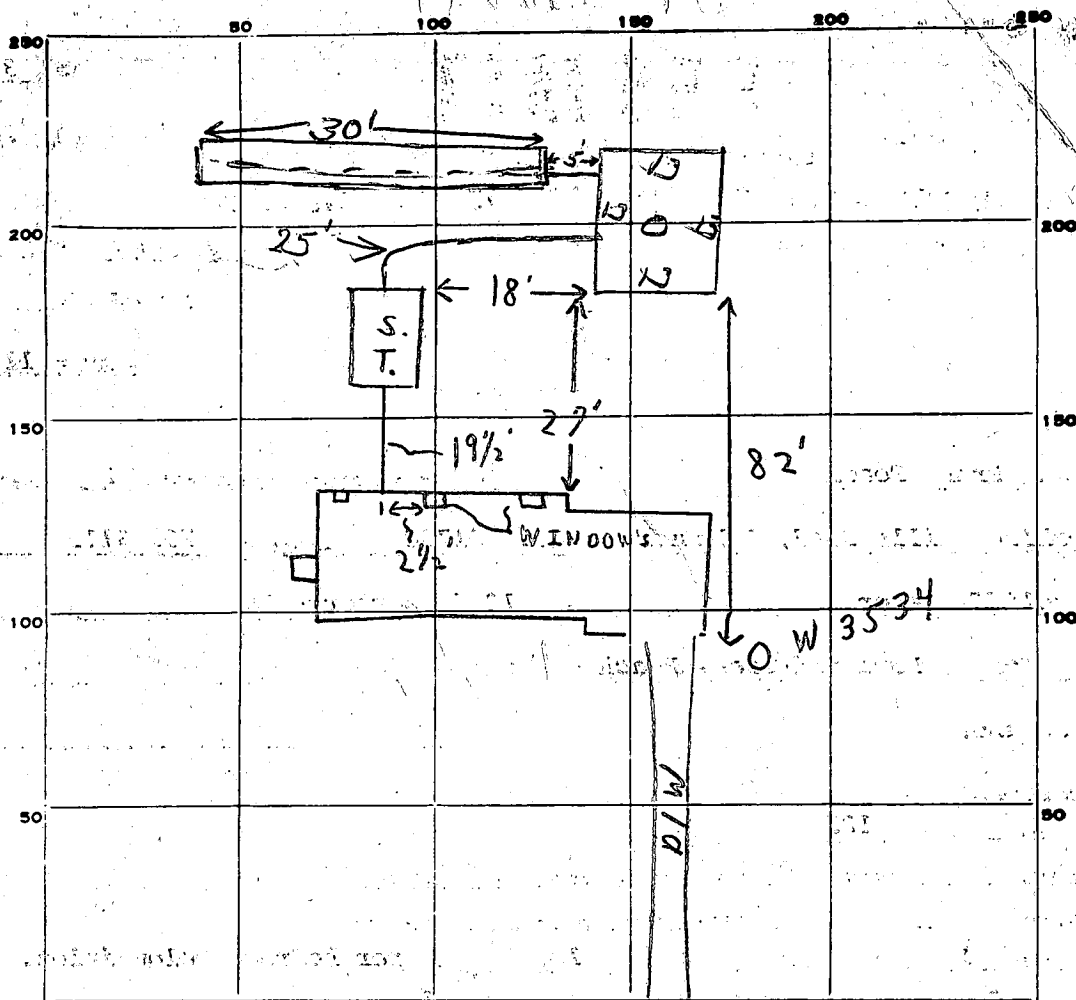

INDICATE NORTH - NAME ADJOINING ROADWAY AS BASE LINE.

BARBERRY WAY

PERMIT CARD ☒
 SEPTIC TANK, LEVEL ☒ CLEANOUTS ST/DW
 DISTRIBUTION BOX, LEVEL ☒ cast iron
 TILE FIELD, DEPTH 10 1/2 FT. TRENCH WIDTH 2 FT.
 GRAVEL DEPTH 2 1/2 IN. TOTAL LENGTH 30 FT.
 NUMBER OF TRENCHES 1 TOTAL BOTTOM AREA 195
 SEEPAGE PITS, INSIDE DIAMETER 52 FT. DEPTH BELOW INLET 6 1/2 FT.
 ABSORBENT AREA 543 SQ. FT.

REMARKS 1/29/81 LOCATED DRY WELL IN AREA 27' FROM
REAR OF HOUSE AND 18' FROM SEPTIC TANK. ; CHECKED
DRY WELL HOLE OK. C.B.S.
2/2/81 OK to add gravel in trench. js
2/4/80 OK to cover all work js

DATE SYSTEM APPROVED 2/4/81 INSPECTOR Stayer

PRELIMINARY

APPLICATION

A 26598

SEWAGE DISPOSAL TESTING

P

STATE OF MARYLAND - DEPARTMENT OF HEALTH AND MENTAL HYGIENE
 HOWARD COUNTY HEALTH DEPARTMENT
 ENVIRONMENTAL HEALTH SERVICES

P O. BOX 476, ELLICOTT CITY, MARYLAND 21043
 TELEPHONE: 465-5000, EXT. 356

DISTRICT 4TH
 DATE 8/16/77

Septic Tank { 1-3 Bedrooms 1000 gallons
 4 Bedrooms 1250 gallons
 Dry well to have 120 sq ft effective
 absorbent sidewalk area. below incl. Under
 to be 3' and maximum depth 10' below
 ground grade, location for dry well.

100' off left property line and 150' from rear property
 line when facing lot from roadway - Barbary
 Way. Purchase (1/2). Changed 12/29/81 see spec's
 spec. C.B.D. ① rip dry well & trench used - need:
 ① 5' earth buffer between
 dry well & trench
 ② 2 inspections of trench

TO: THE COUNTY HEALTH OFFICER
 ELLICOTT CITY, MARYLAND

I, HEREBY, APPLY FOR THE NECESSARY TEST IN ORDER TO CONSTRUCT (OR RECONSTRUCT) A SEWAGE
 DISPOSAL SYSTEM.

PROPERTY OWNER Robert Frye
 J & B Partnership

ADDRESS 6271 Oakland Mills Road
 5632 Stevens Forest Rd., Apt. 254, Columbia 21045 PHONE Ron Carter - 837-0194

PROPERTY LOCATION Sykesville Md 21784
 795-3115

SUBDIVISION Westcliffe Manor- 13754 Barbary Way LOT NO. 25

ROAD AND DESCRIPTION off Underwood Road ③ Run trenches on contour

SIZE OF LOT 45,000 sq. ft. TYPE BLDG. 3 or ④ bedrooms
 NUMBER OF BEDROOMS

IF NOT SINGLE RESIDENCE DESCRIBE

THE SYSTEM INSTALLED UNDER THIS APPLICATION IS ACCEPTABLE ONLY UNTIL PUBLIC
 FACILITIES BECOME AVAILABLE.

SIGNATURE OF APPLICANT /s/ Ron Carter

BLDG. PERMIT SIGNED
 AND RETURNED 10/23/80
 Serial # 44902

APPROVED BY C. B. Stuckey FOR Dry well & 1/13/78
 (KIND OF SYSTEM)

REJECTED BY FOR (KIND OF SYSTEM) DATE


HOLD PENDING FURTHER TESTS DATE

REASONS FOR REJECTION OR HOLDING

10/23/80 Rewrite location of dry well to other high poles.
 NOTE 1/29/81 Check area of dry well hole, not in area called (as far as distance) between holes.
 configuration C.B.D. & F.V. C.B.D.

THIS IS NOT A PERMIT

Forestry Rd out here

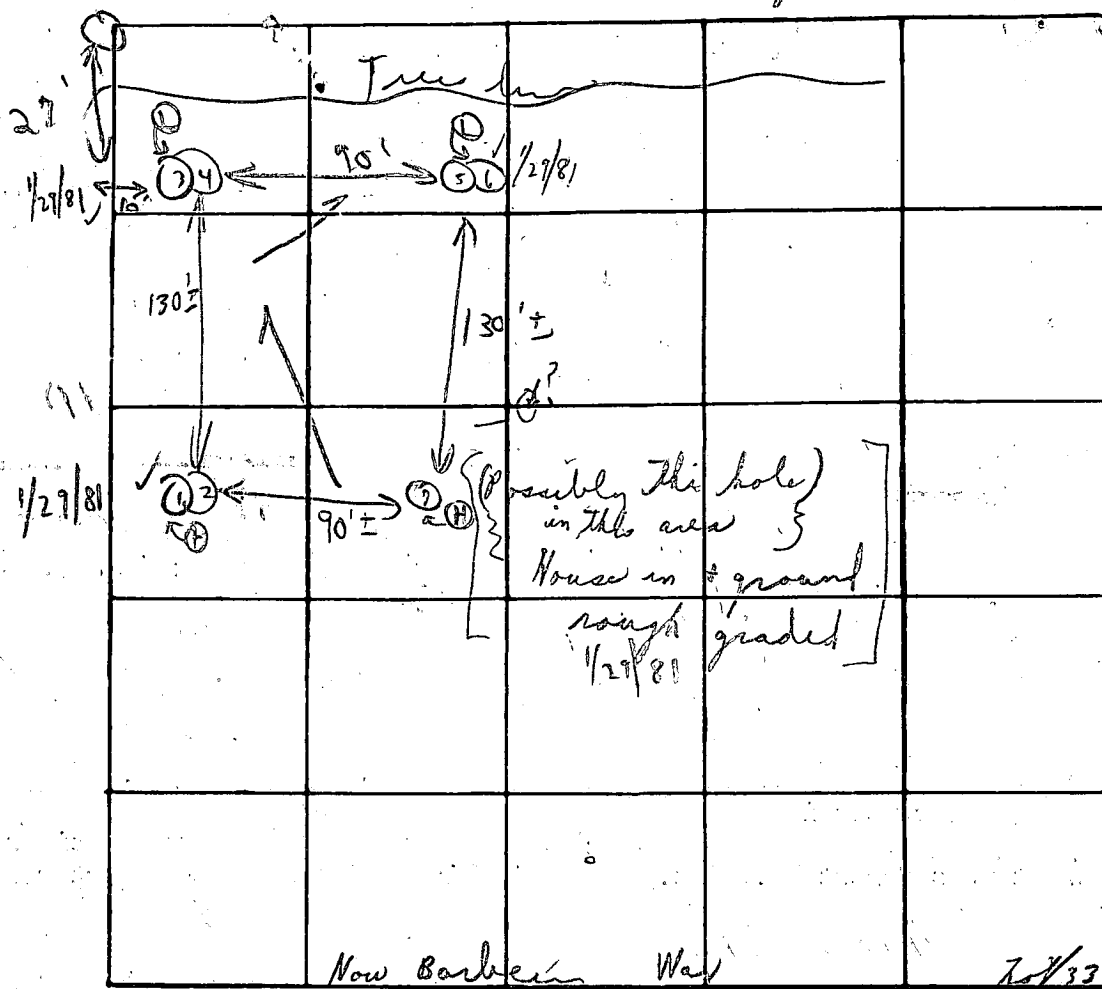

New #9

INDICATE NORTH - NAME ADJOINING ROADWAY AS BASE LINE

Jennifers Coast

Soil Profile

DATE	TEST NO.	DEPTH	PRE-WET		TEST - 1" DROP		TIME
			START	STOP	START	STOP	
8/30/77	1	3'	10:24	10:25	10:25	cut 10:31	6m
	2	13 1/2'	10:24	10:26	10:26	10:33	9m
	3	3'	10:21	10:23	10:23	10:25	2m
	④ 4	12 1/2'	10:21	10:23	10:23	10:26	3m
	5	5'	10:18	10:22	out by 10:22	10:30	9m±
	⑥ 6	13'	10:19	10:24	10:24±	10:36	12m
	7	13'	Visual			6	41

Below clay sandy loam

(120 gpt.)

Maximum depth 12' covered 63'

7m

REMARKS

Tested in open field

TYPE OF SOIL

Some small sand stone

TESTED BY

C.B. &

ALSO PRESENT:

J. Fyock & men

C 1		3721		SEQUENCE NO. (WRA USE ONLY)		STATE OF MARYLAND WATER RESOURCES ADMINISTRATION TAWES STATE OFFICE BLDG., ANNAPOLIS, MD. 21401 WELL COMPLETION REPORT				THIS REPORT MUST BE SUBMITTED WITHIN 30 DAYS AFTER WELL COMPLETION FILL IN THIS FORM COMPLETELY COUNTY NUMBER A26598					
1 2 3 4 (SEQ. NO.) 6															
(THIS NUMBER IS TO BE PUNCHED IN COLS. 3-6 ON ALL CARDS)															
DATE RECEIVED (WRA USE ONLY)		March 19, 1980		DATE WELL COMPLETED		22		DEPTH OF WELL 36		(TO NEAREST FOOT)		26		PERMIT NO. FROM "PERMIT TO DRILL WELL"	
8-13		15		20		22		26		28		29		30 31 32 33 34 35 36 37	
		C31939										DRILLERS IDENTIFICATION NO.		256	
OWNER		Frve, Robert L.		& Peach, Francis		FIRST NAME									
STREET OR RFD		1247 Liberty Road		POST OFFICE		Sykesville, Maryland		21784							
WELL DESCRIPTION															
WELL LOG				GROUTING RECORD											
STATE THE KIND OF FORMATIONS PENETRATED, THEIR COLOR, DEPTH, THICKNESS AND IF WATER BEARING				WELL HAS BEEN GROUTED (CIRCLE APPROPRIATE BOX) ☒ YES ☐ NO											
DESCRIPTION (USE ADDITIONAL SHEETS IF NECESSARY)				TYPE OF GROUTING MATERIAL (CIRCLE BOX)											
FEET				CEMENT ☒ BENTONITE CLAY ☐											
FROM TO				NO. OF BAGS 11 NO. OF POUNDS 1,034											
CHECK IF WATER BEARING				GALLONS OF WATER 66											
Dirt 0 9				DEPTH OF GROUT SEAL (TO NEAREST FOOT)											
Soft Brn. Shale 9 16				FROM 0 FT. TO 27 FT.											
Blue & Brown Sandstone 16 38				(ENTER 0 IF FROM SURFACE)											
Brown Sandstone w/ Clay Seam 38 39 X				CASING RECORD											
Blue & Brown Sandstone 39 55				CASING TYPES											
Brown Sandstone 55 56 X				INSERT APPROPRIATE CODE BELOW											
Blue & Brown Sandstone 56 70				STEEL ☒ CONCRETE ☐											
Brown Sandstone 70 71 X				PLASTIC ☐ OTHER ☐											
Blue & Brown Sandstone 71 86				MAIN CASING TYPE											
				NOMINAL DIAMETER (TOP MAIN) CASING (NEAREST INCH)											
				TOTAL DEPTH OF MAIN CASING (NEAREST FOOT)											
				S T 6 29											
				OTHER CASING (IF USED)											
				DIA. (INCH) DEPTH (FEET) FROM TO											
				SCREEN TYPE OR OPEN HOLE											
				INSERT APPROPRIATE CODE BELOW											
				STEEL ☐ BRASS OR BRONZE ☐ OPEN HOLE ☐											
				PLASTIC ☐ OTHER ☐											
				SCREEN RECORD											
				DEPTH (NEAREST WHOLE FOOT)											
				FROM TO											
				H O 29 36											
				SLOT SIZE 1 3											
				DIAMETER OF SCREEN 56 (NEAREST INCH)											
				FROM TO											
				GRAVEL PACK											
				IF WELL DRILLED WAS A FLOWING WELL CIRCLE BOX 68 F											
				WRA USE ONLY (NOT TO BE FILLED IN BY DRILLER)											
				T 70 LOG TELESCOPE CASING											
				W Q 72 LOG INDICATOR											
				74 75 76 OTHER DATA AVAILABLE											
CIRCLE APPROPRIATE BOXES				PUMPING TEST											
☐ A WELL WAS ABANDONED AND SEALED WHEN THIS WELL WAS COMPLETED				C 3											
☐ E ELECTRIC LOG OBTAINED				1 2 3 (SEQ. NO.) 6											
☐ P TEST WELL CONVERTED TO PRODUCTION WELL				PUMPING TEST											
I HEREBY CERTIFY THAT I HAVE COMPLIED WITH ALL CONDITIONS STATED ON THE ABOVE-CAPTIONED "PERMIT TO DRILL WELL", AND THAT INFORMATION CONTAINED IN THIS REPORT IS TRUE, ACCURATE, AND COMPLETE TO THE BEST OF MY KNOWLEDGE, INFORMATION AND BELIEF.				HOURS PUMPED (TO NEAREST HOUR) 6											
DRILLERS NAME				PUMPING RATE (GALLONS PER MINUTE TO NEAREST GALLON) 26											
(PLEASE PRINT) Dana Kyker, Jr. II				METHOD USED TO MEASURE PUMPING RATE Flowmeter											
SIGNATURE Dana Kyker, Jr. II				WATER LEVEL: (DISTANCE FROM LAND SURFACE)											
				BEFORE PUMPING 17 26 (NEAREST FOOT)											
				WHEN PUMPING 22 70 (NEAREST FOOT)											
				TYPE OF PUMP USED (CIRCLE APPROPRIATE BOX)											
				A AIR 27 P PISTON 27 T TURBINE 27											
				C CENTRIFUGAL 27 R ROTARY 27 O OTHER (DESCRIBE BELOW) 27											
				J JET 27 S SUBMERSIBLE 27											
				PUMP INSTALLED											
				TYPE OF PUMP (WRITE APPROPRIATE LETTER IN BOX - SEE ABOVE: A, C, J, P, R, S, T, O)											
				DRILLER WILL INSTALL PUMP (CIRCLE APPROPRIATE BOX) YES ☒ NO ☐											
				CAPACITY:											
				GALLONS PER MINUTE (TO NEAREST GALLON) 31 35											
				PUMP HORSE POWER 37 41											
				PUMP COLUMN LENGTH (NEAREST FOOT) 43 47											
				CASING HEIGHT (CIRCLE APPROPRIATE BOX AND ENTER CASING HEIGHT)											
				+ ABOVE 50 51 (FEET)											
				- BELOW 50 51 (FEET)											
				LOCATION OF WELL ON LOT											
				SHOW PERMANENT STRUCTURE SUCH AS BUILDINGS, SEPTIC TANKS, AND/OR OTHER LAND MARKS AND INDICATE NOT LESS THAN TWO DISTANCES (MEASUREMENTS TO WELL).											

B 1 4373 SEQUENCE NO. (WRA USE ONLY) 2 3 4 (SEQ. NO.) 6 (THIS NUMBER IS TO BE PUNCHED IN COLS. 3-6 ON ALL CARDS)										STATE OF MARYLAND WATER RESOURCES ADMINISTRATION TAWES STATE OFFICE BLDG., ANNAPOLIS, MARYLAND 21401 APPLICATION FOR PERMIT TO DRILL WELL										WRA PERMIT NUMBER 14-73-2229 FILL IN THIS FORM COMPLETELY																													
DATE RECEIVED (WRA USE ONLY) 3/12/80 3/12/80 C.R. 14										OWNER Frye, Robert L. & Peach, Francis COL 15 LAST NAME FIRST NAME COL. 34										STREET OR RFD. 1247 Filigree Road COL 36 COL. 55																													
POST OFFICE C.R. 14 COL 57										COL. 76																																							
B 1 CONTINUED 1 2 3 (SEQ. NO.) 6										DRILLER INFORMATION DATE January 3, 1980 LICENSE NUMBER 296 77 80 Ronald T. Kyker FIRST NAME DRILLER LAST NAME SIGNATURE [Signature] B 2										WELL INFORMATION 1 2 3 (SEQ. NO.) 6 MAXIMUM PUMPING RATE (GALLONS PER MINUTE) 6 8 12 AVERAGE DAILY QUANTITY NEEDED (GALLONS PER DAY) 575 14 20 USE FOR WATER (CIRCLE APPROPRIATE BOX) D HOME (SINGLE OR DOUBLE HOUSEHOLD UNIT ONLY) F FARMING, AGRICULTURE, IRRIGATION I INDUSTRIAL, COMMERCIAL, STATE AND FEDERAL GOVERNMENT. M MUNICIPAL WATER SUPPLY P PRIVATE WATER COMPANY T TEST MUST HAVE STATE HEALTH DEPT. APPROVAL										B 3 LOCATION OF WELL 1 2 3 (SEQ. NO.) 6 COUNTY Howard (DO NOT ABBREVIATE COUNTY NAME) 21 SUBDIVISION "Westcliffe Manor" 42 SECTION 1 LOT 9 44 46 48 50 NEAREST TOWN Sykesville 52 71 MILES FROM TOWN (ENTER 0 IF IN TOWN) 3 73 76 77 78										B 4 DIRECTION FROM TOWN (CIRCLE APPROPRIATE BOX) 1 2 3 (SEQ. NO.) 6 N NORTH E EAST NE NORTHEAST SE SOUTHEAST S SOUTH W WEST NW NORTHWEST SW SOUTHWEST 8 8 8 9 8 9 NEAR WHAT ROAD Harborview Hwy ON WHICH SIDE OF ROAD (CIRCLE APPROPRIATE BOX) N NORTH S SOUTH E EAST W WEST 32 32 32 32 32 32 DISTANCE FROM ROAD (ENTER DISTANCE AND CIRCLE APPROPRIATE BOX) 50 34 37 38 39 DRAW A SKETCH BELOW SHOWING LOCATION OF WELL IN RELATION TO NEARBY TOWNS, ROADS AND STREAMS WITH NORTH IN THE DIRECTION OF THE ARROW, AND GIVE DISTANCE FROM WELL TO NEAREST ROAD JUNCTION OR STREAM CROSSING SHOWN ON THE SKETCH. ALSO SHOW, BY MEANS OF AN "X", THE WELL LOCATION IN THE BOX BELOW AND THE BOX NUMBER FROM THE WELL LOCATION MAP. N Beechey Way X well K 11 Underwood K 11									
APPROXIMATE DEPTH OF WELL 200 24 26 FEET										APPROXIMATE DIAMETER OF WELL 6 1/2 (NEAREST INCH)																																							
METHOD OF DRILLING USED (CIRCLE APPROPRIATE METHOD) BORED (OR AUGERED) JETTED DRIVEN 30-37 AIR-ROTARY AIR-PERCUSSION ROTARY (HYDRAULIC ROTARY) CABLE REVERSE-ROTARY DRIVE-POINT OTHER (DESCRIBE)										REPLACEMENT OR DEEPEMED WELLS (CIRCLE APPROPRIATE BOX) N THIS WELL WILL NOT REPLACE AN EXISTING WELL Y THIS WELL WILL REPLACE A WELL THAT WILL BE ABANDONED AND SEALED S THIS WELL WILL REPLACE A WELL THAT WILL BE USED AS A STANDBY D THIS WELL WILL DEEPEN AN EXISTING WELL PERMIT NUMBER OF WELL TO BE REPLACED OR DEEPEMED (IF AVAILABLE) 41 52																																							
NOT TO BE FILLED IN BY DRILLER (WRA USE ONLY) APPROPRIATION PERMIT NUMBER 54 ENGINEER REVIEW DISTRICT NO. 63 FORCE WRITE INITIALS IN BOX CONDITIONS A E N S G W Q C L U 67 68 70 71 72 73 74 75 76 77 78 79										BOX NUMBER E 300 N 550 NORTH COORDINATE 50 51 52 53 54 55 EAST COORDINATE 57 58 59 60 61 62 63 ELEVATION AT WELL HEAD (FEET) 65 66 67 68										O/B 5/5 K 11																													
B 4 CONTINUED 1 2 3 (SEQ. NO.) 6 41 S STATE HEALTH (CIRCLE BOX) MO. DAY YR. DATE 07 11 80 43 46 Ronald W. Monahan, Sanitarian										HEALTH DEPARTMENT APPROVAL COUNTY NAME Howard COUNTY NO. 226500 APPROVED BY SPECIAL CONDITIONS 8-63 (WRA USE ONLY)										B 5 1 2 3 (SEQ. NO.) 6																													

B 1		4373		SEQUENCE NO. (WRA USE ONLY)	
1 2 3 (SEQ. NO.) 6		TAWES STATE OFFICE BLDG., ANNAPOLIS, MARYLAND 21401		WRA PERMIT NUMBER	
(THIS NUMBER IS TO BE PUNCHED IN COLS. 3-6 ON ALL CARDS)		APPLICATION FOR PERMIT TO DRILL WELL		FILL IN THIS FORM COMPLETELY	
DATE RECEIVED (WRA USE ONLY) 3/19/80 <i>Sealed</i> <i>see attached</i> <i>C.P.H.</i>		OWNER <u>Frye, Robert L. & Peach, Francis</u> COL 15 LAST NAME FIRST NAME COL. 34 STREET OR RFD <u>1247 Liberty Road</u> COL 36 COL. 55 POST OFFICE <u>Sykesville, Maryland 21782</u> COL 57 COL. 76			
B 1 CONTINUED		DRILLER INFORMATION		B 3 LOCATION OF WELL	
1 2 3 (SEQ. NO.) 6		1 2 3 (SEQ. NO.) 6		1 2 3 (SEQ. NO.) 6	
DATE <u>January 8, 1980</u> LICENSE NUMBER <u>296</u> 77 80 <u>Ronald L. Kyker</u> FIRST NAME DRILLER LAST NAME SIGNATURE <i>Ronald L. Kyker</i>		COUNTY <u>Howard</u> (DO NOT ABBREVIATE COUNTY NAME) SUBDIVISION <u>"Westcliffe Manor"</u> 23 42 SECTION <u>1</u> LOT <u>9</u> 44 46 48 50 NEAREST TOWN <u>Sykesville</u> 52 71 MILES FROM TOWN (ENTER 0 IF IN TOWN) <u>3</u> M. I. 73 76 77 78		DIRECTION FROM TOWN (CIRCLE APPROPRIATE BOX) N NORTH E EAST NE NORTHEAST SE SOUTHEAST S SOUTH W WEST NW NORTHWEST SW SOUTHWEST 8 6 8 9 NEAR WHAT ROAD <u>Barberry Hwy</u> ON WHICH SIDE OF ROAD (CIRCLE APPROPRIATE BOX) N S E W 32 32 32 32 DISTANCE FROM ROAD (ENTER DISTANCE AND CIRCLE APPROPRIATE BOX) <u>50</u> FT. 34 37 38 39	
B 2		WELL INFORMATION		B 4	
1 2 3 (SEQ. NO.) 6		1 2 3 (SEQ. NO.) 6		1 2 3 (SEQ. NO.) 6	
MAXIMUM PUMPING RATE (GALLONS PER MINUTE) <u>6</u> 8 12 AVERAGE DAILY QUANTITY NEEDED (GALLONS PER DAY) <u>575</u> 14 20		USE FOR WATER (CIRCLE APPROPRIATE BOX) ☒ HOME (SINGLE OR DOUBLE HOUSEHOLD UNIT ONLY) ☐ FARMING, AGRICULTURE, IRRIGATION ☐ INDUSTRIAL, COMMERCIAL, STATE AND FEDERAL GOVERNMENT. ☐ MUNICIPAL WATER SUPPLY ☐ PRIVATE WATER COMPANY ☐ TEST MUST HAVE STATE HEALTH DEPT. APPROVAL		DRAW A SKETCH BELOW SHOWING LOCATION OF WELL IN RELATION TO NEARBY TOWNS, ROADS AND STREAMS WITH NORTH IN THE DIRECTION OF THE ARROW, AND GIVE DISTANCE FROM WELL TO NEAREST ROAD JUNCTION OR STREAM CROSSING SHOWN ON THE SKETCH. ALSO SHOW, BY MEANS OF AN "X", THE WELL LOCATION IN THE BOX BELOW AND THE BOX NUMBER FROM THE WELL LOCATION MAP. N Barberry Hwy C&D Run Sykesville Underwood X well 550	
APPROXIMATE DEPTH OF WELL <u>200</u> FEET 24 28 APPROXIMATE DIAMETER OF WELL <u>6 1/2</u> (NEAREST INCH)		METHOD OF DRILLING USED (CIRCLE APPROPRIATE METHOD) BORED (OR AUGERED) JETTED DRIVEN 30-37 AIR-ROTARY AIR-PERCUSSION ROTARY (HYDRAULIC ROTARY) CABLE REVERSE-ROTARY DRIVE-POINT OTHER (DESCRIBE)		REPLACEMENT OR DEEPEINED WELLS (CIRCLE APPROPRIATE BOX) ☒ THIS WELL WILL NOT REPLACE AN EXISTING WELL ☐ THIS WELL WILL REPLACE A WELL THAT WILL BE ABANDONED AND SEALED ☐ THIS WELL WILL REPLACE A WELL THAT WILL BE USED AS A STANDBY ☐ THIS WELL WILL DEEPEIN AN EXISTING WELL PERMIT NUMBER OF WELL TO BE REPLACED OR DEEPEINED (IF AVAILABLE) 41 52	
NOT TO BE FILLED IN BY DRILLER (WRA USE ONLY) APPROPRIATION PERMIT NUMBER <u>54</u> ENGINEER REVIEW DISTRICT NO. <u>63</u> 64 65 FORCE <u>67</u> WRITE INITIALS IN BOX CONDITIONS <u>67 68</u> 67 68 70 71 72 73 74 75 76 77 78 79		HEALTH DEPARTMENT APPROVAL 1 2 3 (SEQ. NO.) 6 41 ☒ STATE HEALTH (CIRCLE BOX) <u>Howard</u> COUNTY NAME <u>226500</u> COUNTY NO. MO. DAY YR. <u>03 17 80</u> DATE APPROVED BY <u>Donald W. Monaghan, Sanitarian</u> 43		BOX NUMBER <u>550</u> E <u>550</u> N <u>550</u> NORTH COORDINATE <u>50 51 52 53 54 55</u> EAST COORDINATE <u>57 58 59 60 61 62 63</u> ELEVATION AT WELL HEAD (FEET) <u>65 66 67 68</u> 0/0 5/0	
B 5		SPECIAL CONDITIONS 8-63		(WRA USE ONLY)	
1 2 3 (SEQ. NO.) 6		1 2 3 (SEQ. NO.) 6		1 2 3 (SEQ. NO.) 6	

EMERGENCY NO. (If any) -

STATE OF MARYLAND
WATER RESOURCES ADMINISTRATION
TAWES STATE OFFICE BLDG., ANNAPOLIS, MARYLAND 21401
APPLICATION FOR PERMIT TO DRILL WELL

WRA PERMIT NUMBER
3534

FILL IN THIS FORM COMPLETELY

DATE RECEIVED (WRA USE ONLY)
3/19/80
1:30 P.M.
9Fm

OWNER
COL 15 LAST NAME
Frye, Robert L. & Peach, Francis
FIRST NAME
COL 16
STREET OR RFD
1247 Liberty Road
COL 38
POST OFFICE
Sykesville, Maryland 21784
COL 57

DRILLER INFORMATION
DATE
March 10, 1980
LICENSE NUMBER
77 256
Dana Kyker, Jr. II
FIRST NAME
DRILLER
LAST NAME
Signature: Dana Kyker, Jr. II

WELL INFORMATION
MAXIMUM PUMPING RATE (GALLONS PER MINUTE)
5
AVERAGE DAILY QUANTITY NEEDED (GALLONS PER DAY)
575
USE FOR WATER (CIRCLE APPROPRIATE BOX)
☒ HOME SINGLE OR DOUBLE HOUSEHOLD UNIT ONLY
☐ FARMING, AGRICULTURE, IRRIGATION
☐ INDUSTRIAL, COMMERCIAL, STATE AND FEDERAL GOVERNMENT.
☐ MUNICIPAL WATER SUPPLY
☐ PRIVATE WATER COMPANY
MUST HAVE STATE HEALTH DEPT. APPROVAL
☐ TEST
APPROXIMATE DEPTH OF WELL
200'
APPROXIMATE DIAMETER OF WELL
6" (NEAREST INCH)
METHOD OF DRILLING USED (CIRCLE APPROPRIATE METHOD)
SORED (OR AUGERED) JETTED DRIVEN
ROTARY (HYDRAULIC ROTARY)
AIR-ROTARY AIR-PERCUSSION REVERSE-ROTARY DRIVE-POINT
OTHER (DESCRIBE)
REPLACEMENT OR DEEPENED WELLS (CIRCLE APPROPRIATE BOX)
☒ THIS WELL WILL NOT REPLACE AN EXISTING WELL
☐ THIS WELL WILL REPLACE A WELL THAT WILL BE ABANDONED AND SEALED
☐ THIS WELL WILL REPLACE A WELL THAT WILL BE USED AS A STANDBY
☐ THIS WELL WILL DEEPEN AN EXISTING WELL
PERMIT NUMBER OF WELL TO BE REPLACED OR DEEPENED (IF AVAILABLE)
NOT TO BE FILLED IN BY DRILLER (WRA USE ONLY)
APPROPRIATION PERMIT NUMBER
ENGINEER REVIEW DISTRICT NO.
FORCE
WRITE INITIALS IN BOX
CONDITIONS
HEALTH DEPARTMENT APPROVAL
STATE HEALTH
COUNTY NAME
Howard
COUNTY NO.
A26597
DATE
03/17/80
APPROVED BY
Donald W. Monaghan, Sanitarian
SPECIAL CONDITIONS (WRA USE ONLY)

LOCATION OF WELL
COUNTY
Howard
SUBDIVISION
"Westcliffe Manor"
SECTION
1
LOT
#4
NEAREST TOWN
Sykesville
MILES FROM TOWN (ENTER 0 IF IN TOWN)
5
DIRECTION FROM TOWN (CIRCLE APPROPRIATE BOX)
N NORTH E EAST NE NORTHEAST SE SOUTHEAST
S SOUTH W WEST NW NORTHWEST SW SOUTHWEST
NEAR WHAT ROAD
Barberry Way
ON WHICH SIDE OF ROAD (CIRCLE APPROPRIATE BOX)
N NORTH S SOUTH E EAST W WEST
DISTANCE FROM ROAD (ENTER DISTANCE AND CIRCLE APPROPRIATE BOX)
50
DRAW A SKETCH BELOW SHOWING LOCATION OF WELL IN RELATION TO NEAREST TOWN ROADS AND STREAMS WITH NORTH IN THE DIRECTION OF THE ARROW, AND GIVE DISTANCE FROM WELL TO NEAREST ROAD JUNCTION OR STREAM CROSSING SHOWN ON THE SKETCH. ALSO SHOW, BY MEANS OF AN "X", THE WELL LOCATION IN THE BOX BELOW AND THE BOX NUMBER FROM THE WELL LOCATION MAP.

#9
Well stake near casing
3/19/80
26' Well staked
29' Well casing
2 1/2' + casing out of ground
Forsythe Underwood
No house plans
No septic in
No house staked
No pure papers for #9 @ site
pure papers for #8 @ site
Wells in area called of preliminary signed plat


A 26597

ORIGINAL

LAND SURVEYOR 8440

5312 EMERALD DRIVE SYKESVILLE, MARYLAND, 21784 PHONE (301) 795-2210

□ DENOTES TACKED HUB
AND GUARD SET

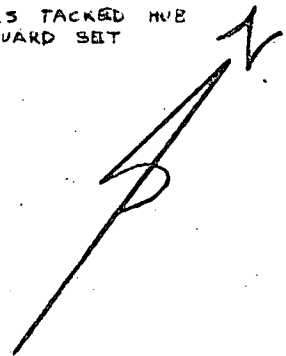

HOUSE STAKEOUT
SITE ^{AND} PLAN

BARBERRY WAY
LOT 9
WESTCLIFFE MANOR
PLAT NO. 3897
ELECT. DIST. 4
HOWARD CO., MD.

ok C.B.D. 11/6/80

DRYWELL DATA


INV. IN DRYWELL	560.90
INV. OUT SEPTIC TANK	561.60
INV. IN SEPTIC TANK	561.90
INV. OUT DWELLING	562.50
FIRST FLOOR ELEV.	571.00
BASEMENT ELEV.	563.00
WELL ELEV.	566.00
NO. BEDROOMS	4
ACREAGE	1.12703

I CERTIFY THE ABOVE MEASUREMENTS
AND ELEVATIONS ARE ACTUAL AND
CORRECT FOR THIS PROPERTY.

SIGNED William E. Boyce

DRAWN: OCT. 14, 1980
SCALE: 1" = 50'

Probley Westcliff Manor
 Lot 119
 P 31015 A 26598

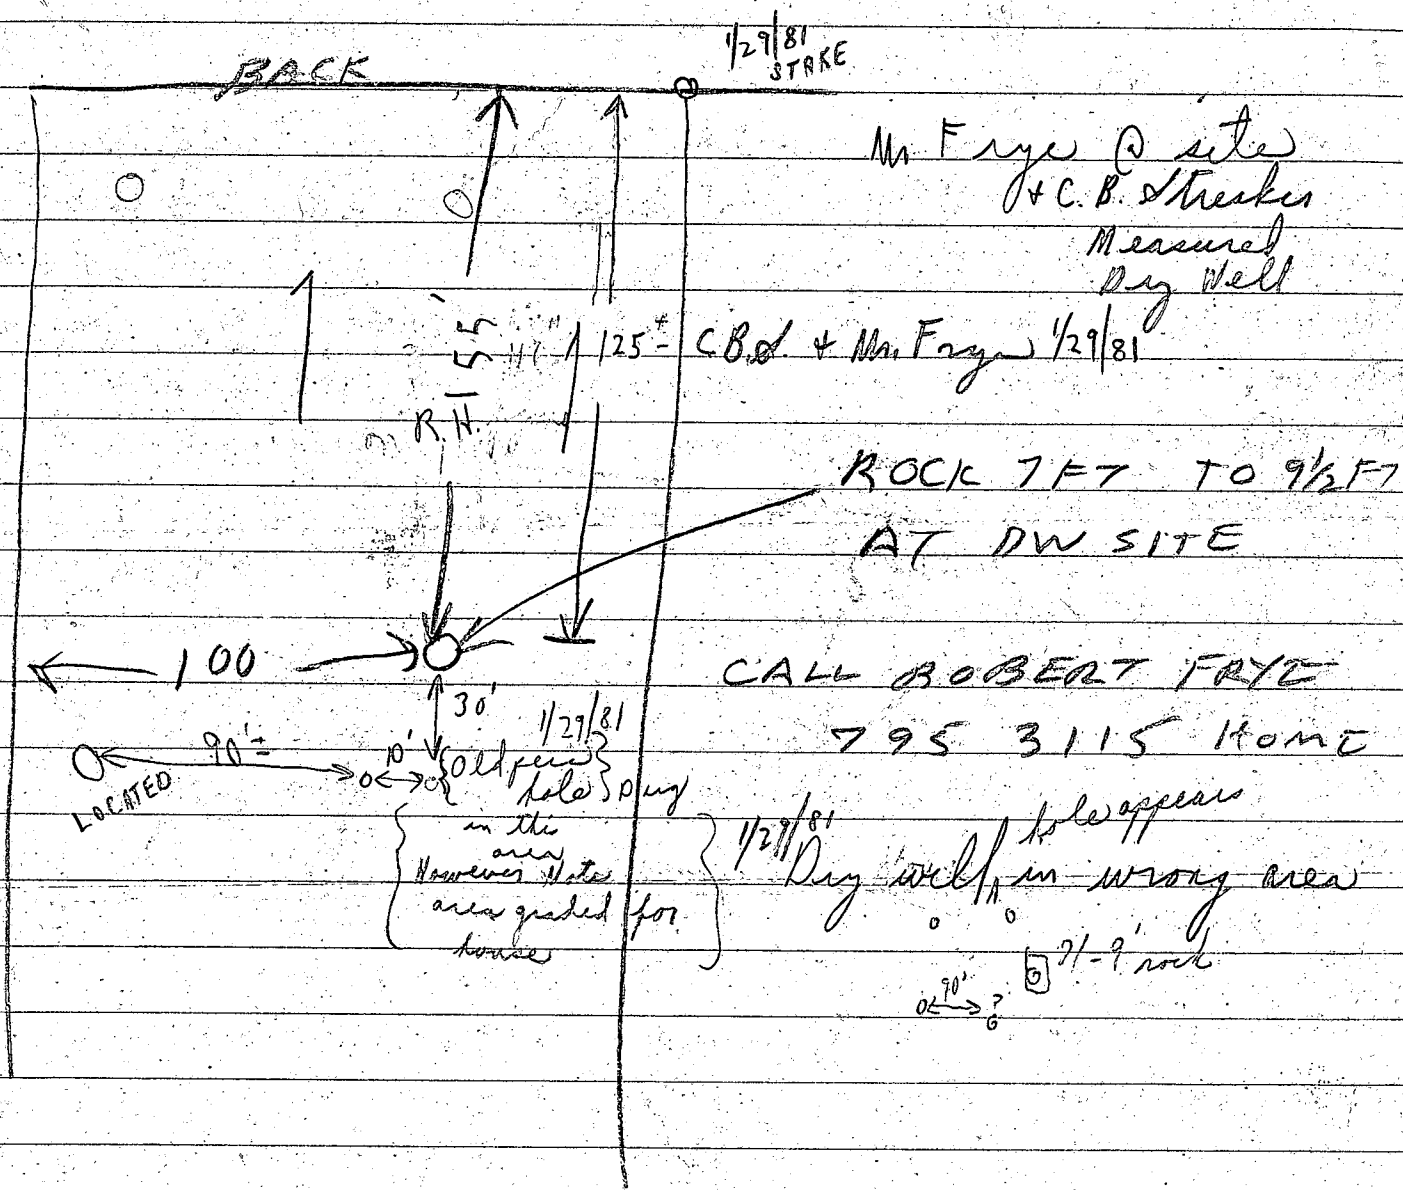

1/28/81 { Reinspection of perc hole location
 as soon as possible.
 Recommend Take preliminary perc plat signed.
 C.B. Sh. " final plat signed.

1/29/81 Dry Well hole 30' from where it was
 suppose to be front-garage from front perc.

