

PERMIT

SEWAGE DISPOSAL SYSTEM

MARYLAND STATE DEPARTMENT OF HEALTH

HOWARD COUNTY

ELLICOTT CITY

DISTRICT 5th.

DATE 11/8/79

INDEXED

05-378923

Clint Dustin

IS PERMITTED TO INSTALL ☒ ALTER

ADDRESS

Fulton, Md

PHONE

SUBDIVISION

Williams Contrivance Estates

ROAD

Reservoir Road

LOT

4, Sec. 2

PROPERTY OWNER

Mr. Stephen Faultz

ADDRESS

14000 Castle Boulevard, Silver Springs, Md. 20904

SPECIFICATIONS

4 Bedrooms

SEPTIC TANK CAPACITY 1250 GALLONS

DRAIN FIELD DEPTH FEET, BOTTOM AREA SQ. FT.

DEEP TRENCH DEPTH FEET, BOTTOM AREA SQ. FT.

Dry Well

SEEPAGE PITS ☒ ABSORBENT SIDE-WALL AREA 156 SQ. FT. for dry well & trench system

INLET PIPE 2 1/2 FT. BELOW ORIGINAL GRADE. MAXIMUM DEPTH 10 1/2 FT. BELOW ORIGINAL GRADE

EFFECTIVE DEPTH AT FT. BELOW ORIGINAL GRADE.

LOCATE DISPOSAL AREA 120 FT. FROM front LOT LINE AND 10 FT. FROM left LOT LINE AS SEEN WHEN
FACING LOT FROM Lovat Road

Start the trench after a 5 foot earth buffer with the drywell and proceed to dig it
on level ground the necessary distance. NOTE: Call for inspection of trench before
gravel is installed.

PLANS APPROVED BY

F Frank Skinner

DATE

3/16/78

COVER NO WORK UNTIL INSPECTED AND APPROVED.

NEITHER THE HOWARD COUNTY COUNCIL NOR THE HEALTH DEPARTMENT IS RESPONSIBLE FOR THE SUCCESSFUL OPERATION OF ANY SYSTEM.

NOTE: IF TRENCH IS USED CALL FOR INSPECTION BEFORE PLACING GRAVEL IN TRENCH.

NOTE: NO DRY WELL SHALL EXCEED 15 FOOT IN DIAMETER.

NOTE: ALL PIPE FROM HOUSE TO DISPOSAL AREA MUST BE CAST IRON.

PERMIT VOID AFTER THREE YEARS.

NOTE: INSTALL STAND PIPE ON SEPTIC TANK AND DRY WELL. STAND PIPES MUST BE 6 INCHES IN DIAMETER. CAST IRON, CONCRETE OR TERRA
COTTA ACCEPTED.

*INSTALLER IS RESPONSIBLE FOR OBTAINING FINAL APPROVAL ON THIS PERMIT.

A 21070

APPLICATION

A 27070

P _____

SEWAGE DISPOSAL TESTING

STATE OF MARYLAND - DEPARTMENT OF HEALTH AND MENTAL HYGIENE

HOWARD COUNTY HEALTH DEPARTMENT

ENVIRONMENTAL HEALTH SERVICES

P.O. BOX 476, ELLICOTT CITY, MARYLAND 21043

TELEPHONE: 465-5000, EXT. 356

3 B.R.

4 B.R.

DISTRICT 5th

DATE 10/14/77

1000 gal. septical

1250 gal. septic tank

156 SQ. FT. effective sidewall absorption area to

begin below the first 2 1/2 ft. of non-porous soil. Maximum depth permitted

for drywell and trench is 16 1/2 ft. below original grade. Place the drywell

120 ft. from the front property line and 10 ft. from the left side line, as seen

when facing the property from Lovat Road. Start the trench after a

5 foot earth buffer with the drywell and proceed to dig it on level ground

the necessary distance.

NOTE: Call for inspection of trench before gravel is installed.

TO THE COUNTY HEALTH OFFICER

ELLICOTT CITY, MARYLAND

I, HEREBY, APPLY FOR THE NECESSARY TEST IN ORDER TO CONSTRUCT (OR RECONSTRUCT) A SEWAGE

DISPOSAL SYSTEM.

PROPERTY OWNER

C. Ellsworth Iager

Stephen Fultz

ADDRESS

Route 216, Fulton, Md. # 911

14000 Castle Boulevard, Silver Spring, Md.

PROPERTY LOCATION: 890-8911

SUBDIVISION

Williams Contrivance Estates

LOT NO. 4, Sec. 2

ROAD AND DESCRIPTION

off Reservoir Road

SIZE OF LOT ?

TYPE BLDG. 3 or 4 bedrooms

NUMBER OF BEDROOMS

IF NOT SINGLE RESIDENCE DESCRIBE

THE SYSTEM INSTALLED UNDER THIS APPLICATION IS ACCEPTABLE ONLY UNTIL PUBLIC

FACILITIES BECOME AVAILABLE.

SIGNATURE OF APPLICANT /s/ C. Ellsworth Iager

APPROVED BY Frank Skinner FOR Drywell & trench DATE 3/16/78

REJECTED BY _____ FOR _____ DATE _____

HOLD PENDING FURTHER TESTS _____ DATE _____


REASONS FOR REJECTION OR HOLDING

10/21/77 C.B.R. in 33 min

No holes dug

C.B.R.

THIS IS NOT A PERMIT

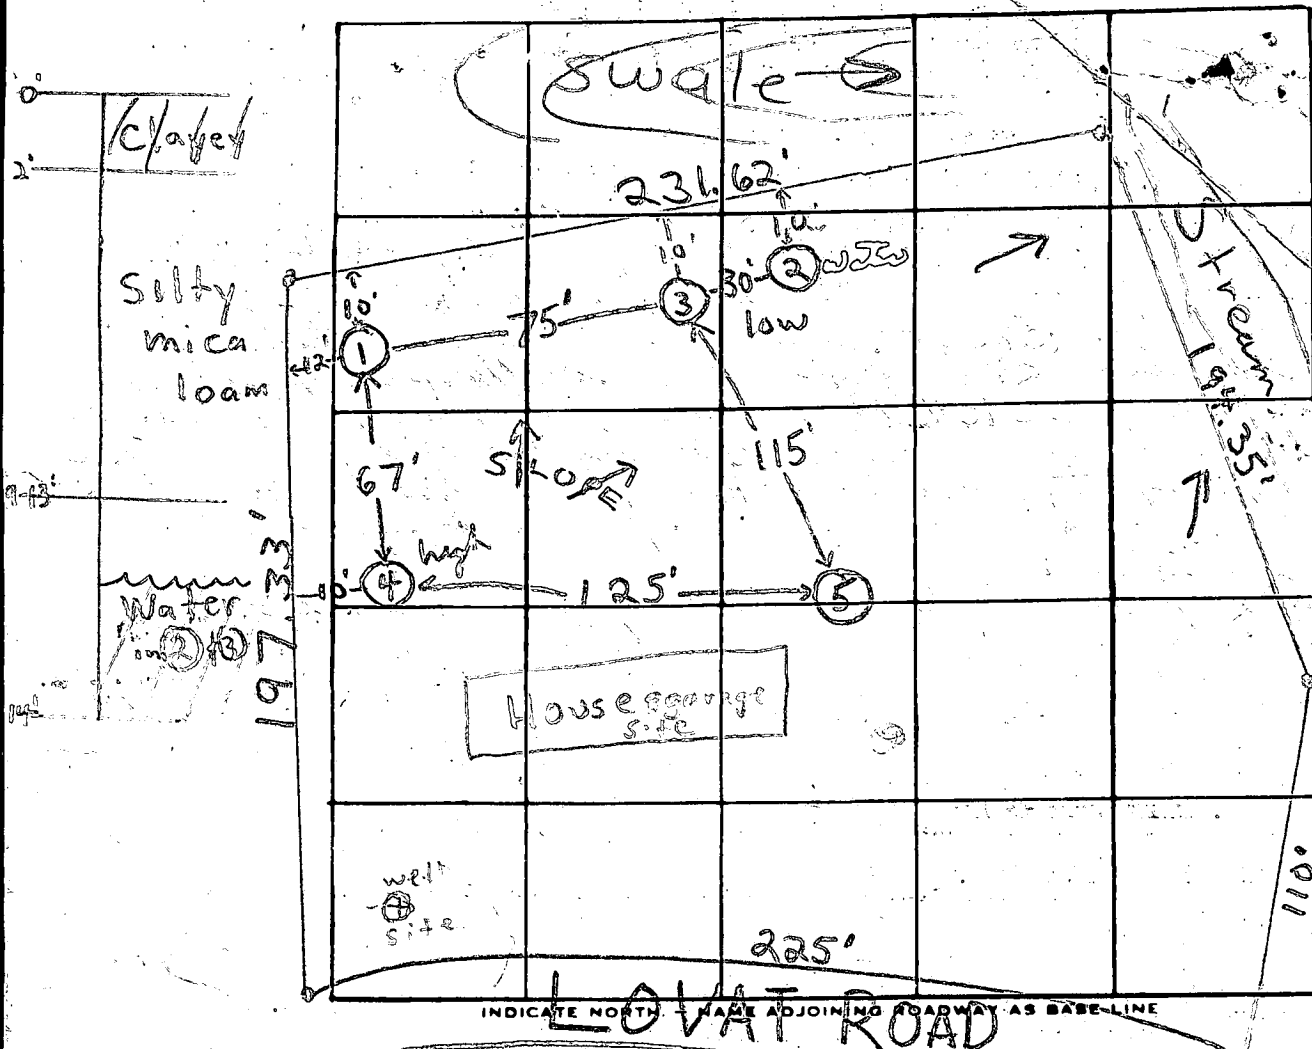

(3) → (2) ~ 3' drop
 (4) → (5) ~ 7' drop
 (4) → (3) ~ 8' drop

DATE	TEST NO.	DEPTH	PRE-WET		TEST - 1" DROP		TIME
			START	STOP	START	STOP	
11/1/77	1	4'	10:19	—	—	10:27	~5min
	1A	13'	10:20	10:26	10:26	10:45	19min
	(2)	11'	Water at 9' clayey to ~3' mica loam below				
	3 low	4'	11:10	—	—	11:15	~3min clayey to 2'
	3A	13'	Water at 13' clayey to 2' mica loam below				
	4 high	4'	11:27	11:29	11:29	11:33	4min porous at 2'
	4A	14'	11:31	11:41	11:41	12:02	21min
	5	4'	11:45	11:48	11:48	11:56	8min
	5A	13 1/2'	12:01	12:09	12:09	12:20	11min
	3 B	10'	11:55	12:00	12:00	12:10	10min

REMARKS Water at 13' in low hole

TYPE OF SOIL clayey to 2' silty mica loam below

TESTED BY F.S.

ALSO PRESENT: C.E. Tager, Rev. Sickler, D. Rush, Schools

APPLICATION

A 24461

SEWAGE DISPOSAL TESTING

P _____

STATE OF MARYLAND - DEPARTMENT OF HEALTH AND MENTAL HYGIENE

HOWARD COUNTY HEALTH DEPARTMENT
ENVIRONMENTAL HEALTH SERVICES

P. O. BOX 476, ELLICOTT CITY, MARYLAND 21043
TELEPHONE: 465-5000, EXT. 356

Septic Tank { 1-3 Bedrooms 1000 gallon
4 Bedrooms 51250 gallons
DATE 11/8/76

absorbent sidewall area per bedroom
below inlet. Inlet to be 4" and maximum
depth 12'. location: 50' from the left lot
line and 30' from the front lot line
AS seen from Ellsworth Dr.

TO: THE COUNTY HEALTH OFFICER
ELLICOTT CITY, MARYLAND

I, HEREBY, APPLY FOR THE NECESSARY TEST IN ORDER TO CONSTRUCT (OR RECONSTRUCT) A SEWAGE
DISPOSAL SYSTEM.

PROPERTY OWNER E. Jager, et. al
ADDRESS Fulton, Maryland PHONE 725-2075

PROPERTY LOCATION:

SUBDIVISION William Contreras, Sec. 2 LOT NO. 4 Sec 2
ROAD AND DESCRIPTION Ellsworth Drive & Ellsworth Court

SIZE OF LOT 68,000 sq. feet TYPE BLDG. 3 or 4
NUMBER OF BEDROOMS

IF NOT SINGLE RESIDENCE DESCRIBE _____

THE SYSTEM INSTALLED UNDER THIS APPLICATION IS ACCEPTABLE ONLY UNTIL PUBLIC
FACILITIES BECOME AVAILABLE.

SIGNATURE OF APPLICANT /s/ C. Ellsworth Jager

APPROVED BY C. B. Streak & H. Benson (KIND OF SYSTEM) Dry Well or Dry Well + trench DATE 4/6/77


REJECTED BY _____ FOR _____ (KIND OF SYSTEM) _____ DATE _____

HOLD PENDING FURTHER TESTS _____ DATE _____

REASONS FOR REJECTION OR HOLDING _____

THIS IS NOT A PERMIT

Reservoir Rd

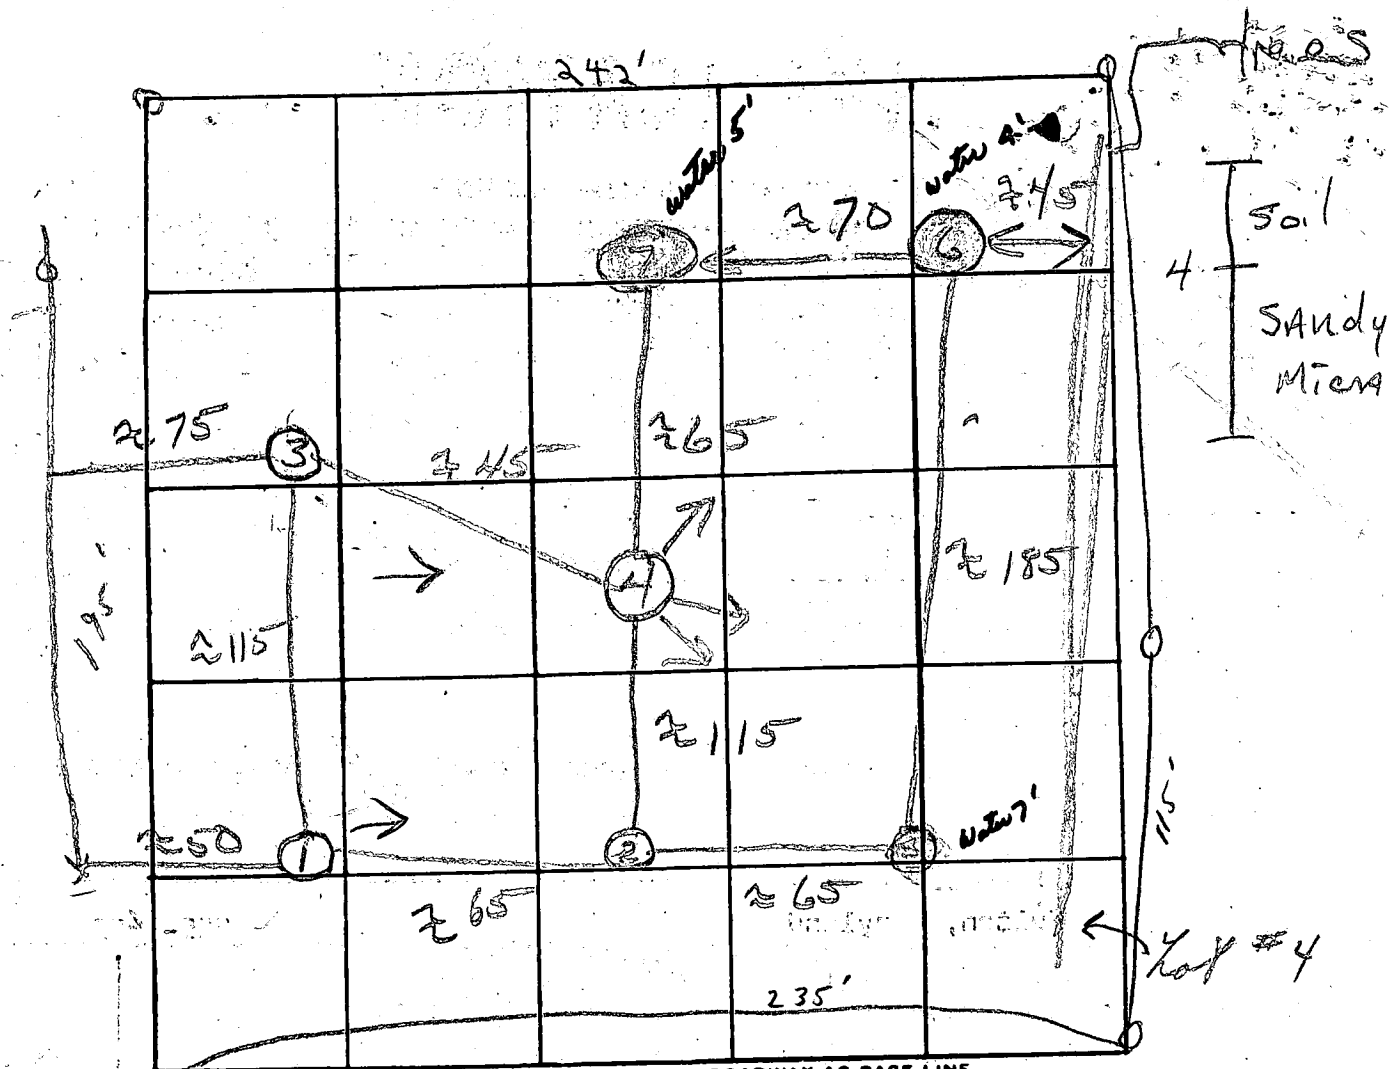

INDICATE NORTH - NAME ADJOINING ROADWAY AS BASE LINE.

← Ellsworth Drive Toward Rd. →

Sal. Profile
 { High
 { Low

DATE	TEST NO.	DEPTH	PRE-WET		TEST - 1" DROP		TIME
			START	STOP	START	STOP	
5/25/76	1 S	4	12:01	12:03	12:03	12:05	2
	1 D	13	12:01	12:06	12:06	12:15	8
	2 V	13'	similar soil; clay				
	3 S	3.5	11:47	11:50	11:50	11:53	3
	3 d	13	11:47	11:54	11:54	12:00	6
	4 S	4.5	11:50	11:50 ⁺¹⁵	11:50 ⁺¹⁵	11:51	2:45
	4 d	13	11:50	11:50 ⁺¹⁵	11:50 ⁺¹⁵	11:54	3:45
	5	water	at	7'			
	6	water	at	4'			6
	7	water	at	5'			

under 4'
 4 min
 125' A.
 24

REMARKS open field high grass

TYPE OF SOIL

TESTED BY hal benson ALSO PRESENT: Furr men

September 21, 1979

Mr. Fred Frommelt
Howard County Health Department
P. O. Box 476
Ellicott City, MD 21043

Dear Mr. Frommelt:

Per our meeting of September 20, 1979, this is to inform you that we accept full responsibility for the well site located on Lot 4, Section 2, Williams Contrivance, Howard County, Maryland.

Furthermore, if at any time during our occupancy of the premises it is determined that the well becomes contaminated by our septic system, we hereby agree to locate and drill a new well in accordance with existing Howard County code.

Thank you for your kind consideration in this matter.


Stephen Richard Fultz


Denise Ann Fultz

cc: Mr. Donald Monaghan

PERMIT #
HO-73-3427

9/18/79

WILLIAMS CONTRIVANCE

SECTION 2 LOT 4

LOCATION NOT APPROVED. GRANTED AS GEORGE EASTERDAY REQUESTED.
HOUSE LOCATION UNKNOWN. RD. & J.S.


63' CASING

2' ABOVE GROUND

43' OPEN

19 BAGS CEMENT

G. Melton

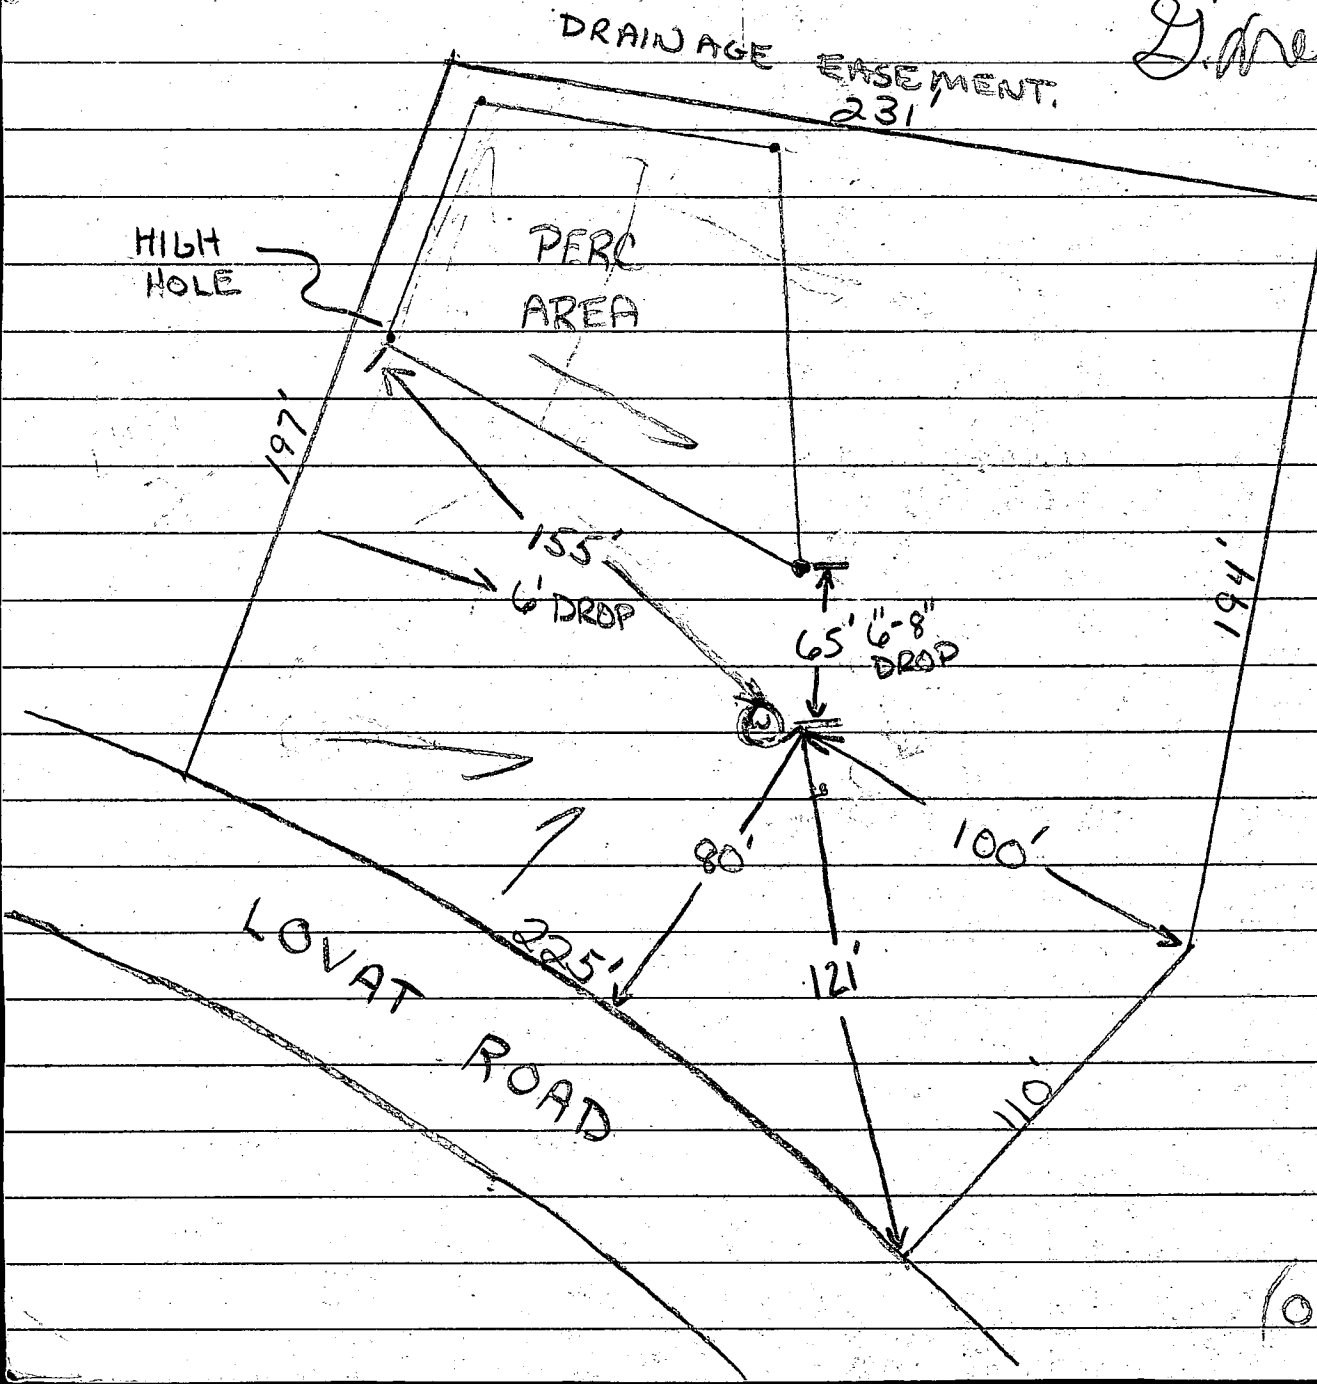

Vasebeck
622-1700
(OVER) X 217

HOME 890-8911
~~WORK 662-1700 EXT 225~~

8/18/79 CALLED S. FULTZ 4:20 NO ANSWER
CALLED 4:35. OWNER (S. FULTZ) SAID HE
WAS THE ONE WHO TOLD EASTERDAY TO
DRILL THE WELL IN ITS PRESENT LOCATION.

B 1 0994 1 2 3 (SEQ. NO.) 6 (THIS NUMBER IS TO BE PUNCHED IN COLS. 3-6 ON ALL CARDS)	SEQUENCE NO. (WRA USE ONLY)	STATE OF MARYLAND WATER RESOURCES ADMINISTRATION TAWES STATE OFFICE BLDG., ANNAPOLIS, MARYLAND 21401 APPLICATION FOR PERMIT TO DRILL WELL	WRA PERMIT NUMBER 40-73-3427 FILL IN THIS FORM COMPLETELY
--	--------------------------------	--	---

DATE RECEIVED (WRA USE ONLY) 9/18/79 9:30 1st	OWNER COL 15 LAST NAME COL 34 FIRST NAME COL 55 COL. 56 COL 57 COL. 76
STREET OR RFD COL 36 COL. 55 COL. 56 COL. 57 COL. 76	
POST OFFICE COL 57 COL. 76	

B 1	CONTINUED	DRILLER INFORMATION
1 2 3 (SEQ. NO.) 6		
DATE	LICENSE NUMBER	
8/1/79	40	
FIRST NAME DRILLER LAST NAME SIGNATURE		

B 3	CONTINUED	LOCATION OF WELL
1 2 3 (SEQ. NO.) 6		
COUNTY	DO NOT ABBREVIATE COUNTY NAME	
Howard	21	
SUBDIVISION	42	
23	42	
SECTION	LOT	
44	48	
NEAREST TOWN	50	
52	71	
MILES FROM TOWN (ENTER 0 IF IN TOWN)		
2		

B 2	CONTINUED	WELL INFORMATION
1 2 3 (SEQ. NO.) 6		
MAXIMUM PUMPING RATE (GALLONS PER MINUTE)		
8	12	
AVERAGE DAILY QUANTITY NEEDED (GALLONS PER DAY)		
14	20	
USE FOR WATER (CIRCLE APPROPRIATE BOX) ☒ HOME (SINGLE OR DOUBLE HOUSEHOLD UNIT ONLY) ☐ FARMING, AGRICULTURE, IRRIGATION ☐ INDUSTRIAL, COMMERCIAL, STATE AND FEDERAL GOVERNMENT. ☐ MUNICIPAL WATER SUPPLY ☐ PRIVATE WATER COMPANY ☐ TEST		

B 4	CONTINUED	DIRECTION FROM TOWN
1 2 3 (SEQ. NO.) 6		
NORTH EAST NORTHWEST SOUTHWEST SOUTH WEST SOUTHWEST		
NEAR WHAT ON WHICH SIDE OF ROAD (CIRCLE APPROPRIATE BOX) NORTH SOUTH EAST WEST DISTANCE FROM ROAD (ENTER DISTANCE AND CIRCLE APPROPRIATE BOX) 34 37 38 39		

B 3	CONTINUED	APPROXIMATE DEPTH OF WELL
1 2 3 (SEQ. NO.) 6		
APPROXIMATE DIAMETER OF WELL (NEAREST INCH) 6		
METHOD OF DRILLING USED (CIRCLE APPROPRIATE METHOD) BORED (OR AUGERED) JETTED DRIVEN 30-37 AIR-ROTARY AIR-PERCUSSION ROTARY (HYDRAULIC ROTARY) CABLE REVERSE-ROTARY DRIVE-POINT		
OTHER (DESCRIBE)		

B 4	CONTINUED	REPLACEMENT OR DEEPEMED WELLS (CIRCLE APPROPRIATE BOX)
1 2 3 (SEQ. NO.) 6		
☐ THIS WELL WILL NOT REPLACE AN EXISTING WELL ☐ THIS WELL WILL REPLACE A WELL THAT WILL BE ABANDONED AND SEALED ☐ THIS WELL WILL REPLACE A WELL THAT WILL BE USED AS A STANDBY ☐ THIS WELL WILL DEEPEM AN EXISTING WELL PERMIT NUMBER OF WELL TO BE REPLACED OR DEEPEMED (IF AVAILABLE)		

NOT TO BE FILLED IN BY DRILLER (WRA USE ONLY)	
APPROPRIATION PERMIT NUMBER	ENGINEER REVIEW DISTRICT NO.
84	63
FORCE	CONDITIONS
67 68	70 71 72 73 74 75 76 77 78 79

B 4	CONTINUED	HEALTH DEPARTMENT APPROVAL
1 2 3 (SEQ. NO.) 6		
41	STATE HEALTH (CIRCLE BOX)	
DATE	APPROVED BY	
08/27/79	Donald W. Monaghan, Sanitarian	

DRAW A SKETCH BELOW SHOWING LOCATION OF WELL IN RELATION TO NEARBY TOWNS, ROADS AND STREAMS WITH NORTH IN THE DIRECTION OF THE ARROW, AND GIVE DISTANCE FROM WELL TO NEAREST ROAD JUNCTION OR STREAM CROSSING SHOWN ON THE SKETCH. ALSO SHOW, BY MEANS OF AN "X", THE WELL LOCATION IN THE BOX BELOW AND THE BOX NUMBER FROM THE WELL LOCATION MAP.

B 5	CONTINUED	HEALTH DEPARTMENT APPROVAL
1 2 3 (SEQ. NO.) 6		
SPECIAL CONDITIONS 8-63 (WRA USE ONLY)		

LOCATION NOT APPROVED
 SEE ATTACHED SHEET
 9/18/79 R.D.
 Some other well

BOX NUMBER	E	N
810	470	

NORTH COORDINATE	EAST COORDINATE
80 81 82 83 84 85	57 58 59 60 61 62 63
ELEVATION AT WELL HEAD (FEET)	
65 66 67 68	

A27070


HEALTH

C 1	4032	SEQUENCE NO. (WRA USE ONLY)	STATE OF MARYLAND WATER RESOURCES ADMINISTRATION TAWES STATE OFFICE BLDG., ANNAPOLIS, MD. 21401		THIS REPORT MUST BE SUBMITTED WITHIN 30 DAYS AFTER WELL COMPLETION
1 2 3 (SEQ. NO.) 4		(THIS NUMBER IS TO BE PUNCHED IN COLS. 3-6 ON ALL CARDS)		FILE IN THIS FORM COMPLETELY	
DATE RECEIVED (WRA USE ONLY)		DATE WELL COMPLETED		PERMIT NO. FROM "PERMIT TO DRILL WELL"	
9/18/99		260		40-73-3427	
15 20		22 (TO NEAREST FOOT) 26		28 29 30 31 32 33 34 35 36 37	
OWNER <u>FULTZ</u>		LAST NAME <u>STEPHENS</u>		FIRST NAME <u>WILLIAM</u>	
STREET OR RFD <u>1400 CANTERBURY BLVD</u>		POST OFFICE <u>WILVER SPRINGS MD.</u>			
WELL DESCRIPTION					
WELL LOG					
STATE THE KIND OF FORMATIONS PENETRATED, THEIR COLOR, DEPTH, THICKNESS AND IF WATER BEARING					
DESCRIPTION (USE ADDITIONAL SHEETS IF NECESSARY)	FEET		CHECK IF WATER BEARING		
	FROM	TO			
TOP SOIL	0	2			
SAND	2	10			
BROWN SLATE	10	60			
MICA	60	65			
BROWN SLATE	65	70			
MICA	70	260			
GROUTING RECORD					
WELL HAS BEEN GROUTED (CIRCLE APPROPRIATE BOX) ☒ YES ☐ NO					
TYPE OF GROUTING MATERIAL (CIRCLE BOX):					
CEMENT ☒ C ☐ M		BENTONITE CLAY ☐ B ☐ C			
NO. OF BAGS <u>19</u>		NO. OF POUNDS <u>1900</u>			
GALLONS OF WATER <u>95</u>					
DEPTH OF GROUT SEAL (TO NEAREST FOOT)					
FROM <u>0</u>		TO <u>43</u>			
(ENTER 0 IF FROM SURFACE)					
CASING RECORD					
CASING TYPES					
(INSERT APPROPRIATE CODE BELOW)		☒ S ☐ T		☐ C ☐ O	
		STEEL		CONCRETE	
		☐ P ☐ L		☐ O ☐ T	
		PLASTIC		OTHER	
MAIN CASING TYPE ☒ S ☐ T		NOMINAL DIAMETER TOP (MAIN) CASING (NEAREST INCH) <u>6</u>		TOTAL DEPTH OF MAIN CASING (NEAREST FOOT) <u>63</u>	
		60 61 63 64 66 70			
OTHER CASING (IF USED)					
EACH CASING		DIAMETER (INCH)		DEPTH (FEET) FROM TO	
SCREEN RECORD					
SCREEN TYPE OR OPEN HOLE					
(INSERT APPROPRIATE CODE BELOW)		☒ S ☐ T		☐ B ☐ R	
		STEEL		BRASS OR BRONZE	
		☐ P ☐ L		☐ O ☐ T	
		PLASTIC		OTHER	
C 2					
1 2 3 (SEQ. NO.) 4					
DEPTH (NEAREST WHOLE FOOT)					
FROM <u>14</u>		TO <u>260</u>			
1 8 9 11 15 17 21					
2 23 24 26 30 32 36					
3 38 39 41 45 47 51					
SLOT SIZE 1. <u>2</u> 2. <u>3</u> 3. <u>4</u>					
DIAMETER OF SCREEN <u>56</u> (NEAREST INCH)					
FROM <u>56</u> TO <u>60</u>					
GRAVEL PACK <u>1</u>					
IF WELL DRILLED WAS A FLOWING WELL CIRCLE BOX ☒ 68 ☐ F					
WRA USE ONLY (NOT TO BE FILLED IN BY DRILLER):					
T ☐ 70		(E.R.O.S.) ☐ 72		W O ☐ 74 ☐ 75 ☐ 76	
TELESCOPE CASING		LOG INDICATOR		OTHER DATA AVAILABLE	
PUMPING TEST					
C 3					
1 2 3 (SEQ. NO.) 4					
HOURS PUMPED (TO NEAREST HOUR) <u>2</u>					
PUMPING RATE (GALLONS PER MINUTE TO NEAREST GALLON) <u>2</u>					
METHOD USED TO MEASURE PUMPING RATE <u>PISTON</u>					
WATER LEVEL: (DISTANCE FROM LAND SURFACE)					
BEFORE PUMPING <u>40</u>		(NEAREST FOOT) <u>20</u>			
WHEN PUMPING <u>260</u>		(NEAREST FOOT) <u>25</u>			
TYPE OF PUMPED USED (CIRCLE APPROPRIATE BOX) (FOR PUMPING TEST)					
☒ A AIR		☐ P PISTON		☐ T TURBINE	
☐ C CENTRIFUGAL		☐ R ROTARY		☐ O OTHER (DESCRIBE BELOW)	
☐ J JET		☐ S SUBMERSIBLE			
PUMP INSTALLED					
TYPE OF PUMP (WRITE APPROPRIATE LETTER IN BOX - SEE ABOVE: A, C, J, P, R, S, T, O)					
DRILLER WILL INSTALL PUMP (CIRCLE APPROPRIATE BOX) ☒ YES ☐ NO					
CAPACITY:					
GALLONS PER MINUTE (TO NEAREST GALLON) <u>31</u>		<u>35</u>			
PUMP HORSE POWER <u>37</u>		<u>41</u>			
PUMP COLUMN LENGTH (NEAREST FOOT) <u>43</u>		<u>47</u>			
CASING HEIGHT (CIRCLE APPROPRIATE BOX AND ENTER CASING HEIGHT)					
☒ ABOVE		LAND SURFACE (NEAREST FOOT) <u>2</u>			
☐ BELOW		49 50 51			
LOCATION OF WELL ON LOT					
SHOW PERMANENT STRUCTURE SUCH AS BUILDINGS, SEPTIC TANKS, AND/OR OTHER LAND MARKS AND INDICATE NOT LESS THAN TWO DISTANCES (MEASUREMENTS TO WELL).					
CIRCLE APPROPRIATE BOXES					
☐ A A WELL WAS ABANDONED AND SEALED WHEN THIS WELL WAS COMPLETED					
☐ E ELECTRIC LOG OBTAINED					
☐ P TEST WELL CONVERTED TO PRODUCTION WELL					
I HEREBY CERTIFY THAT I HAVE COMPLIED WITH ALL CONDITIONS STATED ON THE ABOVE-CAPTIONED "PERMIT TO DRILL WELL", AND THAT INFORMATION CONTAINED IN THIS REPORT IS TRUE, ACCURATE, AND COMPLETE TO THE BEST OF MY KNOWLEDGE, INFORMATION AND BELIEF.					
DRILLER'S NAME					
(PLEASE PRINT) <u>George F. Farnham</u>					
SIGNATURE <u>George A. Carter</u>					

B41501

moved house 10' to the right

231.62'

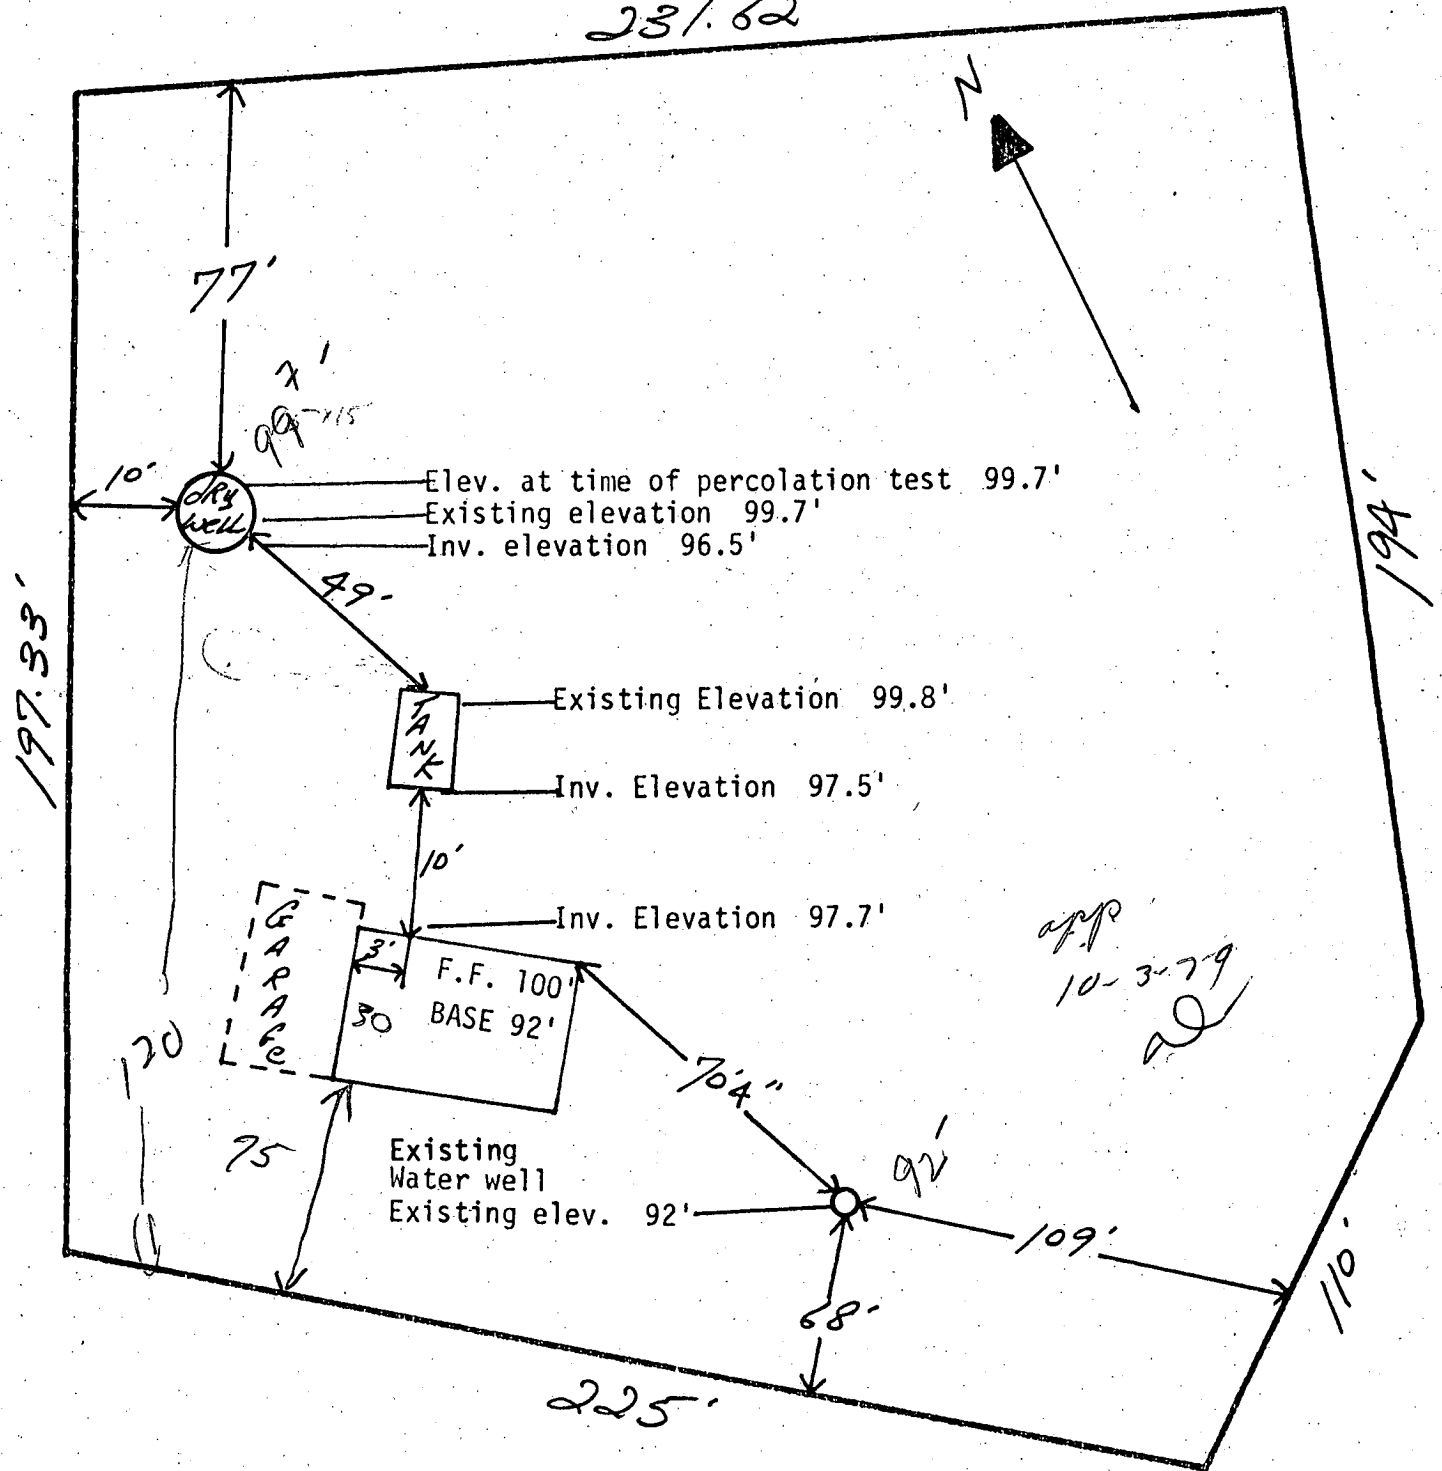



ROAD

I CERTIFY THE ABOVE MEASUREMENTS AND ELEVATIONS ARE ACTUAL AND CORRECT FOR THIS PROPERTY.

SIGNED:

Stephen R. Fultz

COORDINATES			CURVE DATA						
NO	NORTH	EAST	CURVE	RADIUS	LENGTH	Δ	TAN.	CHD. BRG. & DIST.	
1	478041.777	817354.232	1-2	711.17'	225.00'	18° 07' 38"	113.45'	N54° 40' 50" W 224.06'	
2	478171.315	817171.409							
3	478353.986	817246.041							
4	478310.085	817473.462							
5	478120.394	817431.170							

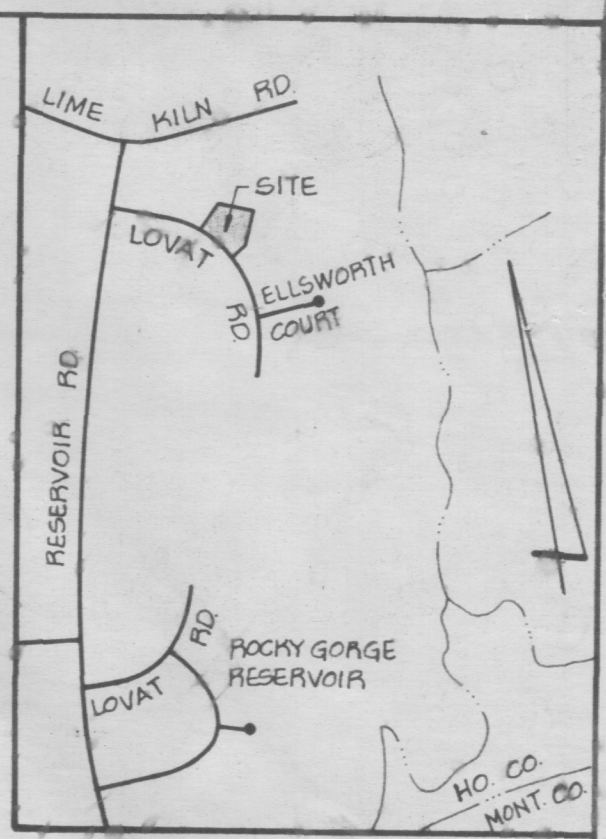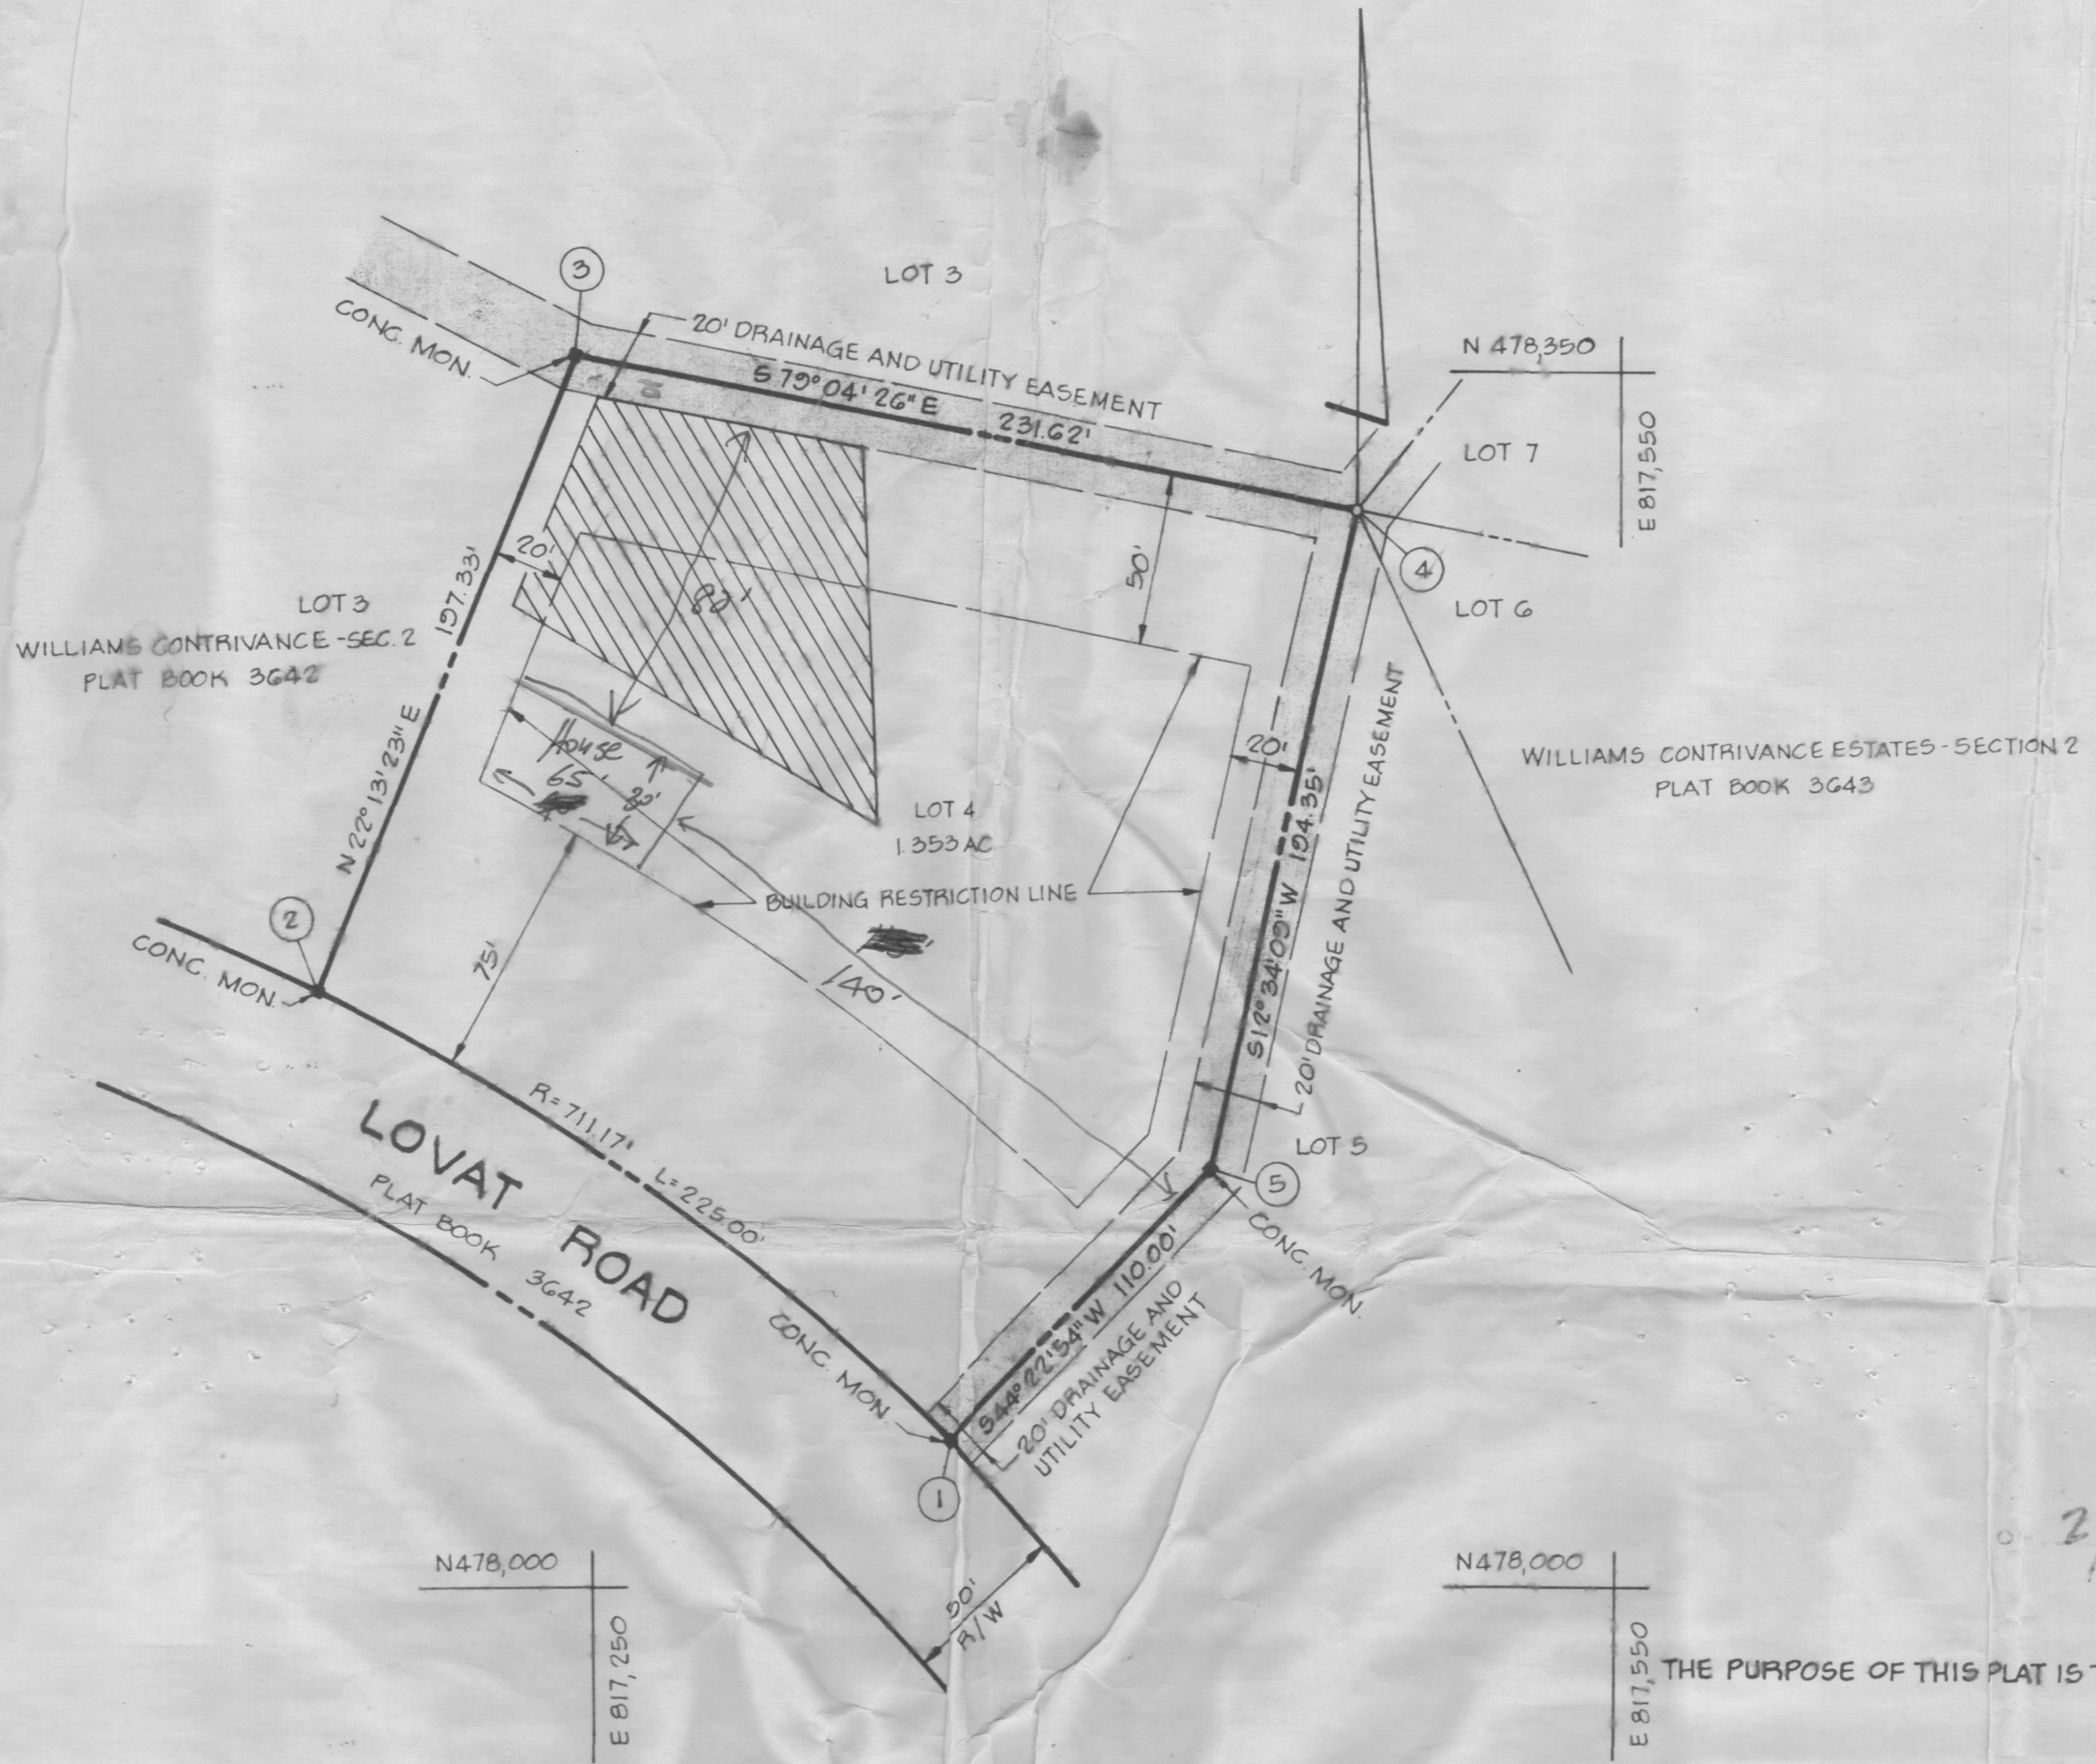

GENERAL NOTES

- DEED REFERENCE: 402/266.
- THE LOTS SHOWN HEREON COMPLY WITH THE MINIMUM OWNERSHIP WIDTH AND LOT AREAS REQUIRED BY THE MARYLAND STATE DEPARTMENT OF HEALTH AND MENTAL HYGIENE.
- THIS AREA INDICATES A PRIVATE SEWAGE EASEMENT OF APPROXIMATELY 10000 SQ. FT. AS REQUIRED BY THE MARYLAND STATE DEPARTMENT OF HEALTH AND MENTAL HYGIENE FOR INDIVIDUAL SEWAGE DISPOSAL. IMPROVEMENTS OF ANY NATURE IN THIS AREA IS RESTRICTED UNTIL PUBLIC SEWAGE IS AVAILABLE AND SERVICING ANY RESIDENTIAL STRUCTURES CONSTRUCTED ON THESE BUILDING SITES. THIS EASEMENT SHALL BECOME NULL AND VOID UPON CONNECTION TO A PUBLIC SEWAGE SYSTEM.
- DATUM SHOWN HEREON IS BASED ON HOWARD COUNTY CONTROL POINT NO. 2037002 AND NO. 2037001. THE ADJOINING AND EXISTING SUBDIVISIONS ARE IN ASSUMED DATUM. THE DIFFERENCE IN THE ADJOINING AREAS IS 08° 30' 05".
- ALL PERC TEST HOLE LOCATIONS HAVE BEEN FIELD LOCATED.

2/7 78 3958
HOWARD COUNTY, MD.

THE PURPOSE OF THIS PLAT IS TO REVISE THE PRIVATE SEWAGE EASEMENT.

AREA TABULATIONS

- TOTAL NO. OF LOTS: 1
- TOTAL AREA OF LOTS: 1.353 AC.
- TOTAL AREA OF ROAD DEDICATION: NONE
- TOTAL AREA OF PLAT: 1.353 AC.

BOENDER ASSOCIATES, INC.

SUITE 102-107
TOWN & COUNTRY PROFESSIONAL BLDG.
ELLCOTT CITY, MD. 21043

APPROVED: FOR PRIVATE WATER AND PRIVATE SEWAGE SYSTEMS. HOWARD COUNTY HEALTH DEPARTMENT.

Jaym Boush 1-19-78
COUNTY HEALTH OFFICER DATE

APPROVED: HOWARD COUNTY OFFICE OF PLANNING AND ZONING

Thomas L. Harris 2-1-78
DIRECTOR DATE

APPROVED: FOR STORM DRAINAGE SYSTEMS AND PUBLIC ROADS. HOWARD COUNTY DEPARTMENT OF PUBLIC WORKS.

W. J. Regard 1-25-78
DIRECTOR DATE

OWNERS STATEMENT

WE, C. ELLSWORTH IAGER, MARY ELIZABETH IAGER, C. ORMAN MANAHAN AND DOROTHY W. MANAHAN, OWNERS OF THE PROPERTY SHOWN AND DESCRIBED HEREON, HEREBY ADOPT THIS PLAN OF SUBDIVISION, AND IN CONSIDERATION OF THE APPROVAL OF THIS PLAT BY THE OFFICE OF PLANNING AND ZONING ESTABLISH THE MINIMUM BUILDING RESTRICTION LINES. ALL EASEMENTS OR RIGHTS-OF-WAY AFFECTING THE PROPERTY ARE INCLUDED IN THIS PLAN OF SUBDIVISION.

WITNESS OUR HANDS THIS 11TH DAY OF NOVEMBER, 1977

C. Ellsworth Iager *Orman Manahan*
Mary Elizabeth Iager *Dorothy W. Manahan*
WITNESS WITNESS

SURVEYORS CERTIFICATE

I HEREBY CERTIFY THAT THE FINAL PLAT SHOWN HEREON IS CORRECT, THAT IT IS A REVISION TO LOT 4, "WILLIAMS CONTRIVANCE" SECTION 2, AS SHOWN ON A PLAT OF SUBDIVISION ENTITLED "WILLIAMS CONTRIVANCE" SECTION 2 AND RECORDED AMONG THE LAND RECORDS OF HOWARD COUNTY, MARYLAND IN PLATBOOK 3642, SAID LOT ALSO BEING A PART OF THE LAND CONVEYED BY GRACE F. BASSLER TO C. ELLSWORTH IAGER, MARY ELIZABETH IAGER, C. ORMAN MANAHAN AND DOROTHY W. MANAHAN BY DEED DATED JUNE 27, 1963 AND RECORDED AMONG THE AFORESAID LAND RECORDS IN LIBER 402 AT FOLIO 266 AND THAT ALL MONUMENTS ARE IN PLACE AS SHOWN IN ACCORDANCE WITH THE ANNOTATED CODE OF MARYLAND, AS AMENDED.

William G. Hartel 11-23-77
WILLIAM G. HARTEL, P.L.S. NO. 9436 DATE

OWNER & DEVELOPER

C. ELLSWORTH IAGER, ET AL
FULTON, MARYLAND 21043

A REVISION TO LOT 4
WILLIAMS CONTRIVANCE ESTATES
SECTION 2

TAX MAP 45 PARCEL 2
5TH ELECTION DISTRICT HOWARD COUNTY, MD.
SCALE: 1"=50' NOVEMBER, 1977