

PERMIT

SEWAGE DISPOSAL SYSTEM

MARYLAND STATE DEPARTMENT OF HEALTH*

HOWARD COUNTY

ELLICOTT CITY

DISTRICT 4th

INDEXED

DATE 12/29/78

Old Line Construction Corporation

IS PERMITTED TO INSTALL ☒ ALTER

ADDRESS Middletown, Maryland 21769

PHONE 371-5770

SUBDIVISION ROAD 14080 Triadelphia Road

LOT

PROPERTY OWNER John J. Easter

ADDRESS 158 Cherrydell Road, Baltimore, Md. 21228

Phone: 744-1465

SPECIFICATIONS 3 bedrooms

SEPTIC TANK CAPACITY 1000 GALLONS

DRAIN FIELD DEPTH FEET, BOTTOM AREA SQ. FT.

DEEP TRENCH DEPTH FEET, BOTTOM AREA SQ. FT.

SEEPAGE PITS ☒ ABSORBENT SIDE-WALL AREA 360 SQ. FT. total sidewall area in dry well.

INLET PIPE 4 FT. BELOW ORIGINAL GRADE. MAXIMUM DEPTH 11 FT. BELOW ORIGINAL GRADE

EFFECTIVE DEPTH AT 200 FT. BELOW ORIGINAL GRADE.

LOCATE DISPOSAL AREA 95 FT. FROM rear LOT LINE AND 200 FT. FROM right LOT LINE AS SEEN WHEN FACING LOT FROM Triadelphia Road.

PLANS APPROVED BY George Keller

DATE 8/23/78

COVER NO WORK UNTIL INSPECTED AND APPROVED.

NEITHER THE HOWARD COUNTY COUNCIL NOR THE HEALTH DEPARTMENT IS RESPONSIBLE FOR THE SUCCESSFUL OPERATION OF ANY SYSTEM.

NOTE: IF TRENCH IS USED CALL FOR INSPECTION BEFORE PLACING GRAVEL IN TRENCH.

NOTE: NO DRY WELL SHALL EXCEED 15 FOOT IN DIAMETER.

NOTE: ALL PIPE FROM HOUSE TO DISPOSAL AREA MUST BE CAST IRON.

PERMIT VOID AFTER THREE YEARS.


NOTE: INSTALL STAND PIPE ON SEPTIC TANK AND DRY WELL. STAND PIPES MUST BE 6 INCHES IN DIAMETER. CAST IRON, CONCRETE OR TERRA COTTA ACCEPTED.

*INSTALLER IS RESPONSIBLE FOR OBTAINING FINAL APPROVAL ON THIS PERMIT.

BDDG. PERMIT SIGNED
AND RETURNED 8/25/78

Small # P453
Gale

A 28640

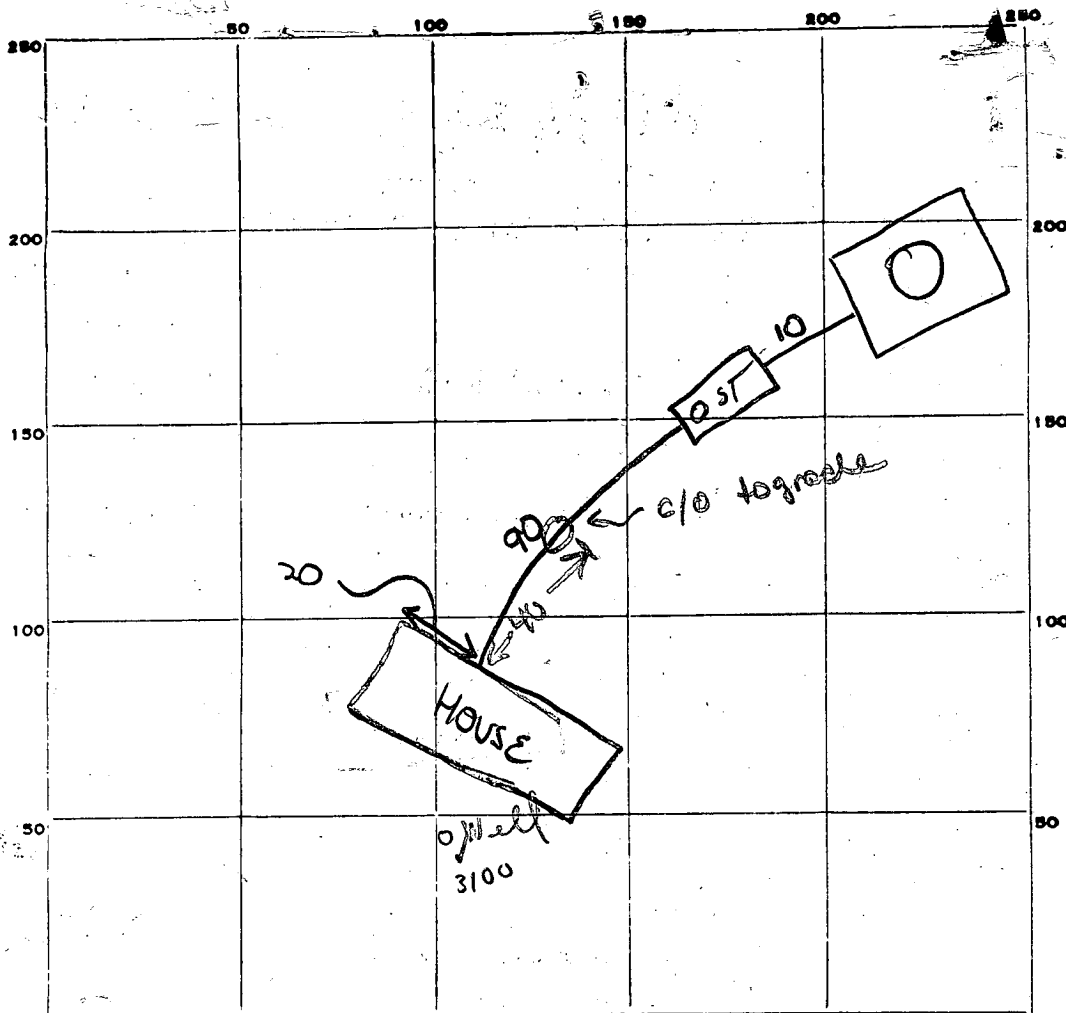

INDICATE NORTH. - NAME ADJOINING ROADWAY AS BASE LINE.

PERMIT CARD

Not seen left one night full of house in inspection

S.T.	D.W.	SEWER
✓	✓	✓

SEPTIC TANK, LEVEL

OK

CLEANOUTS

C.I. C.I.

DISTRIBUTION BOX, LEVEL

N/A

TILE FIELD, DEPTH _____ FT. TRENCH WIDTH _____ FT.

GRAVEL DEPTH _____ IN. TOTAL LENGTH _____ FT.

NUMBER OF TRENCHES _____ TOTAL BOTTOM AREA _____

SEEPAGE PITS, INSIDE DIAMETER

55

FT. DEPTH BELOW INLET

6 1/2 FT. ±358

ABSORBENT AREA ±358 SQ. FT.

REMARKS

4/26/79 AM. Held down well appears in wrong area - stop work (Partial) P.M. Jack's called in - discussed - recommend retreat below system as it is in 1/2 relocate system per house plans C.B.S. He is to be in touch with supervisor.

MAY 79 - System OK except for cleanout on house sewer.

Install cleanout 3 call before backfilling. (GLK) 2 MAY 79 - FINAL OK (641)

DATE SYSTEM APPROVED

2 MAY 79

INSPECTOR

George F. Keller

APPLICATION

SEWAGE DISPOSAL TESTING

STATE OF MARYLAND - DEPARTMENT OF HEALTH AND MENTAL HYGIENE

HOWARD COUNTY HEALTH DEPARTMENT
ENVIRONMENTAL HEALTH SERVICES

P.O. BOX 476 ELLICOTT, MARYLAND 21043
TELEPHONE: 992-2330

A 29761

P _____

DISTRICT 4th

DATE 4/27/79

TO: THE COUNTY HEALTH OFFICER
ELLICOTT CITY, MARYLAND

I, HEREBY, APPLY FOR THE NECESSARY TEST IN ORDER TO CONSTRUCT (OR RECONSTRUCT) A SEWAGE DISPOSAL SYSTEM.

PROPERTY OWNER John J. Easter

ADDRESS 158 Cherrydell Road, Baltimore, Md. PHONE 744-1465

PROPERTY LOCATION:

SUBDIVISION _____ LOT NO. _____

ROAD AND DESCRIPTION 14080 Triadelphia Road

SIZE OF LOT _____ TYPE BLDG. 3 or 4 bedrooms

THE SYSTEM INSTALLED UNDER THIS APPLICATION IS ACCEPTABLE ONLY UNTIL PUBLIC FACILITIES BECOME AVAILABLE.

I FULLY UNDERSTAND THE FEE CONNECTED WITH THE FILING OF THIS PERC TEST APPLICATION IS NON-REFUNDABLE UNDER ANY CIRCUMSTANCES.

SIGNATURE OF APPLICANT /s/ Mike Sacks - Old Line Construction Corp.

APPROVED BY _____ FOR _____ DATE _____


REJECTED BY _____ FOR _____ DATE _____

HOLD PENDING FURTHER TESTS _____ DATE _____


REASONS FOR REJECTION OR HOLDING _____

THIS IS NOT A PERMIT

⑥⑦⑧
SOIL PROFILE

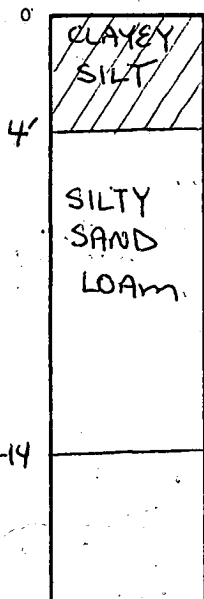


Hole ⑤ → hole ④

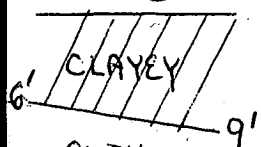

SMALL AMTS weathered mica

DRY

Sachs
371-5770

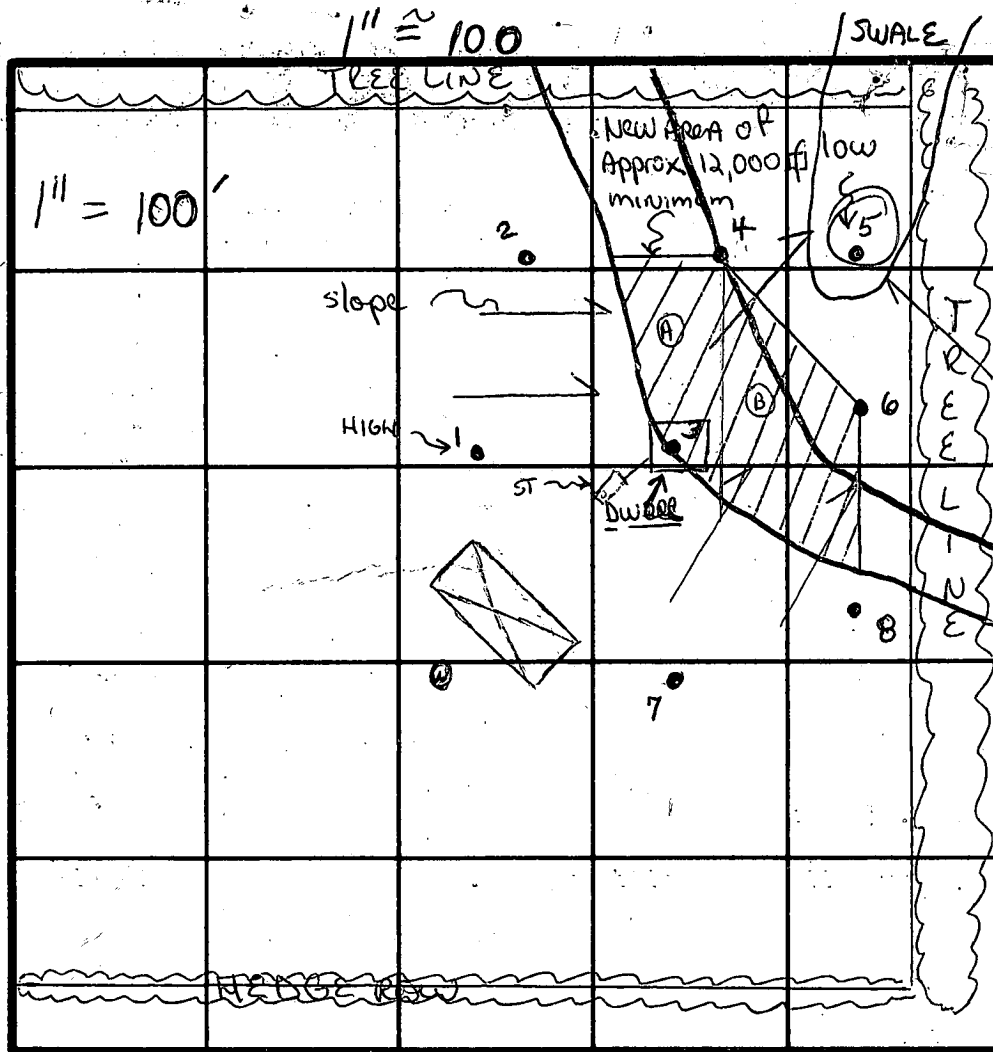

low → high
Elevation
⑤ → DW = 12'
⑤ → ⑥ = 7'
⑥ → DW = 5'
DW → ⑦ = 2 1/2'
DW → ⑧ = 2'
To feed ⑦ from Drywell:
DW out - 3'
100' @ 1/4" - 2'
elevation - 2 1/2'
invert 7 1/2' at ⑦
SAME CONTOURS SIGHT LEVEL
A ≈ 4900 cf
B ≈ 8250 cf
TOTAL

INDICATE NORTH - NAME ADJOINING ROADWAY AS BASE LINE.

TRIDELPHIA ROAD

DATE	TEST NO.	DEPTH	PRE-WET		TEST - 1" DROP		TIME	
			START	STOP	START	STOP		
5/1/79	5	14'	(see profile)		BAD - CLAYEY			
	6S	4'	1015	1017	1017	1021	4	
	6D	13 1/2'	SILTY LOAM - CAVING IN - COULD NOT TEST					
	7S	4'	1036	1040	1040	1045	5	
	7D	13'	1033	1035	1035	1037	2	
	8'	14'	VISUAL - see profile				SIMILAR TO HOLE ⑧	
	1 → 4	previously tested on 8/23/79 3 Approved						

REMARKS Retest - System put in wrong (LOW) Hole previous PERC AREA

TYPE OF SOIL see profile

TESTED BY GLK + BH

ALSO PRESENT Sachs / Bollinger / Easter

APPLICATION

SEWAGE DISPOSAL TESTING

STATE OF MARYLAND - DEPARTMENT OF HEALTH AND MENTAL HYGIENE

HOWARD COUNTY HEALTH DEPARTMENT
ENVIRONMENTAL HEALTH SERVICES

P.O. BOX 476 ELLICOTT, MARYLAND 21043
TELEPHONE: 992-2330

A 28640
P _____

DISTRICT 4th
DATE 8/7/78

TO: THE COUNTY HEALTH OFFICER
ELLICOTT CITY, MARYLAND

I HEREBY APPLY FOR THE NECESSARY TEST IN ORDER TO CONSTRUCT (OR RECONSTRUCT) A SEWAGE DISPOSAL SYSTEM.

PROPERTY OWNER JAMES J. PATTERSON ETAL JOHN J. + DOROTHY P. EASTER
CONTRACT BUYER
ADDRESS 158 CHERRYDELL ROAD CATONSVILLE PHONE 744-1465
21228

PROPERTY LOCATION:

SUBDIVISION _____ LOT NO. _____
ROAD AND DESCRIPTION BEHIND 14050 TRIADELPHIA ROAD - 14080 Triadelphia
GLENELG MD. 21737

SIZE OF LOT APPROX 20 ACRES TYPE BLDG. 3 BR - MODULAR

THE SYSTEM INSTALLED UNDER THIS APPLICATION IS ACCEPTABLE ONLY UNTIL PUBLIC FACILITIES BECOME AVAILABLE.

I FULLY UNDERSTAND THE FEE CONNECTED WITH THE FILING OF THIS PERC TEST APPLICATION IS NON-REFUNDABLE UNDER

ANY CIRCUMSTANCES.

SIGNATURE OF APPLICANT Dorothy P. Easter BLDG. PERMIT SIGNED
AND RETURNED 12/27/78
Serial No. 37694

APPROVED BY B. Keller FOR Daynard DATE 8/23/78

REJECTED BY _____ FOR _____ DATE _____



HOLD PENDING FURTHER TESTS _____ DATE _____

REASONS FOR REJECTION OR HOLDING Hold for certified holes - owner's notified verbally (GLK) 23 Aug. 78
Plot received 21 Sept 78 (GLK) 27 Sept 78 - Talked to MR. EASTER who realized "problems" i had met with
engineer yesterday. Engineer will contact HCHD (GLK) 12/12/78 Hold for elevations. (GLK)

THIS IS NOT A PERMIT

ALL HOLES
CONSISTENT

SOIL PROFILE

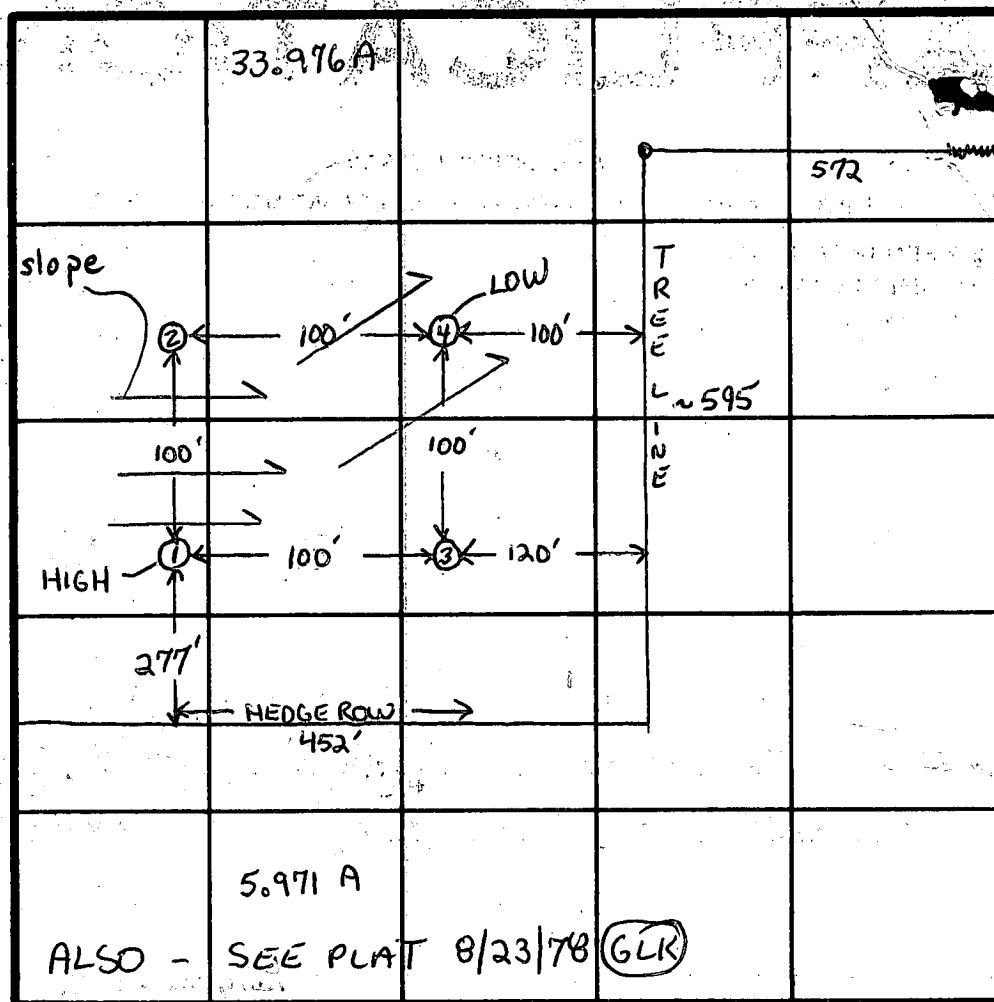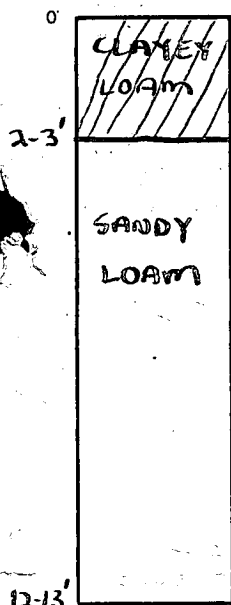

if needed
Run trench
toward ③

ELEVATION
DIFFERENCE:

① → ④ = 3-4'

INDICATE NORTH - NAME ADJOINING ROADWAY AS BASE LINE.

TRIDELPHIA ROAD

DATE	TEST NO.	DEPTH	PRE-WET		TEST - 1" DROP		TIME
			START	STOP	START	STOP	
8/23/78	15 - HIGH	5'	945	946	946	948	2
	10 - HIGH	13'	945	946	946	951	5
	2	12'	VISUAL - See profile				
	35	4'	1004	1006	1006	1010	4
	30	14'	1005	1010	1010	1119	9
	45 - LOW	3 1/2'	951	954	954	956	2
	40	13'	953	956	956	1002	6


good soil
at 3'

REMARKS Owner's present and stated that they intend to have SKINNER survey land & field locate holes.

TYPE OF SOIL Sandy loam with little or no clay layer

TESTED BY (GLK) + JS

ALSO PRESENT Easter/Brittlingham

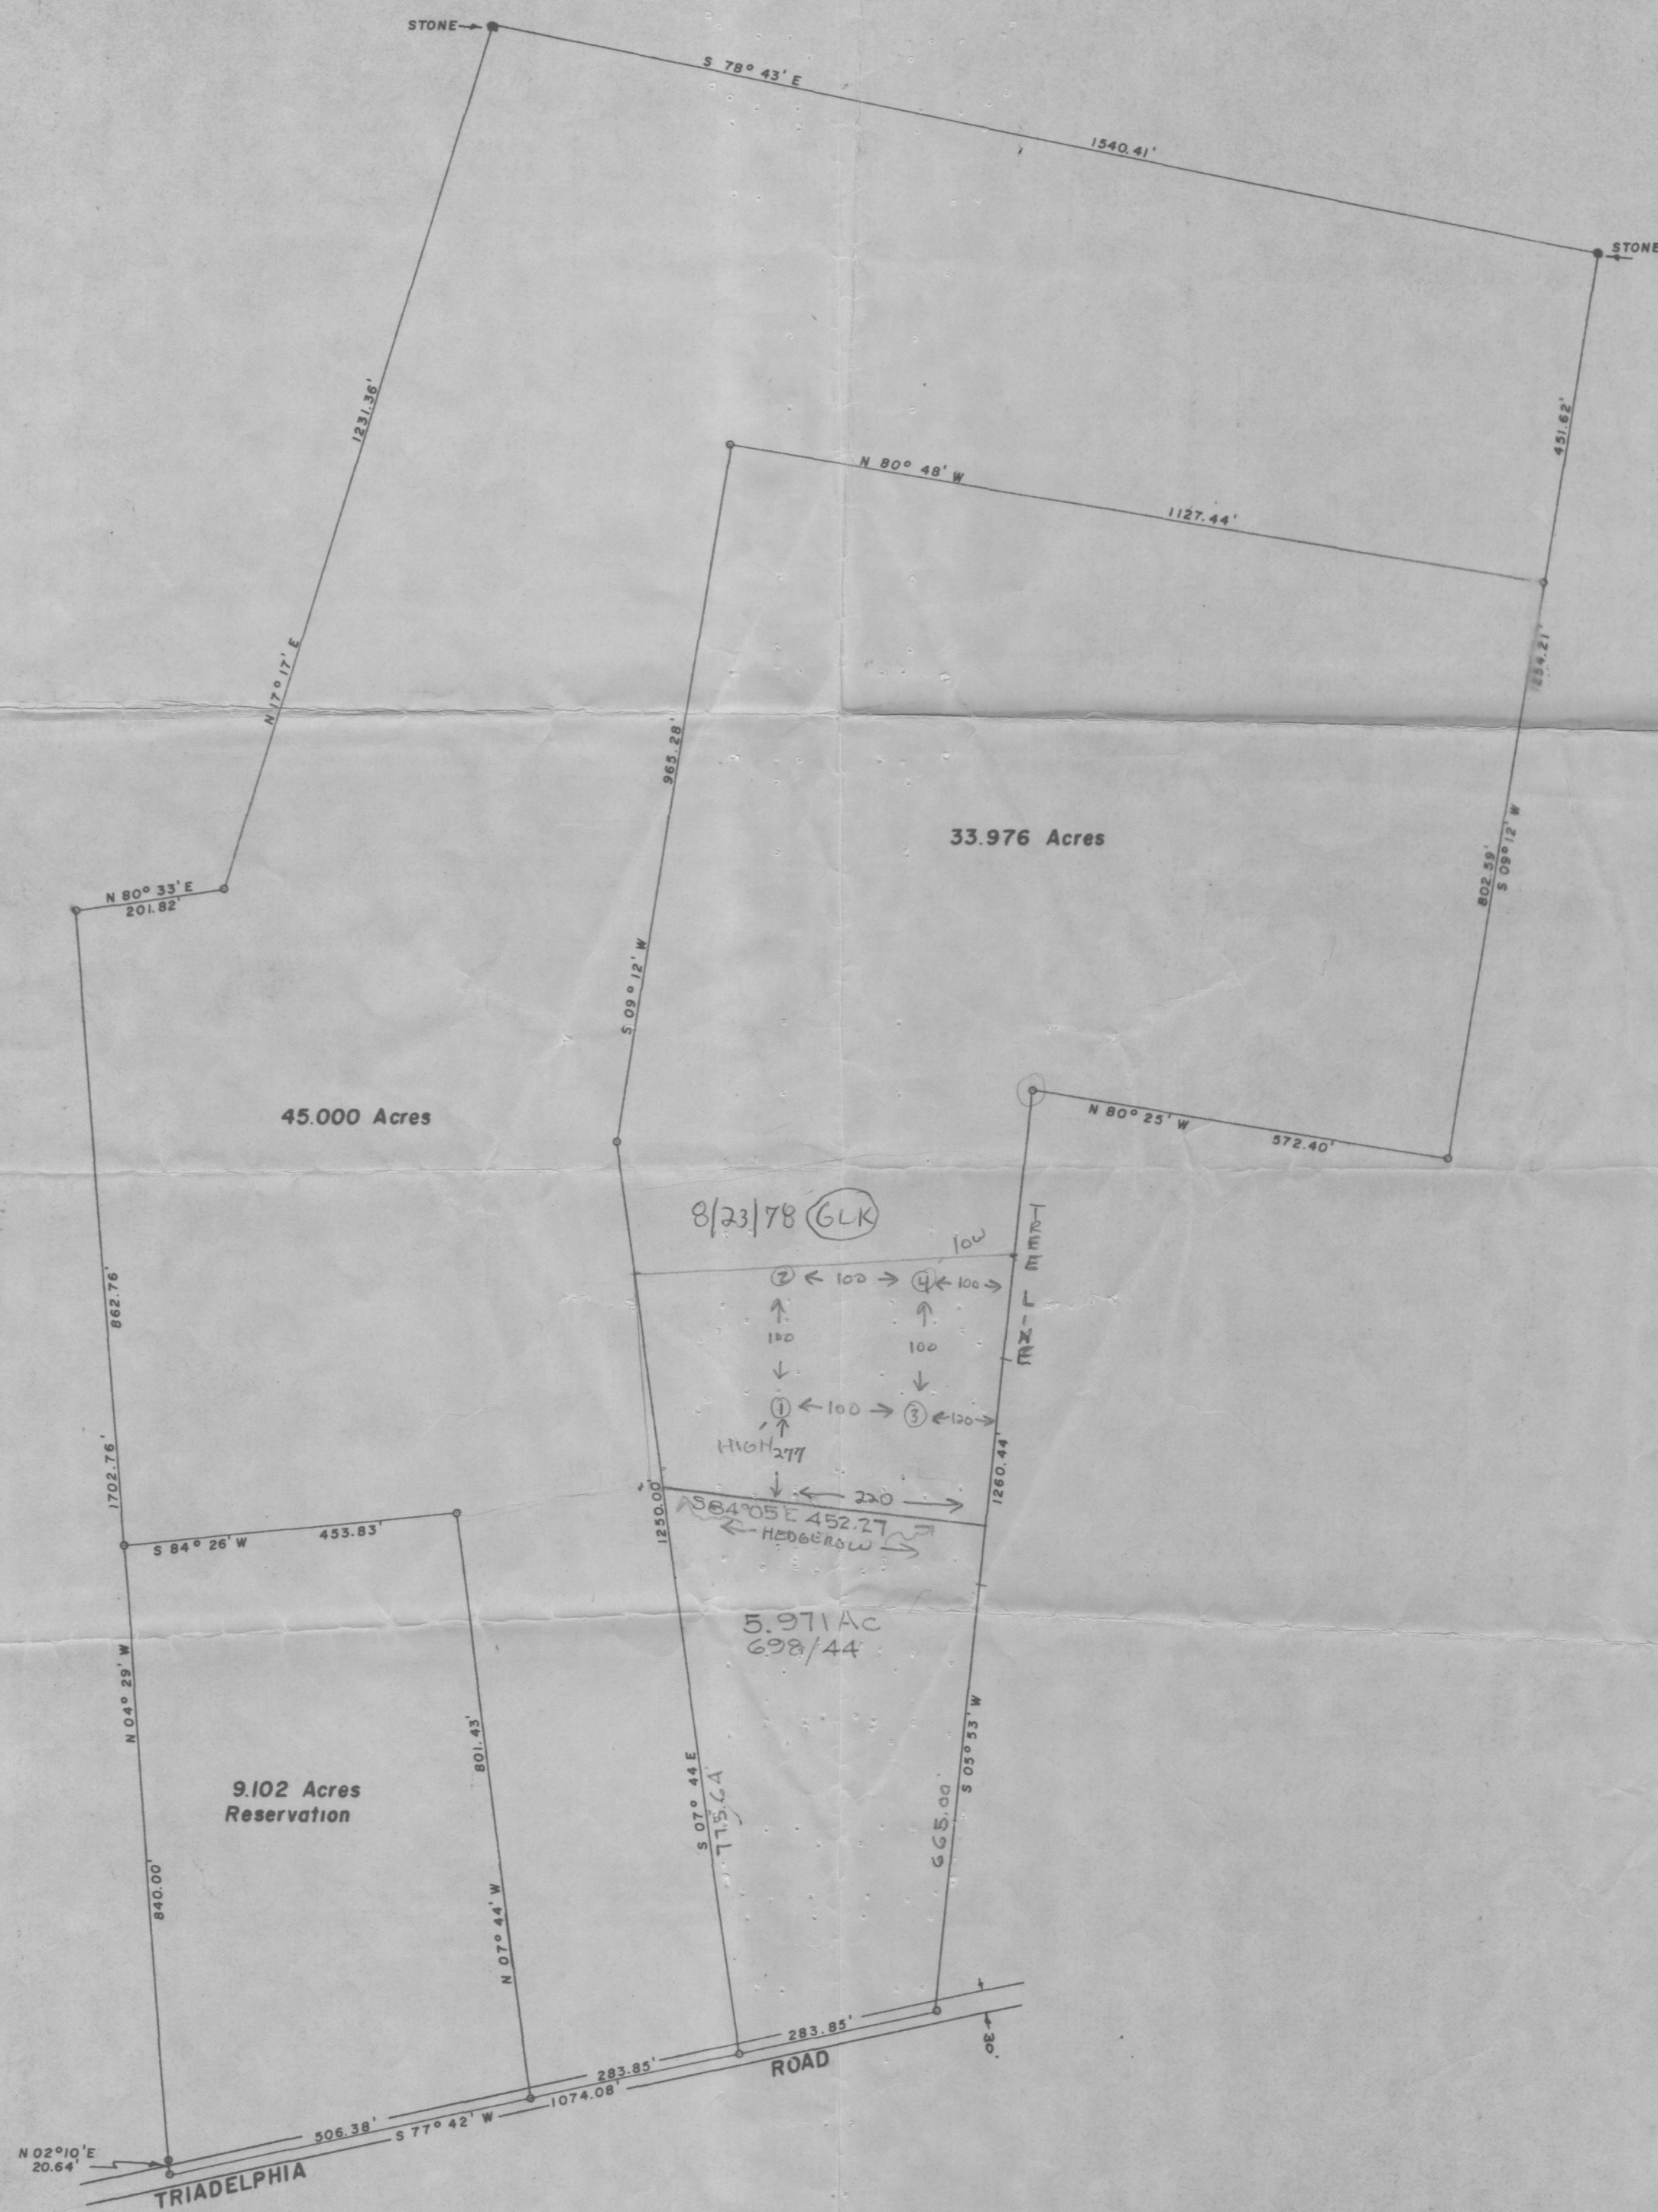

PLAT OF SURVEY
FOR
WALTER J. PATTERSON
FOURTH ELECTION DISTRICT OF HOWARD COUNTY
GLENELG, MARYLAND
SCALE: 1 IN. = 200 FT. APRIL 15, 1965

Claude M. Skinner, Jr.
Claude M. Skinner Jr. Reg. Engineer & Land Surveyor No. 2237

NOTE: Plot Revised to show 5.971 acre parcel.
Cande M. Skimming 8/7/78



C - 2495

EASTER

DRILLER: OBTAIN HEALTH DEPT. APPROVAL AND RETURN ALL PARTS OF THIS FORM INTACT TO THE WATER RESOURCES ADMINISTRATION.

EMERGENCY NO. (If any) -

B 1	3143	SEQUENCE NO. (WRA USE ONLY)	STATE OF MARYLAND WATER RESOURCES ADMINISTRATION TAWES STATE OFFICE BLDG., ANNAPOLIS, MARYLAND 21401 APPLICATION FOR PERMIT TO DRILL WELL	WRA PERMIT NUMBER 140-73-3100
1 2 3 (SEQ. NO.) 0 (THIS NUMBER IS TO BE PUNCHED IN COLS. 3-6 ON ALL CARDS)		FILL IN THIS FORM COMPLETELY		

DATE RECEIVED (WRA USE ONLY) 12/15/78 11:00 A.M. 2nd	<table style="width:100%;"> <tr> <td style="width:50%;">OWNER <u>EASTER</u></td> <td style="width:50%;">OWNER <u>JOHN</u></td> </tr> <tr> <td style="font-size: 8pt;">COL 15 LAST NAME</td> <td style="font-size: 8pt;">FIRST NAME COL. 34</td> </tr> <tr> <td colspan="2">STREET OR RFD <u>14080 TRIADELPHIA RD.</u></td> </tr> <tr> <td style="font-size: 8pt;">COL 36</td> <td style="font-size: 8pt;">COL. 55</td> </tr> <tr> <td colspan="2">POST OFFICE <u>GLENELG, MD.</u></td> </tr> <tr> <td style="font-size: 8pt;">COL 57</td> <td style="font-size: 8pt;">COL. 76</td> </tr> </table>	OWNER <u>EASTER</u>	OWNER <u>JOHN</u>	COL 15 LAST NAME	FIRST NAME COL. 34	STREET OR RFD <u>14080 TRIADELPHIA RD.</u>		COL 36	COL. 55	POST OFFICE <u>GLENELG, MD.</u>		COL 57	COL. 76
OWNER <u>EASTER</u>	OWNER <u>JOHN</u>												
COL 15 LAST NAME	FIRST NAME COL. 34												
STREET OR RFD <u>14080 TRIADELPHIA RD.</u>													
COL 36	COL. 55												
POST OFFICE <u>GLENELG, MD.</u>													
COL 57	COL. 76												

B 1	CONTINUED	DRILLER INFORMATION
1 2 3 (SEQ. NO.) 0		
DATE <u>11/30/78</u>		LICENSE NUMBER <u>303</u>
77 80		
FIRST NAME <u>WILLIAM</u>		DRILLER LAST NAME <u>QUYNN</u>
SIGNATURE <u>William B. Quynn</u>		

B 3	LOCATION OF WELL
1 2 3 (SEQ. NO.) 0	
COUNTY <u>HOWARD</u>	
(DO NOT ABBREVIATE COUNTY NAME) 21	
SUBDIVISION <u>DAYTON</u>	42
SECTION <u>44</u>	LOT <u>48</u>
50	50
NEAREST TOWN <u>DAYTON</u>	
52	71
MILES FROM TOWN (ENTER 0 IF IN TOWN) <u>3</u>	
73	76 77 78

B 2	WELL INFORMATION
1 2 3 (SEQ. NO.) 0	
MAXIMUM PUMPING RATE (GALLONS PER MINUTE) <u>5</u>	
8 12	
AVERAGE DAILY QUANTITY NEEDED (GALLONS PER DAY) <u>500</u>	
14 20	
USE FOR WATER (CIRCLE APPROPRIATE BOX)	
☒ HOME (SINGLE OR DOUBLE HOUSEHOLD UNIT ONLY) ☐ FARMING, AGRICULTURE, IRRIGATION ☐ INDUSTRIAL, COMMERCIAL, STATE AND FEDERAL GOVERNMENT. ☐ MUNICIPAL WATER SUPPLY ☐ PRIVATE WATER COMPANY ☐ TEST	
22	

B 4	DIRECTION FROM TOWN (CIRCLE APPROPRIATE BOX)
1 2 3 (SEQ. NO.) 0	
☒ NORTH ☐ EAST ☐ NE NORTHEAST ☐ SE SOUTHEAST ☐ SOUTH ☐ WEST ☐ NW NORTHWEST ☐ SW SOUTHWEST	
NEAR WHAT ROAD <u>TRIADELPHIA RD.</u>	
8 9	
ON WHICH SIDE OF ROAD (CIRCLE APPROPRIATE BOX) ☒ NORTH ☐ SOUTH ☐ EAST ☐ WEST	
11 30	
DISTANCE FROM ROAD (ENTER DISTANCE AND CIRCLE APPROPRIATE BOX) <u>400</u>	
34 37 38 39	

APPROXIMATE DEPTH OF WELL <u>200</u>	24 28 FEET
APPROXIMATE DIAMETER OF WELL <u>6</u> (NEAREST INCH)	

METHOD OF DRILLING USED (CIRCLE APPROPRIATE METHOD)	
☒ BORED (OR AUGERED) ☒ JETTED ☐ DRIVEN ☒ AIR-ROTARY ☐ AIR-PERCUSSION ☐ ROTARY (HYDRAULIC ROTARY) ☐ CABLE ☐ REVERSE-ROTARY ☐ DRIVE-POINT	
OTHER (DESCRIBE)	

REPLACEMENT OR DEEPEINED WELLS (CIRCLE APPROPRIATE BOX)	
☐ THIS WELL WILL NOT REPLACE AN EXISTING WELL ☐ THIS WELL WILL REPLACE A WELL THAT WILL BE ABANDONED AND SEALED ☐ THIS WELL WILL REPLACE A WELL THAT WILL BE USED AS A STANDBY ☐ THIS WELL WILL DEEPEN AN EXISTING WELL PERMIT NUMBER OF WELL TO BE REPLACED OR DEEPEINED (IF AVAILABLE)	
41 52	

NOT TO BE FILLED IN BY DRILLER (WRA USE ONLY)	
APPROPRIATION PERMIT NUMBER <u>84</u> ENGINEER REVIEW DISTRICT NO. <u>65</u> FORCE <u>67</u> WRITE INITIALS IN BOX CONDITIONS <u>70 71 72 73 74 75 76 77 78 79</u>	

DRAW A SKETCH BELOW SHOWING LOCATION OF WELL IN RELATION TO NEARBY TOWN, ROADS AND STREAMS WITH NORTH IN THE DIRECTION OF THE ARROW, AND GIVE DISTANCE FROM WELL TO NEAREST ROAD JUNCTION OR STREAM CROSSING SHOWN ON SKETCH. ALSO SHOW, BY MEANS OF AN "X", THE WELL LOCATION IN THE BOX BELOW AND THE BOX NUMBER FROM THE WELL LOCATION MAP.

N
↑ WELL

65'-CASING
2'-ABOVE GR.
36'-OPEN HOLE

TRIADELPHIA

50'-JET

11-BAGS CEMENT

J8 12/15/78


TEN
CAKES
RD.
DAYTON

BOX NUMBER <u>800</u>	BOX NUMBER <u>520</u>
E	N

B 4	CONTINUED	HEALTH DEPARTMENT APPROVAL
1 2 3 (SEQ. NO.) 0		
DATE <u>12/15/78</u>		W29317
COUNTY NAME <u>Howard</u>		COUNTY NO. <u>1</u>

NORTH COORDINATE <u>60 61 62 63 64 65</u>	EAST COORDINATE <u>70 71 72 73 74 75</u>
---	--

1 2 3 (SEQ. NO.) 4 5971		SEQUENCE NO. (WRA USE ONLY)		STATE OF MARYLAND WATER RESOURCES ADMINISTRATION TAWES STATE OFFICE BLDG., ANNAPOLIS, MD. 21401 WELL COMPLETION REPORT		THIS REPORT MUST BE SUBMITTED WI IN 30 DAYS AFTER WELL COMPLET FILL IN THIS FORM COMPLETELY COUNTY NUMBER	
DATE RECEIVED (WRA USE ONLY)		DATE WELL COMPLETED 12/15/78		DEPTH OF WELL 150 22 (TO NEAREST FOOT) 26		PERMIT NO. FROM "PERMIT TO DRILL WELL" HO-33100 28 29 30 31 32 33 34 35 36 37	
OWNER EASTER		STREET OR RFD 14080 TRIADDELPHIA RD		POST OFFICE GLENELG, MD.		DRILLERS IDENTIFICATION NO. 303	
WELL LOG				WELL DESCRIPTION			
STATE THE KIND OF FORMATIONS PENETRATED, THEIR COLOR, DEPTH, THICKNESS AND IF WATER BEARING				GROUTING RECORD YES NO WELL HAS BEEN GROUTED (CIRCLE APPROPRIATE BOX) ☒ ☐ TYPE OF GROUTING MATERIAL (CIRCLE BOX) CEMENT ☒ BENTONITE CLAY ☐ NO. OF BAGS 12 NO. OF POUNDS 1228 GALLONS OF WATER 75 DEPTH OF GROUT SEAL (TO NEAREST FOOT) FROM 0 FT. TO 55 FT. (ENTER 0 IF FROM SURFACE)			
DESCRIPTION (USE ADDITIONAL SHEETS IF NECESSARY)				CASING RECORD INSERT APPROPRIATE CODE BELOW STEEL ☒ CONCRETE ☐ PLASTIC ☐ OTHER ☐ MAIN CASING TYPE ST 6 65 NOMINAL DIAMETER TOP (MAIN) CASING (NEAREST INCH) TOTAL DEPTH OF MAIN CASING (NEAREST FOOT)			
FEET FROM TO CHECK IF WATER BEARING BROWN MICA 0 52 BLUE SANDSTONE 52 150 ✓				OTHER CASING (IF USED) DIAMETER (INCH) DEPTH (FEET) FROM TO			
SCREEN TYPE OR OPEN HOLE INSERT APPROPRIATE CODE BELOW STEEL ☒ BRASS OR BRONZE ☐ OPEN HOLE ☐ PLASTIC ☐ OTHER ☐				SCREEN RECORD C 2 1 2 3 (SEQ. NO.) 6 DEPTH (NEAREST WHOLE FOOT) FROM TO HO 63 150 8 9 11 15 17 21 23 24 26 30 32 36 38 39 41 45 47 51 SLOTSIZE 1. 2. 3.			
CIRCLE APPROPRIATE BOXES ☐ A WELL WAS ABANDONED AND SEALED WHEN THIS WELL WAS COMPLETED ☐ E ELECTRIC LOG OBTAINED ☐ P TEST WELL CONVERTED TO PRODUCTION WELL				PUMPING TEST C 3 1 2 3 (SEQ. NO.) 6 HOURS PUMPED (TO NEAREST HOUR) 2 PUMPING RATE (GALLONS PER MINUTE TO NEAREST GALLON) 15 METHOD USED TO MEASURE PUMPING RATE AIR WATER LEVEL: (DISTANCE FROM LAND SURFACE) BEFORE PUMPING 40 (NEAREST FOOT) WHEN PUMPING 140 (NEAREST FOOT) TYPE OF PUMP USED (CIRCLE APPROPRIATE BOX) (FOR PUMPING TEST) ☒ A AIR ☐ P PISTON ☐ T TURBINE ☐ C CENTRIFUGAL ☐ R ROTARY ☐ O OTHER (DESCRIBE BELOW) ☐ J JET ☐ S SUBMERSIBLE			
I HEREBY CERTIFY THAT I HAVE COMPLIED WITH ALL CONDITIONS STATED ON THE ABOVE-CAPTIONED "PERMIT TO DRILL WELL", AND THAT INFORMATION CONTAINED IN THIS REPORT IS TRUE, ACCURATE, AND COMPLETE TO THE BEST OF MY KNOWLEDGE, INFORMATION AND BELIEF.				PUMP INSTALLED TYPE OF PUMP (WRITE APPROPRIATE LETTER IN BOX - SEE ABOVE: A, C, J, P, R, S, T, O) DRILLER WILL INSTALL PUMP (CIRCLE APPROPRIATE BOX) YES ☒ NO ☐ CAPACITY: GALLONS PER MINUTE (TO NEAREST GALLON) 31 35 PUMP HORSE POWER 37 41 PUMP COLUMN LENGTH (NEAREST FOOT) 43 47			
DRILLERS NAME W.B. QUINN SIGNATURE William B. Quinn				CASING HEIGHT (CIRCLE APPROPRIATE BOX AND ENTER CASING HEIGHT) ☒ ABOVE ☐ BELOW LAND SURFACE 2 (NEAREST FOOT) LOCATION OF WELL ON LOT SHOW PERMANENT STRUCTURE SUCH AS BUILDINGS, SEPTIC TANKS, AND/OR OTHER LAND MARKS AND INDICATE NOT LESS THAN TWO DISTANCES (MEASUREMENTS TO WELL). 14080 TRIADDELPHIA RD. WELL PATTERSON PROPERTY TRIADDELPHIA ROAD			
WRA USE ONLY (NOT TO BE FILLED IN BY DRILLER) (E.R.O.S.) T 70 72 74 75 76 TELESCOPE CASING LOG INDICATOR OTHER DATA AVAILABLE				HEALTH			

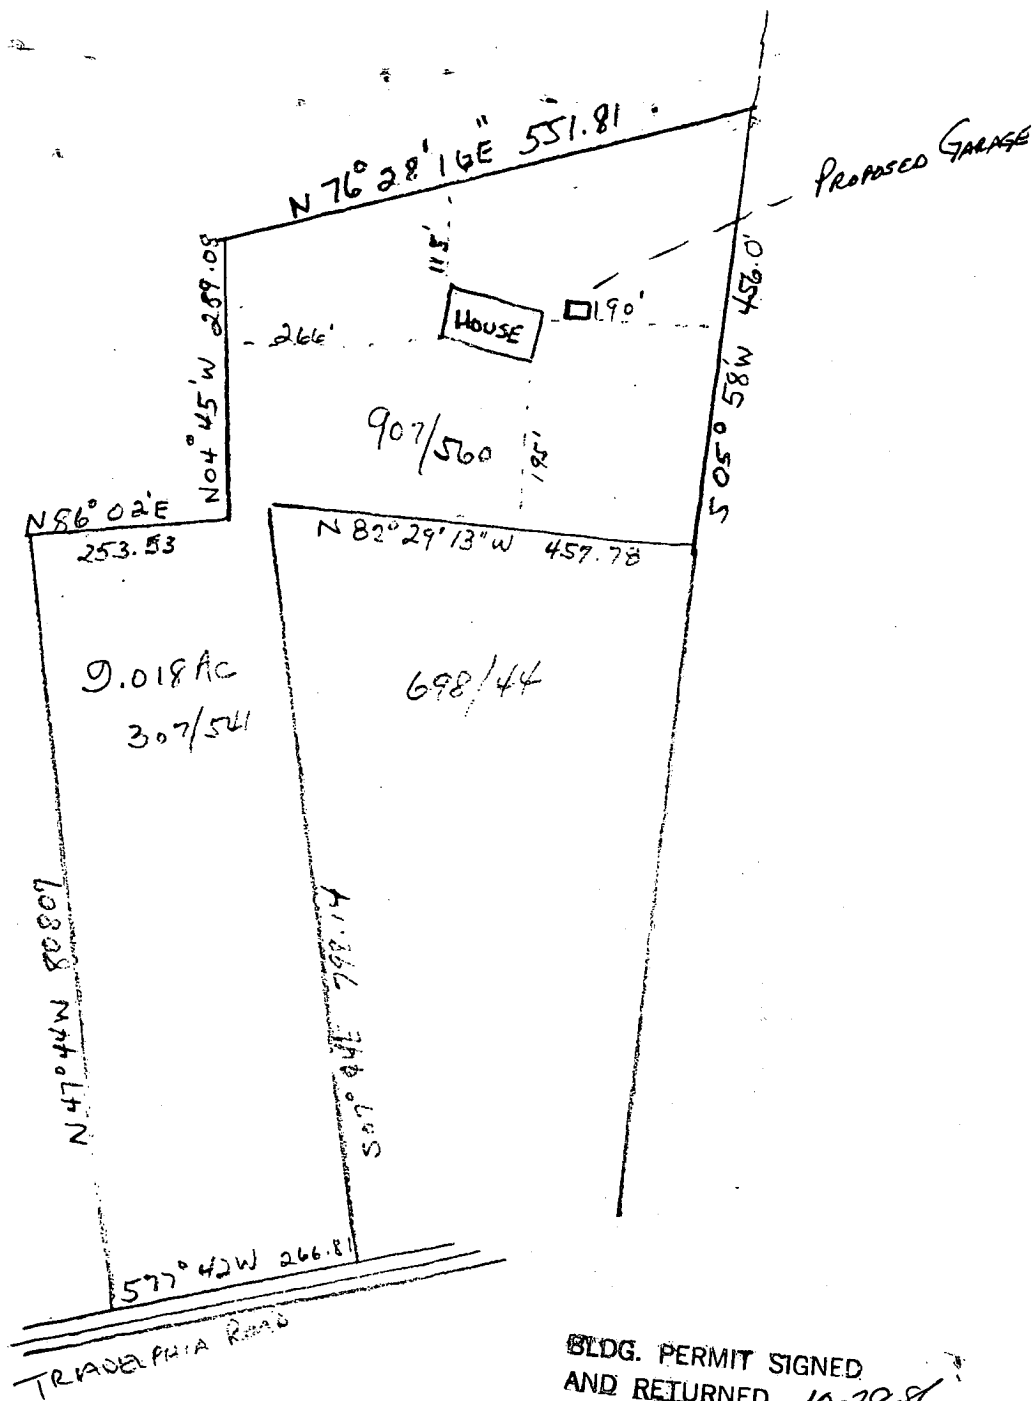


SCALE 1" = 200 FT

BLDG. PERMIT SIGNED
AND RETURNED 10-28-86

8453

RECEIVED
HOWARD COUNTY
HEALTH DEPT.
OCT 21 9 02 AM '86
DIVISION OF
ENVIRONMENTAL
HEALTH

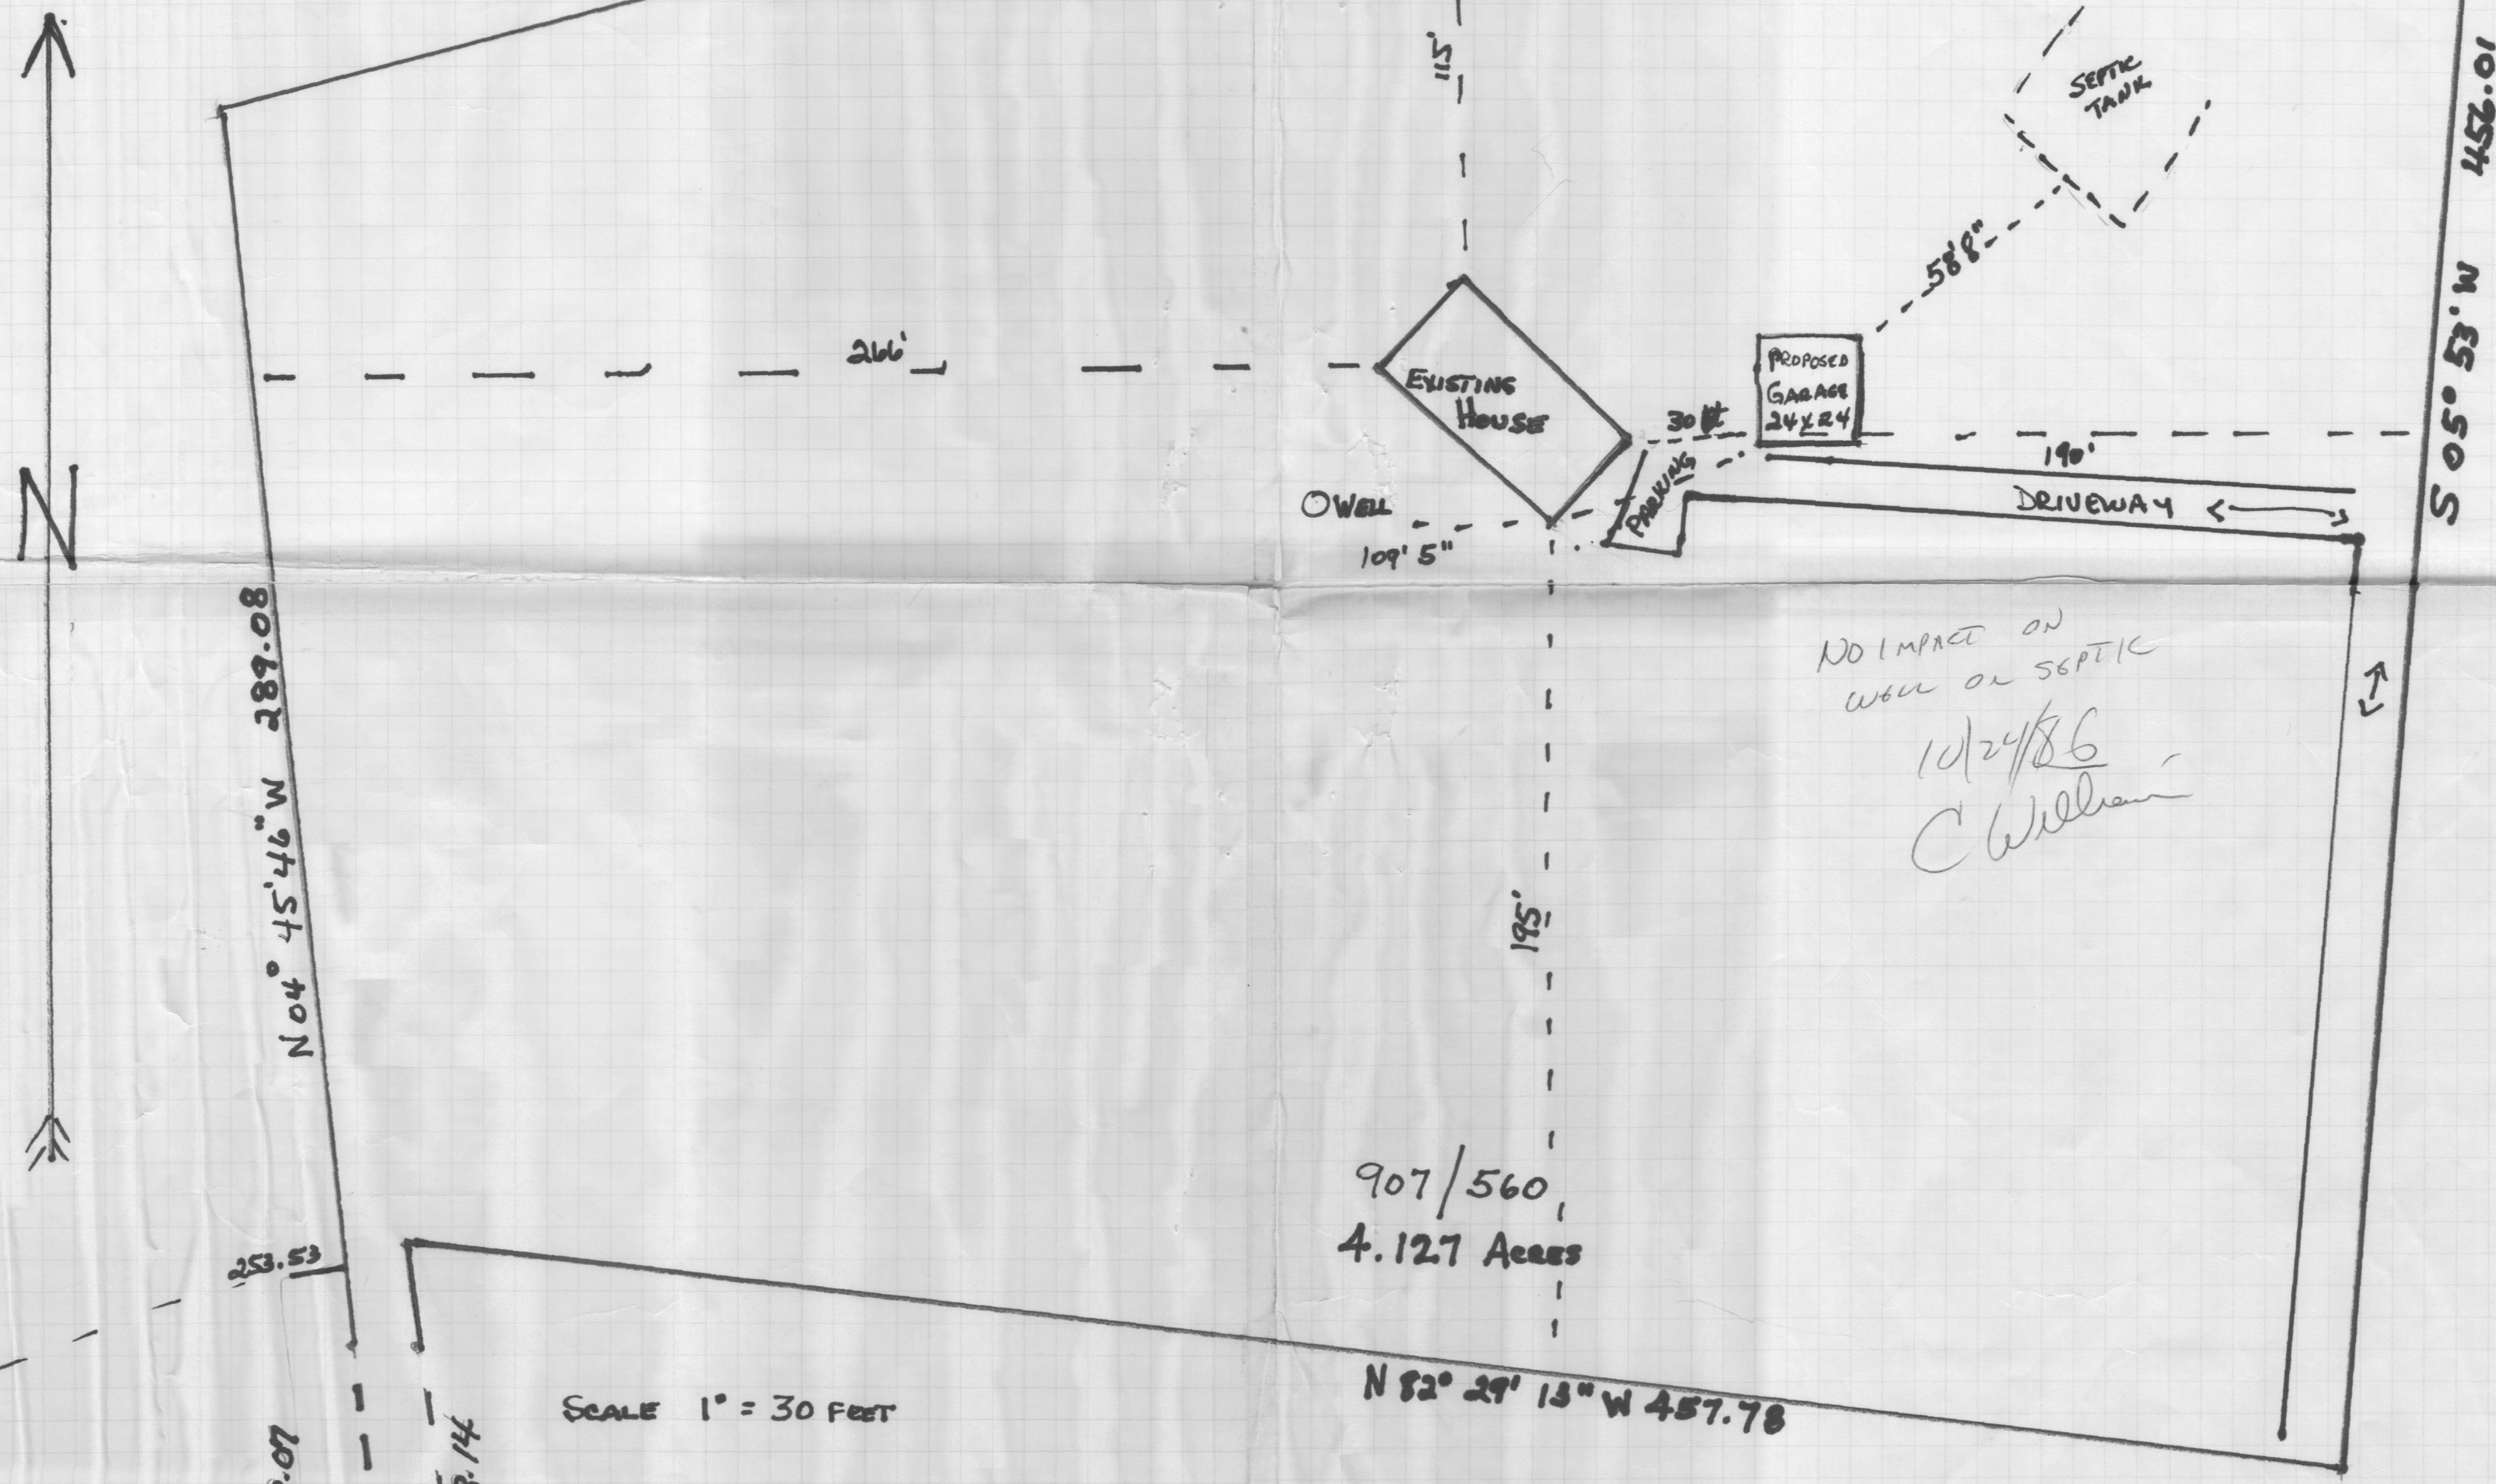

N 76° 28' 16" E 557.81

EXISTING
10x12
SHED

EXISTING
HOUSE

PROPOSED
GARAGE
24x24

SEPTIC
TANK

DRIVEWAY

NO IMPACT ON
WELL OR SEPTIC
10/24/86
C Williams

907/560,
4.127 Acres

N 82° 29' 13" W 457.78

SCALE 1" = 30 FEET

MR. & MRS.
JOHN EASTER
14060

FOURTH ELECTION DISTRICT

TRIADELPHIA ROAD GLENELG 21737

N 04° 45' 46" W 289.08

10.254 452.01
S 05° 53' W

808.07

798.14

253.53

115'

266'

30 ft

190'

195'

N