



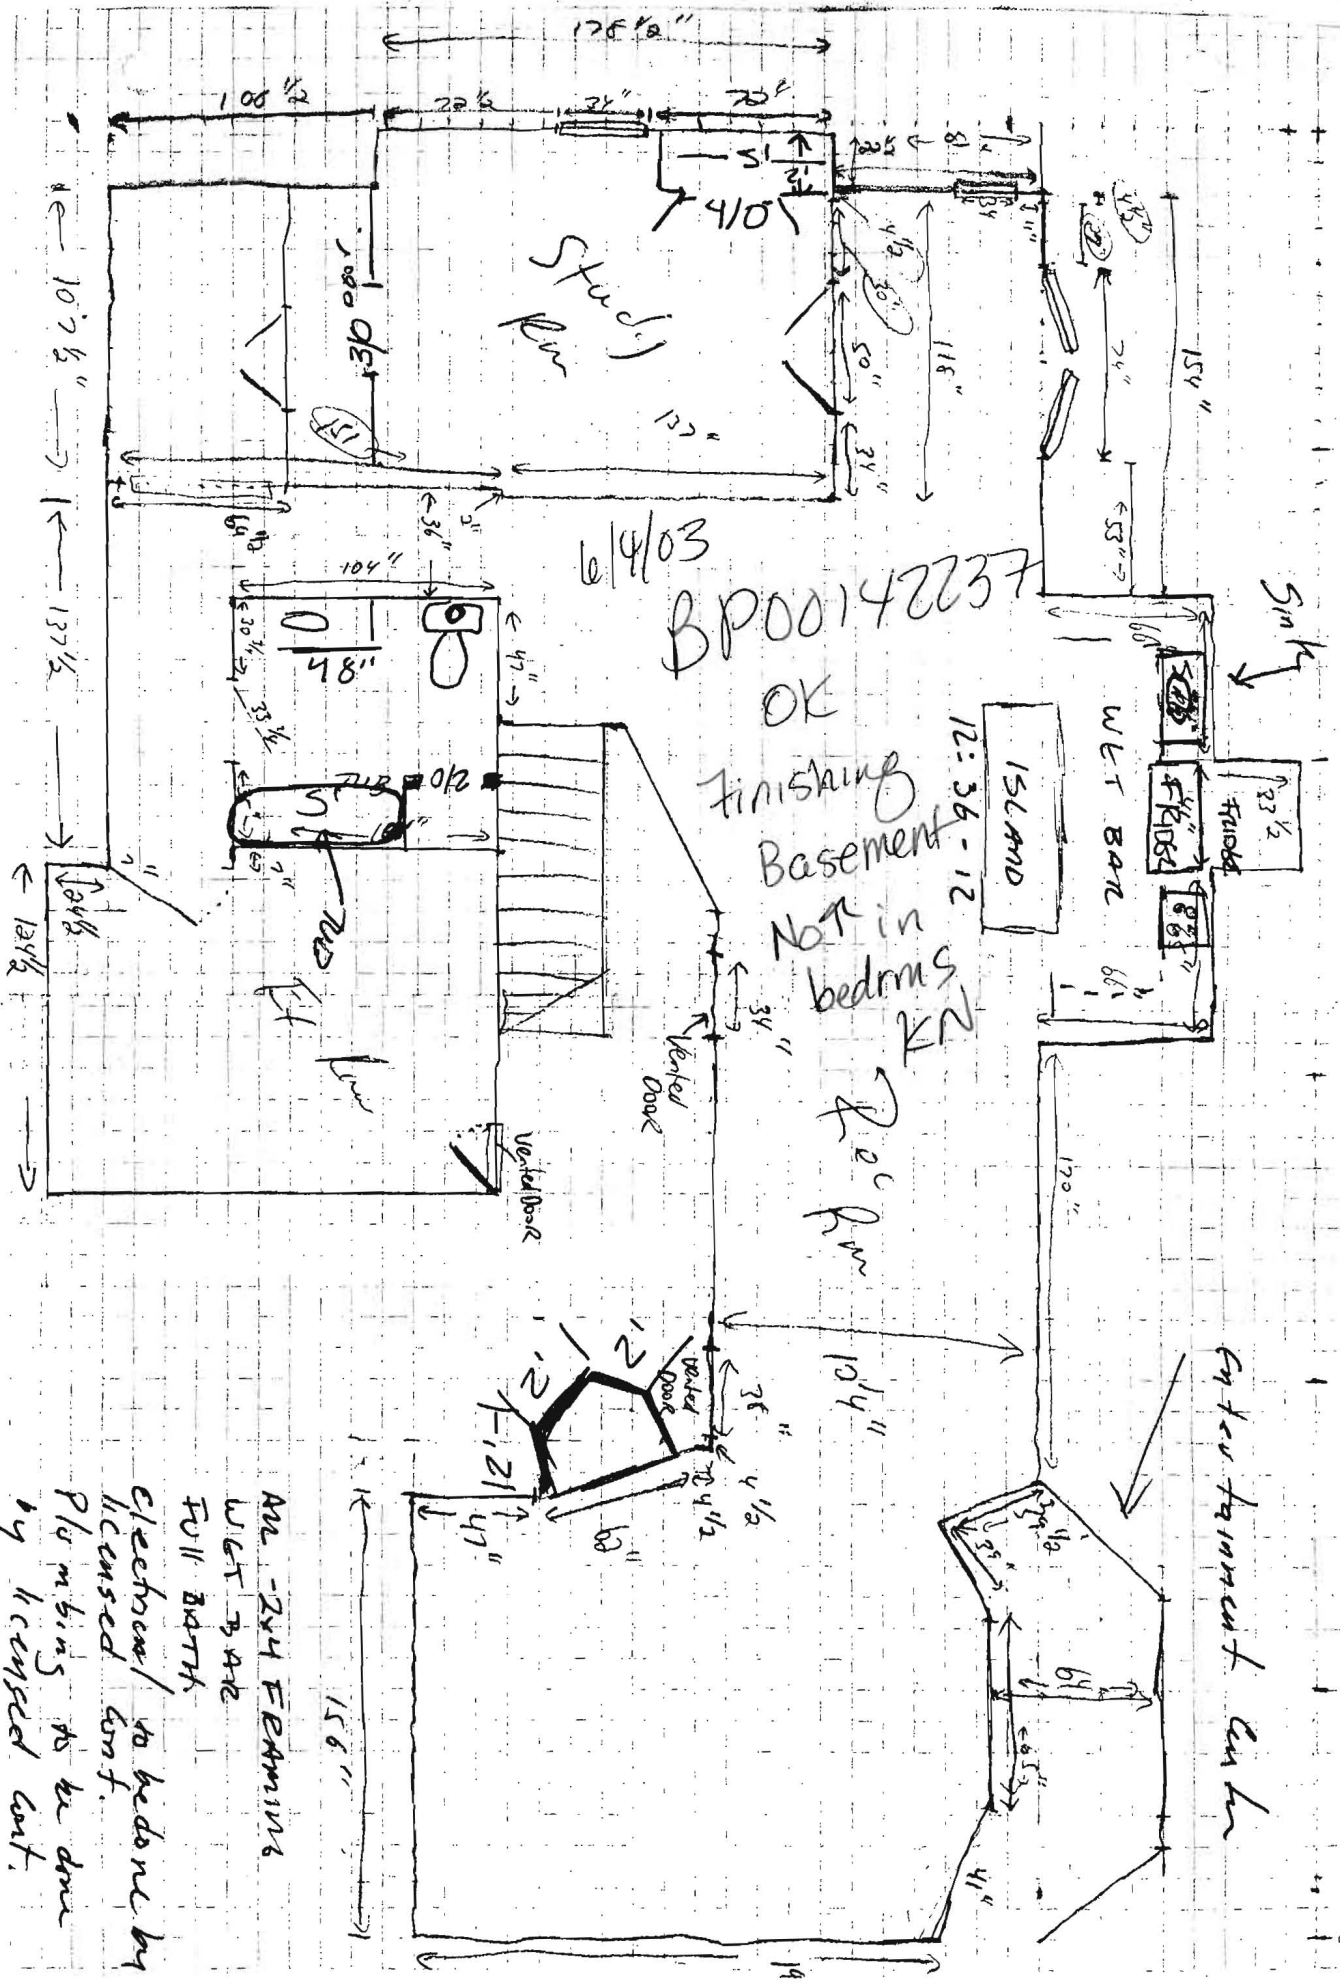

3/8 = 1 FOOT
 SCALE 3/8

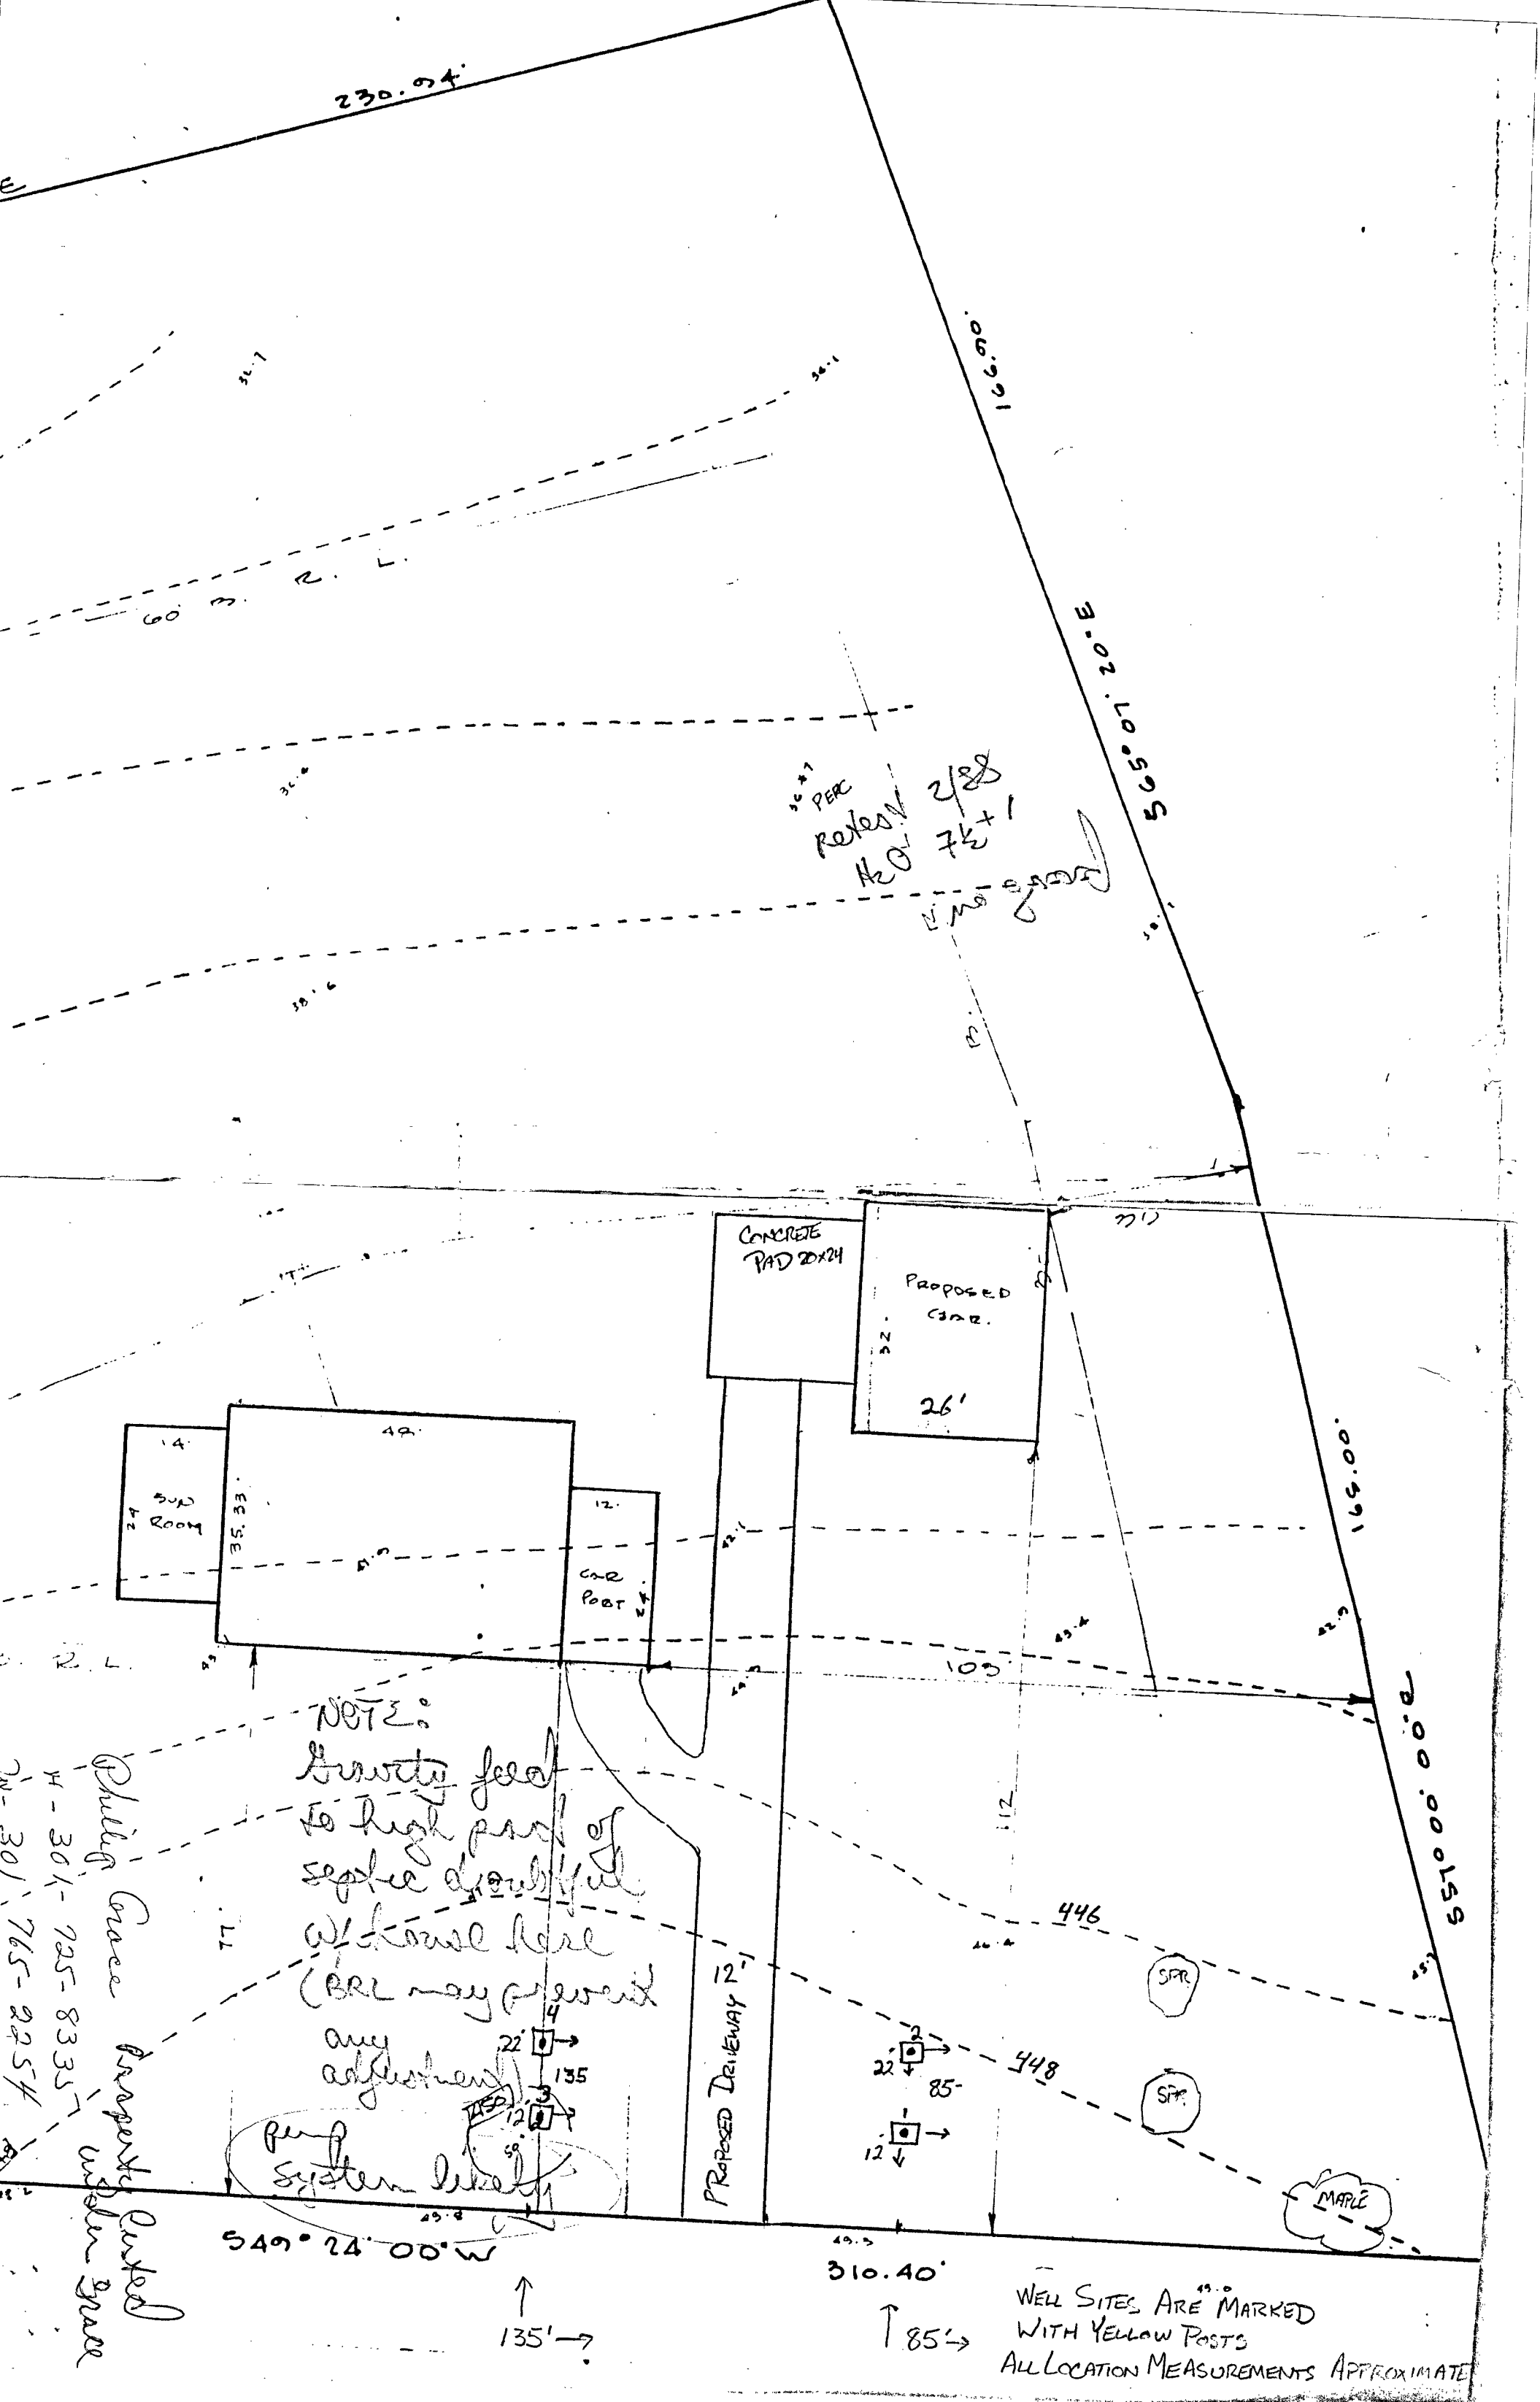

230.94'

166.90'

56.20' E 10.59 S

PERC
Pertes 2/88
H₂O 7 1/2' + 1'

no sign

CONCRETE
PAD 20x24

Proposed
CAR.

26'

24' SUP
ROOM

12' CAR
PORT

NOTE:

Gravity feed
to high part of
septic doubtful
w/ know here
(PER may prevent
any adjustment)

pump
system likely

PROPOSED DRIVEWAY 12'

SFR

SFR

MAPLE

549° 24' 00' W

310.40'

WELL SITES ARE MARKED
WITH YELLOW POSTS
ALL LOCATION MEASUREMENTS APPROXIMATE

Philly Grace Property Limited
under grace