

10/15/76
PERMIT

SEWAGE DISPOSAL SYSTEM

MARYLAND STATE DEPARTMENT OF HEALTH

HOWARD COUNTY

ELICOTT CITY

'INDEXED

DISTRICT 1

DATE 8/25/76

Allied Concrete Construction Co.
(Donald Krader)

IS PERMITTED TO INSTALL X ALTER

ADDRESS Laurel, Maryland

PHONE 725-1343

A SEWAGE DISPOSAL SYSTEM LOCATED AT

SUBDIVISION White Oak Estates

ROAD 13150 Deannar Dr.

LOT 8, Sec. 2

PROPERTY OWNER Ubo Van Der Valk

(WORKS ON SEPTIC SYSTEM)
ALSO

ADDRESS

SPECIFICATIONS - 4 bedrooms

PLDG. PERMIT SIGNED

AND RETURNED 4/20/80

DRAIN FIELD DEPTH FEET, BOTTOM AREA SQ. FT.

1200/23704 4/20/80

SEEPAGE PITS ABSORBENT SIDE WALL AREA SQ. FT.

SEPTIC TANK CAPACITY 1,250 GALLONS

FOR GARBAGE GRINDER, INCREASE DISPOSAL AREA 22% & TANK CAPACITY 50%.

OTHER Dry well - 806 sq. ft. sidewall area below top 4 ft. of clay. Dry well inlet to be

no deeper than 4 ft. and bottom of dry well to be 11 ft. deep below original grade. Place the

dry well 125 ft. from the front lot line along Deannar Drive and 25 ft. from the left side of

the lot as seen when facing the lot from Deannar Drive. Material needed on tank if top deeper than
3 ft. below grade. Two dry wells or a dry well and ditch may be needed.

PERMIT VOID AFTER THREE YEARS.

NOTE: ALL PIPE FROM HOUSE TO DISPOSAL AREA MUST BE 6" DIA.

PLANS APPROVED BY R. Hodges

DATE 10/15/76


NOTE: INSTALL STAIN PIPE ON SEPTIC TANK AND DRY WELL. STAIN PIPE MUST BE 6" IN DIA., ONE END
FILL SEPTIC TANK AND DISTRIBUTION BOX WITH WATER BEFORE CALLING FOR AN INSPECTION. COVER NO WORK
UNTIL INSPECTED AND APPROVED.

CONCRETE OR TERRA COTTA ACCEPTED.

NEITHER THE HOWARD COUNTY COMMISSIONERS NOR THE HEALTH DEPARTMENT IS RESPONSIBLE FOR THE
SUCCESSFUL OPERATION OF ANY SYSTEM.

10/14/76 - 1715 CUSSED WITH DM ADD A DITCH
90 FT LONG, 9 FT DEEP FILLED WITH
5 FT OF STONE 2 FT WIDE
RUN DITCH OFF OLD D.W. PARALLEL TO
DEANMAR DRIVE

A-513573-A

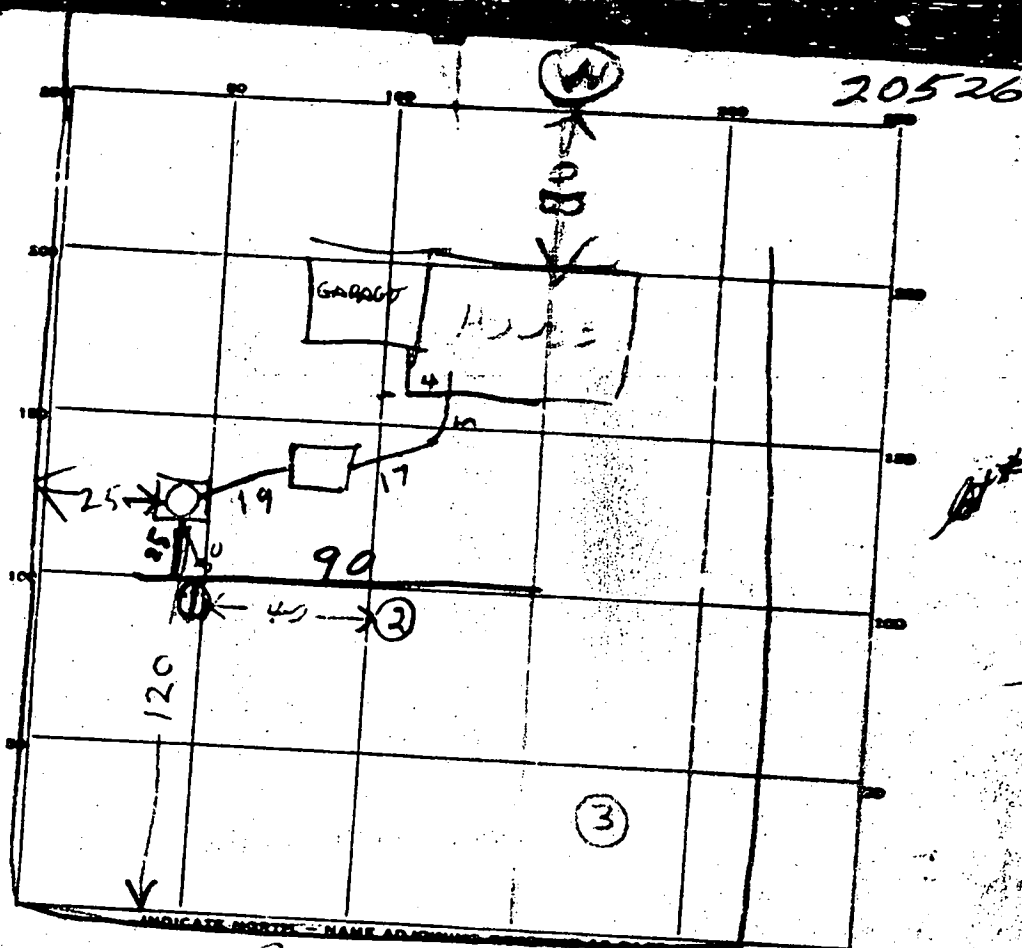

PERMIT CARD

DEANER DRIVE

SEPTIC TANK, LEVEL OK 1250

CLEANOUTS OK

DISTRIBUTION BOX, LEVEL Top 3 ft below grade

DITCH, DEPTH 9-12 FT. TRENCH WIDTH 2 FT.

GRAVEL DEPTH 5-6 FT. TOTAL LENGTH 91 FT.

NUMBER OF TRENCHES 1 TOTAL BOTTOM AREA 455

SEEPAGE PITS, INSIDE DIAMETER 51 FT. DEPTH BELOW INLET 8 FT.

ABSORBENT AREA 408 SQ. FT.


REMARKS 10/13/76 - NW 1/4 61 3' ft below grade but 2 ft below original grade
Top 2 ft Clay Bot sandy but Rock bottom
Top 10 ft deep AD 2 ft deep
Top 1 ft topsoil
11/15/76 1130AM Ditch OK add Rock
10/16/76 320 - PIPE PUT IN

DATE SYSTEM APPROVED

INSPECTOR

Raymond J. Hodges

4/20/00
 Proposed Addition
 will not include
 extra bedrooms
 OK SRH

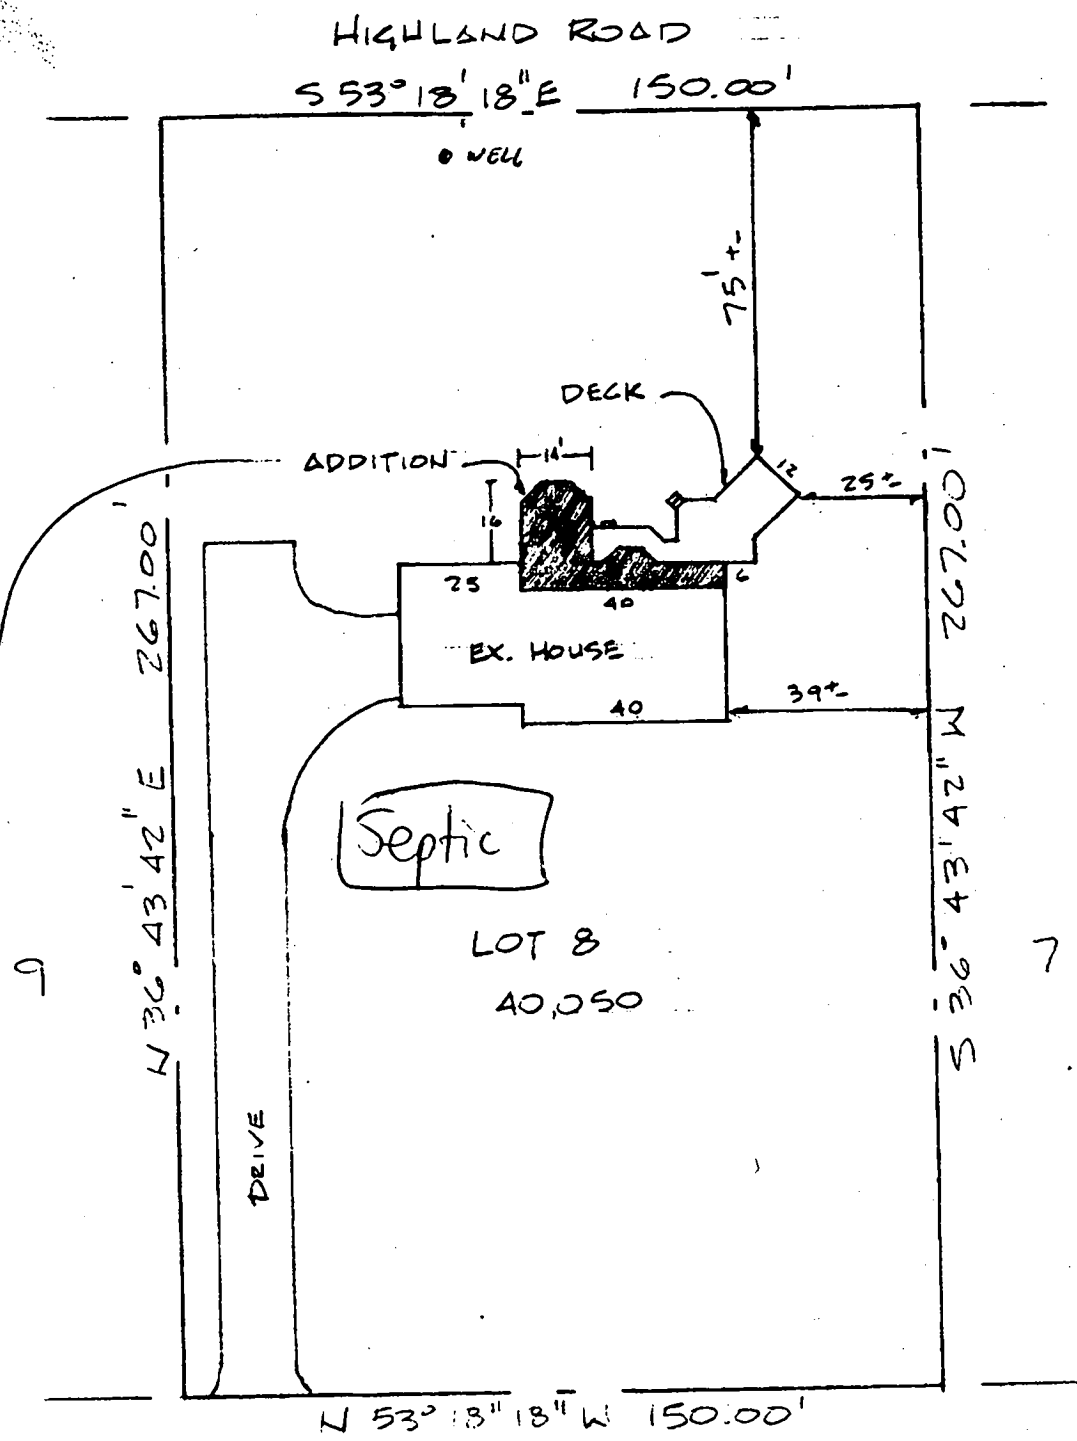

LOT 8
 WHITE OAK ESTATES
 5TH ELECTION DISTRICT
 HOWARD COUNTY

20526