



Health

Department of Inspections, Licenses and Permits
3430 Court House Drive
Permits: 410-313-2455
www.howardcountymd.gov

Permit No.: 814004083

Building Address: 14900 Victory Lane
City: Greenbelt State: MD Zip Code: 21737
Suite/Apt. #: _____ SDP/WP/BA #: _____
Census Tract: _____ Subdivision: Meriville Farm
Section: _____ Area: _____ Lot: 8
Tax Map: 21 Parcel: 28 Grid: 16
Zoning: _____ Map Coordinates: _____ Lot Size: 41,168

Existing Use: SFD
Proposed Use: SFD w/ Tank
Estimated Construction Cost: \$ 8,000
Description of Work: Install 1000 gal
under ground propane tank

Occupant or Tenant: Owner
Was tenant space previously occupied? ☐ Yes ☐ No
Contact Name: _____
Address: _____
City: _____ State: _____ Zip Code: _____
Phone: _____ Fax: _____
Email: _____

Commercial Building Characteristics	Residential Building Characteristics
Height: _____	☒ SF Dwelling ☐ SF Townhouse
No. of stories: _____	Depth _____ Width _____
Gross area, sq. ft./floor: _____	1 st floor: _____
Area of construction (sq. ft.): _____	2 nd floor: _____
Use group: _____	Basement: _____
	☐ Finished Basement
	☐ Unfinished Basement
	☐ Crawl Space
Construction type: _____	☐ Slab on Grade
☐ Reinforced Concrete	No. of Bedrooms: _____
☐ Structural Steel	<u>Multi-family Dwelling</u>
☐ Masonry	No. of efficiency units: _____
☐ Wood Frame	No. of 1 BR units: _____
☐ State Certified Modular	No. of 2 BR units: _____
	No. of 3 BR units: _____
	Other Structure: _____
	Dimensions: _____
☒ Roadside Tree Project Permit	Footings: _____
☐ Yes ☒ No	Roof: _____
Roadside Tree Project Permit # _____	☐ State Certified Modular
	☐ Manufactured Home

Property Owner's Name: Toll MD RII Limited
Address: 7164 Columbia Gateway Dr.
City: Columbia State: MD Zip Code: 21046
Phone: _____ Fax: _____
Email: _____

Applicant's Name & Mailing Address, (if other than stated herein)
Applicant's Name: Michelle Hegel
Address: PO Box 1253
City: Greenbelt State: MD Zip Code: 21734
Phone: 443 610 7511 Fax: _____
Email: Michelle@appliedandapproved.com

Contractor Company: Tech Air
Contact Person: Jeff Kenny
Address: 1560 A-D Caton Center Dr
City: Baltimore State: MD Zip Code: 21227
License No.: 08164 Exp: 10-25-15
Phone: 443 545 4393 Fax: _____
Email: _____

Engineer/Architect Company: Contractor
Responsible Design Prof.: _____
Address: _____
City: _____ State: _____ Zip Code: _____
Phone: _____ Fax: _____
Email: _____

Utilities
<u>Water Supply</u>
☐ Public
☒ Private
<u>Sewage Disposal</u>
☐ Public
☒ Private
Electric: ☐ Yes ☒ No
Gas: ☒ Yes ☐ No
<u>Heating System</u>
☐ Electric ☐ Oil
☐ Natural Gas ☐ Propane Gas
☐ Other: _____
<u>Sprinkler System:</u>
☐ Yes ☒ No
Grading Permit Number: _____
Building Shell Permit Number: _____

THE UNDERSIGNED HEREBY CERTIFIES AND AGREES AS FOLLOWS: (1) THAT HE/SHE IS AUTHORIZED TO MAKE THIS APPLICATION; (2) THAT THE INFORMATION IS CORRECT; (3) THAT HE/SHE WILL COMPLY WITH ALL REGULATIONS OF HOWARD COUNTY WHICH ARE APPLICABLE THERETO; (4) THAT HE/SHE WILL PERFORM NO WORK ON THE ABOVE REFERENCED PROPERTY NOT SPECIFICALLY DESCRIBED IN THIS APPLICATION; (5) THAT HE/SHE GRANTS COUNTY OFFICIALS THE RIGHT TO ENTER ONTO THIS PROPERTY FOR THE PURPOSE OF INSPECTING THE WORK PERMITTED AND POSTING NOTICES.

Applicant's Signature: Michelle Hegel Print Name: Michelle Hegel
Email Address: Michelle@appliedandapproved.com Date: 11/7/14
Permit to: _____
Title/Company: _____

Checks Payable to: DIRECTOR OF FINANCE OF HOWARD COUNTY

****PLEASE WRITE NEATLY & LEGIBLY****
FOR OFFICE USE ONLY

AGENCY	DATE	SIGNATURE OF APPROVAL
State Highways		
Building Officials		
PSZA (Zoning)		
PSZA (Engineering)		
Health	12/1/14	H. Osewka

Is Sediment Control approval required for issuance? ☐ Yes ☐ No
☐ CONTINGENCY CONSTRUCTION START

DPZ SETBACK INFORMATION
Front: _____
Rear: _____
Side: _____
Side St.: _____
All minimum setbacks met? ☐ Yes ☐ No
Is Entrance Permit Required? ☐ Yes ☐ No
Historic District? ☐ Yes ☐ No
Lot Coverage for New Town Zone: _____
SDP/Red-line approval date: _____

Filing Fee	\$
Permit Fee	\$
Tech Fee	\$
Excise Tax	\$
PSFS	\$
Guaranty Fund	\$
Add'l per Fee	\$
Total Fees	\$
Sub- Total Paid	\$
Balance Due	\$
Check	# 4059


Distribution of Copies: White: Building Officials Green: PSZA, Zoning Yellow: PSZA, Engineering Pink: Health Gold: SHA

PROFESSIONAL CERTIFICATION: I HEREBY CERTIFY THAT THESE DOCUMENTS WERE PREPARED BY ME OR UNDER MY RESPONSIBLE CHARGE, AND THAT I AM A DULY LICENSED PROFESSIONAL LAND SURVEYOR UNDER THE LAWS OF THE STATE OF MARYLAND, LICENSE NO. 21328, EXPIRATION DATE 1/8/

BUILDABLE BULK
"PARCEL E"
PLAT NO. 21756

LEGEND:

- PERC TEST LOCATION
- ⊙ WELL LOCATION
- LOD- LIMITS OF DISTURBANCE
- TW TOP OF WALL
- GF GARAGE FLOOR
- BF BASEMENT FLOOR
- BRL BUILDING RESTRICTION LINE

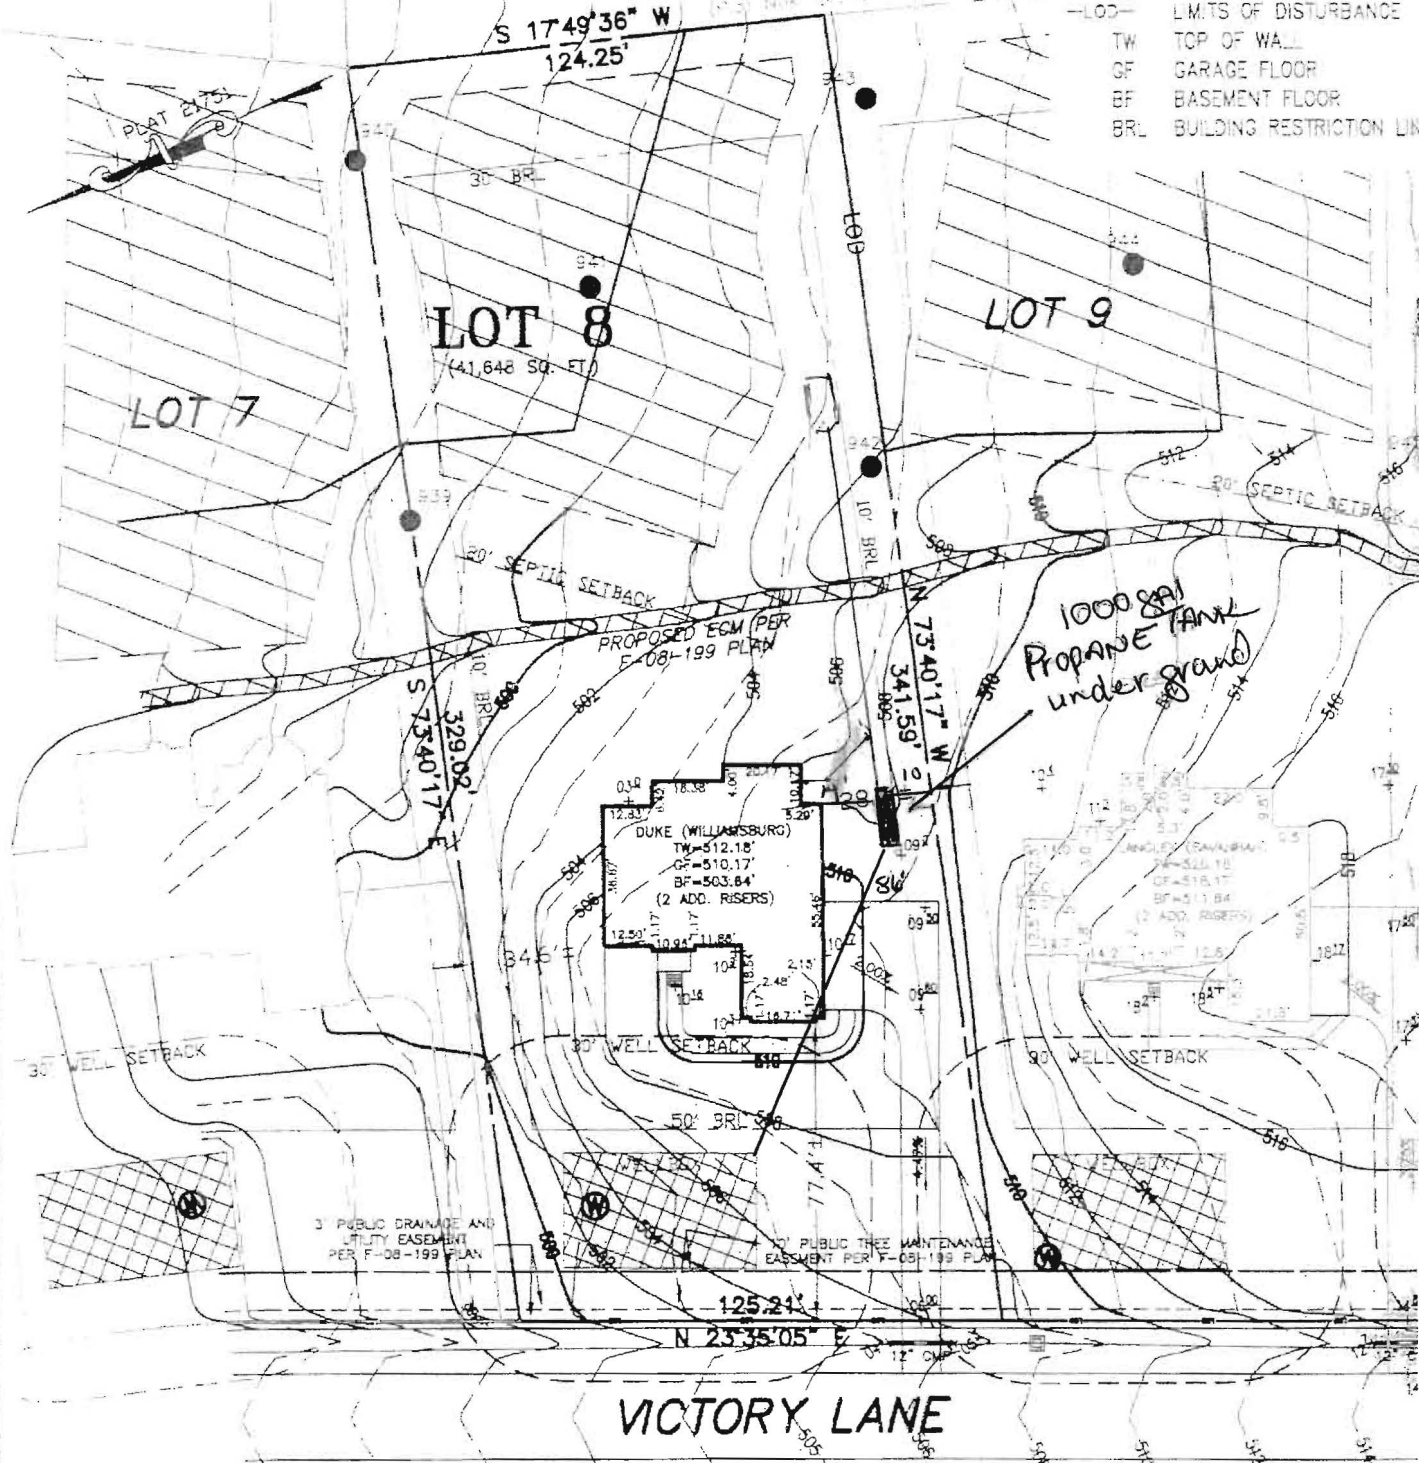

Scale 1-50

WELL TAG NUMBER: HO-95-20

BUILDING SETBACKS (B.R.L.'s) SHOWN HEREON PER SITE DEVELOPMENT PLAN
SETBACK DISTANCES SHOWN HEREON AS "±" HAVE AN ACCURACY OF ±0.1' FOOT.

ADDRESS: 14920 VICTORY LANE
GLENELG, MD 21735

HOUSE OPTIONS:

TYPE: DUKE (WILLIAMSBURG)
THREE CAR SIDE ENTRY GARAGE
WALK-OUT BASEMENT
EXPANDED FAMILY ROOM/GREAT ROOM
ADD. 1' TO HEIGHT OF BASEMENT FOUNDATION

OPTION No. 001
OPTION No. 017
OPTION No. 023
OPTION No. 070

PLOT PLAN
LOT 8

MERIWETHER FARMS

LIBER 13778, FOLIO 473