

APPLICATION

PERCOLATION TESTING

A _____

P _____

HOWARD COUNTY HEALTH DEPARTMENT

BUREAU OF ENVIRONMENTAL HEALTH

3525-H ELLICOTT MILLS DRIVE/ELLICOTT CITY, MARYLAND 21043

TELEPHONE: 313-2640

DISTRICT _____

DATE _____

TO: THE COUNTY HEALTH OFFICER
ELLICOTT CITY, MARYLAND

I HEREBY APPLY FOR THE NECESSARY TEST PRIOR TO APPLICATION FOR PERMIT TO CONSTRUCT (OR RECONSTRUCT) A SEWAGE DISPOSAL SYSTEM.

PROPERTY OWNER Edgewood Farms, Inc.

ADDRESS 14943 Roxbury Road, Glenelg PHONE 410 531-4355

AGENT OR PROSPECTIVE BUYER TOLL BROS., Inc.

ADDRESS 7164 Columbia Gateway Drive, Suite 230 PHONE 410 872-9105

PROPERTY LOCATION: Columbia, MD 21046
Attn: Bill Wainger

SUBDIVISION _____ LOT NO. OF 32

ROAD AND DESCRIPTION TRIADELPHIA ROAD OPPOSITE OF HOWARD ROAD

64± ACRES, PARCEL P 90 (1295/48) & P 32 BORDER EAST & P 227 BORDER
TO THE NORTH. THIS PARCEL IS THE
RESIDUE OF FIFTH PARCEL LIBER 1295
FOLIO 48

TAX MAP Page 21 PARCEL # P 97

SIZE OF LOT 1± ACRE TYPE BLDG. SINGLE FAMILY
(SINGLE FAMILY DWELLING OR COMMERCIAL)

THE SYSTEM INSTALLED UNDER THIS APPLICATION IS ACCEPTABLE ONLY UNTIL PUBLIC FACILITIES BECOME AVAILABLE. I FULLY UNDERSTAND THE

FEE CONNECTED WITH THE FILING OF THIS PERC TEST APPLICATION IS NON-REFUNDABLE UNDER ANY CIRCUMSTANCES. I ALSO AGREE TO

COMPLY WITH ALL M.O.S.H.A. REQUIREMENTS IN TESTING THIS LOT. [Signature]
(SIGNATURE OF APPLICANT)

APPROVED BY _____ FOR _____ DATE _____

DISAPPROVED BY _____ FOR _____ DATE _____

HOLD PENDING FURTHER TESTS _____

REASONS FOR REJECTION OR HOLDING _____

PERCOLATION TEST PLAT/PRELIMINARY PLAT - TITLE OR I.D. # _____ DATE _____

SITE DEVELOPMENT PLAN/FINAL PLAT - TITLE OR I.D. # _____ DATE _____

THIS IS NOT A PERMIT

COUNTY #

SOIL PROFILE

194

0' topsoil
 6" dk org
 brn
 cl lm
 2.5' dk red
 brn
 cl lm
 6.5' pale
 org tan
 si lm
 11' Hard


0' 196
 6" topsoil
 red brn
 cl lm
 3' pale
 pk tan
 si lm
 12' 100%
 rock

0' 197
 6" topsoil
 red brn
 cl lm
 4.5' pale
 org brn
 si lm
 10%+
 rock
 12.5' 40%+ rock
 13.5'

SOIL PROFILE

198

0' topsoil
 6" dk red
 brn
 cl lm
 6.5' pale
 org red
 brn
 si lm
 13'

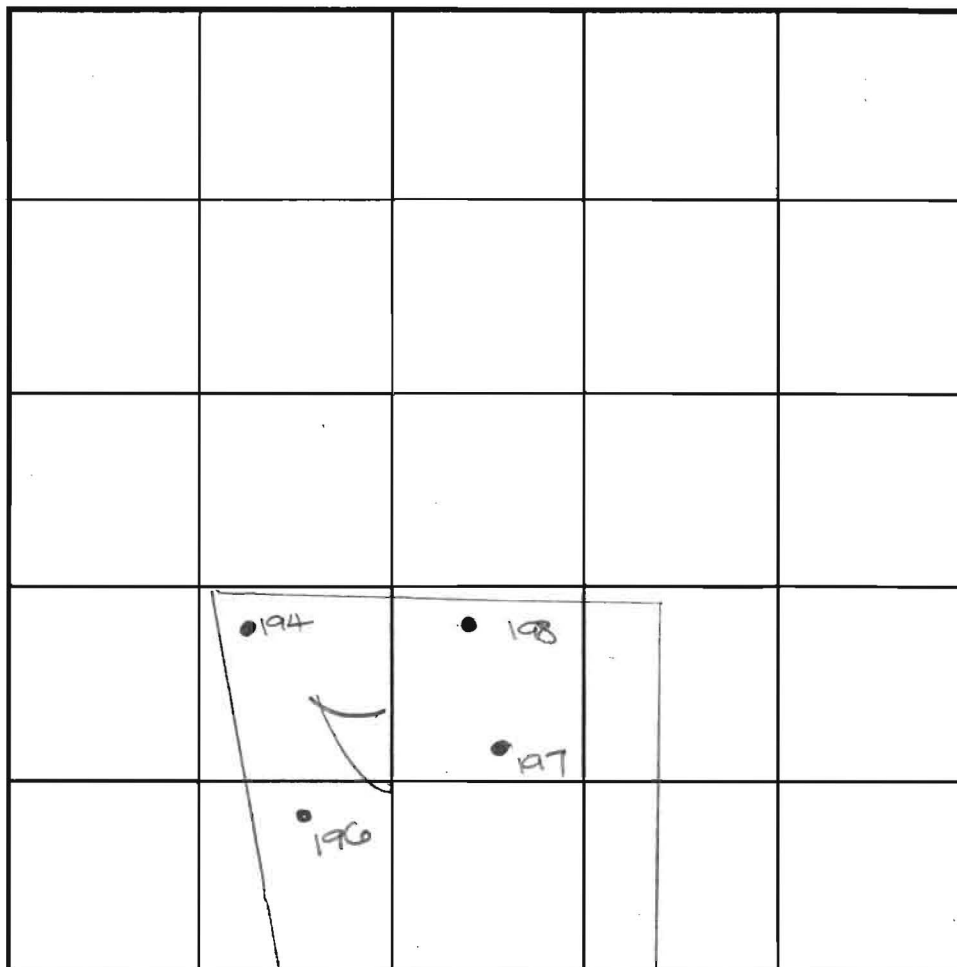

INDICATE NORTH - NAME ADJOINING ROADWAY AS BASE LINE.

Triadelphia Road

DATE	TEST NO.	DEPTH	PRE-WET		TEST - 1" DROP		TIME
			START	STOP	START	STOP	
11-27-00	194	5.5' S	3:36	3:54	3:54	little slow	OK below
		11.0' D	Hard	bottom	- See profile		OK
	196	12.0' D	visual	- See profile			OK
11-28-00	197	4.0' S	10:37	10:42	10:42	11:02	20
		13.5' D	visual	- see profile			OK
	198	6.5' S	11:07	11:14	11:14	11:28	14
		13.0' D	visual	- see profile			OK

REMARKS

holes tested as staked

TYPE OF SOIL

TESTED BY

DCC

ALSO PRESENT

Fogle's, Mr. Wainger


TRENCH DESIGN DATA: AVERAGE PERCOLATION TIME

TRENCH WIDTH

INLET DEPTH

MAXIMUM BOTTOM DEPTH

SQ. FT/BEDROOM

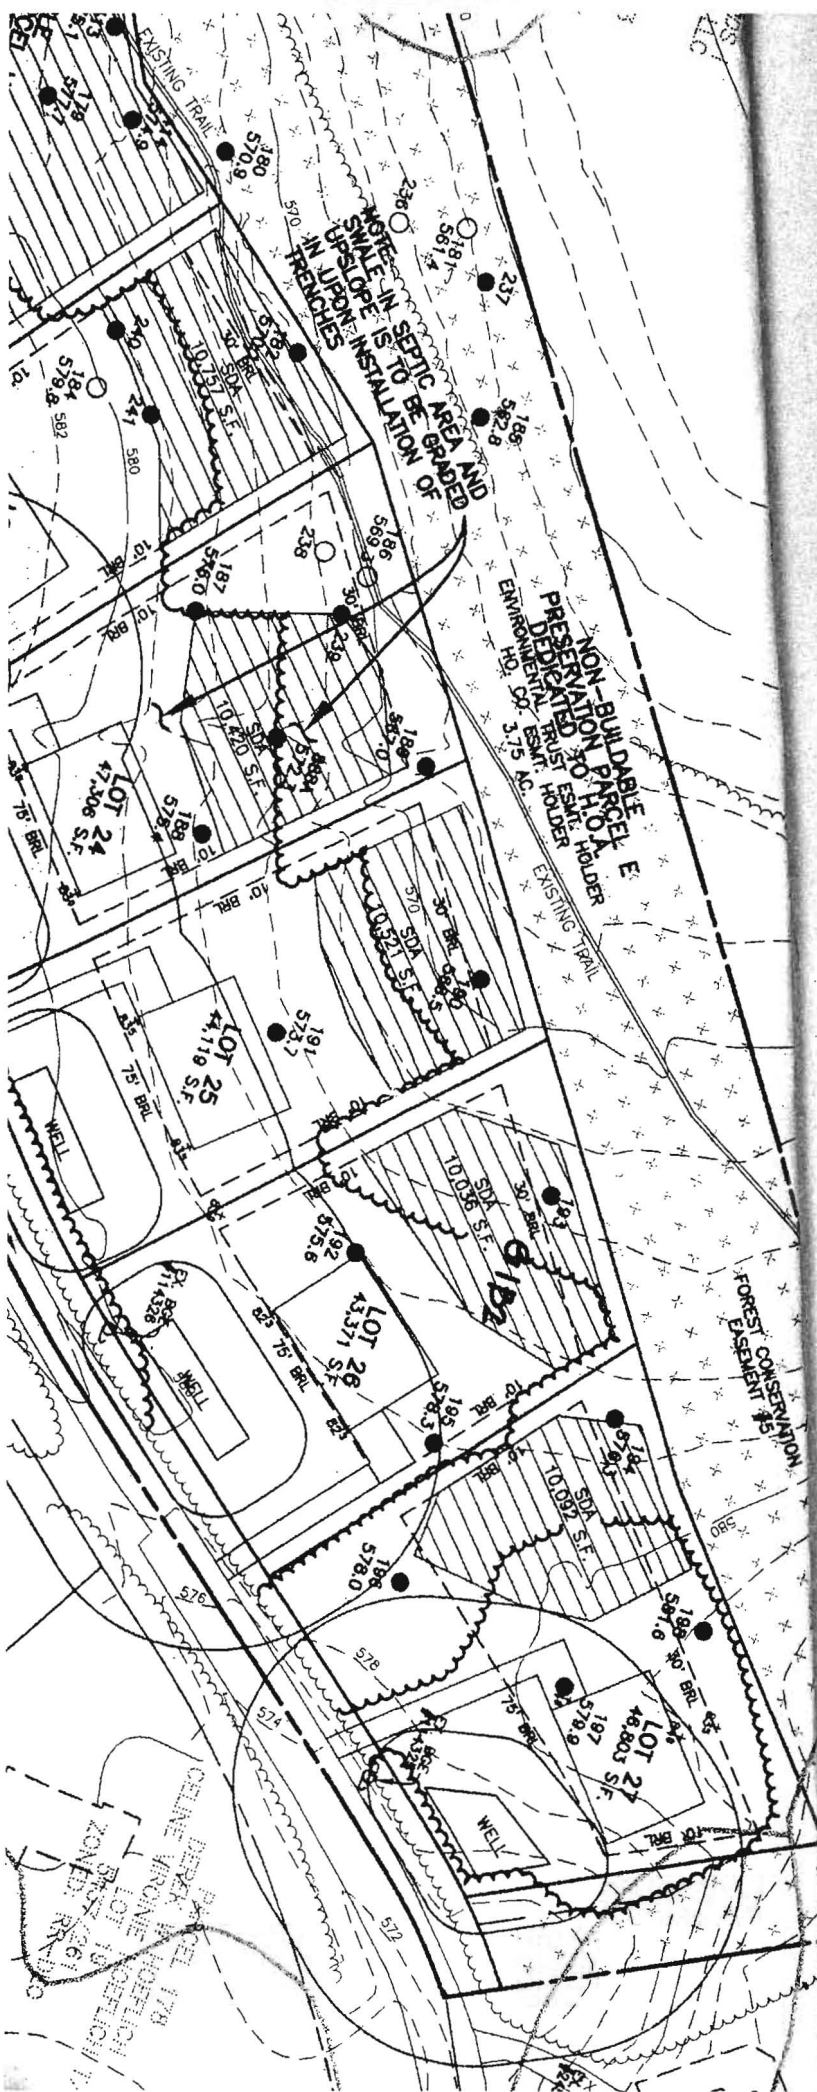

Site plan