

APPLICATION

PERCOLATION TESTING

A _____

P _____

HOWARD COUNTY HEALTH DEPARTMENT

BUREAU OF ENVIRONMENTAL HEALTH

3525-H ELLICOTT MILLS DRIVE/ELLICOTT CITY, MARYLAND 21043
TELEPHONE: 313-2840

DISTRICT _____

DATE _____

TO: THE COUNTY HEALTH OFFICER
ELLICOTT CITY, MARYLAND

I HEREBY APPLY FOR THE NECESSARY TEST PRIOR TO APPLICATION FOR PERMIT TO CONSTRUCT (OR RECONSTRUCT) A SEWAGE DISPOSAL SYSTEM.

PROPERTY OWNER Edgewood Farms, Inc.

ADDRESS 14943 Roxbury Road, Glenelg PHONE 410 531-4355

AGENT OR PROSPECTIVE BUYER TOLL BROS., INC.

ADDRESS 7164 Columbia Gateway Drive, Suite 230 PHONE 410 872-9105

PROPERTY LOCATION Columbia, MD 21046
Attn: Bill Wainger

SUBDIVISION _____ LOT NO. OF 32

ROAD AND DESCRIPTION TRIADELPHIA ROAD OPPOSITE OF HOWARD ROAD

64± ACRES, PARCEL P 90 (1295/48) & P 32 BORDER EAST & P 227 BORDER
TO THE NORTH. THIS PARCEL IS THE
RESIDUE OF FIFTY PARCEL LIBER 1295
FOLIO 48

TAX MAP Page 21 PARCEL # P 97

SIZE OF LOT 1± ACRE TYPE BLDG. SINGLE FAMILY
(SINGLE FAMILY DWELLING OR COMMERCIAL)

THE SYSTEM INSTALLED UNDER THIS APPLICATION IS ACCEPTABLE ONLY UNTIL PUBLIC FACILITIES BECOME AVAILABLE. I FULLY UNDERSTAND THE
FEE CONNECTED WITH THE FILING OF THIS PERC TEST APPLICATION IS NON-REFUNDABLE UNDER ANY CIRCUMSTANCES. I ALSO AGREE TO
COMPLY WITH ALL M.O.S.H.A. REQUIREMENTS IN TESTING THIS LOT. WKC
(SIGNATURE OF APPLICANT)

APPROVED BY _____ FOR _____ DATE _____

DISAPPROVED BY _____ FOR _____ DATE _____

HOLD PENDING FURTHER TESTS _____

REASONS FOR REJECTION OR HOLDING _____

PERCOLATION TEST PLAT/PRELIMINARY PLAT - TITLE OR I.D. # _____ DATE _____


SITE DEVELOPMENT PLAN/FINAL PLAT - TITLE OR I.D. # _____ DATE _____

THIS IS NOT A PERMIT

COUNTY #

SOIL PROFILE

0' 192
 6" topsoil
 red brn
 cl Lm
 6.5' pale
 org tan
 sil Lm
 10-15%
 rock
 14'

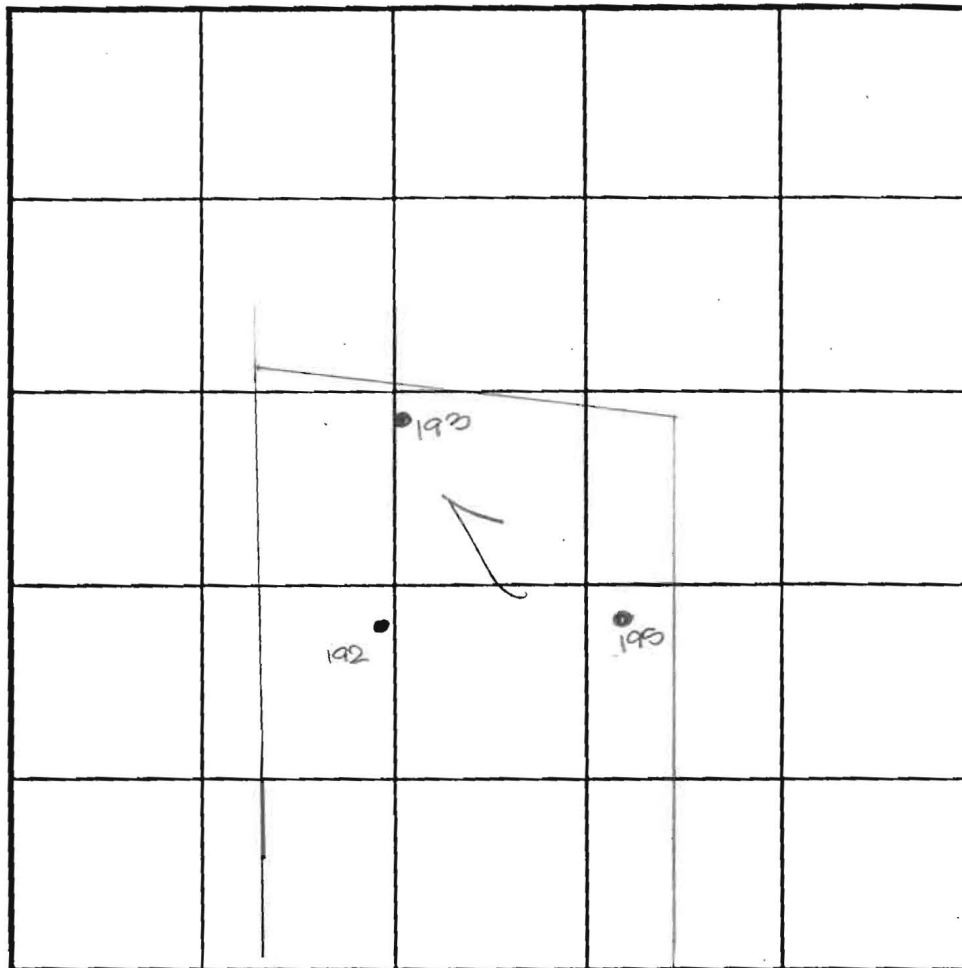

SOIL PROFILE

0'

INDICATE NORTH - NAME ADJOINING ROADWAY AS BASE LINE.

Triadelphia Road

DATE	TEST NO.	DEPTH	PRE-WET		TEST - 1" DROP		TIME
			START	STOP	START	STOP	
11-27-00	192	8.0'S	2:43	2:49	2:49	3:06	17
		14.0'D	Visual	- See	profile		OK
	195	7'9"S	3:12	3:13	3:13	3:16	3
		14.0'D	Visual	- See	profile		OK
11-28-00	193	6.0'S	11:59	12:09	12:09	12:31	22
		14.0'D	Visual	- See	profile		OK

REMARKS

holes tested as staked

TYPE OF SOIL

TESTED BY

DCC

ALSO PRESENT

Page's, Mr. Waine

TRENCH DESIGN DATA: AVERAGE PERCOLATION TIME

TRENCH WIDTH

INLET DEPTH

MAXIMUM BOTTOM DEPTH

SQ. FT./BEDROOM

0' 193
 6" topsoil
 org brn
 cl Lm
 6.5' pale
 org tan
 sil Lm
 10-15%
 rock
 14'

11-28-05 (N)

11-2B-05(~~2N~~)

Where
are
the
soil
data?

