


614
y
CL
MASSIVE

SIL
Strkbrn
trace Rr

Hbrn
Pocket
mucac
SL
w
L-SIL
Bottom

613
yellow
CL
sick
yellow
L.
v. mca.
L sand
Tracer R.
Bottom

(610) ✓
w/rdm
strbm
CL
irreg
boundary
ybrn
mucac
Loam

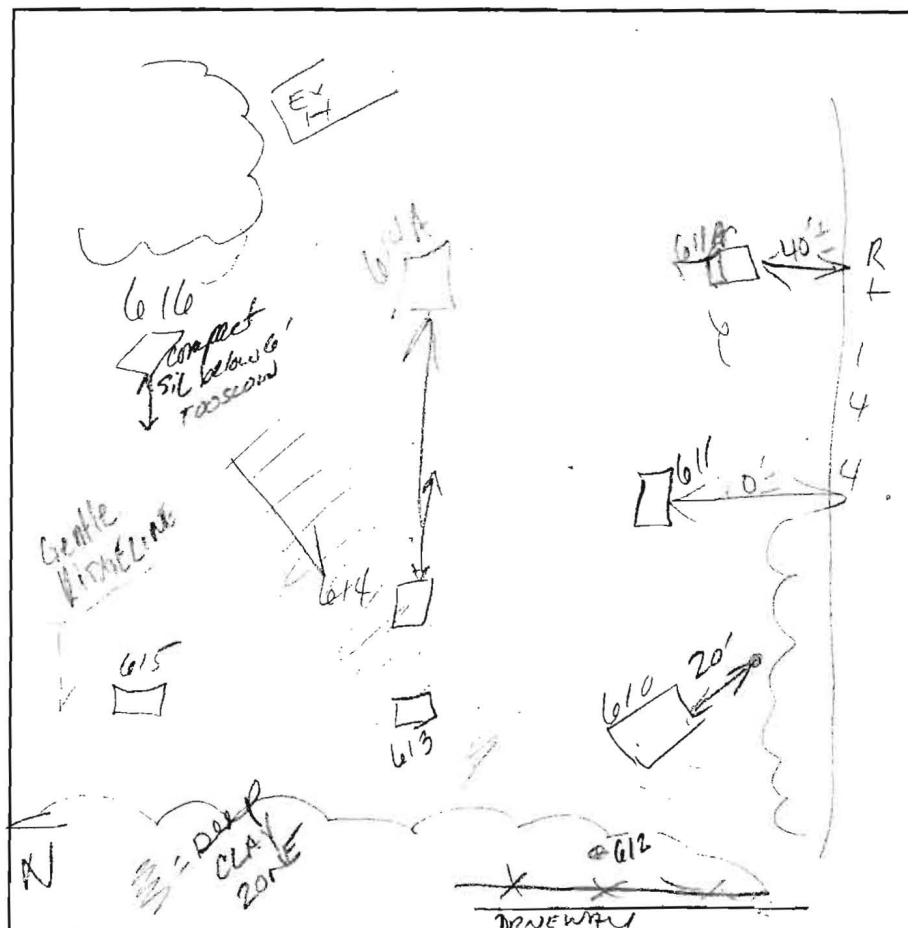

DATE	TEST #	DEPTH	START	BREAK 1" DROP	STOP 2" DROP	TIME OF 2ND INCH	P/F/H
12-27-04	(614)	7'9"	11:26	11:44	11:48 ^{to} _{90@}	12:18	F
	(613)	8'	11:44	11:48	11:58	10	P
	(612)	6'4"	11:57	12:01	12:06	5	P
	(611)	7 1/2'	12:26	12:28	12:32	5	P
	(611A)	6'	12:44	12:46	12:48	SAME 1" 6" diameter hole	EST 5
	(614A)	8'	12:57	1:10	1:35	25	

Hole 611A & 614 A Not per plan

Str red cc	3 1/2
Str brn 316-b	70
brn 14 brn wk platy structures SL	
Bottom	

Cell A

Str. brn
Isaac
may L

brn
4brn

w. C.
comp. —

SL

rock  ~ 15 %
w/ m. face

Bo. Horn

614A

Wkong
org brn
heavy
Least
Compact

Brn
mucous.
stl

Trace
rare

Bottom

SANITARIAN RACE BACKHOE Callahan OTHERS _____
TEST HOLES USED IN SDA _____ AVG. PERC TIME _____ SQ. FT/BR _____
TRENCH WIDTH _____ INLET DEPTH _____ MAX. BOT DEPTH _____ EFFECTIVE S/W _____