

PERMIT

P 23654

SEWAGE DISPOSAL SYSTEM

A _____

MARYLAND STATE DEPARTMENT OF HEALTH

HOWARD COUNTY

ELLICOTT CITY

INDEXED

DISTRICT 4

04-310462

DATE 8/4/76

8/17/76
P.M. please

Bud Arnold

IS PERMITTED TO INSTALL ALTER _____

ADDRESS Mt. Airy, Maryland

PHONE 829-1504

A SEWAGE DISPOSAL SYSTEM LOCATED AT _____

SUBDIVISION _____

ROAD Route 94

LOT _____

PROPERTY OWNER ~~Clady's Brightwell~~ Thomas Lewis 417 Woodbine Road, Woodbine, Maryland (see application for directions)

ADDRESS 417 Woodbine Road, Woodbine, Maryland

SPECIFICATIONS

DRAIN FIELD _____ DEPTH _____ FEET, BOTTOM AREA _____ SQ. FT.

SEEPAGE PITS _____ ABSORBENT SIDE-WALL AREA _____ SQ. FT.

SEPTIC TANK CAPACITY _____ GALLONS

FOR GARBAGE GRINDER, INCREASE DISPOSAL AREA 22% & TANK CAPACITY 50%.

OTHER SEALED TANK - 1500 gallons with an alarm device installed.

PLANS APPROVED BY D. W. Monaghan


DATE 8/4/76

FILL SEPTIC TANK AND DISTRIBUTION BOX WITH WATER BEFORE CALLING FOR AN INSPECTION. COVER NO WORK UNTIL INSPECTED AND APPROVED.

NEITHER THE HOWARD COUNTY COMMISSIONERS NOR THE HEALTH DEPARTMENT IS RESPONSIBLE FOR THE SUCCESSFUL OPERATION OF ANY SYSTEM.

P 523654
A 23654

A23654

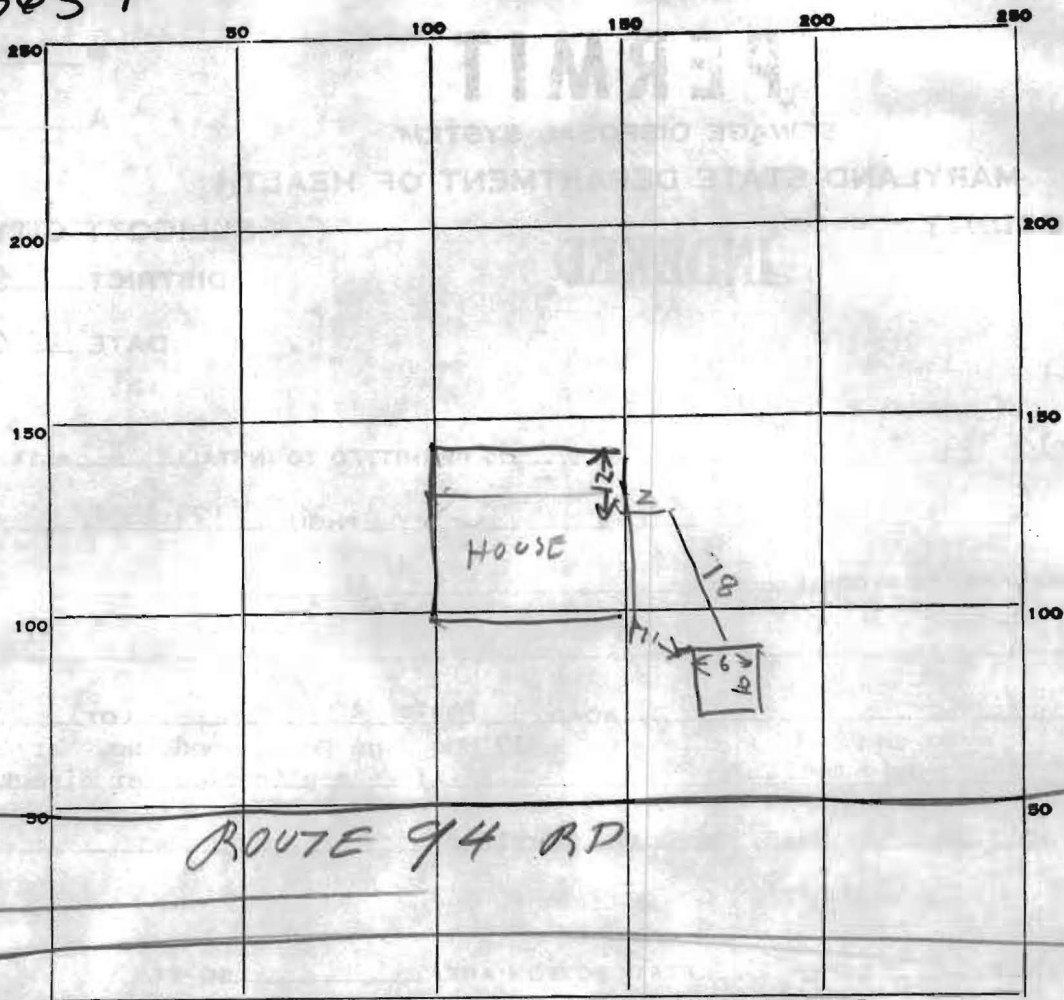

INDICATE NORTH. - NAME ADJOINING ROADWAY AS BASE LINE.

PERMIT CARD _____

SEPTIC TANK, LEVEL OK 1500 CLEANOUTS OK wall Rings

DISTRIBUTION BOX, LEVEL Top 3ft below grade

TILE FIELD, DEPTH _____ FT. TRENCH WIDTH _____ FT.

GRAVEL DEPTH _____ IN. TOTAL LENGTH _____ FT.

NUMBER OF TRENCHES _____ TOTAL BOTTOM AREA _____

SEEPAGE PITS, INSIDE DIAMETER _____ FT. DEPTH BELOW INLET _____ FT.

ABSORBENT AREA _____ SQ. FT.

REMARKS 10 x 6 x 5 ft. deep tank
Alarm system partly installed
OK TO cover Tank
House does not have water well
in yard. Get water from neighbour's

DATE SYSTEM APPROVED 8/17/76 INSPECTOR Raymond Rodege