

APPLICATION

PERCOLATION TESTING

A _____

P _____

HOWARD COUNTY HEALTH DEPARTMENT
BUREAU OF ENVIRONMENTAL HEALTH
3525-H ELLICOTT MILLS DRIVE/ELLICOTT CITY, MARYLAND 21043
TELEPHONE: 313-2640

DISTRICT _____

DATE _____

TO: THE COUNTY HEALTH OFFICER
ELLICOTT CITY, MARYLAND

I HEREBY APPLY FOR THE NECESSARY TEST PRIOR TO APPLICATION FOR PERMIT TO CONSTRUCT (OR RECONSTRUCT) A SEWAGE DISPOSAL SYSTEM.

PROPERTY OWNER Debra and William Anderson
Brando Tompkins-McDade

ADDRESS 7320 George Drive PHONE (410) 531-6444
Columbia MD 21044

AGENT OR PROSPECTIVE BUYER TRINITY QUALITY HOMES INC
7320 George Drive

ADDRESS Columbia MD 21044 PHONE (410) 531-6444

PROPERTY LOCATION: * THE PRESERVE AT WAVERLY WOODS
RESUBDIVISION ON Shadow Shade Lots 1+2 + 7th Parcel

SUBDIVISION AND HIGHWAY AT BREEZEWOOD FARMS LOT NO. PP-A'

ROAD AND DESCRIPTION Woodstock Road and Route 99 (Frederick Road)

TAX MAP 10 PARCEL # 36-102

SIZE OF LOT 1 ac TYPE BLDG. SFD
(SINGLE FAMILY DWELLING OR COMMERCIAL)

THE SYSTEM INSTALLED UNDER THIS APPLICATION IS ACCEPTABLE ONLY UNTIL PUBLIC FACILITIES BECOME AVAILABLE. I FULLY UNDERSTAND THE
FEE CONNECTED WITH THE FILING OF THIS PERC TEST APPLICATION IS NON-REFUNDABLE UNDER ANY CIRCUMSTANCES. I ALSO AGREE TO
COMPLY WITH ALL M.O.S.H.A. REQUIREMENTS IN TESTING THIS LOT.

(SIGNATURE OF APPLICANT)

APPROVED BY _____ FOR _____ DATE _____

DISAPPROVED BY _____ FOR _____ DATE _____

HOLD PENDING FURTHER TESTS _____

REASONS FOR REJECTION OR HOLDING _____

PERCOLATION TEST PLAT/PRELIMINARY PLAT - TITLE OR I.D. # _____ DATE _____

SITE DEVELOPMENT PLAN/FINAL PLAT - TITLE OR I.D. # _____ DATE _____

THIS IS NOT A PERMIT


COUNTY #

SOIL PROFILE

0' 157/159
6" 160
topsoil
org bmn
cl Lm
3.5'
4' med
org tan
sa mica
Lm
10% -
15%
rock

0' 163
6" 160
topsoil
org bmn
cl Lm
3.5'
14 bmn
to
tan
sa mica
Lm
5-10%
rock

0' 401
6" 160
topsoil
org bmn
cl Lm
2' 14
org
bmn
to tan
sa mica
Lm
20%
rock
9 Refusal

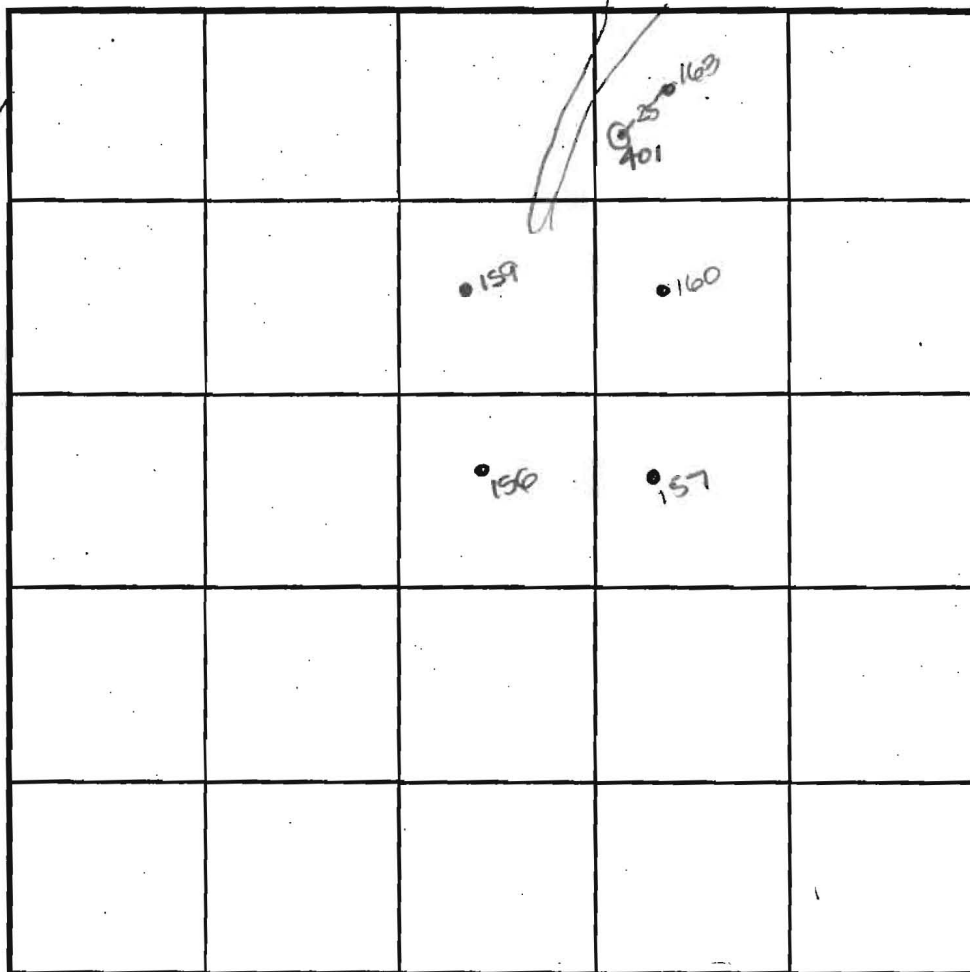

SOIL PROFILE

0' 157
6" 160
topsoil
br
org red
bmn
cl Lm
3.5'
3.5' pale
org beige
sa mica
Lm
10%
rock

INDICATE NORTH - NAME ADJOINING ROADWAY AS BASE LINE.

DATE	TEST NO.	DEPTH	PRE-WET		TEST - 1" DROP		TIME
			START	STOP	START	STOP	
1-4-01	157	13.0' D	Visual	-see	profile		OK
	159	12.5' D	Visual	-see	profile		OK
	160	3.5' S	2:12	2:18	2:18	2:28	10
		12.5' D	Visual	-see	profile		OK
	163	12.0' D	Visual	-see	profile		OK
	401	3.0' S	2:41	2:44	2:44	2:47	3
		9.0' D	Refusal	-see	profile		OK
	156	3.0' S	3:03	3:06	3:06	3:13	7
		12.0' D	Visual	-see	profile		OK

REMARKS holes tested as staked, except 401

TYPE OF SOIL

TESTED BY DWC

ALSO PRESENT

C. Zepp, T. Feaga

TRENCH DESIGN DATA: AVERAGE PERCOLATION TIME

TRENCH WIDTH

INLET DEPTH

MAXIMUM BOTTOM DEPTH

SQ. FT/BEDROOM

APPLICATION

PERCOLATION TESTING

A _____

P _____

HOWARD COUNTY HEALTH DEPARTMENT

BUREAU OF ENVIRONMENTAL HEALTH

3525-H ELLICOTT MILLS DRIVE/ELLICOTT CITY, MARYLAND 21043
TELEPHONE: 313-2640

DISTRICT _____

DATE _____

TO: THE COUNTY HEALTH OFFICER
ELLICOTT CITY, MARYLAND

I HEREBY APPLY FOR THE NECESSARY TEST PRIOR TO APPLICATION FOR PERMIT TO CONSTRUCT (OR RECONSTRUCT) A SEWAGE DISPOSAL SYSTEM.

PROPERTY OWNER Dobran and William Anderson
Brenda Tompkins-McDade

ADDRESS C/O Trinity Quality Homes Inc
7320 Grace Drive PHONE (410) 531-6444

AGENT OR PROSPECTIVE BUYER Columbia MD 21044
TRINITY QUALITY HOMES INC

ADDRESS 7320 Grace Drive PHONE (410) 531-6444
Columbia MD 21044

PROPERTY LOCATION: * THE PRESERVE AT Waverly Woods
D - 2nd Division of Shadow Shade Lots 1+2 + Res. Parcel

SUBDIVISION and Highways at Breezewood Farms LOT NO. _____

ROAD AND DESCRIPTION Woodstock Road and Route 99 (Frederick Road)

TAX MAP 10 PARCEL # 36+102

SIZE OF LOT 1 ac TYPE BLDG. SFD
(SINGLE FAMILY DWELLING OR COMMERCIAL)

THE SYSTEM INSTALLED UNDER THIS APPLICATION IS ACCEPTABLE ONLY UNTIL PUBLIC FACILITIES BECOME AVAILABLE. I FULLY UNDERSTAND THE
FEE CONNECTED WITH THE FILING OF THIS PERC TEST APPLICATION IS NON-REFUNDABLE UNDER ANY CIRCUMSTANCES. I ALSO AGREE TO
COMPLY WITH ALL M.O.S.H.A. REQUIREMENTS IN TESTING THIS LOT.

[Signature]
(SIGNATURE OF APPLICANT)

APPROVED BY _____ FOR _____ DATE _____

DISAPPROVED BY _____ FOR _____ DATE _____

HOLD PENDING FURTHER TESTS _____

REASONS FOR REJECTION OR HOLDING _____

PERCOLATION TEST PLAT/PRELIMINARY PLAT - TITLE OR I.D. # _____ DATE _____

SITE DEVELOPMENT PLAN/FINAL PLAT - TITLE OR I.D. # _____ DATE _____

THIS IS NOT A PERMIT

COUNTY #

SOIL PROFILE

SOIL PROFILE

INDICATE NORTH - NAME ADJOINING ROADWAY AS BASE LINE.

DATE	TEST NO.	DEPTH	PRE-WET		TEST - 1" DROP		TIME
			START	STOP	START	STOP	
1-11-01	154	2.5" S	11:10	11:13	11:13	11:17	4
		13.0' D	Visual	- see	profile		OL

REMARKS hole tested as sited

TYPE OF SOIL _____

TESTED BY DCC ALSO PRESENT T. Feaga, C. Zepp

TRENCH DESIGN DATA: AVERAGE PERCOLATION TIME _____ TRENCH WIDTH _____

INLET DEPTH _____ MAXIMUM BOTTOM DEPTH _____ SQ. FT./BEDROOM _____

APPLICATION

PERCOLATION TESTING

A _____

P _____

HOWARD COUNTY HEALTH DEPARTMENT

BUREAU OF ENVIRONMENTAL HEALTH

3525-H ELLICOTT MILLS DRIVE/ELLICOTT CITY, MARYLAND 21043
TELEPHONE: 313-2640

DISTRICT _____

DATE _____

TO: THE COUNTY HEALTH OFFICER
ELLICOTT CITY, MARYLAND

I HEREBY APPLY FOR THE NECESSARY TEST PRIOR TO APPLICATION FOR PERMIT TO CONSTRUCT (OR RECONSTRUCT) A SEWAGE DISPOSAL SYSTEM.

PROPERTY OWNER Deborah and William Anderson
Brenda Tompkins-McDade

ADDRESS 7320 Grace Drive PHONE (410) 531-6444
Columbia MD 21044

AGENT OR PROSPECTIVE BUYER TRIUMPH QUALITY HOMES INC
7320 Grace Drive

ADDRESS Columbia MD 21044 PHONE (410) 531-6444

PROPERTY LOCATION: * THE PRESERVE AT WAVERLY WOODS
D - SUBDIVISION OF SHADOW SHADE LOTS 1+2 + RES. PARCEL

SUBDIVISION AND HIGHLAND AT BREEZEWOOD FARMS LOT NO. _____

ROAD AND DESCRIPTION WOODBRIDGE ROAD AND ROUTE 99 (FREDERICK ROAD)

TAX MAP 10 PARCEL # 36-102

SIZE OF LOT 1 AC TYPE BLDG. SFD
(SINGLE FAMILY DWELLING OR COMMERCIAL)

THE SYSTEM INSTALLED UNDER THIS APPLICATION IS ACCEPTABLE ONLY UNTIL PUBLIC FACILITIES BECOME AVAILABLE. I FULLY UNDERSTAND THE
FEE CONNECTED WITH THE FILING OF THIS PERC TEST APPLICATION IS NON-REFUNDABLE UNDER ANY CIRCUMSTANCES. I ALSO AGREE TO
COMPLY WITH ALL M.O.S.H.A. REQUIREMENTS IN TESTING THIS LOT.

[Signature]
(SIGNATURE OF APPLICANT)

APPROVED BY _____ FOR _____ DATE _____

DISAPPROVED BY _____ FOR _____ DATE _____

HOLD PENDING FURTHER TESTS _____

REASONS FOR REJECTION OR HOLDING _____

PERCOLATION TEST PLAT/PRELIMINARY PLAT - TITLE OR I.D. # _____ DATE _____

SITE DEVELOPMENT PLAN/FINAL PLAT - TITLE OR I.D. # _____ DATE _____

THIS IS NOT A PERMIT

COUNTY #

SOIL PROFILE

0' 152
 6" topsoil
 org bn
 d bn
 3.5' med
 org
 bn
 si mica
 bn
 5-10%
 rock
 12.5'

0' 155
 6" topsoil
 red
 org bn
 clum
 3' 4" H bn
 si mica
 Lm
 10%
 rock
 12' 4"

SOIL PROFILE

0'

		155		
		152		

INDICATE NORTH - NAME ADJOINING ROADWAY AS BASE LINE.

old Frederick Road

DATE	TEST NO.	DEPTH	PRE-WET		TEST - 1" DROP		TIME
			START	STOP	START	STOP	
1-11-01	152	4.0' S	10:57	10:58	10:58	11:00	2
		12.5' D	visual	-see	profile		OK
	155	12' 4" D	visual	-see	profile		OK

REMARKS holes tested as staked


TYPE OF SOIL

TESTED BY DCC

ALSO PRESENT C. Zepp, T. Feag

TRENCH DESIGN DATA: AVERAGE PERCOLATION TIME TRENCH WIDTH

INLET DEPTH MAXIMUM BOTTOM DEPTH SQ. FT./BEDROOM

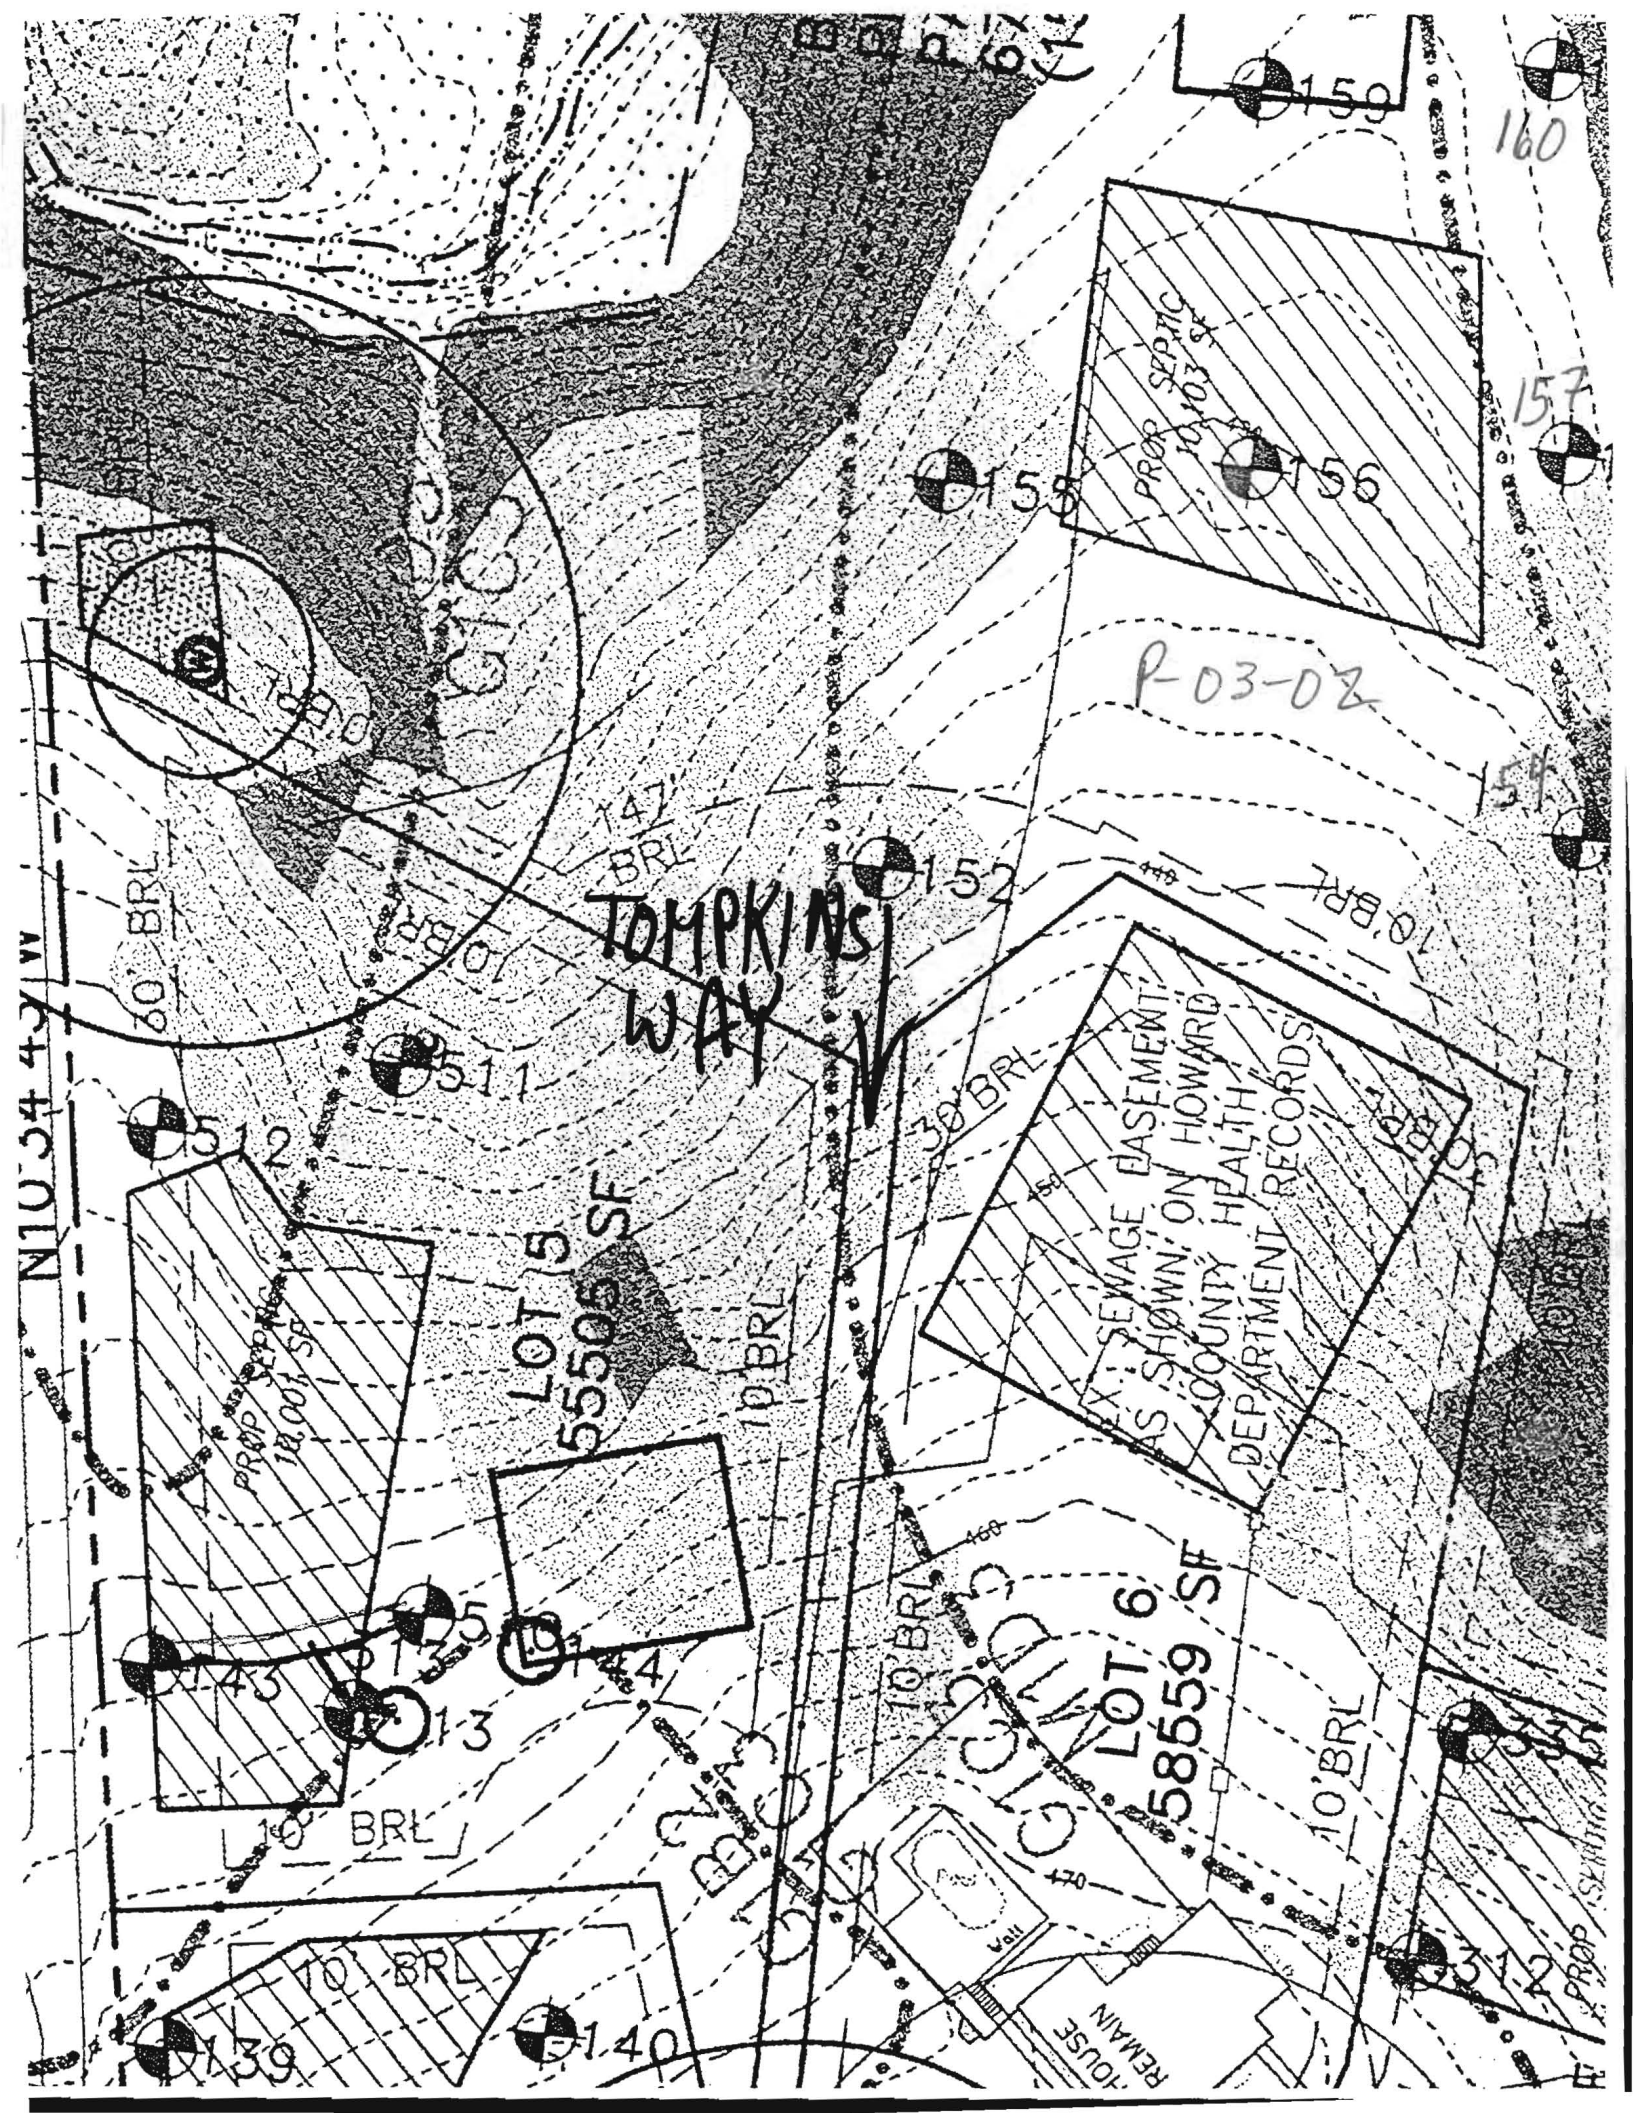

N10 34 42 W

TOMPKINS WAY

P-03-02

LOT 5
55505 SF

LOT 6
58559 SF

EX. SEWAGE EASEMENT
AS SHOWN ON HOWARD
COUNTY HEALTH
DEPARTMENT RECORDS

HOUSE
REMAIN

WELL

60' BRL

147' BRL

38' BRL

10' BRL

10' BRL

154

157

160

158

156

152

151

1512

1513

1514

1512

1539

1540

PROP SEPTIC
18,001 SF

PROP SEPTIC
10,103 SF