

SOIL PROFILE

SOIL PROFILE

INDICATE NORTH - NAME ADJOINING ROADWAY AS BASE LINE.

[illegible]

REMARKS

TYPE OF SOIL

TESTED BY _____

ALSO PRESENT

TRENCH DESIGN DATA: AVERAGE PERCOLATION TIME

TRENCH WIDTH

INLET DEPTH

MAXIMUM BOTTOM DEPTH

SQ. FT./BEDROOM

COUNTY #

SOIL PROFILE

0'

127

topsoil

12-15" rock

12-15" rock

0'

128

topsoil

red brn

12-15" rock


0'

129

topsoil

org brn

12-15" rock

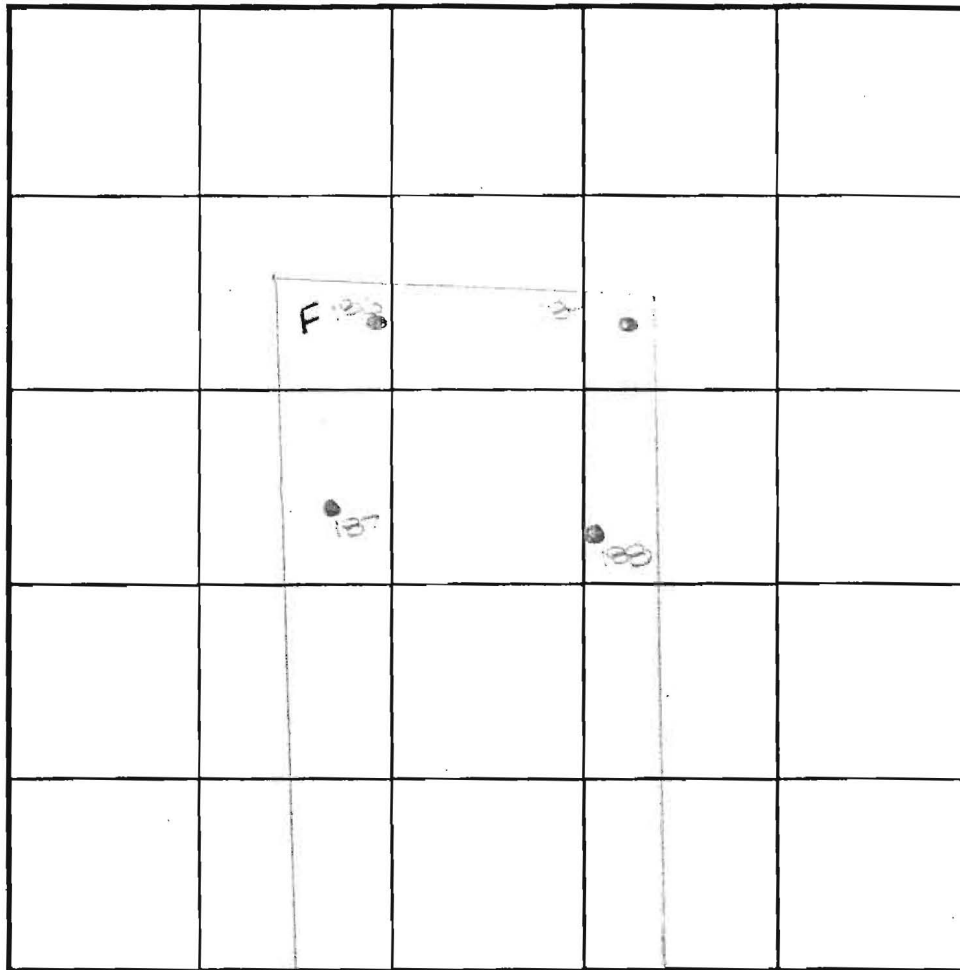

SOIL PROFILE

0'

SOIL PROFILE

INDICATE NORTH - NAME ADJOINING ROADWAY AS BASE LINE.

Tradelphia Road

DATE	TEST NO.	DEPTH	PRE-WET		TEST - 1" DROP		TIME
			START	STOP	START	STOP	
11-27-00	126	6'9"	12:40				
	127	4.5'	12:54	12:54	12:54	1:01	14
		13.5' D	12:40	12:51	12:51	1:01	2
	128	6.0'	12:48	12:51	12:51	1:01	26
		13.5' D	12:48	12:51	12:51	1:01	2
11-28-00	129	4.5' S	12:54	12:56	12:56	1:01	4
		12.5' D	12:54	12:56	12:56	1:01	OK

REMARKS: holes tested as required

TYPE OF SOIL

TESTED BY: DCC ALSO PRESENT: Fudge & Mr. ADUPLA

TRENCH DESIGN DATA: AVERAGE PERCOLATION TIME TRENCH WIDTH

INLET DEPTH MAXIMUM BOTTOM DEPTH SQ. FT./BEDROOM