

APPLICATION

PERCOLATION TESTING

A _____

P _____

HOWARD COUNTY HEALTH DEPARTMENT

BUREAU OF ENVIRONMENTAL HEALTH

3525-H ELLICOTT MILLS DRIVE/ELLICOTT CITY, MARYLAND 21043
TELEPHONE: 313-2640

DISTRICT _____

DATE _____

TO: THE COUNTY HEALTH OFFICER
ELLICOTT CITY, MARYLAND

I HEREBY APPLY FOR THE NECESSARY TEST PRIOR TO APPLICATION FOR PERMIT TO CONSTRUCT (OR RECONSTRUCT) A SEWAGE DISPOSAL SYSTEM.

PROPERTY OWNER Edgewood Farms, Inc.

ADDRESS 14943 Roxbury Road, Glenelg PHONE 410 531-4355

AGENT OR PROSPECTIVE BUYER TOLL BROS., Inc.

ADDRESS 7164 Columbia Gateway Drive, Suite 230 PHONE 410 872-9105

PROPERTY LOCATION: Columbia MD 21046
Attn: Bill Wainger

SUBDIVISION _____ LOT NO. OF 32

ROAD AND DESCRIPTION TRIADELPHIA ROAD OPPOSITE OF HOWARD ROAD

64± ACRES, PARCEL P 90 (1295/48) & P 32 BORDER EAST & P 227 BORDER
TO THE NORTH. THIS PARCEL IS THE
RESIDUE OF FIFTH PARCEL LIBER 1295
FOLIO 48

TAX MAP Page 21 PARCEL # P 97

SIZE OF LOT 1± ACRE TYPE BLDG. SINGLE FAMILY
(SINGLE FAMILY DWELLING OR COMMERCIAL)

THE SYSTEM INSTALLED UNDER THIS APPLICATION IS ACCEPTABLE ONLY UNTIL PUBLIC FACILITIES BECOME AVAILABLE. I FULLY UNDERSTAND THE
FEE CONNECTED WITH THE FILING OF THIS PERC TEST APPLICATION IS NON-REFUNDABLE UNDER ANY CIRCUMSTANCES. I ALSO AGREE TO
COMPLY WITH ALL M.O.S.H.A. REQUIREMENTS IN TESTING THIS LOT. WIC
(SIGNATURE OF APPLICANT)

APPROVED BY _____ FOR _____ DATE _____

DISAPPROVED BY _____ FOR _____ DATE _____

HOLD PENDING FURTHER TESTS _____

REASONS FOR REJECTION OR HOLDING _____

PERCOLATION TEST PLAT/PRELIMINARY PLAT - TITLE OR I.D. # _____ DATE _____


SITE DEVELOPMENT PLAN/FINAL PLAT - TITLE OR I.D. # _____ DATE _____

THIS IS NOT A PERMIT

182
d' topsoil
6'

 org brn
cl lm
5'

 tan
si lm
10%
rock
d'

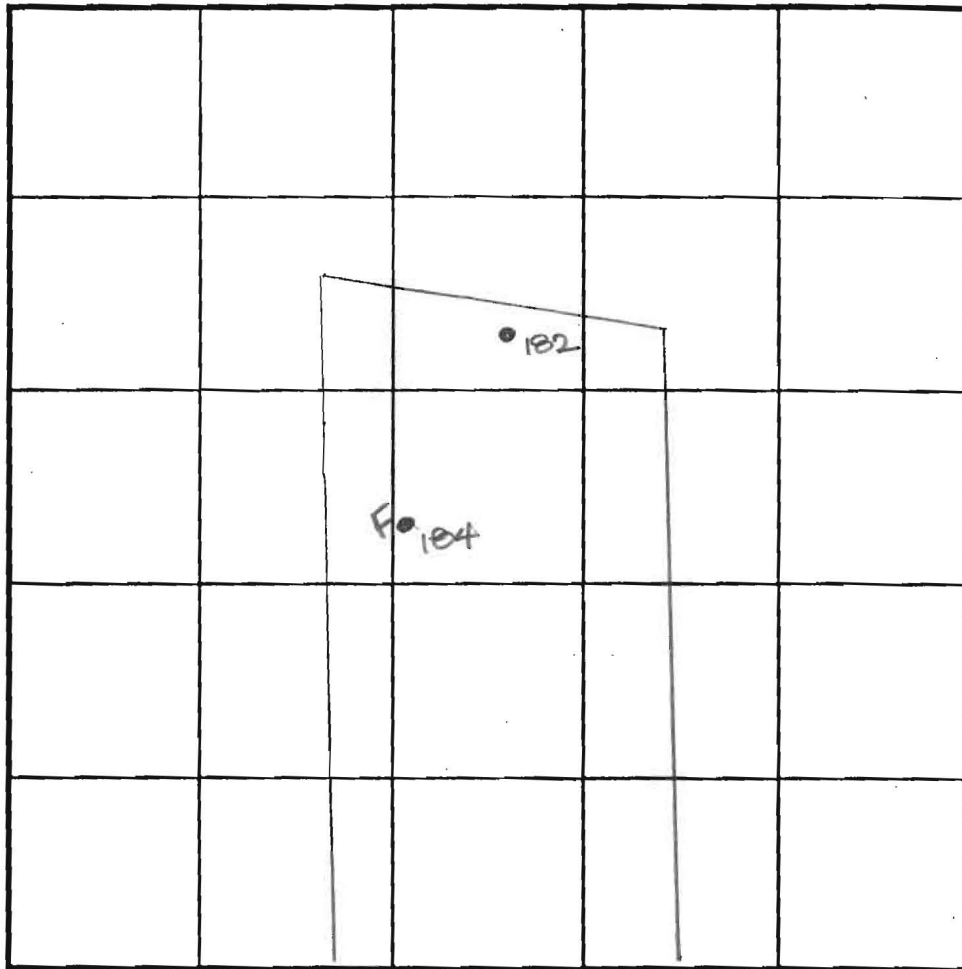

Triadelphia Road

[illegible]

REMARKS holes tested as staked

TYPE OF SOIL _____

TESTED BY DL ALSO PRESENT Boyle's, Mr. Wang

TRENCH DESIGN DATA: AVERAGE PERCOLATION TIME _____ TRENCH WIDTH _____

INLET DEPTH	MAXIMUM BOTTOM DEPTH	SQ. FT./BEDROOM
-------------	----------------------	-----------------

COUNTY #

SOIL PROFILE

240

topsoil

org brn
cl lmmed
red brn
si mica
lm60%
hard
frag
Refusal


241

topsoil

org red
brn
cl lm14 org
brn
si mica
lm30%+
rock
Refusal

SOIL PROFILE

0'

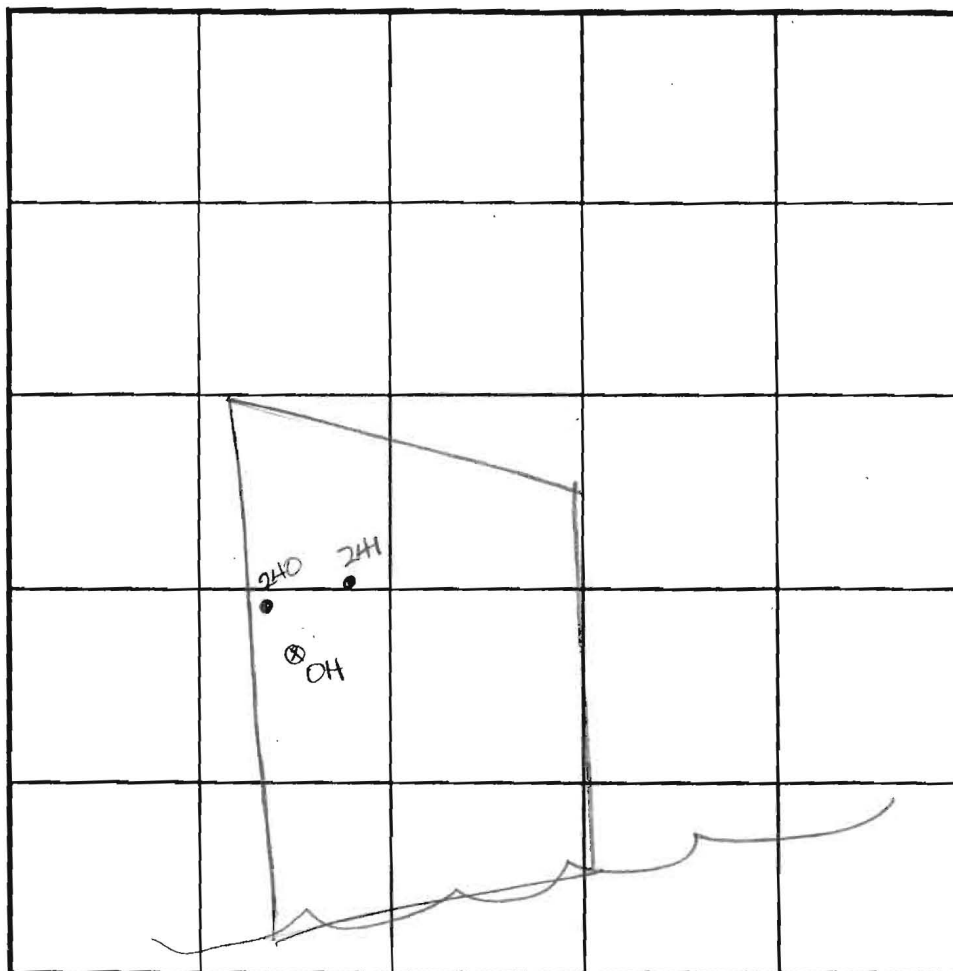

INDICATE NORTH - NAME ADJOINING ROADWAY AS BASE LINE.

Triadelphia Road

DATE	TEST NO.	DEPTH	PRE-WET		TEST - 1" DROP		TIME
			START	STOP	START	STOP	
6-5-01	240	3.0'S	3:28	3:44	3:44	4:04	10"
		12.0'D	Refusal	- see	profile		OK
	241	4.5'S	3:39	3:41	3:41	3:43	2
		11.5'D	Refusal	- see	profile		OK

REMARKS holes tested as staked

TYPE OF SOIL

TESTED BY DKC

ALSO PRESENT

Fogle's crew
B. K. Cheesley

TRENCH DESIGN DATA: AVERAGE PERCOLATION TIME

TRENCH WIDTH

INLET DEPTH

MAXIMUM BOTTOM DEPTH

SQ. FT./BEDROOM

