

PUB. SEWER STATUS VERIFIED BY \_\_\_\_\_

ISSUE DATE: 5/11/06

P 524462

APPROVAL DATE: 5/19/06

A REPAIR

**PERMIT**

**INDEXED**

TAX ID # 03-303101

**ON-SITE SEWAGE DISPOSAL SYSTEM  
HOWARD COUNTY HEALTH DEPARTMENT  
BUREAU OF ENVIRONMENTAL HEALTH**

J M Contracting LLC IS PERMITTED TO INSTALL ☐ ALTER ☒

ADDRESS: 1413 Searchlight Way, Mt Airy 21771 PHONE NUMBER: 410-795-3907

SUBDIVISION: Eagles Loft LOT NUMBER: 23

ADDRESS: 13128 Williamfield Drive PROPERTY OWNER: David Hassett

SEPTIC TANK CAPACITY (GALLONS): Existing 1250

PUMP CHAMBER CAPACITY (GALLONS): N/A

NUMBER OF BEDROOMS: 4

SQUARE FEET PER BEDROOM: 180

LINEAR FEET OF TRENCH REQUIRED: ~ 80 more if possible (86)

|           |  |
|-----------|--|
| TRENCHES: | Trench to be <u>3</u> feet wide. Inlet <u>4</u> feet below original grade. Bottom maximum depth <u>9</u> feet below original grade. Effective area begins at <u>5</u> feet below original grade. <u>5</u> feet of stone below distribution pipe. |
| LOCATION: |  |
| PURPOSE:  | Existing septic system has failed. Call for inspection when ground is opened so sanitarian can recommend repair.   |

PLANS APPROVED: \_\_\_\_\_ DATE: \_\_\_\_\_

NOTE: PERMIT VOID AFTER 2 YEARS

NOTE: CONTRACTOR RESPONSIBLE FOR SCHEDULING A PRE-CONSTRUCTION INSPECTION FOR ALL INSTALLATIONS

NOTE: WATERTIGHT SEPTIC TANKS REQUIRED


NOTE: ALL PARTS OF SEPTIC SYSTEM SHALL BE 100 FEET FROM ANY WATER WELL

NOTE: MANHOLE RISERS REQUIRED ON ALL SEPTIC TANKS AND PUMP CHAMBERS

**NEITHER THE HOWARD COUNTY COUNCIL OR THE HEALTH DEPARTMENT IS  
RESPONSIBLE FOR THE SUCCESSFUL OPERATION OF ANY SYSTEM  
PERMITTEE RESPONSIBLE FOR OBTAINING FINAL APPROVAL ON THIS PERMIT  
CALL 410-313-2640 FOR INSPECTION OF SEPTIC SYSTEM**

4524462

NOT TO SCALE

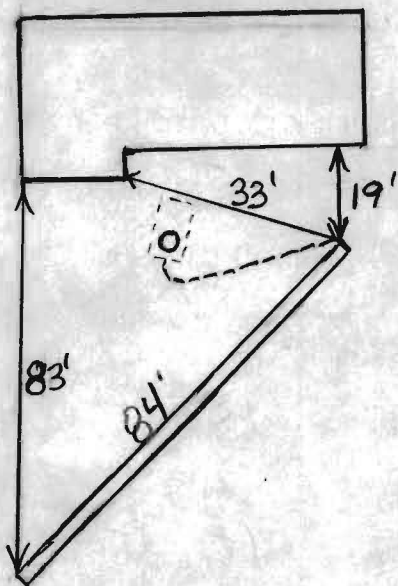

Williamfield Drive

ROAD

| TRENCH/DRAINFIELD DATA  |         |                |
|-------------------------|---------|----------------|
| WIDTH                   | INLET   | BOTTOM         |
| 3                       | 3.5'-4' | 9'             |
| NUMBER OF TRENCHES      |         | 1              |
| TOTAL LENGTH            |         | 84'            |
| ABSORPTION AREA         |         | 252 + Sidewalk |
| DISTRIBUTION BOX LEVEL  |         | N/A            |
| DISTRIBUTION BOX BAFFLE |         | N/A            |
| DISTRIBUTION BOX PORT   |         | N/A            |

| SEPTIC TANK DATA    |             |
|---------------------|-------------|
| SEPTIC TANK 1 LEVEL | Existing 50 |
| CAPACITY            | 1250 GAL    |
| SEAM LOC            | MID         |
| TANK LID DEPTH      |             |
| BAFFLES             | Inlet       |
| BAFFLE FILTER       |             |
| MANHOLE LOC         | Outlet      |
| 6" PORT LOC         |             |
| WATERTIGHT TEST     |             |
| SEPTIC TANK 2 LEVEL |             |
| CAPACITY            | GAL         |
| SEAM LOC            |             |
| TANK LID DEPTH      |             |
| BAFFLES             |             |
| BAFFLE FILTER       |             |
| MANHOLE LOC         |             |
| 6" PORT LOC         |             |
| WATERTIGHT TEST     |             |

PRE-CONSTRUCTION

INSTALLATION 5/19/06 Everything covered except for trench. Drywell pumped out and filled in per Ronny Heap. Trench depth is 9' per Ronny. O.K. to backfill. BB

FINAL INSPECTOR

B. Baker

GAC

DATE OF APPROVAL

5/19/06