

LTC

Count A $\rightarrow$

14

LIBRARY NAME - NAME ADDRESS PHONE FAX

W. H. H. Dr.

DATE	TEST NO.	DEPTH	PRE-WET		TEST 1" DROP		TIME
			START	STOP	START	STOP	
	1	4					
8/29	2	12	5 gal	press in	2 1/2 min		
8/30	3	7'	all rock				
8/30	4	10 1/2'	5 gal	press in	2 min		
8/31	5	4 1/2'	2 32	2 22	2 32	3 07	30
8/31	6	3 1/2'	2 32	2 49	2 49	2 53	8
8/31	7	12	2 29	2 40	2 40	2 50	11
8/31	8	6' rock					
9/20	9	10'	dn	clay / loam			


2000
3000
4000
REMARKS

we still need a hole @ #3 12 ft deep

TYPE OF SOIL

down, force up 5/31/13 RZ

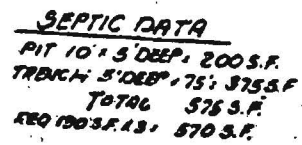

44-38861-12477