

PERMIT

SEWAGE DISPOSAL SYSTEM

MARYLAND STATE DEPARTMENT OF HEALTH

HOWARD COUNTY

ELICOTT CITY

DISTRICT 2nd

DATE 6/20/77

INDEXED

Jim Brittingham

IS PERMITTED TO INSTALL ☒ ALTER ☐

ADDRESS 3004 N. Rogers Ave. Elicott City, Md. 21043 PHONE 461-1870

SEWAGE DISPOSAL SYSTEM LOCATED AT

SUBDIVISION Kingston ROAD Williamfield Dr. 4, Blk. C, LOT Sec. 2.

PROPERTY OWNER Floyd Grayson Robert Gunwin

ADDRESS Columbia, Md.

SPECIFICATIONS 4 Bedrooms

DRAIN FIELD DEPTH FEET, BOTTOM AREA SQ. FT.

SEEPAGE PITS ABSORBENT SIDE-WALL AREA SQ. FT.

SEPTIC TANK CAPACITY 1250 GALLONS

FOR GARBAGE GRINDER, INCREASE DISPOSAL AREA 25% & TANK CAPACITY 50%.

OTHER DRY WELL & TRENCH: Locate the dry well 58 feet from the edge of Kingston Cr. and 86 feet from the edge of Williamfield Dr. - the invert will be around 4 feet below original grade with a maximum depth of 5 feet below original grade. The trench will begin 5 feet from the edge of the dry well, and will follow the contour of the land. The trench will be 3 feet wide, 3 feet deep and contain 3 feet of stone. There will be 190 feet of absorbent sidewall area per bedroom.

NOTE: CALL FOR INSPECTION OF TRENCH BEFORE PLACING GRAVEL IN TRENCH.

NOTE: ALL PIPE FROM HOUSE TO DISPOSAL AREA MUST BE CAST IRON. PERMIT JOBS AFTER THREE YEARS.

NOTE: INSTALL STAND PIPE ON SEPTIC TANK AND DRY WELL. STAND PIPES MUST BE 6 INCHES

PLANS APPROVED BY R. Moorefield DATE 1/10/76

IN DIAMETER. CAST IRON, CONCRETE OR TERRA COTTA ACCEPTED.

FILL SEPTIC TANK AND DISTRIBUTION BOX WITH WATER BEFORE CALLING FOR AN INSPECTION. COVER NO WORK UNTIL INSPECTED AND APPROVED.

NEITHER THE HOWARD COUNTY COMMISSIONERS NOR THE HEALTH DEPARTMENT IS RESPONSIBLE FOR THE SUCCESSFUL OPERATION OF ANY SYSTEM.

BLDG. PERMIT SIGNED

AND RETURNED 2/18/77


Serial # 610116267

SUNNYSIDE

18665

261574

DATE SYSTEM APPROVED

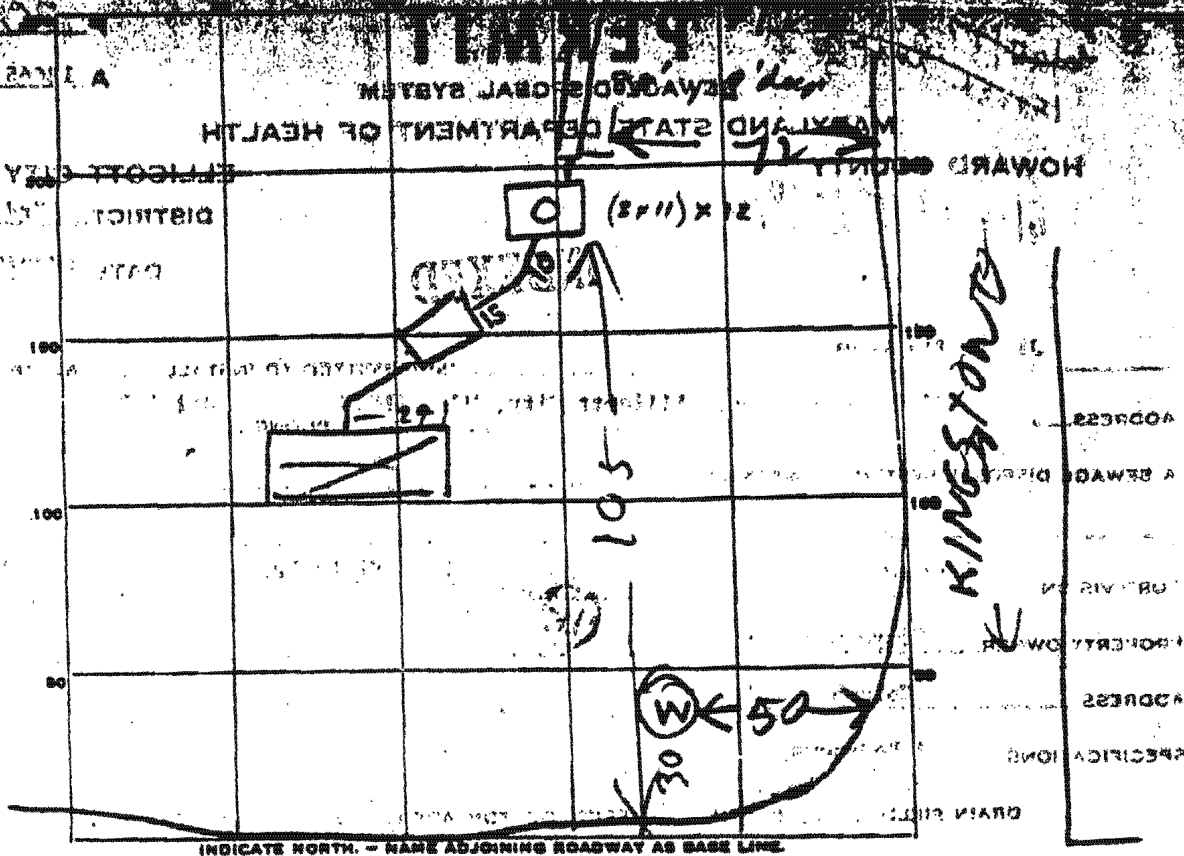

INDICATE NORTH - NAME ADJOINING ROADWAY AS BASE LINE

PERMIT CARD

SEPTIC TANK, LEVEL OK 1250 CLEANOUTS OK OK
 TOP 1 FT below grade
 DISTRIBUTION BOX, LEVEL OK
 TRENCH DEPTH 9 FT. TRENCH WIDTH 2 FT.
 GRAVEL DEPTH 5 1/2 FT. TOTAL LENGTH 188
 NUMBER OF TRENCHES 1 TOTAL SIDE WALL AREA 732
 SEPTAGE PITS, INSIDE DIAMETER 15 FT. DEPTH BELOW INLET 5.5 FT.
 ABSORBENT AREA 248 SQ. FT.

REMARKS: 6/30/77 - DW inlet 4 FT below grade
Ditch inlet 4 FT below grade
 TOTAL SIDE WALL AREA 732 sq ft

SEPTIC SYSTEM APPROVED

INSPECTOR

Raymond Rhodes