

NOTES:

- 1) B.R.L. information, if shown, was obtained from existing record plat or local agencies and is not guaranteed by NTT, Inc.
- 2) Building line and/or Flood Zone information is subject to the interpretation of the originator.
- 3) NTT, Inc. does not certify to unshown or unrecorded encroachments or overlaps.
- 4) Property markers NOT found, or guaranteed by this location.
- 5) Setback distance accuracy: 1'.

Villad'est Drive

L=130.72'
R=1728.41'

Pin in
Conc

N 20°20'00" E 341.73'

Septic
in
Front

Gravel

28.5'
52.1'
24.1' 1 Story
Brick + Frame
24.1' # 13462
52.1'

23'±

Well

Bsmnt
Ent

Frame
Shed

Lot
4
Block
B

Overgrown

APPROVED

WALK-THRU BUILDING PERMIT

BP# B02158-337A# 10344

APP. SAN 5/0 DATE:

DESC. OF WORK: Sanded

14' x 14'

N 75°30'00" E
175.58'

S 16°00'00" W 404.97'


(3)

75'
B.R.L.

Subject property is shown in Zone C
on the FIRM Map of Howard County,
Maryland on Community Panel #
240044 0032B. Effective 12-4-86

This is to certify that I have surveyed the property shown hereon,
being known as Lot 4, Block B, Section Two
Green Hill Manor
and recorded among the land records of Howard County,
Maryland in Pl Bl 24 folio 5
for the purpose of locating the improvements thereon.

- * This plat is of benefit to the consumer only insofar as it is required by a lender or a title insurance company or its agent in connection with contemplated transfer, financing, or refinancing purposes.
- * This plat is not to be relied upon for the establishment of location of fences, garages, buildings, or other existing or future structures.
- * This plat does not provide for the accurate identification of property boundary lines, but such identification may not be required for the transfer of title or for securing financing or refinancing.

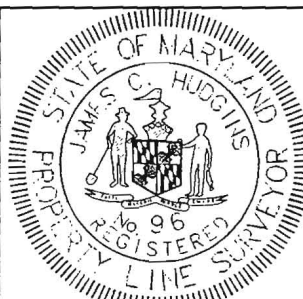

J. Carl Hudgins
Property Line Surveyor #96

LOCATION DRAWING

13462 Villad'est Drive
Howard County, Maryland

Election District No. 05

NTT Associates, Inc.

16205 Old Frederick Road
Mt. Airy, Maryland 21771
Ph. (410)442-2031
Fax No. (410)442-1315

Scale: 1"=50'
Date: 12-16-05
Field By: Don
Drawn By: Don
Drawing # 05-162 HD