
DEFAULT OF SUPECTIONS, LICENSES AND PERMITS
305 COURT HOUSE DRIVE
ELLICOTT CITY, MD 3905
PERMITS (NO 313-368) REPECTIONS (NO 313-1810)
AUTOMATIN REPUBLICATION OF WAY 300

HOWARD COUNTY

Bool5860)

经验证据证据	は は は は は は は は は は は は は は は は は は は	FEIGATION			
Building Address MOWN 2678	Willow Brace Derive	Property Owner's Name TERDINE BUILDING			
Grawas V	h a1738	Address 14015 GADES DRIVE			
Suite/Apt. #: SDP/WP/Petition #: # 11050		City Grunous State M Zip Code 21738			
		Home Phone Work Phone			
Census Tract 604002 Subdivision CGHG1 Crepto		Applicant's Name & Mailing Address, (if other than stated hereon):			
Section Area					
Tax Map 21 Parcel 211 Grid 8					
Zoning RC - DEMap Coordinates 859 Lot size 463901		Phone Fax			
Existing Use Suich FAMILY		Contractor Company DNITTO YRUDAUE			
Proposed Use Suich From 10 100004 744K		Contact Person			
Description of Work Tustal (1) 100006 LP TOUR		City Mr. Ains State M Zip Code 31771			
Occupant or Tenant		表现是有更多的是这种是是是一种的。 第一种的是一种的是一种的是一种的是一种的是一种的是一种的是一种的是一种的是一种的。			
		Engineer or Architect Company			
Contact Name		Contact Person			
Address		Address			
CityState_	Zip Code	CityZip Code			
Phone Fax		Phone Fax			
BUILDING DESCRIPTION - COMMERCIAL		BUILDING DESCRIPTION - R	RESIDENTIAL		
Building Characteristics	<u>Utilities</u>	Building Characteristics	<u>Utilities</u>		
Height:	Water Supply: Public	SF Dwelling SF Townhouse Depth Width	Water Supply: Public		
No. of stories:	Private Sewage Disposal:	1st floor: 2nd floor:	Private Sewage Disposal:		
Gross area, sq. ft. per floor:	Public Private	Basement:	Public Private		
Cross area, sq. ii. per noor.		Finished Basement □ Unfinished Basement□ Crawl space □ Slab on Grade □	Electric Yes No		
Use group:	Electric Yes □ No □ Gas Yes □ No □	No. of Bedrooms	Gas Yes□ No□		
	Heating System:	Multi-family dwellings: No. of efficiency units: No. of 1 BR units:	Heating System: Electric □ Oil □		
Construction type: Reinforced Concrete	Electric Oil Oil Natural Gas	No. of 2 BR units: No. of 3 BR units:	Natural Gas □ Propane Gas □		
Structural Steel Masonry	Propane Gas	Other Structure:	Sprinkler system: N/A		
Wood Frame	Sprinkler system: N/A Full	Dimensions: Footings:	NFPA #13D NFPA #13R		
	Partial	Rooft	Other:		
State Certified Modular	Other Suppression # of Heads	State Certified Modular Manufactured Home			
	O WORK ON THE ABOVE REFERENCED PROPERTY NOT	TRUN; (2) THAT THE INFORMATION IS CORRECT; (3) THAT HE/SHE WILL COS SPECIFICALLY DESCRIBED IN THIS APPLICATION; (5) THAT HE/SHE GRANT			
aller Grand	H.	Alvice E. GARRE	1		
Applicant's Signature		Print Name			
Title/Company		3/17/06 Date	and the mind of the second		
		FINANCE OF HOWARD COUNTY ATLY AND LEGIBLY. **			
AGENCY DATE	- FOR OFFI SIGNATURE APPROVAL	CE USE ONLY - DPZ SETBACK INFORMATION PRO	PERTY 10#: 65934		
Land Development, DPZ	SIGNATORE APPROVAL	From: Filing	g fee S and American American		
		A STATE OF THE PARTY OF THE PAR	nit fee Ssetax S		
Dev. Engineering, DPZ / / / / / / 8		Side St.: Add'	l per, fee \$		
Fire Protection 4/5/00 Angles			AL FEES \$		
		Is Entrance Permit required? Bala	nce due \$		
YES D NO D		YES□ NO□ Chec Historic District? Valid	tation # //0555		
		YES 🗆 NO 🗅			
ONE STOP SHOP:	the state of the s	Lot Coverage for NewTown Zone SDP/Red-line approval date	Accepted by		
ution of Copies- White: Building Offi	cial Green: LDD, DPZ Y	ellow: DED, DPZ Pink: Health Gold	SHA		

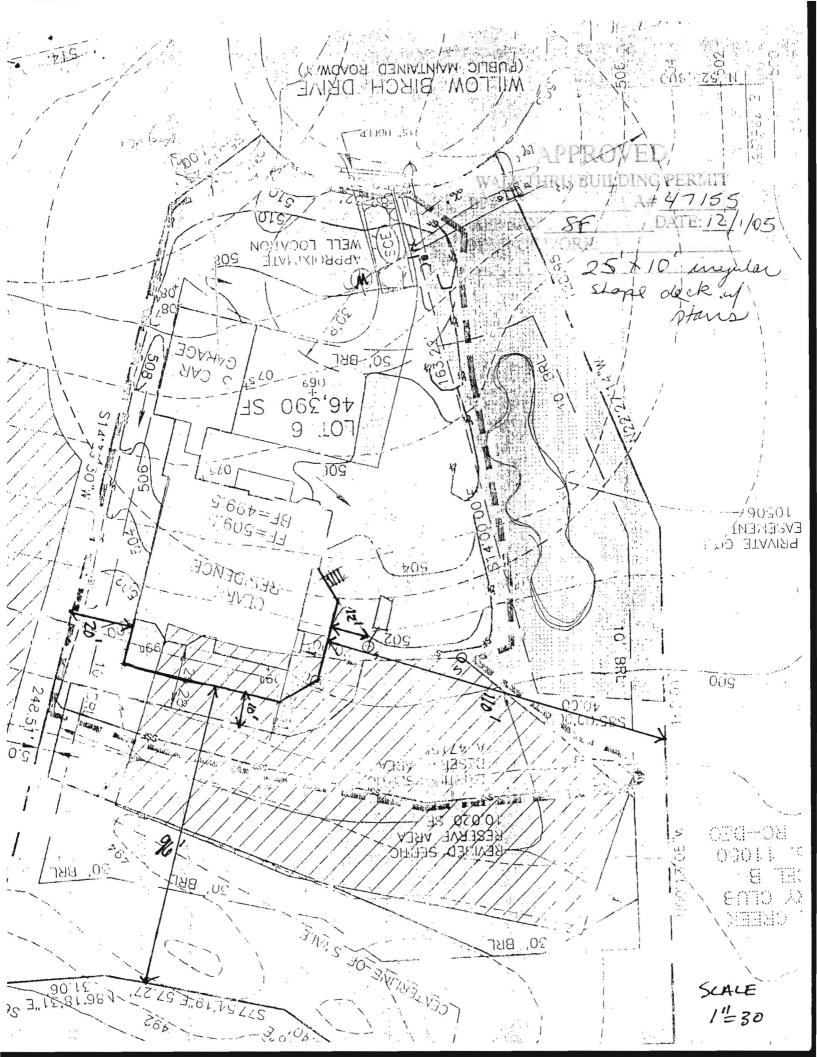

DEPARTMENT OF INSPECTIONS, LICENSES AND PERMITS

SHIP COLIFF MY JEE DRIVE

FELLY TOTAL NO 21043

FERMITS (410) 313-2455 NEPECTIONS (410) 333-1810

FERMITS (410) 313-2455 NEPECTIONS (410) 333-1810

HOWARD COUNTY

PERMIT NUMBER

PERMITS (410) 313-2455 INSPECTIONS (410) 313-1810 ALITOMATED INFORMATION (410) 313-2800	PERMIT AF	PLICATION				
Building Address 3608 WIII	w Birch Drive	Property Owner's Name _	DREL	J CIA	nK	
- GHIWALD MD 21738		Address 3608 Willow Birch Drive				
Suite/Apt. # SDP/WP/Petition #:		1				
Census Tract Subdivision		City Glanwood State MID Zip Code 21781				
Section Area Lot		Home Phone 416 461 6706 Work Phone Applicant's Name & Mailing Address, (if other than stated hereon):				
Tax Map Z Parcel Z // Grid 8		, , , , , , , , , , , , , , , , , , , ,	, , (., .			
Zoning Map Coordinates Lot size		Phone Fax				
Existing Use SINGLE Family Home w/Pf(10 WS- Proposed Use SINGLE Family Home w/Pf(10 WS- Estimated Construction Cost \$ 20,000		Contractor Company BUDDING BRANCH Land Scap GONTACT Person RUB BOSWELL				
Description of Work Build Meck Approx 30 x 12		Address 14900 TRIAD-Elphia Rd				
and 25×10 Transquian Shape		2				
- around house wistams to grade		City Clenelog State MD Zip Code 21737 License No. 12 1573 7 Phone 410 442 8708 Fax 410 489 0749				
Occupant or TenantA		Engineer or Architect Company / A				
Contact Name		Contact Person				
Address Address						
City State _	Zip Code	}				
Phone Fax				ate Zip Code		
		Phone Fax				
BUILDING DESCRIPTION	BUILDING DESCRIPTION - RESIDENTIAL					
Building Characteristics Height:	<u>Utilities</u> Water Supply:	Building Characte SF Dwelling X SF Town				
No. of stories:	Public	Depth	Width			
NO. OF STOTIOS.	Private Sewage Disposal:	1st floor:		Sewage	Disposal:	
Gross area, sq. ft. per floor:	Public Private	Basement: Finished Basement □ Unfinished Basement□ Public Private		olic vate		
Use group:	Electric Yes □ No □ Gas Yes □ No □	Crawl space □ Slab on Grade □ Electric Yes ☒ No □ No. of Bedrooms Height:				
	Heating System:	Multi-family dwellings: No. of efficiency units: Heating System:				
Construction type: Reinforced Concrete	Electric □ Oil □ Natural Gas □	No. of 1 BR units: Electric Oil No. of 2 BR units: Natural Gas		Gas □		
Structural Steel Masonry	Propane Gas 🗆	Propane Gas		Gas □		
Wood Frame	Sprinkler system: N/A	Other Structure: Sprinkler system: N/A Dimensions: NFPA #13D		FPA #13D		
00	Full Partial	Roof Height: NFPA #13R Other:				
State Certified Modular	Other Suppression # of Heads	State Certified Modul	аг			
THE UNDERSIGNED HEREBY CERTIFIES AND AGREES AS FOLLOWS: HOWARD COUNTY WHICH ARE APPLICABLE THERETO; (4) THAT HE/ THE RIGHT TO ENTER ONTO THIS PROPERTY FOR THE PURPOSE OF	SHE WILL PERFORM NO WORK ON THE ABOVE REFE	RENCED PROPERTY NOT SPECIFICALLY DESC	RECT; (3) THAT HE/SH	E WILL COMPLY WI ATION; (5) THAT HE	TH ALL REGULATIONS OF SHE GRANTS COUNTY OFFICIALS	
THE MOST TO ERIER ONTO THIS PROPERTY FOR THE PURPOSE OF	INSPECTING THE WORK PERMITTED AND POSTING N	IOTICES.				
Applicant's Signature	;	Print Name				
Title/Company Date Checks payable to: DIRECTOR OF FINANCE OF HOWARD COUNTY ** PLEASE WRITE NEATLY AND LEGIBLY. **						
AGENCY DATE	- FOR OFFIC SIGNATURE APPROVAL	DPZ SETBACK IN	FORMATION		PROPERTY ID#:	
Land Development, DPZ		Front:	FIII	ing fee	\$	
State Highways Building Official		Rear: Side:		rmit fee cise tax	\$ \$	
Dev. Engineering, DPZ		Side St.:		d'I per. fee	5	
Health 12/1/05 faraffer		All minimum setbacks met?	TC	TAL FEES	5	
Is Sediment Control approval required prior to issuance?		YES NO Is Entrance Permit		b-total paid lance due	\$	
YES D NO D		YES - NO -	Ch	eck		
그는 그 그는 그 그는 그는 그는 그는 그는 그는 그를 보는 것이 없었다. 그는 그는 그는 그는 그를 가는 것이 모든 것이 없다. 그는 그를 가는 것이 없다는 것이 없다.		Historic District? YES NO	Va	lidation	THE RESERVE OF THE PROPERTY OF	
		Lot Coverage for NewTown Zo	ne	1		
Distribution of Copies- White: Building Official Green: LDD, DPZ Yellow: DED, DPZ Pink: Health Gold: SHA					HA	
T:Norms\PERMIT.FRM	一	副性。它特殊了付付持在1860m	The Market of the Park	1	Rev. 11/4//04	

HOWARD COUNTY PERMIT NUMBER PERMIT APPLICATION Building Address 3608 Willow Birch Drive Property Owner's Name William Duch 3606 Glanwood MD 21738 Address PLAT 11010 TA 52 01-354559 State ND Zip Code 21738 Leaving City Census Tract 604002 Subdivision CATA CAR CO Work Phone Home Phone Applicant's Name & Mailing Address, (if other than stated hereon): Section Tex Map 21 8 Zoning Lot size 46390 54 Phone Contractor Company JAMES H. Selfwig Buildy Existing Use VACANT LOT Proposed Use New Sing FAMily Divilling
Estimated Construction Cost \$ 950,000 Contact Person FIM KAGE GARD Description of Work Castom 1 Story 14045 Zip Code 21738 State MD 2HB 2 Masony F/ 1GK F/ License No. 0001169 Phone 410 531 8930 SARINE FLOSIES BEA Fex 410-531-6939 Occupant or Tenant Engineer or Architect Company Contact Name Contact Person Actions Address CRV Zip Code City State Zip Code BUILDING DESCRIPTION - COMMERCIAL BUILDING DESCRIPTION - RESIDENTIAL Building Characteristics Building Characteristics Utilities Utilities Water Supply:
Public Private Sewage Dispos Public Private No. of stones: Basement
Finished Basement (**Unfinished Basement Crawl space | Slab on Grade | No. of Bedruous 60 Gross area, sq. it; per floor. Yes No D Electric Yes | No | Gas Yes | No | Heating System:
Electric Total III
Natural One III
Propose Gas III No. of efficiency un No. of 1 BR units No. of 2 BR units No. of 3 BR units Heating System Electric D Oil Natural Gas D Propune Gas D Construction type:
Reinforced Concession Structural Steel
Massagey Sprinkler system:
NFPA #13D
NFPA #13R
Other: N/A E Wood Frame Sprinkler system: N/A [] Full Partial State Certified Michigan Other Suppression # of Heads State Certified Modular Manufactured Home Operation in the second arrange con ANCE OF HOWARD COUNTY PROPERTY IN DATE SIGNATURE APPROVAL DPZ SETBACK INFORMATION Filing fee \$ Permit for Excise tax Add'I per fee TOTAL FEES Sub-total paid Balance due YES D NO D Is Entrance Permit required?

YES CI NO CI 11000 CONTINUENCY CONSTRUCTION START: DI YES I NO D Lot Coverage for New Town Zo SDP/Red-line approval date White: Building Official Green: LDD, DPZ Yellow: DED, DPZ Rev. 5/17/00

