

LAYOUT N/A INSP 4 _____
 INSP 2 4/10/06 INSP 5 _____
 INSP 3 _____ INSP 6 _____

Not valid
Friday

ISSUE DATE: 4/13/06
 APPROVAL DATE: 4/13/06

P 524404
 A 523873

PERMIT
INDEXED
TAX ID #05-343348
ON-SITE SEWAGE DISPOSAL SYSTEM
HOWARD COUNTY HEALTH DEPARTMENT
BUREAU OF ENVIRONMENTAL HEALTH

_____ IS PERMITTED TO INSTALL ALTER

ADDRESS: _____ PHONE NUMBER: _____

SUBDIVISION: _____ LOT NUMBER: _____

ADDRESS: 6107 Tulane Drive PROPERTY OWNER: Gregory Gibson

SEPTIC TANK CAPACITY (GALLONS): 1250 OUTLET BAFFLE FILTER REQUIRED

PUMP CHAMBER CAPACITY (GALLONS): n/a COMPARTMENTED TANK REQUIRED

NUMBER OF BEDROOMS: 4

SQUARE FEET PER BEDROOM: _____

LINEAR FEET OF TRENCH REQUIRED: _____ HOUSE SERVED BY PUBLIC WATER

TRENCHES:	
LOCATION:	Existing 1250 gallon septic tank, tie in line from 2 story addition to existing septic tank line.
NOTES:	

PLANS APPROVED: GAC Reviewed by: _____ DATE: 4/12/06

NOTES: PERMIT VOID AFTER 2 YEARS
 CONTRACTOR IS RESPONSIBLE FOR SCHEDULING A PRE-CONSTRUCTION INSPECTION FOR ALL INSTALLATIONS
 WATERTIGHT SEPTIC TANKS REQUIRED
 ALL PARTS OF SEPTIC SYSTEM SHALL BE 100 FEET FROM ANY WATER WELL UNLESS SPECIFICALLY AUTHORIZED
 MANHOLE RISERS REQUIRED ON ALL SEPTIC TANKS AND PUMP CHAMBERS UNLESS SPECIFICALLY AUTHORIZED
 CONTRACTOR RESPONSIBLE FOR COMPLIANCE WITH APPLICABLE REGULATIONS, GUIDELINES AND THE TERMS OF THIS PERMIT

NEITHER THE HOWARD COUNTY COUNCIL NOR THE HEALTH DEPARTMENT IS RESPONSIBLE FOR THE SUCCESSFUL OPERATION OF ANY SYSTEM PERMITTEE RESPONSIBLE FOR OBTAINING FINAL APPROVAL ON THIS PERMIT CALL 410-313-1771 FOR INSPECTION OF SEPTIC SYSTEM

A523873

NOT TO SCALE

TRENCH/DRAINFIELD DATA

WIDTH Existing INLET _____ BOTTOM _____

NUMBER OF TRENCHES _____

TOTAL LENGTH _____

ABSORPTION AREA _____

DISTRIBUTION BOX LEVEL _____

DISTRIBUTION BOX BAFFLE _____

DISTRIBUTION BOX PORT _____

SEPTIC TANK DATA

SEPTIC TANK 1 LEVEL _____

E CAPACITY _____ GAL

X SEAM LOC _____

I TANK LID DEPTH _____

S BAFFLES _____

T BAFFLE FILTER _____

I MANHOLE LOC _____

N 6" PORT LOC _____

G WATERTIGHT TEST _____

~~SEPTIC TANK 2 LEVEL _____~~

~~CAPACITY _____ GAL~~

~~SEAM LOC _____~~

~~TANK LID DEPTH _____~~


~~BAFFLES _____~~

~~BAFFLE FILTER _____~~

~~MANHOLE LOC _____~~

~~6" PORT LOC _____~~

~~WATERTIGHT TEST _____~~

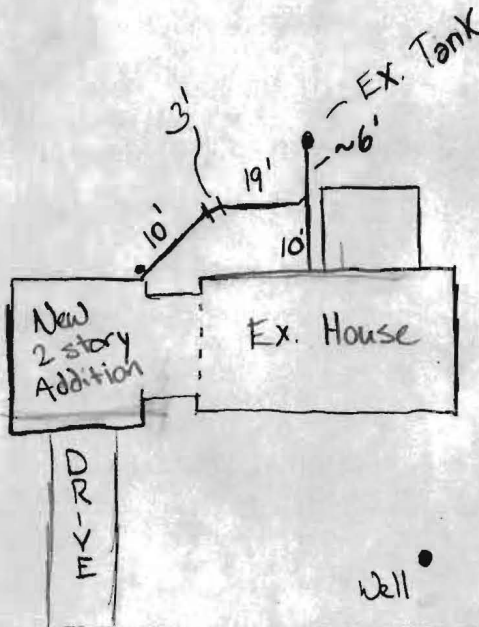

PRE-CONSTRUCTION _____

Tie line from new 2 story addition into existing septic line for existing system. 4/10/06

INSTALLATION _____

Connection done and approved for cover. final approval pending payment of upgrade fee.

GAC


4/13/06 payment received. GAC

FINAL INSPECTOR _____

Richard J. Gray

DATE OF APPROVAL _____

4/13/06

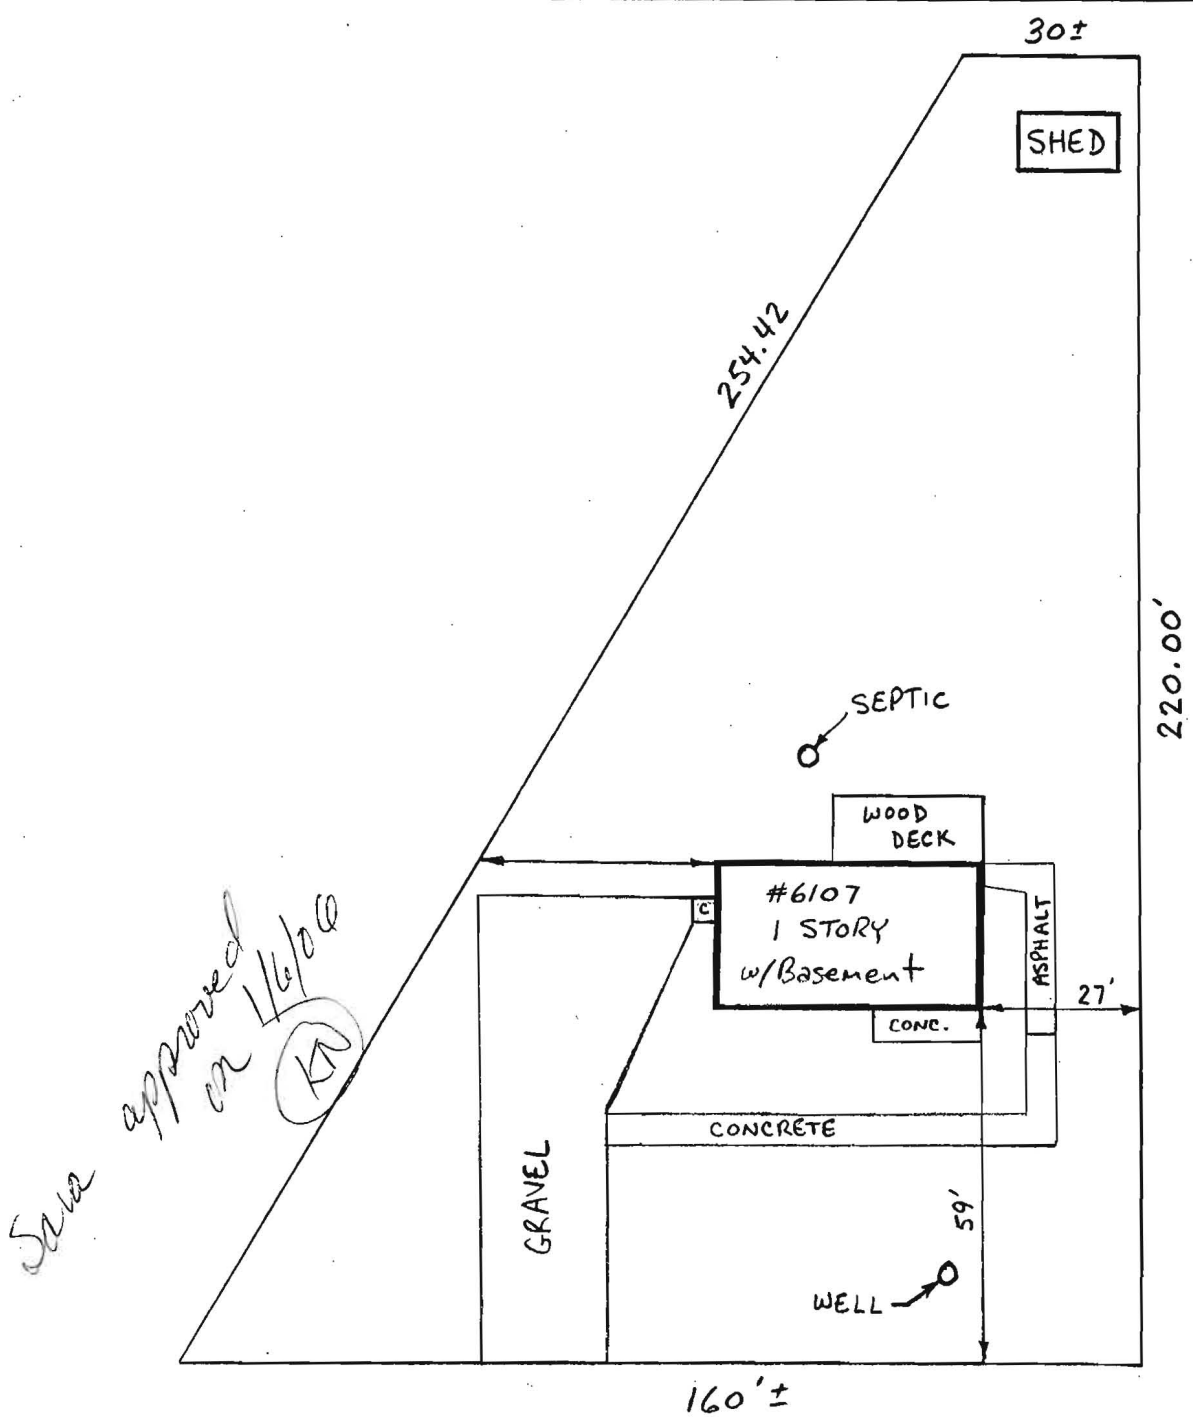

TULANE DRIVE

EXISTING SITE	
Project: 6107 Tulane Dr. - Addition	
Scale: 1/32	Date: Nov. 21, 2005