

HOWARD COUNTY
PERMIT APPLICATION

PERMIT NUMBER

PO6006275

Building Address 651W WATERVILLE RD.
MT. AIRY MD. 21771

Property Owner's Name CHRISTIAN HOMES INC.

Address P.O. Box 1026

Suite/Apt. #: _____ SDP/WP/Petition #: _____

Census Tract _____ Subdivision _____

City MT. AIRY State MD. Zip Code 21771

Section _____ Area _____ Lot _____

Home Phone _____ Work Phone _____

Tax Map _____ Parcel _____ Grid _____

Applicant's Name & Mailing Address, (if other than stated hereon):
SCOTT ANTKOWIAK

Zoning _____ Map Coordinates _____ Lot size _____

Phone 301-829-7524 Fax 301-829-7526

Existing Use _____

Contractor Company TEVIN OIL / MODERN COMFORT

Proposed Use _____

Contact Person SCOTT ANTKOWIAK

Estimated Construction Cost \$ 2219.

Address 82 JOHN ST.

Description of Work INSTALL OF 500

City WESTMINSTER State MD. Zip Code 21158

GALEON UNDERGROUND TANK

License No. _____

TANK.

Phone _____ Fax _____

Occupant or Tenant _____

Engineer or Architect Company _____

Contact Name TEVIN OIL / MODERN COMFORT

Contact Person _____

Address 82 JOHN ST.

Address _____

City WESTMINSTER State MD. Zip Code 21158

City _____ State _____ Zip Code _____

Phone 410 Fax _____

Phone _____ Fax _____

BUILDING DESCRIPTION - COMMERCIAL

BUILDING DESCRIPTION - RESIDENTIAL

Building Characteristics

Utilities

Height: _____

Water Supply: _____

No. of stories: _____

Public _____
Private _____

Gross area, sq. ft. per floor: _____

Sewage Disposal: _____

Public _____
Private _____

Use group: _____

Electric Yes ☐ No ☐
Gas Yes ☐ No ☐

Construction type: _____

Heating System: _____

Reinforced Concrete _____
Structural Steel _____
Masonry _____
Wood Frame _____

Electric ☐ Oil ☐
Natural Gas ☐
Propane Gas ☐

State Certified Modular _____

Sprinkler system: N/A ☐
Full _____
Partial _____
Other Suppression _____
of Heads _____

Building Characteristics

Utilities

SF Dwelling ☒ SF Townhouse ☐

Water Supply: _____

Depth _____ Width _____

Public _____
Private ☒

1st floor: _____

Sewage Disposal: _____

2nd floor: _____

Public _____
Private ☒

Basement: _____

Finished Basement ☐ Unfinished Basement ☐

Crawl space ☐ Slab on Grade ☐

No. of Bedrooms _____

Height: _____

Multi-family dwellings: _____

No. of efficiency units: _____

No. of 1 BR units: _____

No. of 2 BR units: _____

No. of 3 BR units: _____

Other Structure: _____

Dimensions: _____

Footings: _____

Roof Height: _____

State Certified Modular _____

Manufactured Home _____

Electric Yes ☐ No ☐
Gas Yes ☐ No ☐

Heating System: _____

Electric ☐ Oil ☐
Natural Gas ☐
Propane Gas ☒

Sprinkler system: N/A ☐
NFPA #13D _____
NFPA #13R _____
Other: _____

THE UNDERSIGNED HEREBY CERTIFIES AND AGREES AS FOLLOWS: (1) THAT HE/SHE IS AUTHORIZED TO MAKE THIS APPLICATION; (2) THAT THE INFORMATION IS CORRECT; (3) THAT HE/SHE WILL COMPLY WITH ALL REGULATIONS OF HOWARD COUNTY WHICH ARE APPLICABLE THERETO; (4) THAT HE/SHE WILL PERFORM NO WORK ON THE ABOVE REFERENCED PROPERTY NOT SPECIFICALLY DESCRIBED IN THIS APPLICATION; (5) THAT HE/SHE GRANTS COUNTY OFFICIALS THE RIGHT TO ENTER ON TO THIS PROPERTY FOR THE PURPOSE OF INSPECTING THE WORK PERMITTED AND POSTING NOTICES.

Applicant's Signature

Print Name

Title/Company

Date

Checks payable to: **DIRECTOR OF FINANCE OF HOWARD COUNTY**
** PLEASE WRITE NEATLY AND LEGIBLY. **

- FOR OFFICE USE ONLY -

AGENCY DATE SIGNATURE APPROVAL

DPZ SETBACK INFORMATION

PROPERTY ID#

Land Development DPZ

Front: _____

Filing fee \$

State Highways

Rear: _____

Permit fee \$

Building Official

Side: _____

Excise tax \$

Dev. Engineering DPZ

Side St: _____

Add'l per. fee \$

Health

All minimum setbacks met?

TOTAL FEES \$

Fire Protection

YES ☐ NO ☐

Sub-total paid \$

Is Sediment Control approval required prior to issuance?

Is Entrance Permit required?

Balance due \$

YES ☐ NO ☐

YES ☐ NO ☐

Check \$

Historic District?

Validation \$

YES ☐ NO ☐

Lot Coverage for NewTown Zone

SDP/Red-line approval date

Accepted by

CONTINGENCY CONSTRUCTION START: ☐

ONE STOP SHOP: ☐

Distribution of Copies-

White: Building Official

Green: LDD, DPZ

Yellow: DED, DPZ

Pink: Health

Gold: SHA

T:\norma\PERMIT.FRM

Rev. 11/4/04

6-9689

DEPARTMENT OF INSPECTIONS, LICENSES AND PERMITS
3430 COUNTY HOUSE DRIVE
ELICOTT CITY, MD 21043
PERMITS (410) 313-2000 INSPECTIONS (410) 313-1510
AUTOMATED INFORMATION (410) 313-3900

HOWARD COUNTY PERMIT APPLICATION

PERMIT NUMBER

B-00160149

Building Address 651 W. Patterson Ave. #202Property Owner's Name Christiane Horner IncAddress P.O. Box 1026Suite/Apt. #: 04-3013218 S.O.P./M.P./Petition #: _____City MD State MD Zip Code 21771Census Tract 604001 Subdivision _____

Home Phone _____ Work Phone _____

Section 3 Area _____ Lot _____

Applicant's Name & Mailing Address, (if other than stated hereon):

Tax Map 2 Parcel 245 Grid 20Phone 301-829-7524 Fax 301-829-7526Zoning RCD-9 Map Coordinates _____ Lot size 3.00Contractor Company Christiane Horner IncExisting Use U/MContact Person Matthew MetzgerProposed Use Construct a single family homeAddress P.O. Box 1026Estimated Construction Cost \$400,000City MD State MD Zip Code 21771Description of Work Custom SFD - single family homeLicense No. 348Phone 301-829-7524 Fax 301-829-7526

Occupant or Tenant _____

Engineer or Architect Company Christian Horner Inc

Contact Name _____

Contact Person Donald Horner

Address _____

City MD State MD Zip Code 21771

City _____ State _____ Zip Code _____

Phone _____ Fax _____

Phone 301-829-7524 Fax 301-829-7526BUILDING DESCRIPTION - COMMERCIALBUILDING DESCRIPTION - RESIDENTIAL

Building Characteristics

Utilities

Building Characteristics

Utilities

Height: _____

Water Supply: _____

SF Dwelling ☒ SF Townhouse ☐

No. of stories: _____

Public

Depth _____ Width _____

Gross area, sq. ft. per floor: _____

Private

1st floor: _____

Use group: _____

Sewage Disposal: _____

2nd floor: _____

Construction type: _____

Public

Basement: _____

Reinforced ConcretePrivateFinished Basement ☐ Unfinished Basement ☒Structural SteelElectric Yes ☐ No ☐Crawl space ☐ Slab on Grade ☐MasonryGas Yes ☐ No ☐No. of Bedrooms 4Wood Frame

Heating System: _____

Multi-family dwellings: _____

State Certified ModularElectric ☐ Oil ☐

No. of efficiency units: _____

Natural Gas ☐

No. of 1 BR units: _____

Propane Gas ☐

No. of 2 BR units: _____

Sprinkler system: N/A ☐

Other Structure: _____

Full

Dimensions: _____

Partial

Footings: _____

Other Suppression

Roof Height: _____

of HeadsState Certified ModularManufactured Home

Water Supply: _____

PublicPrivate

Sewage Disposal: _____

PublicPrivateElectric Yes ☐ No ☐Gas Yes ☐ No ☐

Heating System: _____

Electric ☐ Oil ☐Natural Gas ☐Propane Gas ☒Sprinkler system: N/A ☐NFPA #13DNFPA #13ROther:

THE UNDERSIGNED HEREBY CERTIFIES AND AGREES AS FOLLOWS: (1) THAT HE/SHE IS AUTHORIZED TO MAKE THIS APPLICATION; (2) THAT THE INFORMATION IS CORRECT; (3) THAT HE/SHE WILL COMPLY WITH ALL REGULATIONS OF HOWARD COUNTY WHICH ARE APPLICABLE THERETO; (4) THAT HE/SHE WILL PERFORM NO WORK ON THE ABOVE REFERENCED PROPERTY NOT SPECIFICALLY DESCRIBED IN THIS APPLICATION; (5) THAT HE/SHE GRANTS COUNTY OFFICIALS THE RIGHT TO ENTER ONTO THIS PROPERTY FOR THE PURPOSE OF INSPECTING THE WORK PERMITTED AND POSTING NOTICES.

Applicant's Signature

Print Name

Title/Company

Date

Checks payable to: DIRECTOR OF FINANCE OF HOWARD COUNTY

** PLEASE WRITE NEATLY AND LEGIBLY **

APPROVAL

DEPT SETBACK INFORMATION

PROPERTY INFO

Date/Description: 06-22-06 Process

Front _____

Filing fee: \$ 100.00

Date/Description: _____

Rear _____

Permit fee: \$ _____

Date/Description: _____

Side _____

Excess fee: \$ _____

Date/Description: _____

Side 2 _____

Add'l per. fee: \$ _____

Date/Description: _____

As indicated on plan? _____

TOTAL FEES: \$ _____

Date/Description: _____

YES ☐ NO ☐

Sub-total paid: \$ _____

Date/Description: _____

Is Estimate Permit required? _____

Balance due: \$ _____

Date/Description: _____

YES ☐ NO ☐Check: \$ 100.00

Date/Description: _____

Is Estimate Permit required? _____

Validation: \$ 100.00

Date/Description: _____

YES ☐ NO ☐

Date/Description: _____

Lot Coverage for New/Use Zone _____

Date/Description: _____

STOP/Not-Start approval date _____

Accepted by: DT

Date/Description: _____

Yellow: DEPT OFZ _____

Date/Description: _____

Pink: Health _____

Date/Description: _____

Gold: SHA _____


Date/Description: _____

Red: 11/1/06

N/F
DONALD FLEMING
L. 1307, F. 595

N/F
C.A. & D.D. SHARP
L. 4252, F. 338

S 37°06'01"W 319.32'

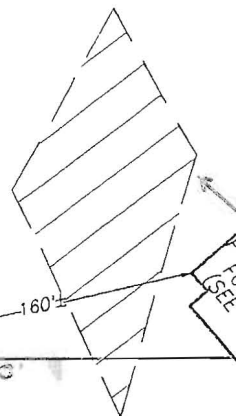

LAND CONVEYED TO
CHRISTIAN HOMES AND BUILDING
MANAGEMENT, INC.
L. 10076, F. 308
130,680 SQ. FT.
3.0000 AC.±


EX. 10' GRV. DRIVE

EX. MAC. PAVING

N 37°06'01"E 209.52'

WEST WATERSVILLE ROAD

*LP tank location
ok
11/3/06
sf*

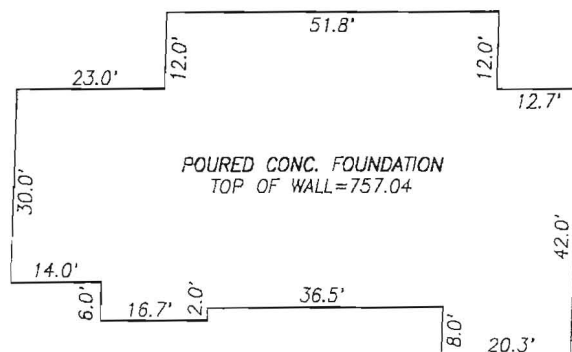

HOUSE DETAIL
SCALE: 1"=30'

