



Howard County
Health Department

LOTS 16, 17

APPLICATION

FOR PERCOLATION TESTING AND SITE EVALUATION

TEST DATE(S) _____ TEST TIME _____ A/P _____

AGENCY REVIEW: _____ DATE _____

DO NOT WRITE ABOVE THIS LINE

I HEREBY APPLY FOR THE NECESSARY TESTING/EVALUATION PRIOR TO ISSUANCE OF SEWAGE DISPOSAL SYSTEM PERMIT(S) TO:

CHECK AS NEEDED:

- ☐ CONSTRUCT NEW SEPTIC SYSTEM(S)
- ☐ REPAIR/ADD TO AN EXISTING SEPTIC SYSTEM
- ☐ REPLACE AN EXISTING SEPTIC SYSTEM

CHECK AS NEEDED:

- ☐ NEW STRUCTURE(S)
- ☐ ADDITION TO AN EXISTING STRUCTURE
- ☐ REPLACE AN EXISTING STRUCTURE

CHECK ONE:

- ☐ CREATE NEW LOT(S)
- ☐ BUILD ON AN EXISTING LOT IN A SUBDIVISION
- ☐ BUILD ON AN EXISTING PARCEL OF RECORD

IS THE PROPERTY WITHIN 2500' OF ANY RESERVOIR?

- ☐ YES
- ☐ NO

THE TYPE OF STRUCTURE IS:

- ☐ RESIDENTIAL WITH _____ PROPOSED BEDROOMS IN THE COMPLETED STRUCTURE. (NOTE *UNKNOWN* IF APPROPRIATE)
- ☐ COMMERCIAL (PROVIDE DETAIL OF NUMBERS AND TYPES OF EMPLOYEES/ CUSTOMERS ON ACCOMPANYING PLAN)
- ☐ INSTITUTIONAL/GOVERNMENT (PROVIDE DETAIL OF NUMBERS AND TYPES OF EMPLOYEES/USERS ON ACCOMPANYING PLAN)

PROPERTY OWNER(S) _____

DAYTIME PHONE _____ CELL _____ FAX _____

MAILING ADDRESS _____
STREET CITY/TOWN STATE ZIP

APPLICANT _____

DAYTIME PHONE _____ CELL _____ FAX _____

MAILING ADDRESS _____
STREET CITY/TOWN STATE ZIP

APPLICANT'S ROLE: DEVELOPER BUILDER BUYER RELATIVE/FRIEND REALTOR CONSULTANT

PROPERTY LOCATION
SUBDIVISION/PROPERTY NAME _____ LOT NO. _____

PROPERTY ADDRESS Meriwether
STREET TOWN/POST OFFICE

TAX MAP PAGE(S) _____ GRID _____ PARCEL(S) _____ PROPOSED LOT SIZE _____

AS APPLICANT, I UNDERSTAND THE FOLLOWING: THE SYSTEM INSTALLED SUBSEQUENT TO THIS APPLICATION IS ACCEPTABLE ONLY UNTIL PUBLIC SEWERAGE IS AVAILABLE. THIS APPLICATION IS COMPLETE WHEN ALL APPLICABLE FEES AND A SUITABLE SITE PLAN HAVE BEEN RECEIVED. I ACCEPT THE RESPONSIBILITY FOR COMPLIANCE WITH ALL M.O.S.H.A. AND "MISS UTILITY" REQUIREMENTS. APPROVAL IS BASED UPON SATISFACTORY REVIEW OF A PERC CERTIFICATION PLAN.

TEST RESULTS WILL BE MAILED TO APPLICANT.

SIGNATURE OF APPLICANT _____

HOWARD COUNTY HEALTH DEPARTMENT, BUREAU OF ENVIRONMENTAL HEALTH, WELL AND SEPTIC PROGRAM
3525-H ELLICOTT MILLS DRIVE, ELLICOTT CITY, MARYLAND 21043-4544 (410) 313-1771 FAX (410) 313-2648
TDD (410) 313-2323 TOLL FREE 1-877-4MD-DHMH

Lot 17-34 Area

LOTS 16, 17

929

brown L
yellow or brown
h1 → sl
25% gravel
cw sbk
orange yellow
dsl gr
cw
rock prom
gravel /
cobbles

928


Brown L
orange
h1 → sl
gr / sbk
5% gravel

yellow brown
sg / s
5-10%
cobbles

930

Brown L
red brown
h1 → sl
sbk cw

gray brown
ls
downhill
rock
100%
cobbles

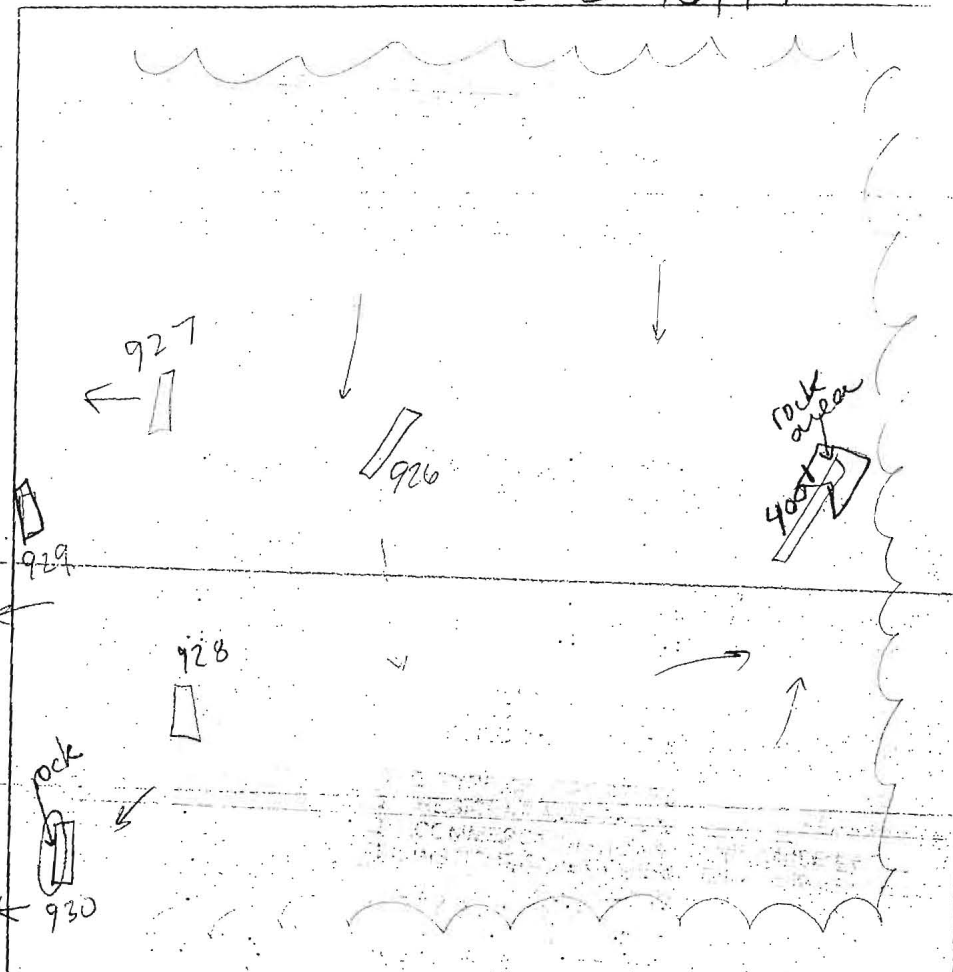

DATE	TEST #	DEPTH	START	BREAK 1" DROP	STOP 2" DROP	TIME OF 2nd INCH	P/F/H
6-28-05	4001	3'10" / 7'7"	2:01:49	2:23	dense soil too slow		F
6-22	926	2'11" / 10'	2:14:24	2:18:13	2:23:54	5'41"	P
	927	5'10" / 11'	2:51:07	2:54:50	2:59:30	4'20"	P
LOTS 16/17	929	4' / 10'	2:25:33	2:34:09	2:45:31	11'22"	P
LOT 17	930	3'3" / 10'	2:30:36	2:40:25	2:56:55	16'30"	P
Middle	928	4' / 9'10"	2:38:16	2:50:30	3:10:33	20'03"	P
	LOT 16						
926	4001-LOT 16						
927							

REMARKS Holes dug per plan - '4001' was field located
 SANITARIAN SF BACKHOE Level Land OTHERS Jeremy Butler / Tim Fragg
 TEST HOLES USED IN SDA _____ AVG. PERC TIME 11.5 SQ. FT/BR
 TRENCH WIDTH _____ INLET DEPTH _____ MAX. BOT DEPTH _____ EFFECTIVE SW _____

AP 4001
Brown L
orange brown
SL gr
CW sbk
5% gravels
yellow brown
SL gr
downhill 25%
cobbles
uphill 10%
cobbles
stone

926

Brown L
brown
hSL sg
10% cobbles
15% gravels
yellow brown
ls sg
10%
chert / coarse
chert

927

Brown L
orange brown
dsl cw
5-10% stone
cobbles
yellow brown
SL sg
5% cobbles
grain

