

C 1: 0974
 THIS NUMBER IS TO BE PUNCHED IN COLUMNS 3-6 ON ALL CARDS

STATE OF MARYLAND
 WATER RESOURCES ADMINISTRATION
 TAMES STATE OFFICE BLDG., ANNAPOLIS, MD. 21401
 WELL COMPLETION REPORT

THIS REPORT MUST BE SUBMITTED WITHIN 30 DAYS AFTER WELL COMPLETION
 FILL IN THIS FORM COMPLETELY
 COUNTY NUMBER

DATE RECEIVED (WRA USE ONLY) 10/10/71 DEPTH OF WELL 185
 DATE WELL COMPLETED 10/10/71 22 (TO NEAREST FOOT) 26
 PERMIT NO. FROM "PERMIT TO DRILL WELL" 41-1-1344
 28 29 30 31 32 33 34 35 36 37
 DRILLER'S IDENTIFICATION NO. 438

OWNER W. J. Jones FIRST NAME W. J.
 LAST NAME Jones
 STREET OR RFD 7700 W. Jones Dr. Rpt H POST OFFICE Shelton Md.

WELL LOG
 STATE THE KIND OF FORMATIONS PENETRATED, THEIR COLOR, DEPTH, THICKNESS AND IF WATER BEARING
 DESCRIPTION (USE ADDITIONAL SHEETS IF NECESSARY) FEET FROM TO CHECK IF WATER BEARING

GROUTING RECORD
 WELL HAS BEEN GROUTED (CIRCLE APPROPRIATE BOX) YES ☒ NO ☐
 TYPE OF GROUTING MATERIAL (CIRCLE BOX) CEMENT ☒ BENTONITE CLAY ☐
 NO. OF BAGS 16 NO. OF POUNDS 1500
 GALLONS OF WATER 16
 DEPTH OF GROUT SEAL (TO NEAREST FOOT) FROM 0 FT. TO 40 FT.
 (ENTER 0 IF FROM SURFACE)

CASING RECORD
 INSERT APPROPRIATE CODE BELOW
 STEEL ☒ CONCRETE ☐
 PLASTIC ☐ OTHER ☐
 MAIN CASING TYPE S NOMINAL DIAMETER OF MAIN CASING (NEAREST INCH) 6 TOTAL DEPTH OF MAIN CASING (NEAREST FOOT) 66
 60 61 62 63 64 65 66 67 68 69 70

OTHER CASING (IF USED)
 DIAMETER (INCH) DEPTH (FEET) FROM TO

SCREEN RECORD
 INSERT APPROPRIATE CODE BELOW
 STEEL ☒ BRASS ☐ OPEN HOLE ☐
 PLASTIC ☐ OTHER ☐

C 2
 1 2 3 (SEQ. NO.) 6
 DEPTH (NEAREST WHOLE FOOT) FROM 64 TO 185
 8 9 10 11 12 13 14 15 16 17 18 19 20 21
 22 23 24 25 26 27 28 29 30 31 32 33 34 35 36 37
 38 39 40 41 42 43 44 45 46 47 48 49 50 51
 BLOT SIZE 1, 2, 3, 99, 100


DIAMETER OF SCREEN 30 (NEAREST INCH) FROM 64 TO 185
 GRAVEL PACK 60
 IF WELL DRILLED WAS A FLOWING WELL CIRCLE BOX ☒
 WRA USE ONLY (NOT TO BE FILLED IN BY DRILLER)
 YES ☐ NO ☐
 TELESCOPE CASING ☐ LOG INDICATOR ☐ OTHER DATA AVAILABLE ☐

C 3
 1 2 3 (SEQ. NO.) 6
 PUMPING TEST
 HOURS PUMPED (TO NEAREST HOUR) 2
 PUMPING RATE (GALLONS PER MINUTE TO NEAREST GALLON) 10
 METHOD USED TO MEASURE PUMPING RATE BU
 WATER LEVEL (DISTANCE FROM LAND SURFACE) BEFORE PUMPING 45 (NEAREST FOOT) 17 20
 WHEN PUMPING 22 (NEAREST FOOT) 22 25
 TYPE OF PUMP USED (CIRCLE APPROPRIATE BOX) (FOR PUMPING TEST)
 AIR ☐ PISTON ☐ TURBINE ☐
 CENTRIFUGAL ☐ ROTARY ☐ OTHER (DESCRIBE BELOW) ☐
 JET ☐ SUBMERSIBLE ☐

PUMP INSTALLED
 TYPE OF PUMP (WRITE APPROPRIATE LETTER IN BOX - SEE ABOVE: A, C, J, P, R, S, T, O)
 DRILLER WILL INSTALL PUMP YES ☐ NO ☐
 CAPACITY: GALLONS PER MINUTE (TO NEAREST GALLON) 31 31 35
 PUMP HORSE POWER 37 37 41
 PUMP COLUMN LENGTH (NEAREST FOOT) 43 43 47
 CASING HEIGHT (CIRCLE APPROPRIATE BOX AND ENTER CASING HEIGHT)
 ABOVE ☐ BELOW ☐ LAND SURFACE 2 (NEAREST FOOT) 49 50 51

LOCATION OF WELL ON LOT
 SHOW PERMANENT STRUCTURE SUCH AS BUILDINGS, SEPTIC TANKS, AND/OR OTHER LAND MARKS AND INDICATE NOT LESS THAN TWO DISTANCES (MEASUREMENTS TO WELL).
 House
 10 ft
 well

CIRCLE APPROPRIATE BOXES
☐ A WELL WAS ABANDONED AND SEALED WHEN THIS WELL WAS COMPLETED
☐ E ELECTRIC LOG OBTAINED
☐ P TEST WELL CONVERTED TO PRODUCTION WELL
 I HEREBY CERTIFY THAT I HAVE COMPLIED WITH ALL CONDITIONS STATED ON THE ABOVE-CAPTIONED "PERMIT TO DRILL WELL", AND THAT INFORMATION CONTAINED IN THIS REPORT IS TRUE, ACCURATE, AND COMPLETE TO THE BEST OF MY KNOWLEDGE, INFORMATION AND BELIEF.
 DRILLER'S NAME Joseph M. Jones
 PLEASE PRINT Joseph M. Jones
 SIGNATURE Joseph M. Jones

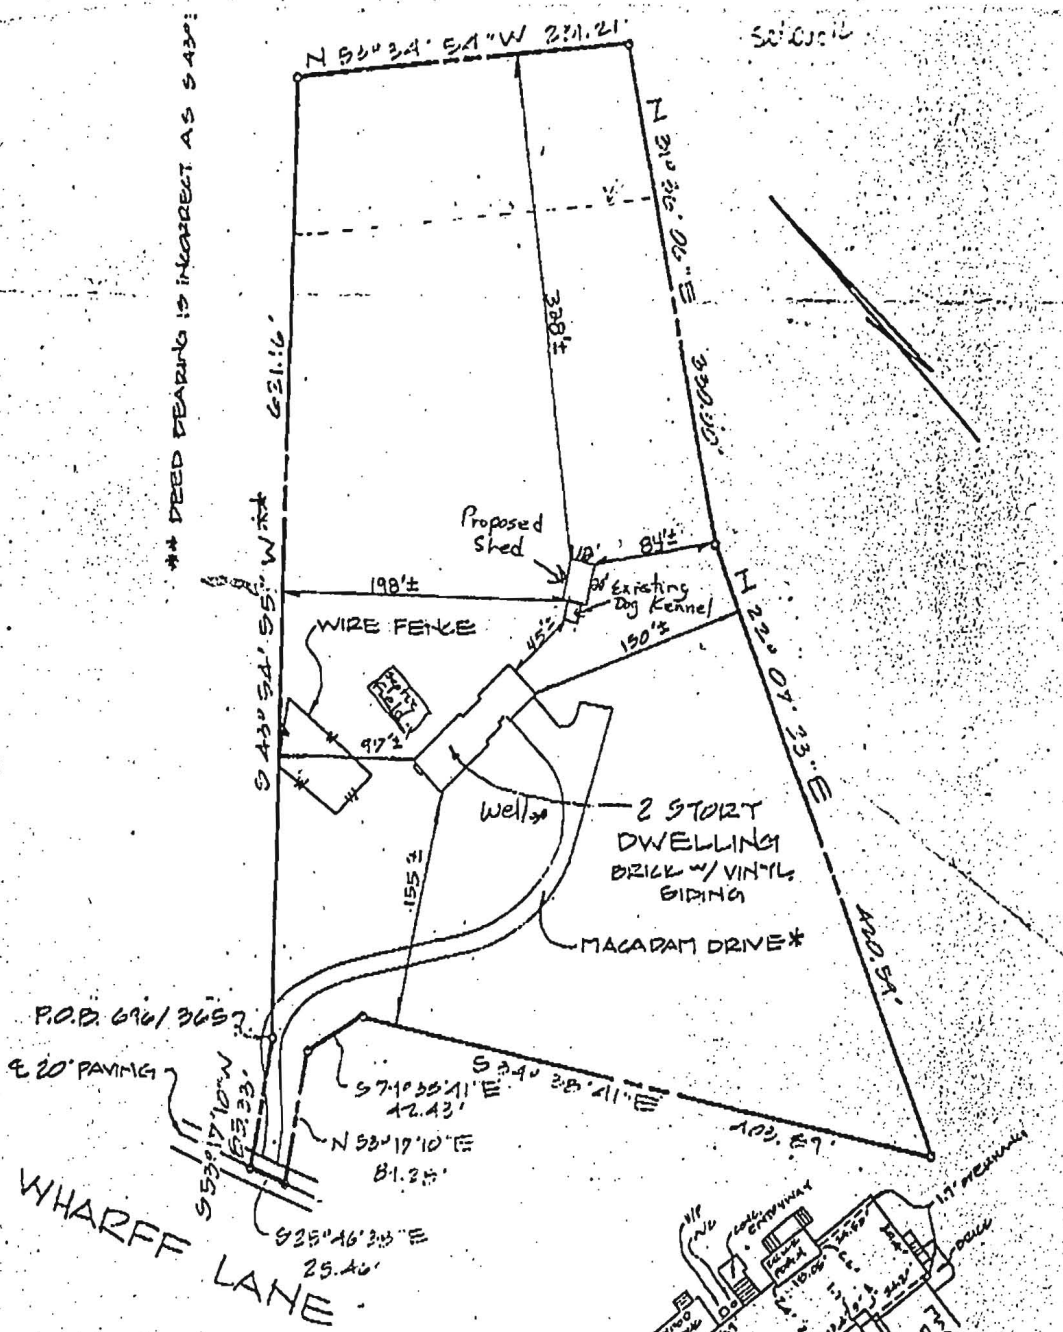


DEED REFERENCE: 696/305
 HOWARD COUNTY, MD

* DRIVEWAY USED IN COMMON w/ LOT ON LEFT SIDE.

Note: The information on this plat shows only that the improvements indicated hereon are contained within the outlines of the lot upon which they were erected, unless otherwise noted, and is not to be used to establish property lines or corners.

I hereby certify that I have examined the current Flood Insurance Rate Map (FIRM Map #) for the subject property and it does not lie in an area identified by the Secretary of Housing and Urban Development as having Special Flood or multiple hazards.

HOUSE
 DETAIL
 1"=50'

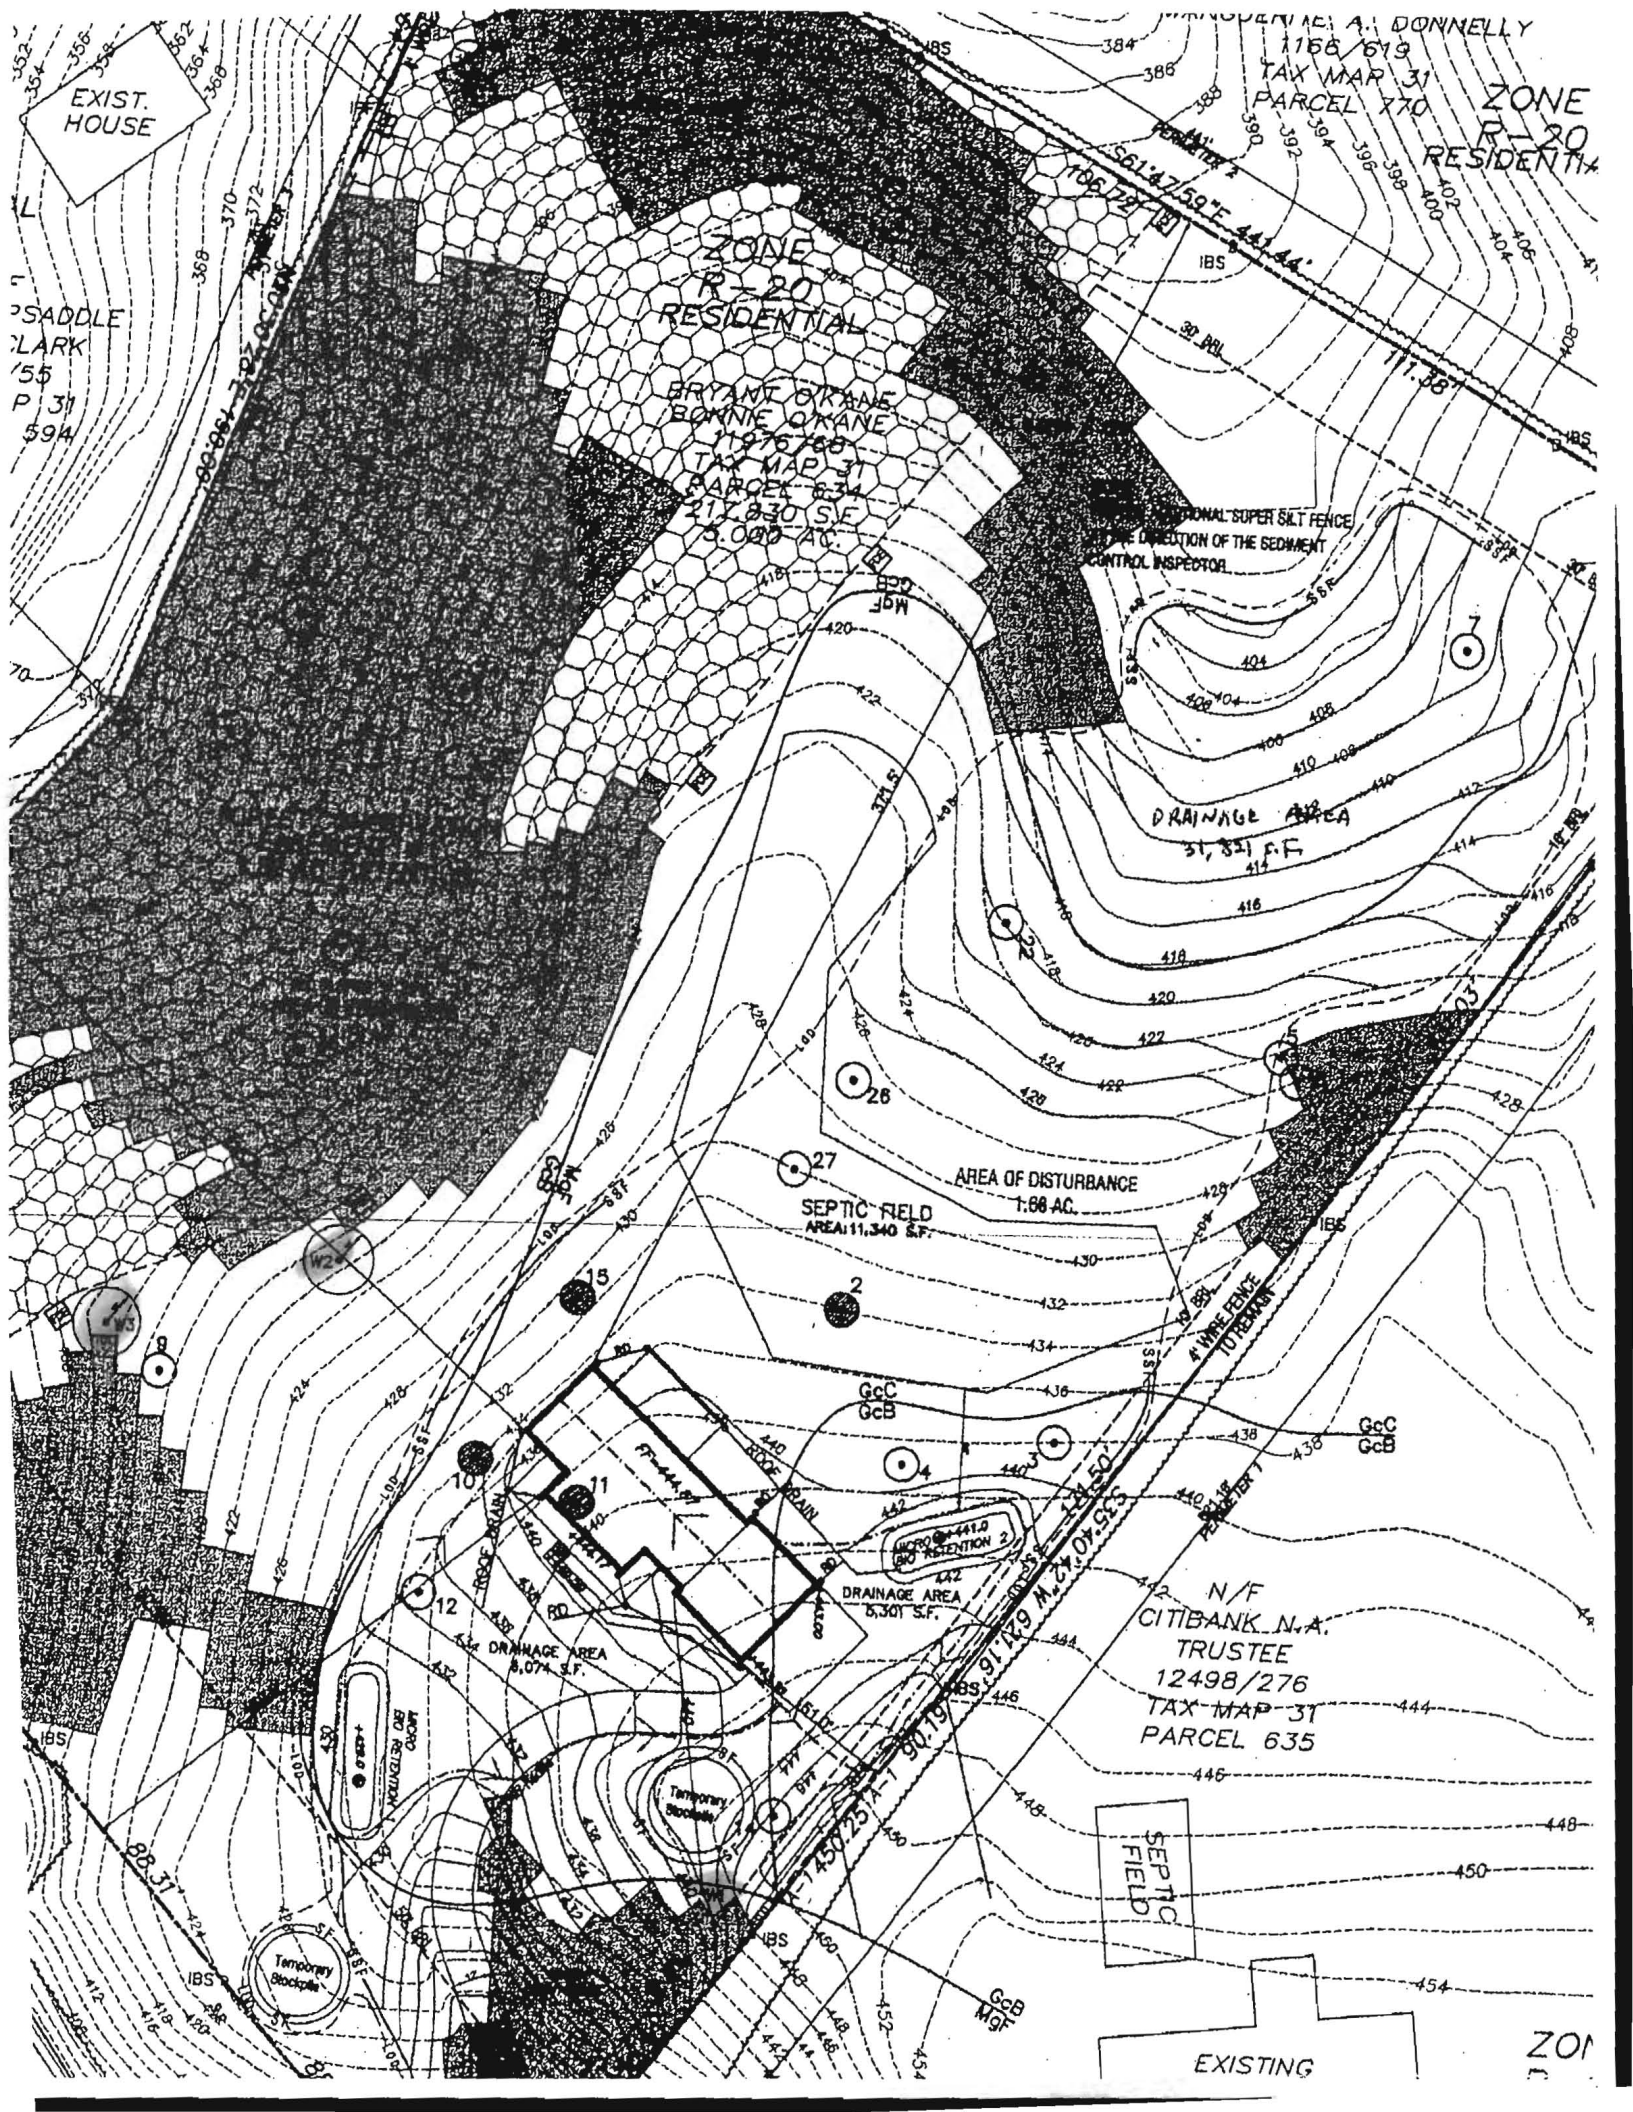

EXIST.
HOUSE

SADDLE
LARK
55
P 31
594

ZONE
R-20
RESIDENTIAL

BRYANT OKANE
BONNIE OKANE
1976788
TAX MAP 31
PARCEL 770
21,830 S.F.
3.000 AC.

1156/619
TAX MAP 31
PARCEL 770
ZONE
R-20
RESIDENTIAL

ADDITIONAL SUPER SALT FENCE
DIRECTION OF THE SEDIMENT
CONTROL INSPECTOR

DRAINAGE AREA
31,831 S.F.

AREA OF DISTURBANCE
1.68 AC.

SEPTIC FIELD
AREA: 11,340 S.F.

DRAINAGE AREA
5,301 S.F.

DRAINAGE AREA
8,074 S.F.

N/F
CITIBANK N.A.
TRUSTEE
12498/276
TAX MAP 31
PARCEL 635

SEPTIC
FIELD

EXISTING

ZON