

Retest

APPLICATION

A 22869

SEWAGE DISPOSAL TESTING.

P _____

STATE OF MARYLAND - DEPARTMENT OF HEALTH AND MENTAL HYGIENE

HOWARD COUNTY HEALTH DEPARTMENT
ENVIRONMENTAL HEALTH SERVICES
P. O. BOX 474, ELLICOTT CITY, MARYLAND 21043
TELEPHONE: 443-5000, EXT. 356
*Locate all lat holes first
prior to test & retest.*

DISTRICT 1st
DATE 2/26/76

7A4-8726

TO: THE COUNTY HEALTH OFFICER
ELLICOTT CITY, MARYLAND

I, HEREBY, APPLY FOR THE NECESSARY TEST IN ORDER TO CONSTRUCT (OR RECONSTRUCT) A SEWAGE DISPOSAL SYSTEM.

PROPERTY OWNER Richard H. Wagener
ADDRESS 7420 Lasada Drive, Apt. 1-A, Baltimore, Md. PHONE 944-9033

PROPERTY LOCATION:

SUBDIVISION _____ LOT NO. Parcel #2

ROAD AND DESCRIPTION Wharff Lane - $\frac{1}{2}$ mile down Wharff Lane on the right - stone driveway
has now been put in to this property - directions given are from off Ilchester Road

SIZE OF LOT 5 acres TYPE BLDG. 3 bedrooms
NUMBER OF BEDROOMS

IF NOT SINGLE RESIDENCE DESCRIBE _____

THE SYSTEM INSTALLED UNDER THIS APPLICATION IS ACCEPTABLE ONLY UNTIL PUBLIC FACILITIES BECOME AVAILABLE.

SIGNATURE OF APPLICANT /s/ Robert H. Wagener

APPROVED BY *David J. O'Neil* FOR *Revised + term* DATE 3-19-76
(KIND OF SYSTEM)


REJECTED BY _____ FOR _____ DATE _____
(KIND OF SYSTEM)

HOLD PENDING FURTHER TESTS _____ DATE _____

REASONS FOR REJECTION OR HOLDING _____

BLDG. PERMIT SIGNED
AND RETURNED 4/13/76

THIS IS NOT A PERMIT

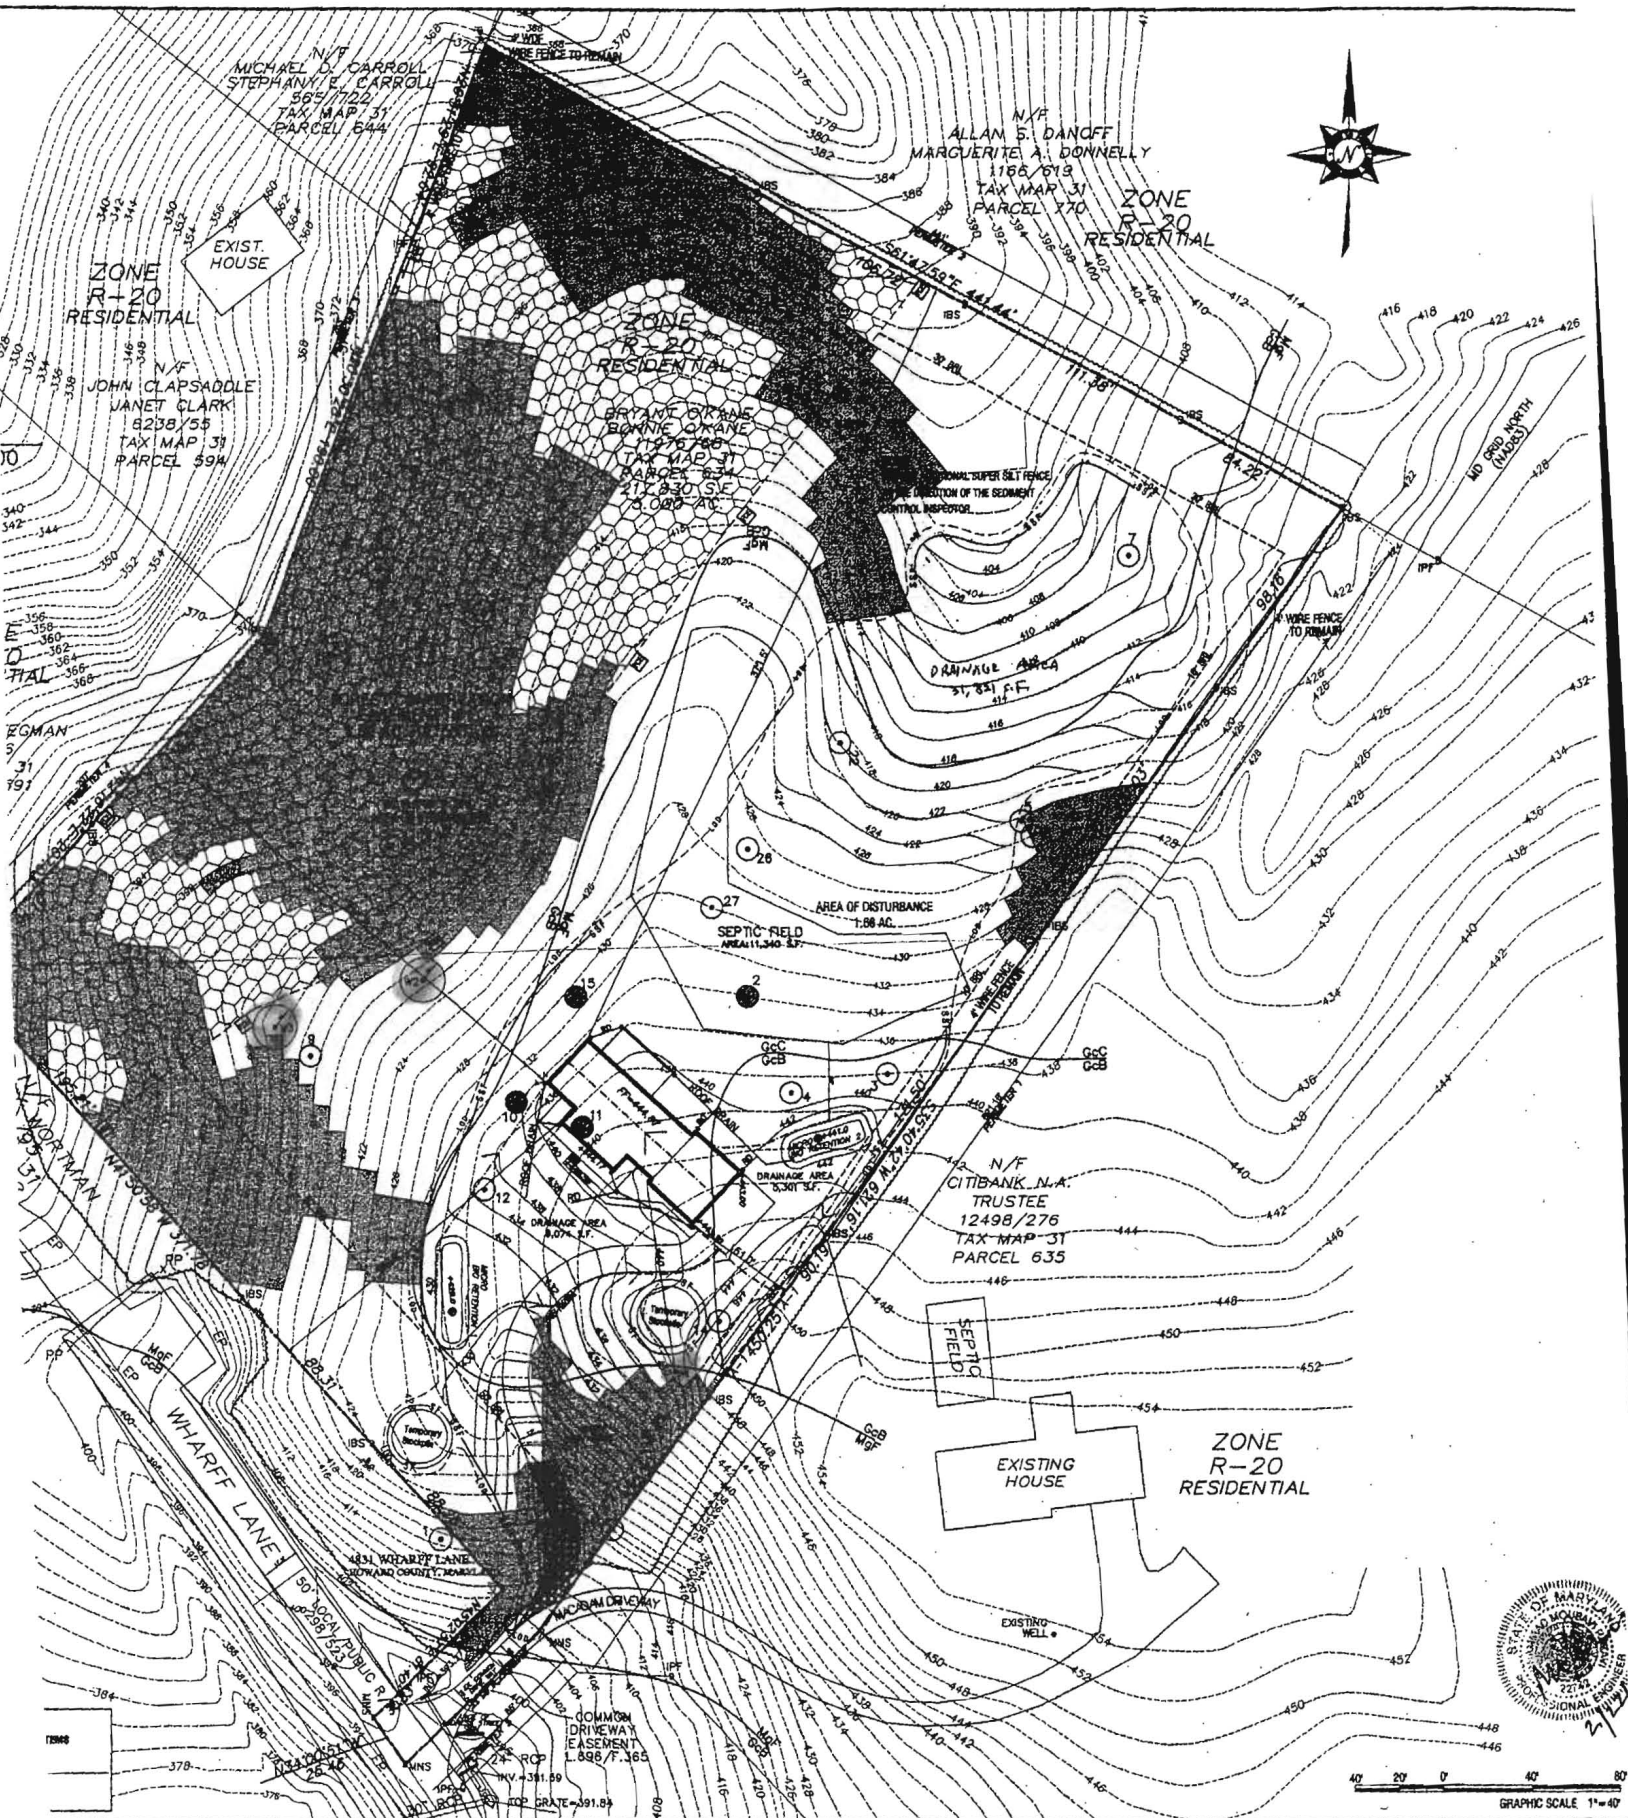

ING AND ZONING

REV#

DATE


OWNER

RAZTEC ASSOCIATES INC



GRAPHIC SCALE 1" = 40'

ALSO PRESENT:

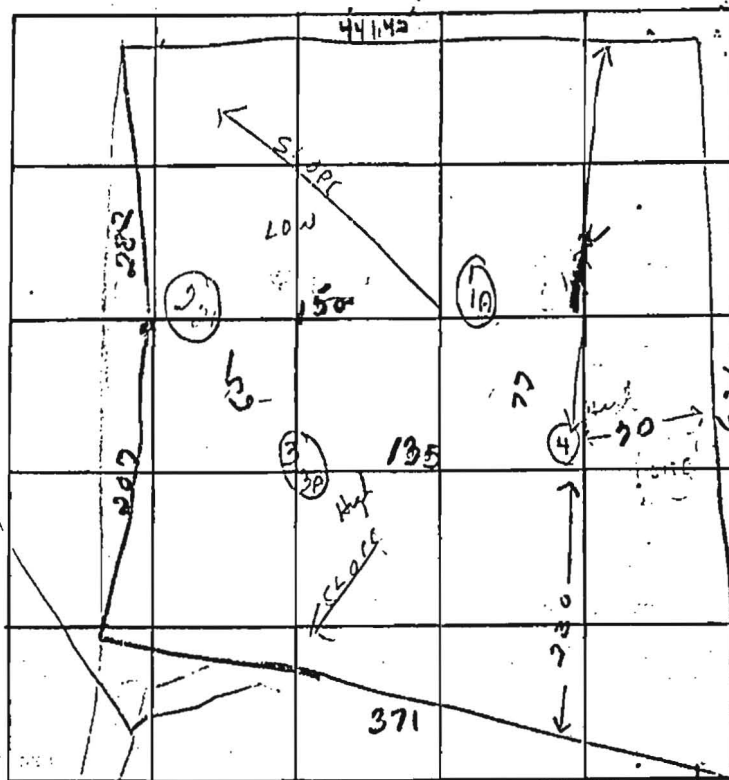

DATE	TEST NO.	DEPTH	FIRE-WET		TEST - 1" DROP		TIME
			START	STOP	START	STOP	
10/74	1	3 1/2 ft	9 55	10 22	10 22	2 mi	8 mi
	1A	12 ft	9 59	10 08	10 08	10 24	1 hr
	2	4 ft	10 30	10 42	10 42	11 05	23 mi
	2A	12 ft	10 35	10 38	10 38	10 44	6 mi
	3	11 ft	10 52	10 56	10 56	11 06	10 mi
	3A	3 1/2 ft	10 47	10 54	10 54	11 09	15 mi
	4	12 ft	See	See	See	See	Other

All measurements taken from
SURVEY PLAT from back 151

REMARKS

TYPE OF SOIL

TESTED BY

ALSO PRESENT:

1158/619
TAX MAP 31
PARCEL 770
DONNELLY
ZONE
R-20
RESIDENTIAL

EXIST. HOUSE
ZONE
R-20
RESIDENTIAL
N/F
JOHN CLAPSADDE
JANET CLARK
6238/55
TAX MAP 31
PARCEL 594

ZONE
R-20
RESIDENTIAL
BRYANT OKANE
BONNIE OKANE
1276/88
TAX MAP 31
PARCEL 634
217,830 S.F.
3.005 AC.

FORMAL SUPER SALT FENCE
DIRECTION OF THE SEDIMENT
CONTROL INSPECTOR

DRAINAGE AREA
51,831 S.F.

AREA OF DISTURBANCE
1.08 AC.

SEPTIC FIELD
AREA 11,340 S.F.

N/F
CITIBANK N.A.
TRUSTEE
12498/276
TAX MAP 31
PARCEL 635

SEPTIC
FIELD

EXISTING
HOUSE

ZONE
R-20
RESIDENTIAL

EXISTING
WELL

COMMON
DRIVEWAY
EASEMENT
1,896 S.F.
0.043 AC.

SYSTEMS