

H0731177

STATE OF MARYLAND WATER RESOURCES ADMINISTRATION
TANES STATE OFFICE, BLDG., ANNAPOLIS, MD. 21401
WELL COMPLETION REPORT

THIS REPORT MUST BE SUBMITTED WITHIN 30 DAYS AFTER WELL COMPLETION
 FILL IN THIS FORM COMPLETELY

SEQUENCE NO. (WPA USE ONLY) **9110**
 COUNTY NUMBER **21290**
 COUNTY NUMBER **21290**

DATE RECEIVED (WPA USE ONLY) **11-2-72**
 DATE WELL COMPLETED **11-2-72**
 DEPTH OF WELL **200**
 PERMIT NO. FROM "PERMIT TO DRILL WELL" **170-13-1111**
 DRILLERS IDENTIFICATION NO. **42**

OWNER **William Edwin**
 STREET OR RFD **410 Box 32**
 POST OFFICE **Baldwin Md.**

WELL LOG

DESCRIPTION (USE ADDITIONAL SHEETS NECESSARY)	FEET FROM	TO	THICKNESS OF WATER BEARING
<i>Topsoil</i>	0	3	
<i>Shales</i>	3	40	
<i>Brown slate</i>	40	70	✓
<i>Mica</i>	70	200	

GROUTING RECORD
 WELL HAS BEEN GROUTED (CIRCLE APPROPRIATE BOX) Y N
 TYPE OF GROUTING MATERIAL (CIRCLE BOX) C M B C
 BENTONITE CLAY 40 40
 NO. OF BAGS **12** NO. OF POUNDS **1200**
 CAPACITY OF WATER **60**
 DEPTH OF GROUT SEAL (TO NEAREST FOOT) FROM **0** FT. TO **40** FT.
 (ENTER 0 IF FROM SURFACE)

CASING RECORD
 TYPE OF CASING (CIRCLE APPROPRIATE BOX) S T C O
 STEEL CONCRETE
 PLASTIC OTHER
 NOMINAL DIAMETER (INCH) **6** TOTAL DEPTH OF MAIN CASING (NEAREST FEET) **48**
 (ENTER 0 IF FROM SURFACE)

OTHER CASING (IF USED)
 DIAMETER (INCH) DEPTH (FEET) FROM TO

SCREEN RECORD
 SCREEN TYPE (CIRCLE APPROPRIATE BOX) S T B R M O
 STEEL BRASS OPEN HOLE ON GROUND
 PLASTIC OTHER
 DEPTH (NEAREST WHOLE FOOT) FROM **40** TO **200**

SCREENING RECORD
 DEPTH (NEAREST WHOLE FOOT) FROM TO
 21 24 26 30 32 36
 38 39 41 45 47 51
 SLOTS: 1, 2, 3, 99, 100

PUMPING TEST
 HOURS PUMPED (TO NEAREST HOUR) **2**
 PUMPING RATE (GALLONS PER MINUTE TO NEAREST GALLON) **2**
 METHOD USED TO MEASURE PUMPING RATE **bucket**
 WATER LEVEL (DISTANCE FROM LAND SURFACE) BEFORE PUMPING **40**
 WHEN PUMPING **200** (NEAREST FOOT)
 TYPE OF PUMP USED (CIRCLE APPROPRIATE BOX) (USE PUMPING TEST)
 A AIR P PISTON T TURRINE
 C CENTRIFUGAL R ROTARY O OTHER (DESCRIBE BELOW)
 J JET S SUBMERSIBLE

PUMP INSTALLED
 TYPE OF PUMP (WRITE APPROPRIATE LETTER IN BOX - SEE ABOVE) A, C, J, P, R, S, T, O
 DRILLER WILL INSTALL PUMP (CIRCLE APPROPRIATE BOX) Y N
 CAPACITY: GALLONS PER MINUTE (TO NEAREST GALLON) **31** **36**
 PUMP HORSE POWER **37** **41**
 PUMP COLUMN LENGTH (NEAREST FOOT) **43** **47**

CASING HEIGHT (CIRCLE APPROPRIATE BOX AND ENTER CASING HEIGHT)
 ABOVE LAND SURFACE (NEAREST FOOT) **20**
 BELOW **49** **51**

LOCATION OF WELL ON LOT
 SHOW PERMANENT STRUCTURE SUCH AS BUILDINGS, SEPTIC TANKS, AND/OR OTHER LAND MARKS AND INDICATE NOT LESS THAN TWO DISTANCES (MEASUREMENTS TO WELL).
 House
 20
 45' to well
 70'


CIRCLE APPROPRIATE BOXES
 A WELL WAS ABANDONED AND SEALED WHEN THIS WELL WAS COMPLETED
 E ELECTRIC LOG OBTAINED
 P TEST WELL CONVERTED TO PRODUCTION WELL

I HEREBY CERTIFY THAT I HAVE COMPLIED WITH ALL CONDITIONS STATED ON THE ABOVE-CAPTIONED "PERMIT TO DRILL WELL", AND THAT INFORMATION CONTAINED IN THIS REPORT IS TRUE, ACCURATE, AND COMPLETE TO THE BEST OF MY KNOWLEDGE, INFORMATION AND BELIEF.

DRILLER'S NAME **L.F. Easterday**
 PLEASE PRINT **L.F. Easterday**
 SIGNATURE **L.F. Easterday**

LOG INDICATOR 72 74 75 76
 OTHER DATA AVAILABLE

HEALTH

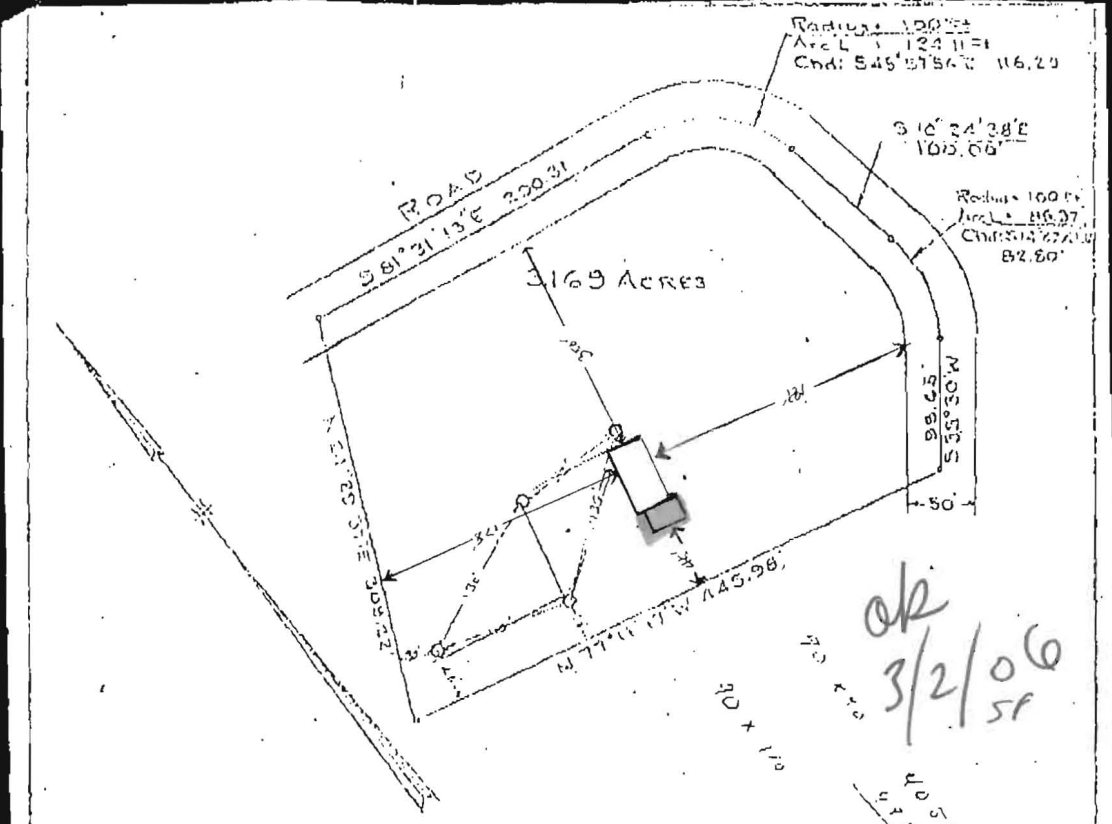

PLAT FROM DEED,
OF
LOT NO. 26 SECTION ONE
FOX HAVEN
FIFTH ELECTION DIST. HOWARD COUNTY,
HIGHLAND, MARYLAND
SCALE: 1 IN. = 100 FT. MARCH 14, 1975


PERMIT # 300157922
2nd floor addition over garage

The lot shown herein complies with the
zoning ordinance and lot area as required
by the Department of Health Department

[Handwritten signature]



[Handwritten signature]
A 5867

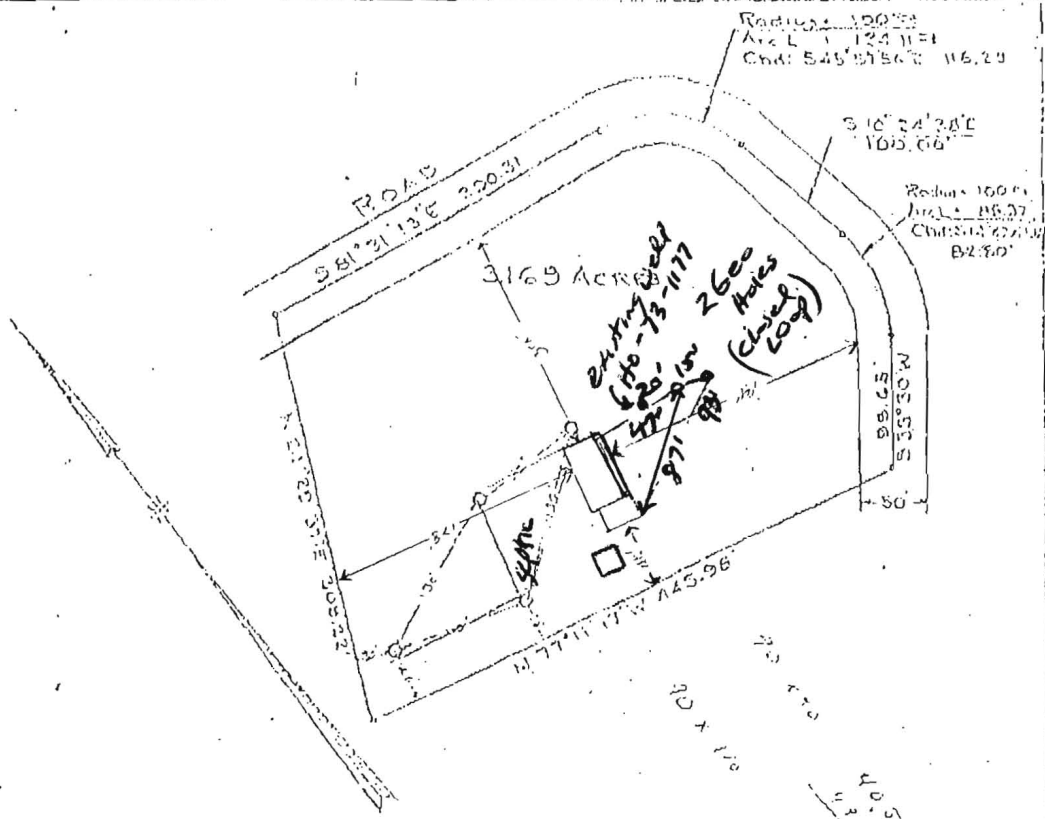

PLAT FROM DEED
OF
LOT NO. 26 SECTION ONE
FOX HAVEN
FIFTH ELECTION DIST. HOWARD COUNTY,
HIGHLAND, MARYLAND
SCALE: 1 IN. = 100 FT. MARCH 14, 1975

Owner: Ryan Roth
14215 Clarksville Pike
Highland MD 20777

1. This lot always has been occupied with the
minimum structure and lot area as required
by the Maryland State Health Department
at the time of its construction.



Count in Party
A 3861

[Handwritten signature]
4/1/75

HO-73-1177

Existing Well