

C10368

SEQUENCE NO.
(MDE USE ONLY)

STATE OF MARYLAND
WELL COMPLETION REPORT
FILL IN THIS FORM COMPLETELY
PLEASE TYPE

THIS REPORT MUST BE SUBMITTED WITHIN
45 DAYS AFTER WELL IS COMPLETED.

COUNTY
NUMBER

13A515042

1236

(THIS NUMBER IS TO BE PUNCHED
IN COLS. 3-6 ON ALL CARDS)

ST/CO USE ONLY
DATE Received
MM DD YY

DATE WELL COMPLETED
MM DD YY

Depth of Well
22 200 26 9/13/06
(TO NEAREST FOOT)

PERMIT NO.
FROM "PERMIT TO DRILL WELL"

40-95-0352

OWNER

1011 Brothers

STREET OR RFD

Valley View Overlook

TOWN

Ellicott City

SUBDIVISION

Benedict Farm

SECTION

LOT

33

WELL LOG

Not required for driven wells

STATE THE KIND OF FORMATIONS PENETRATED, THEIR
COLOR, DEPTH, THICKNESS AND IF WATER BEARING

DESCRIPTION (Use additional sheets if needed)	FEET		check if water bearing
	FROM	TO	
Brown Shale	0	25	
Gray Limestone	25	200	✓

GROUTING RECORD

yes no

WELL HAS BEEN GROUTED
(Circle Appropriate Box)

Y N

TYPE OF GROUTING MATERIAL (Circle one)

CEMENT CM BENTONITE CLAY BC

NO. OF BAGS 10 NO. OF POUNDS 940

GALLONS OF WATER 60

DEPTH OF GROUT SEAL (to nearest foot)

from 0 ft. to 27 ft.

(enter 0 if from surface)

CASING RECORD

casing
types
insert
appropriate
code
below

ST CO
STEEL CONCRETE

PL OT
PLASTIC OTHER

MAIN
CASING
TYPE

Nominal diameter
top (main) casing
(nearest inch)

Total depth
of main casing
(nearest foot)

PL 06 30

OTHER CASING (if used)

diameter depth (feet)

inch from to

SCREEN RECORD

screen type
or open hole

insert
appropriate
code
below

ST BR HO
STEEL BRASS OPEN
HOLE

PL OT
PLASTIC OTHER

DEPTH (nearest ft.)

1 2

1 2 3 76

1 2 3 76

1 2 3 76

NUMBER OF UNSUCCESSFUL WELLS:

0

WELL HYDROFRACTURED

yes no

Y N

CIRCLE APPROPRIATE LETTER

A A WELL WAS ABANDONED AND SEALED
WHEN THIS WELL WAS COMPLETED

E ELECTRIC LOG OBTAINED

P TEST WELL CONVERTED TO PRODUCTION
WELL

I HEREBY CERTIFY THAT THIS WELL HAS BEEN CONSTRUCTED IN
ACCORDANCE WITH COMAR 26.04.04 "WELL CONSTRUCTION" AND
IN CONFORMANCE WITH ALL CONDITIONS STATED IN THE ABOVE
CAPTIONED PERMIT, AND THAT THE INFORMATION PRESENTED
HEREIN IS ACCURATE AND COMPLETE TO THE BEST OF MY
KNOWLEDGE.

DRILLERS LIC. NO. 1 MSD 007

DRILLERS SIGNATURE

(MUST MATCH SIGNATURE ON APPLICATION)

LIC. NO. 1 D

SITE SUPERVISOR (sign. of driller or journeyman
responsible for sitework if different from permittee)

GRAVEL PACK
IF WELL DRILLED
WAS FLOWING WELL
INSERT F IN BOX 68

68

MDE USE ONLY
(NOT TO BE FILLED IN BY DRILLER)

T (E.R.O.S.) W Q

70 72 74 75 76

TELESCOPE LOG OTHER DATA
CASING INDICATOR

PUMPING TEST

HOURS PUMPED (nearest hour)

03

PUMPING RATE (gal. per min.)

6

METHOD USED TO
MEASURE PUMPING RATE

1 gal

WATER LEVEL (distance from land surface)

BEFORE PUMPING

25 ft.

WHEN PUMPING

63 ft.

TYPE OF PUMP USED (for test)

A air P piston T turbine

C centrifugal R rotary O other (describe below)

J jet S submersible

PUMP INSTALLED

DRILLER INSTALLED PUMP
(CIRCLE) (YES or NO)

YES NO

IF DRILLER INSTALLS PUMP, THIS SECTION
MUST BE COMPLETED FOR ALL WELLS.

TYPE OF PUMP INSTALLED
PLACE (A,C,J,P,R,S,T,O)
IN BOX 29

CAPACITY:
GALLONS PER MINUTE
(to nearest gallon)

31 35

PUMP HORSE POWER

37 41

PUMP COLUMN LENGTH
(nearest ft.)

43 47

CASING HEIGHT (circle appropriate box
and enter casing height)

above below

LAND SURFACE

02 (nearest foot)

LOCATION OF WELL ON LOT

SHOW PERMANENT STRUCTURE SUCH AS
BUILDING, SEPTIC TANKS, AND /OR
LANDMARKS AND INDICATE NOT LESS
THAN TWO DISTANCES
(MEASUREMENTS TO WELL)

B 1	8986	SEQUENCE NO. (MDE USE ONLY)	STATE OF MARYLAND PERMIT TO DRILL WELL 524 370 please print or type	STATE PERMIT NUMBER H0-95-0352 fill in this form completely
Date Received (APA) 3-24-06		OWNER INFORMATION		
8 MM DD YY 13		15 Last Name First Name 34		
14329 Triadelphia Rd		36 Street or RFD 55		
Glenelg Md 21737		57 Town 70 State 72 Zip 76		
DRILLER INFORMATION				
Allen Compton		MSD 009		
Driller's Name		76 License No. 81		
Fogle's Well Drilling		Firm Name		
580 Obrecht Rd		Address		
Allen Compton		3-24-06		
Signature		Date		
B 2	WELL INFORMATION		APPROX. PUMPING RATE	
1 2	APPROX. PUMPING RATE (GAL. PER MIN.)		8 12	
AVERAGE DAILY QUANTITY NEEDED (GAL. PER DAY)		14 20		
USE FOR WATER (CIRCLE APPROPRIATE BOX)				
<input checked="" type="checkbox"/> DOMESTIC POTABLE SUPPLY & RESIDENTIAL IRRIGATION <input type="checkbox"/> FARMING (LIVESTOCK WATERING & AGRICULTURAL IRRIGATION) <input type="checkbox"/> INDUSTRIAL, COMMERCIAL, DEWATERING <input type="checkbox"/> PUBLIC WATER SUPPLY WELL <input type="checkbox"/> TEST, OBSERVATION, MONITORING <input type="checkbox"/> GEO-THERMAL				
NOT TO BE FILLED IN BY DRILLER HEALTH DEPARTMENT APPROVAL				
Howard 13 A515042				
COUNTY NAME COUNTY NO.				
STATE SIGNATURE INSERT S → 41				
DATE ISSUED 4/5/2006 Brian Baber 4/5/2007				
43 MM DD YY 48 CO SIGNATURE EXP. DATE				
NORTH GRID 511 0 0 0 EAST GRID 826 0 0 0				
50 55 57 63				
APPROXIMATE DEPTH OF WELL 300 FEET				
24 28				
APPROXIMATE DIAMETER OF WELL 6 INCH				
METHOD OF DRILLING (circle one)				
BORED (or Augered) JETTED Jetted & DRIVEN				
30 AIR-ROTary AIR-PERCussion ROTARY (Hydraulic Rotary)				
37 CABLE REVERSE-ROTary DRIVE-POINT				
other				
REPLACEMENT OR DEEPEMED WELLS (CIRCLE APPROPRIATE BOX)				
<input checked="" type="checkbox"/> THIS WELL WILL NOT REPLACE AN EXISTING WELL <input type="checkbox"/> THIS WELL WILL REPLACE A WELL THAT WILL BE ABANDONED AND SEALED <input type="checkbox"/> THIS WELL WILL REPLACE A WELL THAT WILL BE USED AS A STANDBY-CONTACT LOCAL APPROVING AUTHORITY FOR POLICY ON STANDBY WELLS <input type="checkbox"/> THIS WELL WILL DEEPEN AN EXISTING WELL				
PERMIT NUMBER OF WELL TO BE REPLACED OR DEEPEMED (IF AVAILABLE) 41 52				
Not to be filled in by driller (MDE OR COUNTY USE ONLY)				
APPROP. PERMIT NUMBER H0 2003G 006				
PERMIT No. H0-95-0352				
70 71 72 73 74 75 76 77 78 79				
SPECIAL CONDITIONS Water Sample Must Be Taken During Yield Test				
NOTE - APPROVING AUTHORITIES SHOULD USE PERMIT NUMBER IF NEEDED				

**HOWARD COUNTY HEALTH DEPARTMENT
BUREAU OF ENVIRONMENTAL HEALTH
WATER AND SEWERAGE PROGRAM
TEL: (410)313-2640 FAX: (410)313-2648**

Information Form for the Installation of the Well Pump, Pitless Adapter, and Supply Piping

NOTE: The installer is responsible for requesting an inspection prior to 9 am on the day of the desired inspection. No work is to be covered until approved by the Health Department. All installations must comply with the National Standard Plumbing Code (NSPC, as amended locally) and COMAR 26.04.04 (MD Well Construction Regulations). Submission of a complete form is required prior to Use and Occupancy approval.

Company Name: Fogles well Drilling Telephone #: 410-795-5670
Address: 580 coburn rd
Sykesville, Md 21784

(Must circle one) Licensed Plumber Licensed Well Driller Licensed Well Pump Installer

License # and name of individual responsible for the field installation:

Name (Print): Allen Compton License# MSD 009

*A licensed individual must perform the actual installation. Apprentices must be under the direct supervision of a licensed journeyman or master plumber, pump installer or well driller. Licenses may be subjected to field verification.

Name of Property Owner: Toll Brothers Telephone #: 410-489-6292
Subdivision: Paluxant Chase Lot #: 33 Well Tag #: HO-45-0352
Site Address: 4935 Valley View Overlook

Submersible Pump Data

Make: Cummins
Model #: 155GE07C180
Pump Capacity 15 GPM
Well Yield: 6 GPM

Pitless Adapter

Make: Cummins
Model #: NA
Depth: 36 (36" min)
NSF approved: YES

Well Cap and Electric Conduit

Two piece watertight cap: YES
Screened, vented well cap: YES
Cap secured to casing: YES
Conduit min 18" B.G.: YES
Conduit secured to well cap: YES

Depth of well encountered at time of pump installation: 200 (feet)
If pump capacity exceeds well yield, a low water cut off switch is required by NSPC 1990 Section 17.8.4
Torque arrestors or Cable guards are required - Must circle one
Safety rope, if used, attached to inside of well casing with eye bolt NA

Piping to house

Type: 1" Black Plastic
PSI: 160 (160 psi min)
Depth of supply line: 42 (36" min)

House Connection

PVC sleeved to undisturbed soil at wall penetration: YES
Approximate length of sleeve: 5
Sleeve caulked and sealed properly: YES


The water supply line is required to be at least ten feet from the septic tank, pump chamber, sewage piping, distribution box, drainfields, and sewage reserve area. If this cannot be accomplished, contact this office for approval prior to installation.

Signature of company representative responsible for installation: Allen Compton

date: 3/20/07

For Health Department Use Only - Not to be completed by Installer

Date Insp. Requested: _____ Date Insp. Approved: 12/18/06 KW
Inspection Data: Pitless adapter and water supply line at least 36" below grade ☒
Two piece cap installed and attached to casing securely ☒
Elec. conduit extends at least 18" below grade/attached to cap properly ☒
Safety rope installed inside of well casing ☒
Correct well tag attached properly and casing 8" above finished grade ☒
Water supply line sleeved adequately at house connection ☒
Adequate grout observed below pitless adapter ☒

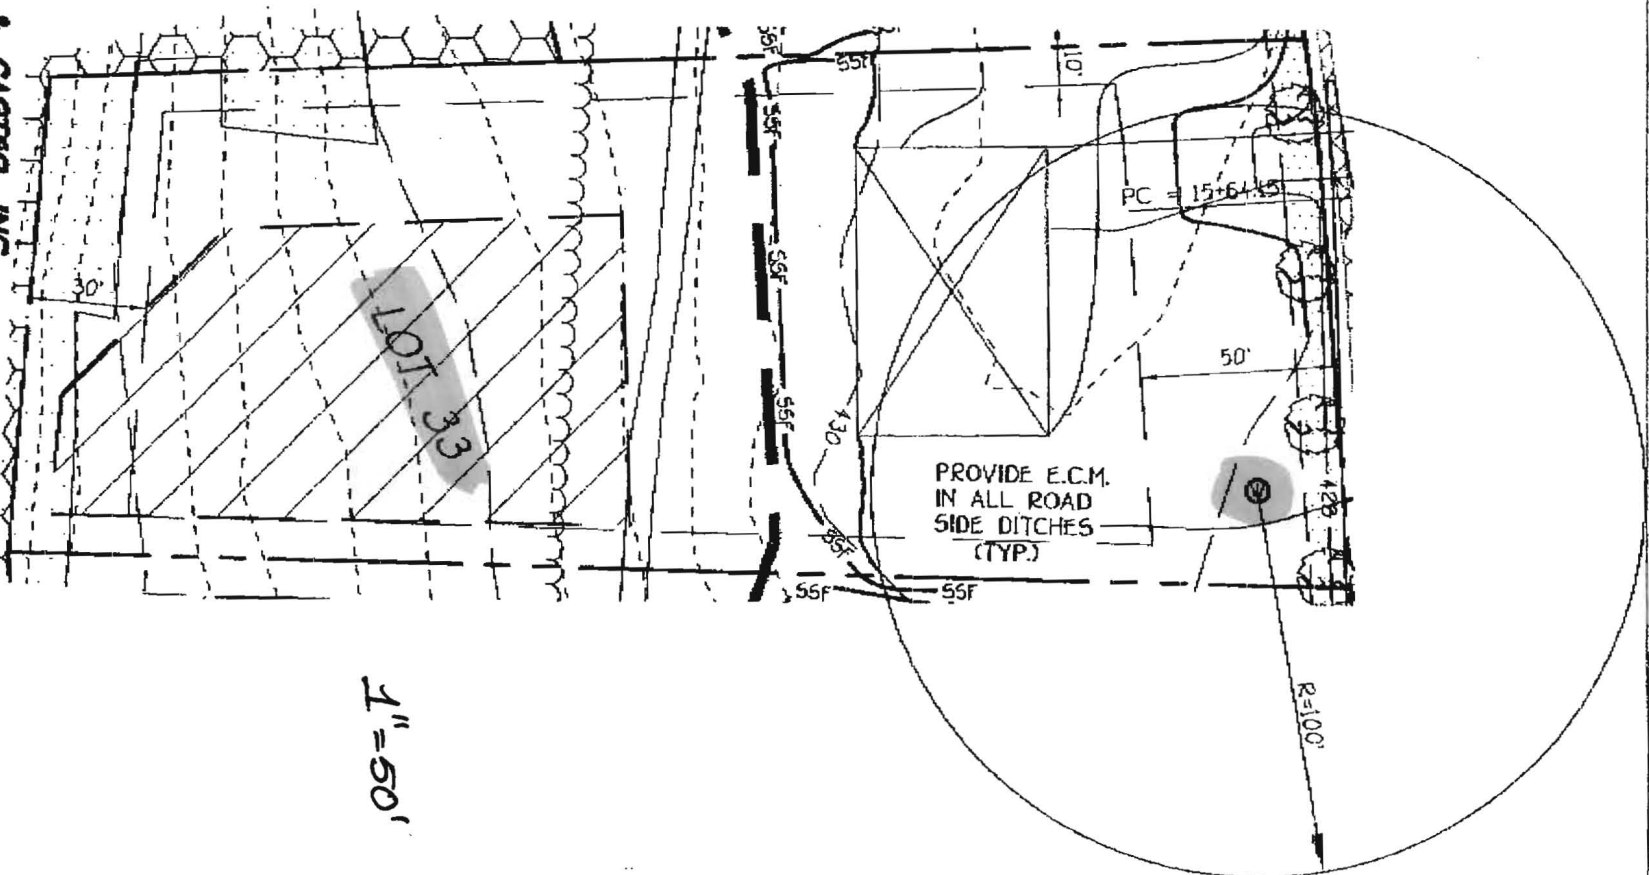

3/30/06
Well Site
to Be
Staked
By F.C.C.
BB

FISHER, COLLINS & CARTER, INC.
CIVIL ENGINEERING CONSULTANTS & LAND SURVEYORS

CENTENNIAL SQUARE OFFICE PARK - 10272 BALTIMORE NATIONAL PIKE
ELLCOTT CITY, MARYLAND 21042
(410) 461 - 2055

WELL LOCATION PLAN
LOT-33

ZONED RC-DEO
TAX MAP No. 29 GRID No. 9 PARCEL No. 28
THIRD ELECTION DISTRICT HOWARD COUNTY, MARYLAND
SCALE 1" = 50' DATE: FEBRUARY 16, 2006



Bureau of Environmental Health
7178 Gateway Drive Columbia, MD 21046
(410) 313-2640 Fax (410) 313-2648
TDD (410) 313-2323 Toll Free 1-866-313-6300
website: www.hchealth.org

Peter L. Beilenson, M.D., M.P.H., Health Officer

April 12, 2007

Toll MD III LP
7164 Columbia Gateway Drive, #230
Columbia, MD 21046

RE: Homewood Crossing, Lot 33
4935 Valley View Overlook
Ellicott City, MD 21042
BP #: B06000887
Well Permit # HO-95-0352

Dear Sir:

This is to advise you that the septic system for the above referenced property has been installed and inspected. Final approval of the septic system was granted on 01/16/2007. Final approval of the well line connection to the dwelling was approved on 12/18/2006.

The water sample results indicate that the water samples submitted for testing were free of coliform and fecal coliform bacteria at the time of sampling and are bacteriologically safe for drinking. The water sample results were found to be in compliance with COMAR water quality standards.

Also, a Gross Alpha and Beta sample was collected on 08/07/2006. Both findings were below the maximum limit suggested by the EPA. At the time of the testing and with respect to these parameters, the future well water supply appears safe for all uses. No additional testing for these parameters will be required to secure the future Use and Occupancy.


INTERIM CERTIFICATE OF POTABILITY

This certifies that the initial sampling requirements of COMAR 26.04.04 "Well Regulations" have been met for the water supply system installed under well permit #HO-95-0352. Although the submitted sample results are in compliance with COMAR standards, the Health Department does not guarantee water supplies. Based upon satisfactory investigation and evaluation, the Howard County Health Department as authorized by the Maryland Department of the Environment accepts this well system as required by COMAR 26.04.04.

This certificate may become final upon completion of the second bacteriological test, which is to be taken by the county health department within six months of receipt of this letter. Please contact (410) 313-1773 to schedule a final water sample appointment. Currently, there is no charge for this final sampling.

Date of Water Samples: 04/09/2007 & 08/07/2006 (Radium)
Date of Well Completion: 08/07/2006

Approving Authority,

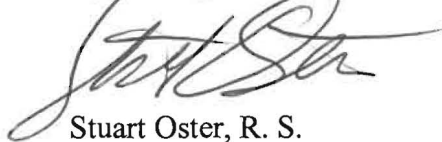A handwritten signature in black ink, appearing to read "Stuart Oster", is written over the printed name.

Stuart Oster, R. S.
Well & Septic Program

cc: Building Inspector's Office
Community Health Services
File

301 - 252 6546

Fadoul

FOUNTAIN VALLEY ANALYTICAL LABORATORY, INC.

1413 Old Taneytown Rd. Westminster, MD (410) 848-1014 (410) 876-4554 FAX (410) 848-0298

REPORT OF ANALYSIS

Laboratory ID #: 62687	Account #: 1930
Reference: Toll Brothers Lot 33	Company: Fogle's Well Drilling
Location: 4935 Valley View Overlook	Requested By: Dave Fogle
Ellicott City, MD 21042	Source: Well Water
Date/Time Collected: 4/9/2007 0900	Site: Kitchen Sink Tap
Date/Time Rec'd: 4/9/2007 1055	Treatment: None
Chlorine ppm: Free: ND Total: ND	pH: 6.7
Collected By: V.M. Fadoul 6804VF-FS	Well #: HO-95-0352


PARAMETERS	RESULTS	UNITS	REFERENCE	METHOD	DATE/TIME/ANALYST
Bacteria, Coliform, Total, MPN	<1.0	MPN/ 100 ml	<1.0	SM18 9223 B.	4/10/2007 / 0830 / AD/BD
Bacteria, E. coli, MPN	<1.0	MPN/ 100 ml	<1.0	SM18 9223 B.	4/10/2007 / 0830 / AD/BD
Nitrate	1.24	mg/L	10	601	4/9/2007 / 1430 / AD/BD
Turbidity	0.84	NTU	<10	SM18 2130B	4/9/2007 / 1500 / AD/BD
Sand	NS	mg/L	5	Visual/Gravimet	4/9/2007 / 1500 / AD/BD

NOTES

- 1 mg/L = milligrams per liter (also, parts per million)
- 2 MPN/ 100 ml = Most Probable Number [of viable bacteria] per 100 ml of sample.
- 3 NS = None Seen (NS indicates less than 5 mg/L)
- 4 NTU = Nephelometric Turbidity Units
- 5 Results less than or within the reference range are considered satisfactory and within potable water limits at the time of sampling.
- 6 ND:None Detected
- 7 Sample collected by client, analyzed as received
- 8 pH tested on-site

Reason for Test : Use & Occupancy
Building Permit # : B06000887

Date Reported: 4/10/2007

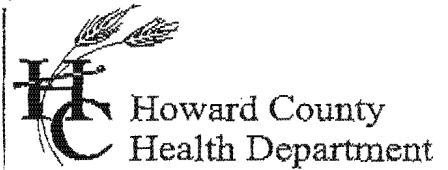

Bureau of Environmental Health
7178 Columbia Gateway Drive, Columbia, MD 21046
(410) 313-2640 Fax (410) 313-2648
TDD (410) 313-2323 Toll Free 1-866-313-6300
website: www.hchealth.org

Penny E. Borenstein, M.D., M.P.H., Health Officer

August 31, 2006

Toll Brothers - Maryland Division
7164 Columbia Gateway Drive
Columbia, Maryland 21046


RE: Benedict Farm Subdivision, Lot 33
Well Tag: HO-95-0352

To Whom It May Concern:

A sample was collected during a yield test on August 7, 2006 and submitted to the Department of Health & Mental Hygiene Laboratories to assess the possible presence of Gross Alpha and Gross Beta in the future well water supply. Gross Alpha and Gross Beta measure the total alpha and beta particle activity in a water supply. These naturally occurring radioactive nuclides have been demonstrated to be present in a certain type of geologic formation known as the Baltimore Gneiss which exists in your area of development within the County.

Results from this screening revealed a Gross Alpha of 2.0 ± 1.0 picocuries/liter (pCi/L); while the Gross Beta level was 3.0 ± 2.0 pCi/L. The Gross Alpha result was below its maximum contaminant level (MCL) of 15 pCi/L, while the Gross Beta level was below its target value of 50 pCi/L (roughly equivalent to the annual dose rate of 4 millirems/year). At the time of testing and with respect to these parameters, the future well water supply appears safe for all uses. No additional testing for these parameters will be required to secure the future Use & Occupancy. However, other standard (potability) testing will still be necessary.

A copy of the test results is enclosed for your information. Please call this office at 410-313-1773 if you have any further questions or concerns.

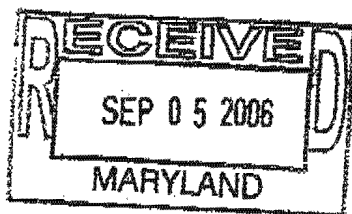

Sincerely,

Bert Nixon

Bert Nixon, Deputy Director
Bureau of Environmental Health

cc: Eric Dougherty, MDE Water Mgmt., Groundwater
Well & Septic property file