

PUB. SEWER STATUS VERIFIED BY _____

ISSUE DATE: _____

PERMIT

P 530256

APPROVAL DATE: _____

A REPAIR

Tax ID # 03-283305

**MINOR REPAIR AND MOVE SEPTIC TANK
ON-SITE SEWAGE DISPOSAL SYSTEM
HOWARD COUNTY HEALTH DEPARTMENT
BUREAU OF ENVIRONMENTAL HEALTH**

Fogles Septic Clean, Inc IS PERMITTED TO INSTALL ALTER

ADDRESS: 580 Obrecht Road, Sykesville PHONE NUMBER: 410-795-5670

SUBDIVISION: King's Gift LOT NUMBER: 55

ADDRESS: 11674 Frederick Road PROPERTY OWNER: Joseph Anderson

SEPTIC TANK CAPACITY (GALLONS): _____

PUMP CHAMBER CAPACITY (GALLONS): _____

NUMBER OF BEDROOMS: _____

SQUARE FEET PER BEDROOM: _____

LINEAR FEET OF TRENCH REQUIRED: _____

TRENCHES:	
LOCATION:	In support of building permit, B00148376, existing septic tank is to be moved and a Minor Repair done.
ADDITIONAL NOTES:	


PLANS APPROVED: _____ DATE: _____

- NOTE: PERMIT VOID AFTER 2 YEARS
- NOTE: CONTRACTOR RESPONSIBLE FOR SCHEDULING A PRE-CONSTRUCTION INSPECTION FOR ALL INSTALLATIONS
- NOTE: WATERTIGHT SEPTIC TANKS REQUIRED
- NOTE: ALL PARTS OF SEPTIC SYSTEM SHALL BE 100 FEET FROM ANY WATER WELL
- NOTE: MANHOLE RISERS REQUIRED ON ALL SEPTIC TANKS AND PUMP CHAMBERS

NEITHER THE HOWARD COUNTY COUNCIL OR THE HEALTH DEPARTMENT IS RESPONSIBLE FOR THE SUCCESSFUL OPERATION OF ANY SYSTEM PERMITTEE RESPONSIBLE FOR OBTAINING FINAL APPROVAL ON THIS PERMIT CALL 410-313-2640 FOR INSPECTION OF SEPTIC SYSTEM

0 feet 60

1 inch = 60 feet

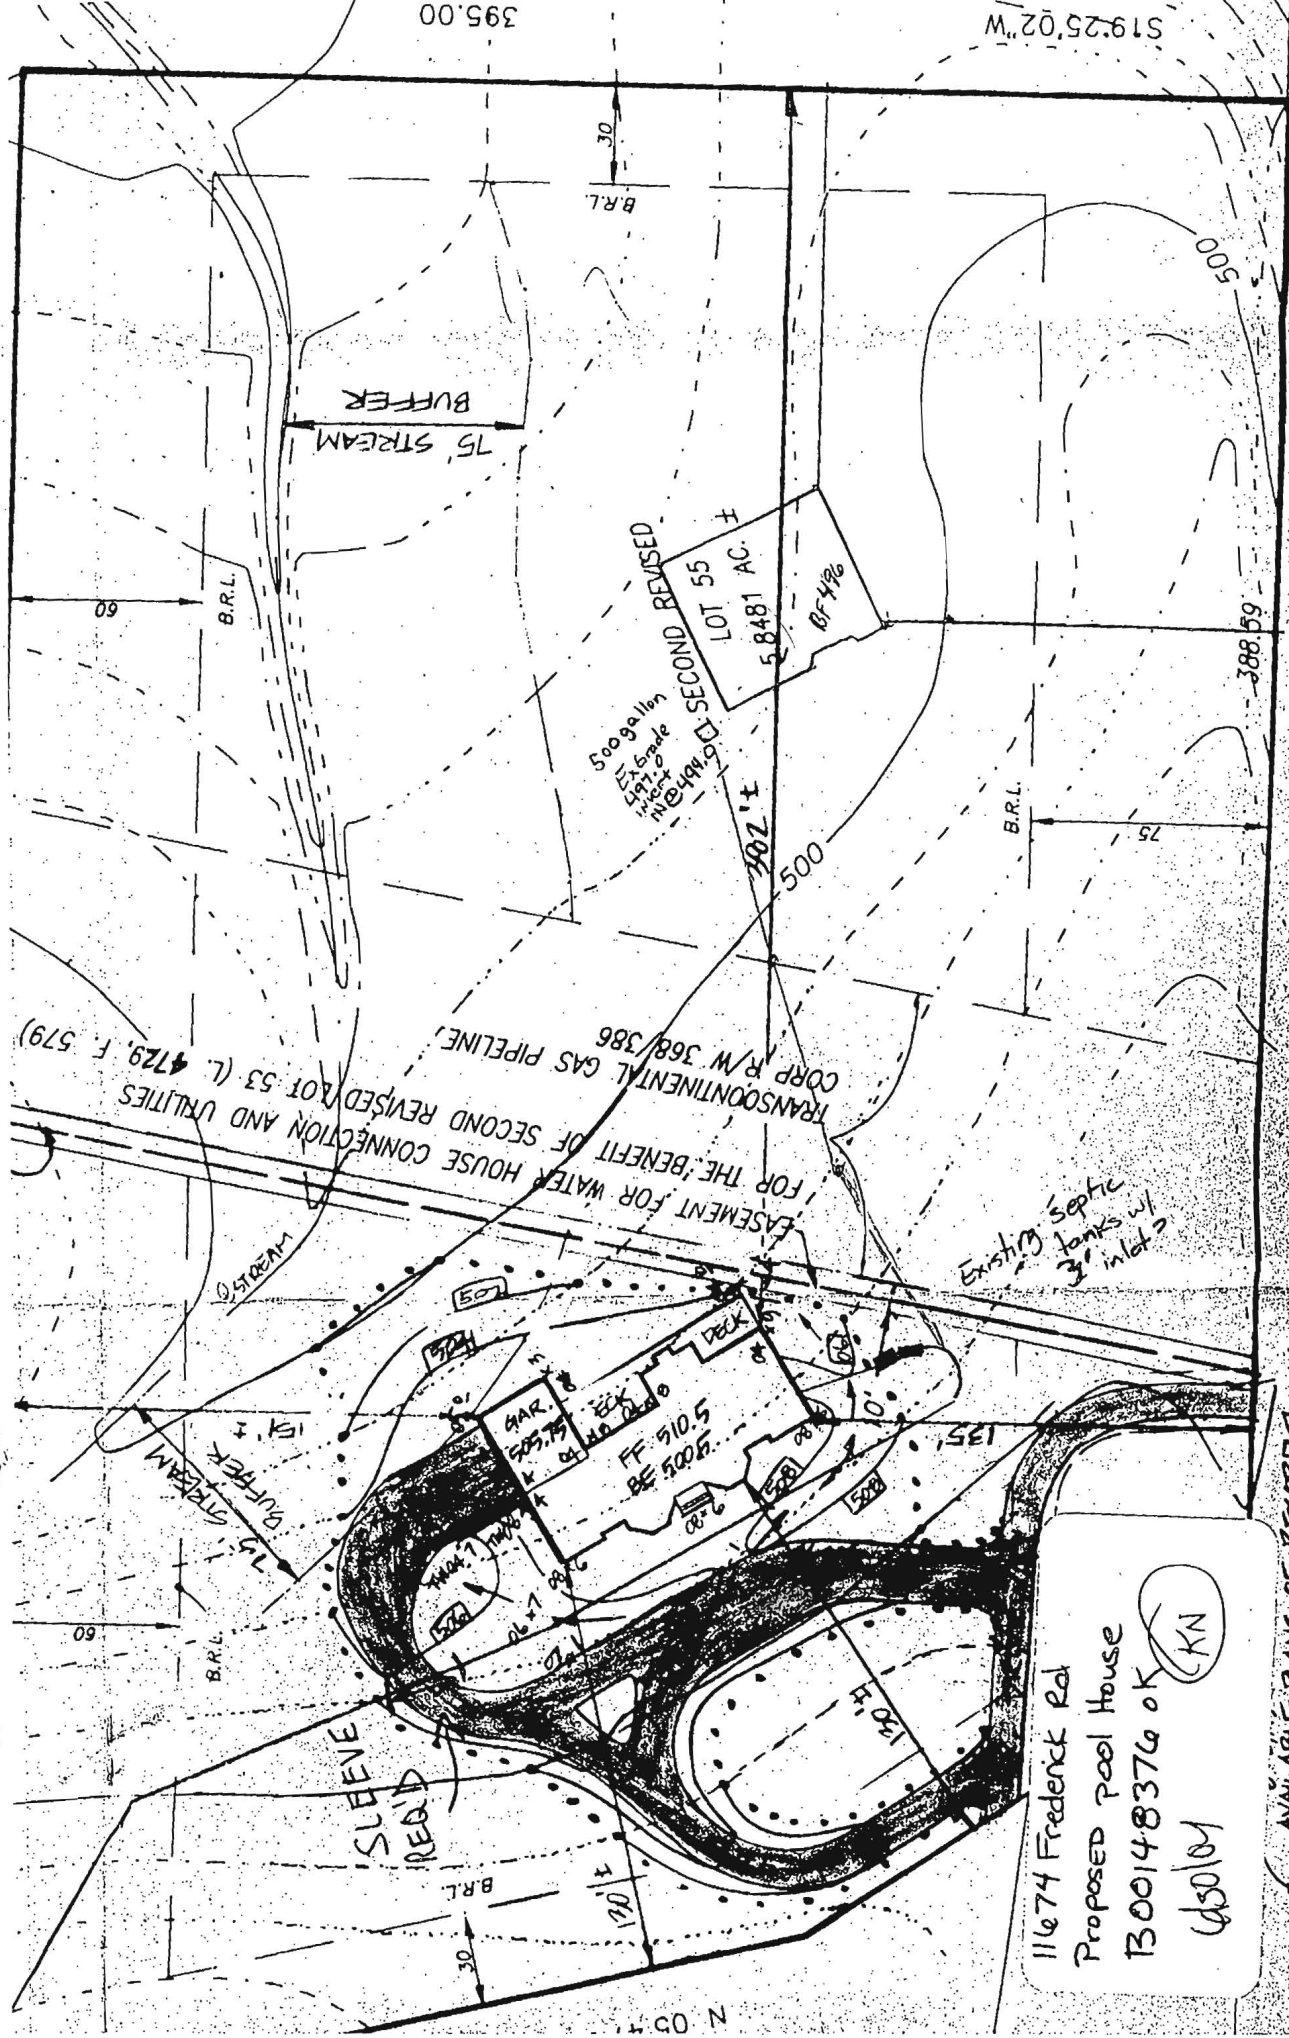

11674 Frederick Rd
 Proposed Pool House
 B00148376 OK
 6/30/01
 CKN

EASEMENT FOR WATER HOUSE CONNECTION AND UTILITIES
 FOR THE BENEFIT OF SECOND REVISED LOT 53 (L. #129, F. 579)
 TRANSCONTINENTAL GAS PIPELINE
 CORP R/W 368/386

REVISIONS
 500 gallon
 LIGHT GAUGE
 WATER TANK
 11/15/01
 SECOND REVISED
 LOT 55
 5.8481 AC.
 Gr 4%

Existing septic
 tanks w/
 3" inlets

SLEEVE
 RED

395.00

S19.25'02"W

AVAILABLE PLANS OF RECORD
 N70°34'58"W

480.00

388.59

500

75

505

307'±

30

B.R.L.

60

B.R.L.

B.R.L.

60

B.R.L.

30

B.R.L.

120'±

120'±

N 03°