

PUB. SEWER STATUS VERIFIED BY _____

ISSUE DATE: _____

P 532590

APPROVAL DATE: 8/20/2014

A REPAIR

PERMIT

Minor Septic Repair ON-SITE SEWAGE DISPOSAL SYSTEM HOWARD COUNTY HEALTH DEPARTMENT BUREAU OF ENVIRONMENTAL HEALTH

Fogles Septic Clean Inc. IS PERMITTED TO INSTALL ALTER

ADDRESS: 580 Obrecht Road Sykesville, MD 21784 PHONE NUMBER: 410-795-5670

SUBDIVISION: _____ LOT NUMBER: 2 Sec 2

ADDRESS: 7240 Guilford Road PROPERTY OWNER: Mike Chen

SEPTIC TANK CAPACITY (GALLONS): N/A

PUMP CHAMBER CAPACITY (GALLONS): 1250

NUMBER OF BEDROOMS: _____

SQUARE FEET OF HOUSE: _____

LINEAR FEET OF TRENCH REQUIRED: 90'


*2' Wide
Inlet 3.5'
Bottom 7.5'*

| | |
|-----------|--|
| TRENCHES: | |
| LOCATION: | |
| PURPOSE: | Replace pump in pump chamber and add an alarm to the system. Line between the septic tank and pump chamber needs to be repaired. |

PLANS APPROVED: Brian Baker DATE: 4/7/10

- NOTE: PERMIT VOID AFTER 2 YEARS
- NOTE: CONTRACTOR RESPONSIBLE FOR SCHEDULING A PRE-CONSTRUCTION INSPECTION FOR ALL INSTALLATIONS
- NOTE: WATERTIGHT SEPTIC TANKS REQUIRED
- NOTE: ALL PARTS OF SEPTIC SYSTEM SHALL BE 100 FEET FROM ANY WATER WELL
- NOTE: MANHOLE RISERS REQUIRED ON ALL SEPTIC TANKS AND PUMP CHAMBERS

NEITHER THE HOWARD COUNTY COUNCIL OR THE HEALTH DEPARTMENT IS RESPONSIBLE FOR THE SUCCESSFUL OPERATION OF ANY SYSTEM PERMITTEE RESPONSIBLE FOR OBTAINING FINAL APPROVAL ON THIS PERMIT CALL 410-313-1771 FOR INSPECTION OF SEPTIC SYSTEM

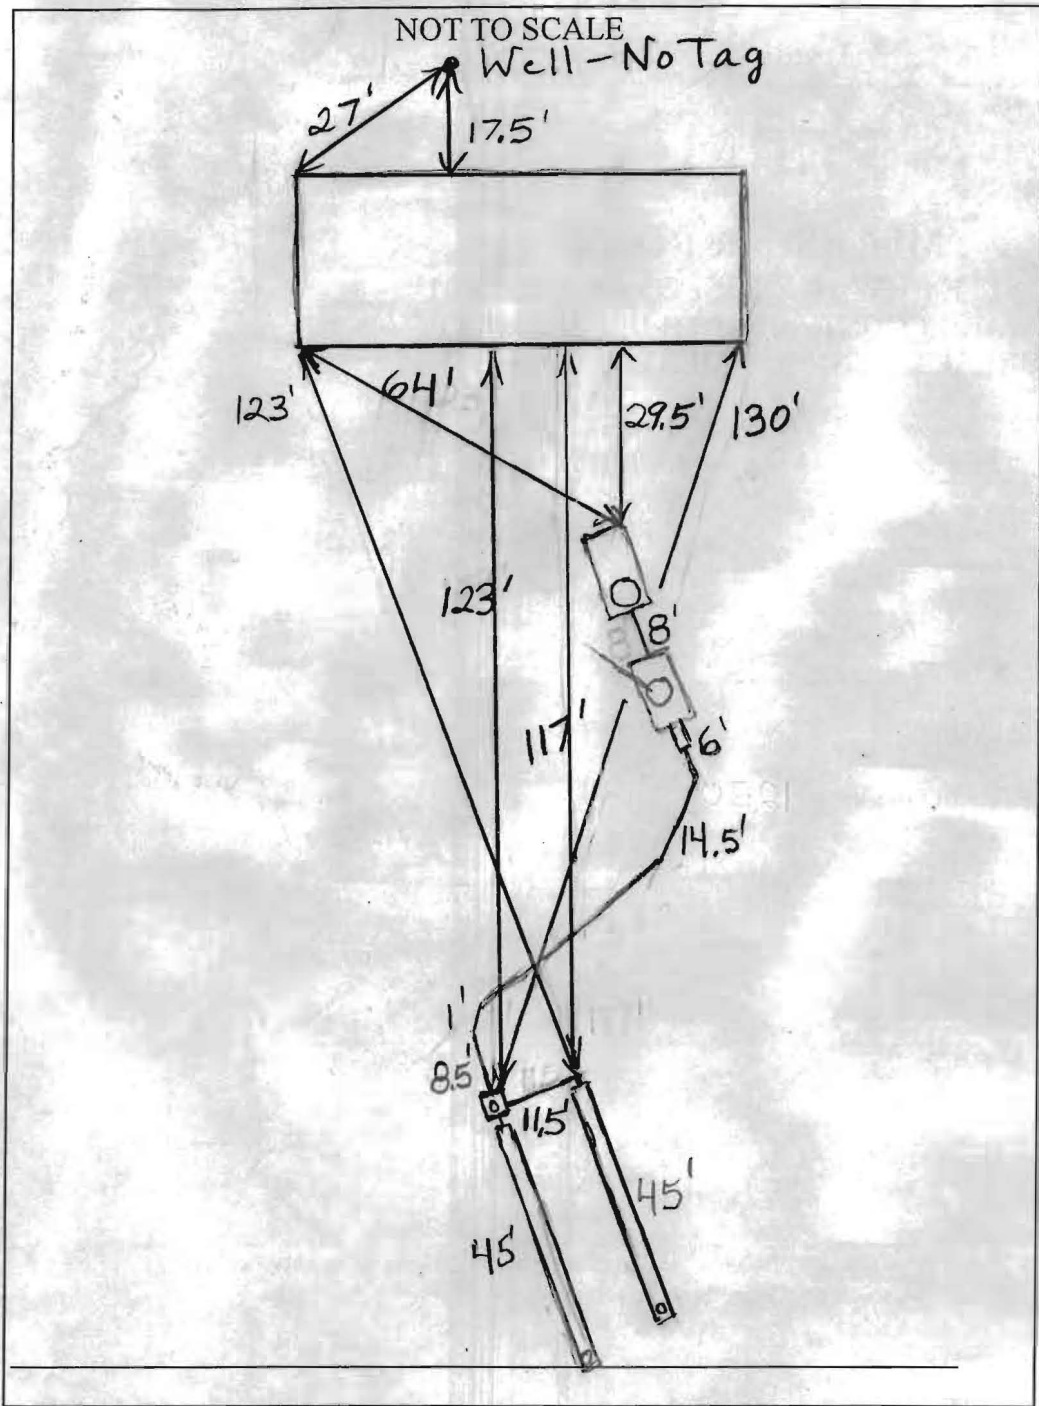

| TRENCH/DRAINFIELD DATA | | |
|-------------------------|-------|--------|
| WIDTH | INLET | BOTTOM |
| 2 | 3.5 | 7.5' |
| NUMBER OF TRENCHES | | 2 |
| TOTAL LENGTH | | 90' |
| ABSORPTION AREA | | 360 |
| DISTRIBUTION BOX LEVEL | | Yes |
| DISTRIBUTION BOX BAFFLE | | Elbow |
| DISTRIBUTION BOX PORT | | Yes |

| SEPTIC TANK DATA | |
|------------------------|----------|
| SEPTIC TANK I LEVEL | Yes |
| MANUFACTURER | N/A |
| CAPACITY | N/A GAL |
| SEAM LOC | Midseam |
| TANK LID DEPTH | 2.5-3' |
| BAFFLES | Yes |
| BAFFLE FILTER | No |
| MANHOLE LOC | Rear |
| 6" PORT LOC | Front |
| WATERTIGHT TEST | No |
| SLOTTED | No |
| PUMP/SEPTIC TANK LEVEL | |
| Yes | |
| MANUFACTURER | Babylon |
| CAPACITY | 1250 GAL |
| SEAM LOC | Top |
| TANK LID DEPTH | 2.5-3' |
| BAFFLES | Front |
| BAFFLE FILTER | No |
| MANHOLE LOC | Middle |
| 6" PORT LOC | Front |
| WATERTIGHT TEST | No |
| SLOTTED | No |

PRE-CONSTRUCTION

4/27/2010 Layout done. (BB)

INSTALLATION: 8/20/14 System installed, O.K. to backfill.
Pump and alarm test never called in. (BB)

FINAL INSPECTOR B. Baker

DATE OF APPROVAL 8/20/2014