

APPLICATION

FOR PERCOLATION TESTING AND SITE EVALUATION

TEST DATE(S) _____

TEST TIME _____

AP 522520

AGENCY REVIEW: _____

DATE 6/7/05

DO NOT WRITE ABOVE THIS LINE

I HEREBY APPLY FOR THE NECESSARY TESTING/EVALUATION PRIOR TO ISSUANCE OF SEWAGE DISPOSAL SYSTEM PERMIT(S) TO:

CHECK AS NEEDED:

- ☐ CONSTRUCT NEW SEPTIC SYSTEM(S)
☐ REPAIR/ADD TO AN EXISTING SEPTIC SYSTEM
☐ REPLACE AN EXISTING SEPTIC SYSTEM

CHECK ONE:

- ☒ CREATE NEW LOT(S)
☐ BUILD ON AN EXISTING LOT IN A SUBDIVISION
☐ BUILD ON AN EXISTING PARCEL OF RECORD

CHECK AS NEEDED:

- ☐ NEW STRUCTURE(S)
☐ ADDITION TO AN EXISTING STRUCTURE
☐ REPLACE AN EXISTING STRUCTURE

IS THE PROPERTY WITHIN 2500' OF ANY RESERVOIR?

- ☐ YES
☐ NO

THE TYPE OF STRUCTURE IS:

- ☐ RESIDENTIAL WITH PROPOSED BEDROOMS IN THE COMPLETED STRUCTURE (NOTE UNKNOWN IF APPROPRIATE)
☐ COMMERCIAL (PROVIDE DETAIL OF NUMBERS AND TYPES OF EMPLOYEES/CUSTOMERS ON ACCOMPANYING PLAN)
☐ INSTITUTIONAL/GOVERNMENT (PROVIDE DETAIL OF NUMBERS AND TYPES OF EMPLOYEES/USERS ON ACCOMPANYING PLAN)

PROPERTY OWNER(S)

Frances Devlin

DAYTIME PHONE

410-997-4600 Goodier Bldrs.

CELL

FAX

MAILING ADDRESS

Echo Farm Route 3, 43 East Litchfield Rd.,

Litchfield

CT

06750

STREET

CITY/TOWN

STATE

ZIP

APPLICANT

Heritage Land Development

DAYTIME PHONE

410-489-7900

CELL

410-982-2882

FAX

410-489-9768

MAILING ADDRESS

3060 Washington Road, Suite 220

Glenwood

MD

21738

STREET

CITY/TOWN

STATE

ZIP

APPLICANT'S ROLE

DEVELOPER

BUILDER

BUYER

RELATIVE/FRIEND

REALTOR

CONSULTANT

PROPERTY LOCATION

SUBDIVISION NAME

Meriweather Farm - Section 2

LOT NO. 18, 19

PROPERTY ADDRESS

14944 Roxbury Road

Glenelg

STREET

TOWN/POST OFFICE

TAX MAP PAGE(S)

21

GRID

16

PARCEL(S)

28

PROPOSED LOT SIZE

1 Acre

AS APPLICANT, I UNDERSTAND THE FOLLOWING: THE SYSTEM INSTALLED SUBSEQUENT TO THIS APPLICATION IS ACCEPTABLE ONLY UNTIL PUBLIC SEWAGE IS AVAILABLE. THIS APPLICATION IS COMPLETE WHEN ALL APPLICABLE FEES AND A SUITABLE SITE PLAN HAVE BEEN RECEIVED. I ACCEPT THE RESPONSIBILITY FOR COMPLIANCE WITH ALL M.O.S.H.A. AND "MISS UTILITY" REQUIREMENTS. APPROVAL IS BASED UPON SATISFACTORY REVIEW OF A PERC CERTIFICATION PLAN. TEST RESULTS WILL BE MAILED TO APPLICANT.


Jimmy Rutta

SIGNATURE OF APPLICANT

HOWARD COUNTY HEALTH DEPARTMENT, BUREAU OF ENVIRONMENTAL HEALTH, WELL AND SEPTIC PROGRAM
3525-H ELLICOTT MILLS DRIVE, ELLICOTT CITY, MARYLAND 21043-4544 (410) 313-1771 FAX (410) 313-2648
TDD (410) 313-2323 TOLL FREE 1-877-4MD-DHMH

LOTS 18-19

A/P 939
lt brn
w.c.s.g.
SL some
pockets
platy struc.
Rx 5%±
7'
wk org
brn sil
8 1/2'
lt brn
LS
v.f. SAND
12 1/2'
Bottom
940
wk org
brn
loam /
sil
2'
4' lt brn
S loam
wk
shale
10%±
12 1/2'
Bottom
938
Qtz frag
brn
1'
2 1/2' str brn
compact
loam
5'
brn
L w/
sil
pockets
Trace
Rx
Bottom

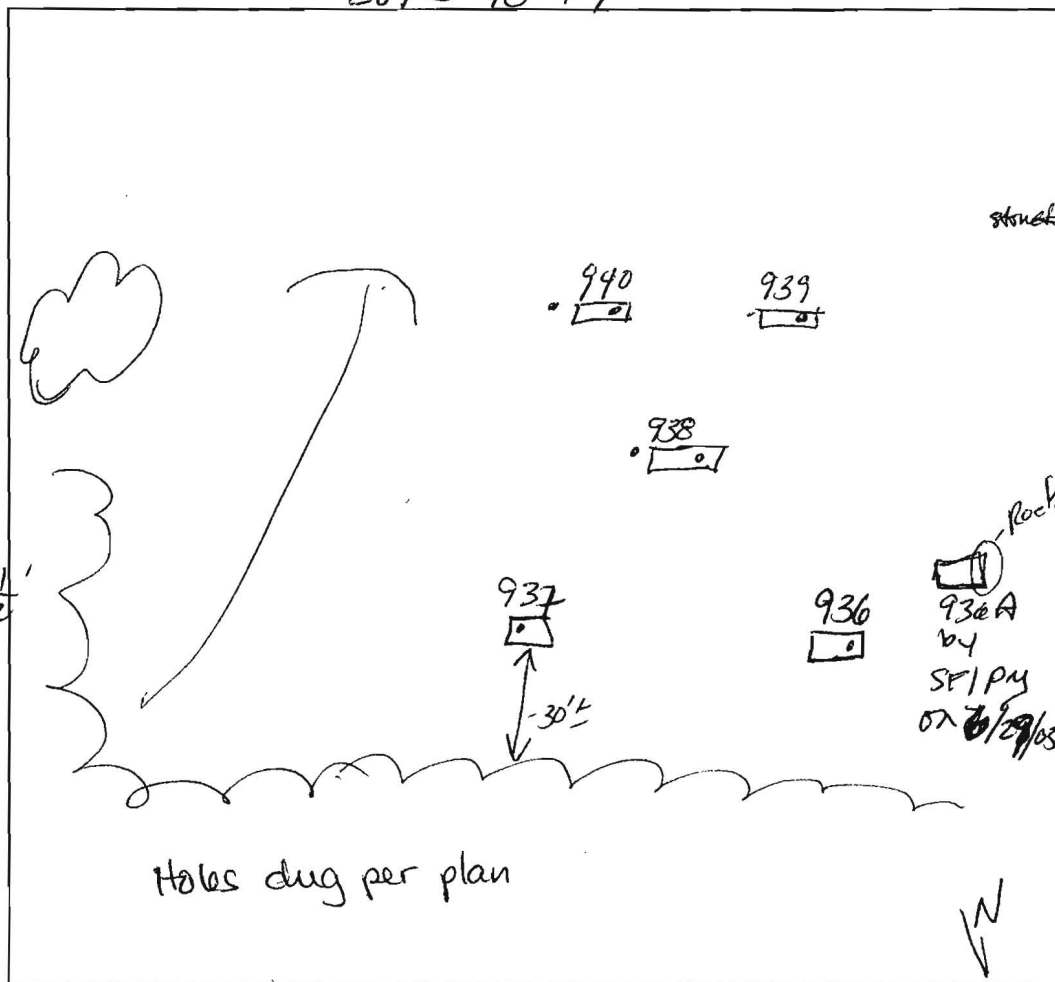

937
DK brn
hwy L
SAND 10'±
mid size
grains
6' struck
Sbk gr, platy
pockets sil
Rx frag 3/10/05
moist
SL w sil
mottled
@ 10'
12' Bottom

936
str brn
loam
1 pl, massive
4' str brn
sil / sil
5' str
sil
white
decomp
rock
7' SL
moist
v. dk brn
faint mottled
11 1/2' bottom 8' to 10' in sap

9.36A
Bm L
1'
org brn
hl →
d sil
sbk, cw
4 1/2'
5-10%
gravel &
cobbles
5 1/2'
org
white
brn
sil

15' 7" Bottom

DATE	TEST #	DEPTH	START	BREAK 1" DROP	STOP 2" DROP	TIME OF 2nd INCH	P/F/H
6-28-05	939	3'	7:19	7:23	7:27	5m	P
	9:40	4'	7:23	7:28	7:40	12m	P
	9:38	3 1/2'	7:27	7:32	7:35	3m	P
	937	3'	7:31	7:38	7:46	8min	P
	936	3'	7:36	Too slow @ 3'			F
	9.36A	3' 8"				24 39	P
6/29/05							

REMARKS Soil structure varies = variable perc rates in same texture
SANITARIAN Kace BACKHOE Zepp, Chuck OTHERS
TEST HOLES USED IN SDA AVG. PERC TIME SQ. FT/BR
TRENCH WIDTH INLET DEPTH MAX. BOT DEPTH EFFECTIVE S/W

Approved 1/25/08
SP Plan

