



Howard County
Health Department

Bureau of Environmental Health
7178 Gateway Drive Columbia, MD 21046
(410) 313-2640 Fax (410) 313-2648
TDD (410) 313-2323 Toll Free 1-866-313-6300
website: www.hchealth.org

Maura J. Rossman, M.D., Health Officer

RECEIPT DATE: 8/26/13

ONSITE SEWAGE DISPOSAL SYSTEM

P 545129

INSTALLATION
APPROVAL DATE: _____

PERMIT
MINOR REPAIR

A _____

PROPERTY ADDRESS: 11821 Triadelphia Road

SUBDIVISION: Evergreen Valley Estates

LOT: 6

TAX ID: 03-297144

CONTRACTOR: James Mettee Plumbing

EMAIL: _____

CONTRACTOR ADDRESS: 4937 -A Green Valley Road #5, Monrovia, MD 21770

PHONE: 301-831-9626

PROPERTY OWNER: Jack and Bridgette Crumrine

EMAIL: _____

OWNER ADDRESS: 11821 Triadelphia Road, Ellicott City, MD 21042

PHONE: 410-531-9253

NUMBER OF BEDROOMS: n/a HOUSE SQ. FT. n/a

LOCATION:	Tie in ejector pump for existing bathroom to existing septic tank.
NOTES:	Call for inspection prior to covering work.

ISSUED BY: _____

ISSUE DATE: _____

EXPIRATION DATE: 8/26/2014

NOTE: CONTRACTOR MUST SCHEDULE AN INSPECTION AND GAIN APPROVAL OF ALL COMPONENTS PRIOR TO COVERING


NOTE: AN ELECTRICAL PERMIT IS REQUIRED FOR INSTALLATION OF ANY ELECTRICAL COMPONENTS OF THE SYSTEM

**NEITHER THE HOWARD COUNTY COUNCIL NOR THE HEALTH DEPARTMENT IS RESPONSIBLE
FOR THE SUCCESSFUL OPERATION OF ANY SYSTEM.**

**PERMITTEE RESPONSIBLE FOR OBTAINING FINAL APPROVAL ON THIS PERMIT.
CALL 410-313-1771 FOR INSPECTION OF SEPTIC SYSTEM.**

Triadelphia Rd.

NOT TO SCALE

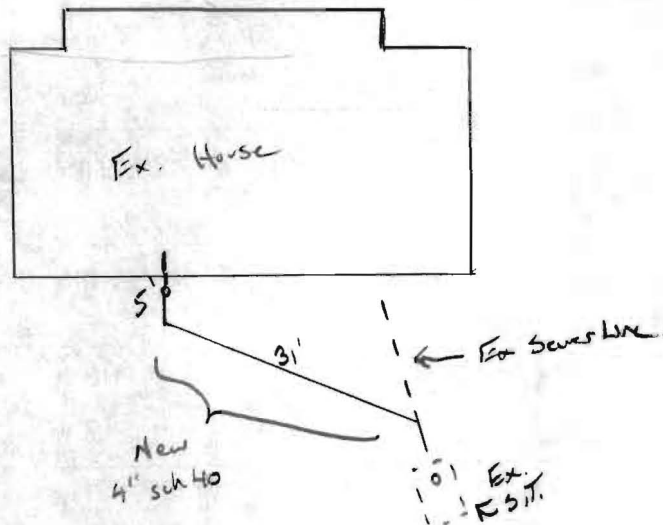

ROAD NAME

TRENCH/DRAINFIELD DATA

WIDTH INLET BOTTOM

NUMBER OF TRENCHES _____
TOTAL LENGTH _____
ABSORPTION AREA _____
DISTRIBUTION BOX LEVEL _____
DISTRIBUTION BOX BAFFLE _____
DISTRIBUTION BOX PORT _____

SEPTIC TANK DATA

SEPTIC TANK 1 LEVEL _____
MANUFACTURER _____
CAPACITY _____ GAL
SEAM LOC _____
TANK LID DEPTH _____
BAFFLES _____
BAFFLE FILTER _____
MANHOLE LOC _____
6" PORT LOC _____
WATERTIGHT TEST _____
SLOTTED _____
DATE ON LID _____

PUMP/SEPTIC TANK LEVEL _____
MANUFACTURER _____
CAPACITY _____ GAL
SEAM LOC _____
TANK LID DEPTH _____
BAFFLES _____
BAFFLE FILTER _____
MANHOLE LOC _____
6" PORT LOC _____
WATERTIGHT TEST _____
SLOTTED _____
DATE ON LID _____

PRE-CONSTRUCTION:

INSTALLATION: 8/23/13 Insp. made w/ a file. Late (pm).
Plumber re-routed new sewer out from addition to original
4" gravity line into tank. 1.5% fall set on new line.
looks ok to cover.

FINAL INSPECTOR

[Signature]

DATE OF APPROVAL

8/23/13