



Building Permit Application

Howard County Maryland
Department of Inspections, Licenses and Permits
3430 Court House Drive
Permits: 410-313-2455
www.howardcountymd.gov

Date Received: 9/28/15

Permit No.: B15004370

Building Address: 3495 WOODBINE ROAD
City: WOODBINE State: MD Zip Code: 21797
Suite/Apt. #: _____ SDP/WP/BA #: _____
Census Tract: _____ Subdivision: _____
Section: _____ Area: _____ Lot: 2
Tax Map: 13 Parcel: 155 Grid: _____
Zoning: RC Map Coordinates: _____ Lot Size: 4.468

Existing Use: RESIDENTIAL SFD
Proposed Use: GARAGE / STORAGE
Estimated Construction Cost: \$ 38,000.00
Description of Work: 2 CAR GARAGE WITH 2ND FLOOR STORAGE DECK

Occupant or Tenant: N/A
Was tenant space previously occupied? Yes No
Contact Name: FRANK HENDERICKSON
Address: 3495 WOODBINE ROAD
City: WOODBINE State: MD Zip Code: 21797
Phone: 443-739-4369 Fax: _____
Email: BIGJET@Yahoo.com

Property Owner's Name: FRANK & MARLENE HENDERICKSON
Address: 3495 WOODBINE ROAD
City: WOODBINE State: MD Zip Code: 21797
Phone: 443-739-4369 Fax: _____
Email: BIGJET@Yahoo.com

Applicant's Name & Mailing Address, (If other than stated herein)
Applicant's Name: _____
Address: _____
City: _____ State: _____ Zip Code: _____
Phone: _____ Fax: _____
Email: _____

Contractor Company: WATERCOOL STRUCTURAL
Contact Person: AL STAGIJEWS
Address: 3575 LINDEN HWY.
City: PRINCETON State: PA Zip Code: 17305
License No.: 10771
Phone: 610-387-2140 Fax: 610-257-2606
Email: AL.WATERCOOL@COMCAST.COM

Engineer/Architect Company: DRAFTING CONCEPTS LLC
Responsible Design Prof.: JOHN L SM
Address: 5912 OLD STRASBURG RD.
City: KUZZOCK State: PA Zip Code: 17335
Phone: 717-442-5053 Fax: _____
Email: JOHN@DRAFTINGCONCEPTSLLC.NET

Commercial Building Characteristics	Residential Building Characteristics	
Height:	<input type="checkbox"/> SF Dwelling <input type="checkbox"/> SF Townhouse	
No. of stories:	Depth	Width
Gross area, sq. ft./floor:	1 st floor: <u>28' x 28'</u>	
	2 nd floor: <u>28' x 28'</u>	
Area of construction (sq. ft.):	Basement: <u>N/A</u>	
	<input type="checkbox"/> Finished Basement	
Use group:	<input type="checkbox"/> Unfinished Basement	
	<input type="checkbox"/> Crawl Space	
Construction type:	<input type="checkbox"/> Slab on Grade	
<input type="checkbox"/> Reinforced Concrete	No. of Bedrooms: <u>N/A</u>	
<input type="checkbox"/> Structural Steel	Multi-family Dwelling	
<input type="checkbox"/> Masonry	No. of efficiency units:	
<input type="checkbox"/> Wood Frame	No. of 1 BR units:	
<input type="checkbox"/> State Certified Modular	No. of 2 BR units:	
	No. of 3 BR units:	
	Other Structure:	
	Dimensions:	
<input checked="" type="checkbox"/> Roadside Tree Project Permit	Footings:	
<input type="checkbox"/> Yes <input checked="" type="checkbox"/> No	Roof:	
Roadside Tree Project Permit #	<input type="checkbox"/> State Certified Modular	
	<input type="checkbox"/> Manufactured Home	

Utilities	
Water Supply	
<input type="checkbox"/> Public	
<input type="checkbox"/> Private	
Sewage Disposal	
<input type="checkbox"/> Public	
<input checked="" type="checkbox"/> Private	
Electric:	<input checked="" type="checkbox"/> Yes <input type="checkbox"/> No
Gas:	<input type="checkbox"/> Yes <input checked="" type="checkbox"/> No
Heating System	
<input type="checkbox"/> Electric <input type="checkbox"/> Oil	
<input type="checkbox"/> Natural Gas <input type="checkbox"/> Propane Gas	
<input type="checkbox"/> Other:	
Sprinkler System:	
<input type="checkbox"/> Yes <input type="checkbox"/> No	
Grading Permit Number:	
Building Shell Permit Number:	

THE UNDERSIGNED HEREBY CERTIFIES AND AGREES AS FOLLOWS: (1) THAT HE/SHE IS AUTHORIZED TO MAKE THIS APPLICATION; (2) THAT THE INFORMATION IS CORRECT; (3) THAT HE/SHE WILL COMPLY WITH ALL REGULATIONS OF HOWARD COUNTY WHICH ARE APPLICABLE THERETO; (4) THAT HE/SHE WILL PERFORM NO WORK ON THE ABOVE REFERENCED PROPERTY NOT SPECIFICALLY DESCRIBED IN THIS APPLICATION; (5) THAT HE/SHE GRANTS COUNTY OFFICIALS THE RIGHT TO ENTER ONTO THIS PROPERTY FOR THE PURPOSE OF INSPECTING THE WORK PERMITTED AND POSTING NOTICES.

Applicant's Signature: [Signature]
Email Address: BIGJET@Yahoo.com
Title/Company: Owner

Print Name: FRANK HENDERICKSON
Date: 9/24/15

Checks Payable to: DIRECTOR OF FINANCE OF HOWARD COUNTY
PLEASE WRITE NEATLY & LEGIBLY
-FOR OFFICE USE ONLY-

AGENCY	DATE	SIGNATURE OF APPROVAL
State Highways		
Building Officials		
PSZA (Zoning)		
PSZA (Engineering)		
Health	<u>10/21/15</u>	<u>H. Oswald</u>

Is Sediment Control approval required for issuance? Yes No
 CONTINGENCY CONSTRUCTION START

DPZ SETBACK INFORMATION	
Front:	
Rear:	
Side:	
Side St.:	
All minimum setbacks met?	<input type="checkbox"/> Yes <input checked="" type="checkbox"/> No
Is Entrance Permit Required?	<input type="checkbox"/> Yes <input checked="" type="checkbox"/> No
Historic District?	<input type="checkbox"/> Yes <input checked="" type="checkbox"/> No
Lot Coverage for New Town Zone:	
SDP/Red-line approval date:	

Filing Fee	\$ <u>25.00</u>
Permit Fee	\$
Tech Fee	\$
Excise Tax	\$
PSFS	\$
Guaranty Fund	\$
Add'l per Fee	\$
Total Fees	\$
Sub-Total Paid	\$
Balance Due	\$
Check #	<u>4111</u>

SITE INSPECTION SHEET

OWNER: Frank & Madeline Hendricks PHONE #: _____


ADDRESS: 3425 Woodbine Rd CONTRACTOR: _____

_____ WELL TAG #: _____

SUBDIVISION: _____ LOT: _____ COUNTY #: _____

PROPOSAL: Replace existing 1 car garage w/ 2 car 2 story garage.

LOCATION DIAGRAM

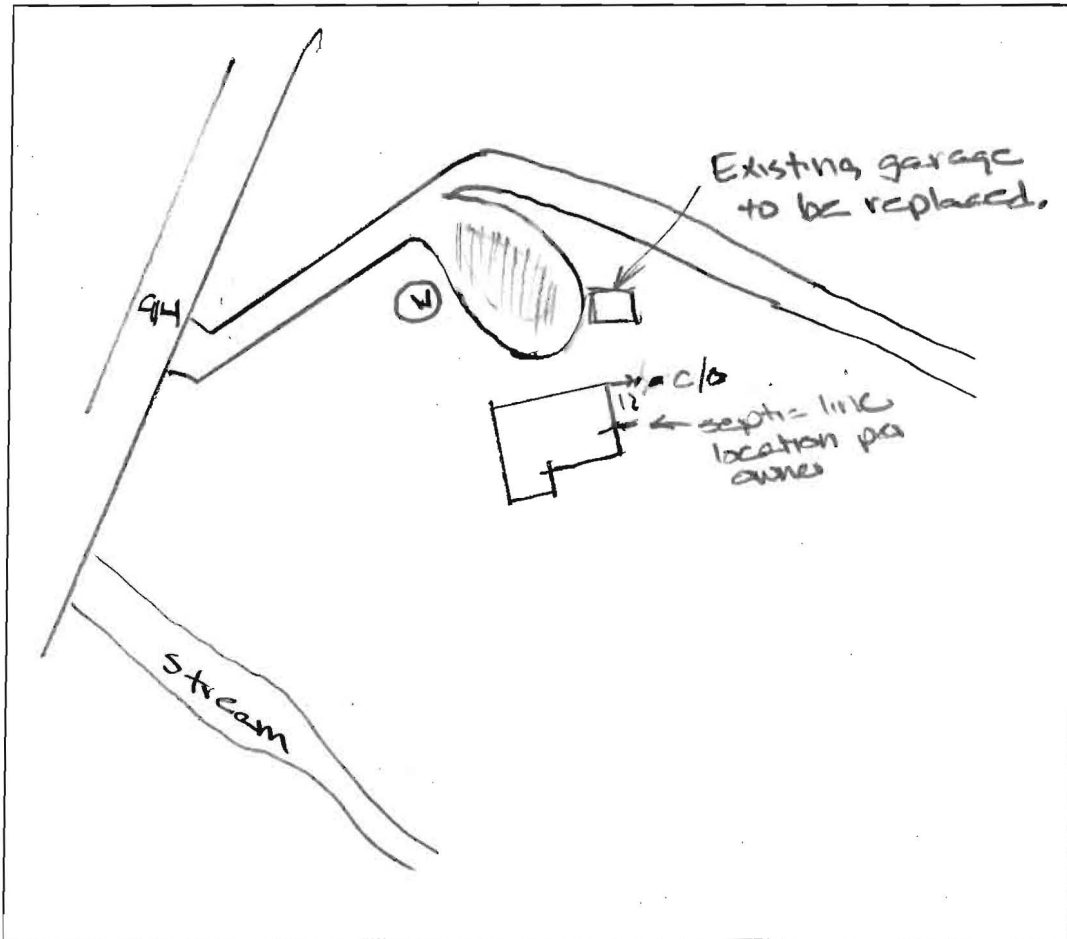

COMMENTS: Site plan appears to match up with field located well & septic tank c/o. Owner states all septic components run along side of house. Per owner, the garage will not have plumbing.

DATE: 10/21/15 INSPECTOR: Mark Oswald