



Building Permit Application

Howard County Maryland
Department of Inspections, Licenses and Permits
3430 Court House Drive
Permits: 410-313-2455
www.howardcountymd.gov

Date Received: 1/16/15

Permit No.: B15000168

Building Address: 15046 Double Bridges Ct.
City: Glenwood State: MD Zip Code: 21738
Suite/Apt. # _____ SDP/WP/BA #: _____
Census Tract: _____ Subdivision: MERIWEATHER
Section: _____ Area: _____ Lot: 3
Tax Map: _____ Parcel: _____ Grid: _____
Zoning: _____ Map Coordinates: _____ Lot Size: _____

Existing Use: VACANT LOT
Proposed Use: NEW SINGLE FAM. DWELLING

Estimated Construction Cost: \$ 295,000

Description of Work: COLORADO w/ MORN RM
6 FT FAM RM. EXT, 2 STONES,
FULL BSMT, 14 R, 5 FB, 1 HB,
Occupant or Tenant: 2 FP, E, MANAGER, (4BR)

Was tenant space previously occupied? Yes No
Contact Name: FIN LIC w/ BATH

Address: _____
City: _____ State: _____ Zip Code: _____
Phone: _____ Fax: _____
Email: _____

Commercial Building Characteristics	Residential Building Characteristics
Height:	<input checked="" type="checkbox"/> SF Dwelling <input type="checkbox"/> SF Townhouse
No. of stories:	Depth Width
Gross area, sq. ft./floor:	1 st floor:
Area of construction (sq. ft.):	2 nd floor:
Use group:	Basement:
	<input checked="" type="checkbox"/> Finished Basement
	<input type="checkbox"/> Unfinished Basement
	<input type="checkbox"/> Crawl Space
	<input type="checkbox"/> Slab-on-Grade
Construction type:	No. of Bedrooms:
<input type="checkbox"/> Reinforced Concrete	Multi-family Dwelling
<input type="checkbox"/> Structural Steel	No. of efficiency units:
<input type="checkbox"/> Masonry	No. of 1 BR units:
<input type="checkbox"/> Wood Frame	No. of 2 BR units:
<input type="checkbox"/> State Certified Modular	No. of 3 BR units:
	Other Structure:
	Dimensions:
<input checked="" type="checkbox"/> Roadside Tree Project Permit	Footings:
<input type="checkbox"/> Yes <input checked="" type="checkbox"/> No	Roof:
Roadside Tree Project Permit #	<input type="checkbox"/> State Certified Modular
	<input type="checkbox"/> Manufactured Home

Property Owner's Name: MERIWEATHER FARM LLC
Address: 14944 Roxbury Rd.
City: _____ State: MD Zip Code: 21737
Phone: Glenig Fax: _____
Email: _____

Applicant's Name & Mailing Address, (if other than stated herein)
Applicant's Name: VICKY MEYER
Address: MD BLDG PERMITS INC.
City: _____ State: _____ Zip Code: _____
Phone: 410-296-6900 Fax: _____
Email: MDBLDGPERMITS@COMCAST.NET

Contractor Company: K. HOVNANIAN HOMES
Contact Person: Chester Willett
Address: 1802 BRIGHTSEAT RD.
City: LANOVER State: MD Zip Code: 20785
License No.: 3149
Phone: 1-240-375-4515 Fax: _____
Email: CWillett@KHOV.COM

Engineer/Architect Company: Development Design Consultan
Responsible Design Prof.: Brian
Address: 192 E. MAIN ST.
City: Westminster State: MD Zip Code: 21157
Phone: 410-386-0560 Fax: _____
Email: _____

Utilities	
Water Supply	
<input type="checkbox"/> Public	
<input checked="" type="checkbox"/> Private	
Sewage Disposal	
<input type="checkbox"/> Public	
<input checked="" type="checkbox"/> Private	
Electric: <input checked="" type="checkbox"/> Yes <input type="checkbox"/> No	
Gas: <input checked="" type="checkbox"/> Yes <input type="checkbox"/> No	
Heating System	
<input type="checkbox"/> Electric <input type="checkbox"/> Oil	
<input checked="" type="checkbox"/> Natural Gas <input type="checkbox"/> Propane Gas	
<input type="checkbox"/> Other:	
Sprinkler System:	
<input checked="" type="checkbox"/> Yes <input type="checkbox"/> No	
Grading Permit Number:	<u>GL3000</u>
Building Shell Permit Number:	

THE UNDERSIGNED HEREBY CERTIFIES AND AGREES AS FOLLOWS: (1) THAT HE/SHE IS AUTHORIZED TO MAKE THIS APPLICATION; (2) THAT THE INFORMATION IS CORRECT; (3) THAT HE/SHE WILL COMPLY WITH ALL REGULATIONS OF HOWARD COUNTY WHICH ARE APPLICABLE THERETO; (4) THAT HE/SHE WILL PERFORM NO WORK ON THE ABOVE REFERENCED PROPERTY NOT SPECIFICALLY DESCRIBED IN THIS APPLICATION; (5) THAT HE/SHE GRANTS COUNTY OFFICIALS THE RIGHT TO ENTER ONTO THIS PROPERTY FOR THE PURPOSE OF INSPECTING THE WORK PERMITTED AND POSTING NOTICES.

Applicant's Signature: Vicky Meyer
MDBLDGPERMITS@comcast.net
Email Address: _____
agent
Title/Company: _____

Print Name: Vicky Meyer
Date: 1/16/15
RECEIVED
JAN 16 2015
LICENSES & PERMITS DIVISION
ck# 54187

Checks Payable to: DIRECTOR OF FINANCE OF HOWARD COUNTY
PLEASE WRITE NEATLY & LEGIBLY
-FOR OFFICE USE ONLY-



AGENCY	DATE	SIGNATURE OF APPROVAL
State Highways		
Building Officials		
PSZA (Zoning)		
PSZA (Engineering)		
Health	<u>2/2/15</u>	<u>H. Oswald</u>

Is Sediment Control approval required for issuance? Yes No
 CONTINGENCY CONSTRUCTION START

DPZ SETBACK INFORMATION	
Front:	
Rear:	
Side:	
Side St.:	
All minimum setbacks met?	<input type="checkbox"/> Yes <input type="checkbox"/> No
Is Entrance Permit Required?	<input type="checkbox"/> Yes <input type="checkbox"/> No
Historic District?	<input type="checkbox"/> Yes <input type="checkbox"/> No
Lot Coverage for New Town Zone:	
SDP/Red-line approval date:	

Filing Fee	\$ <u>100.00</u>
Permit Fee	\$
Tech Fee	\$
Excise Tax	\$
PSFS	\$
Guaranty Fund	\$ <u>50.00</u>
Add'l per Fee	\$
Total Fees	\$
Sub-Total Paid	\$
Balance Due	\$
Check	# <u>00054187</u>


2/2/15 -
 Site plan approved
 for B15008168
 (5 bedrooms)
 H.O.

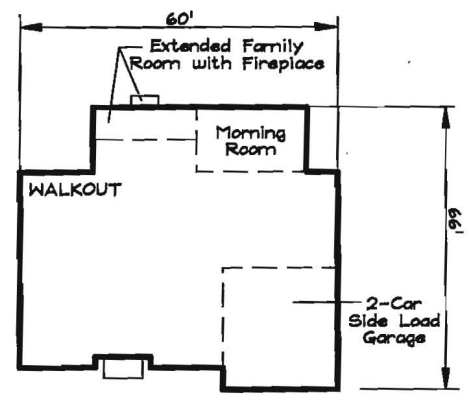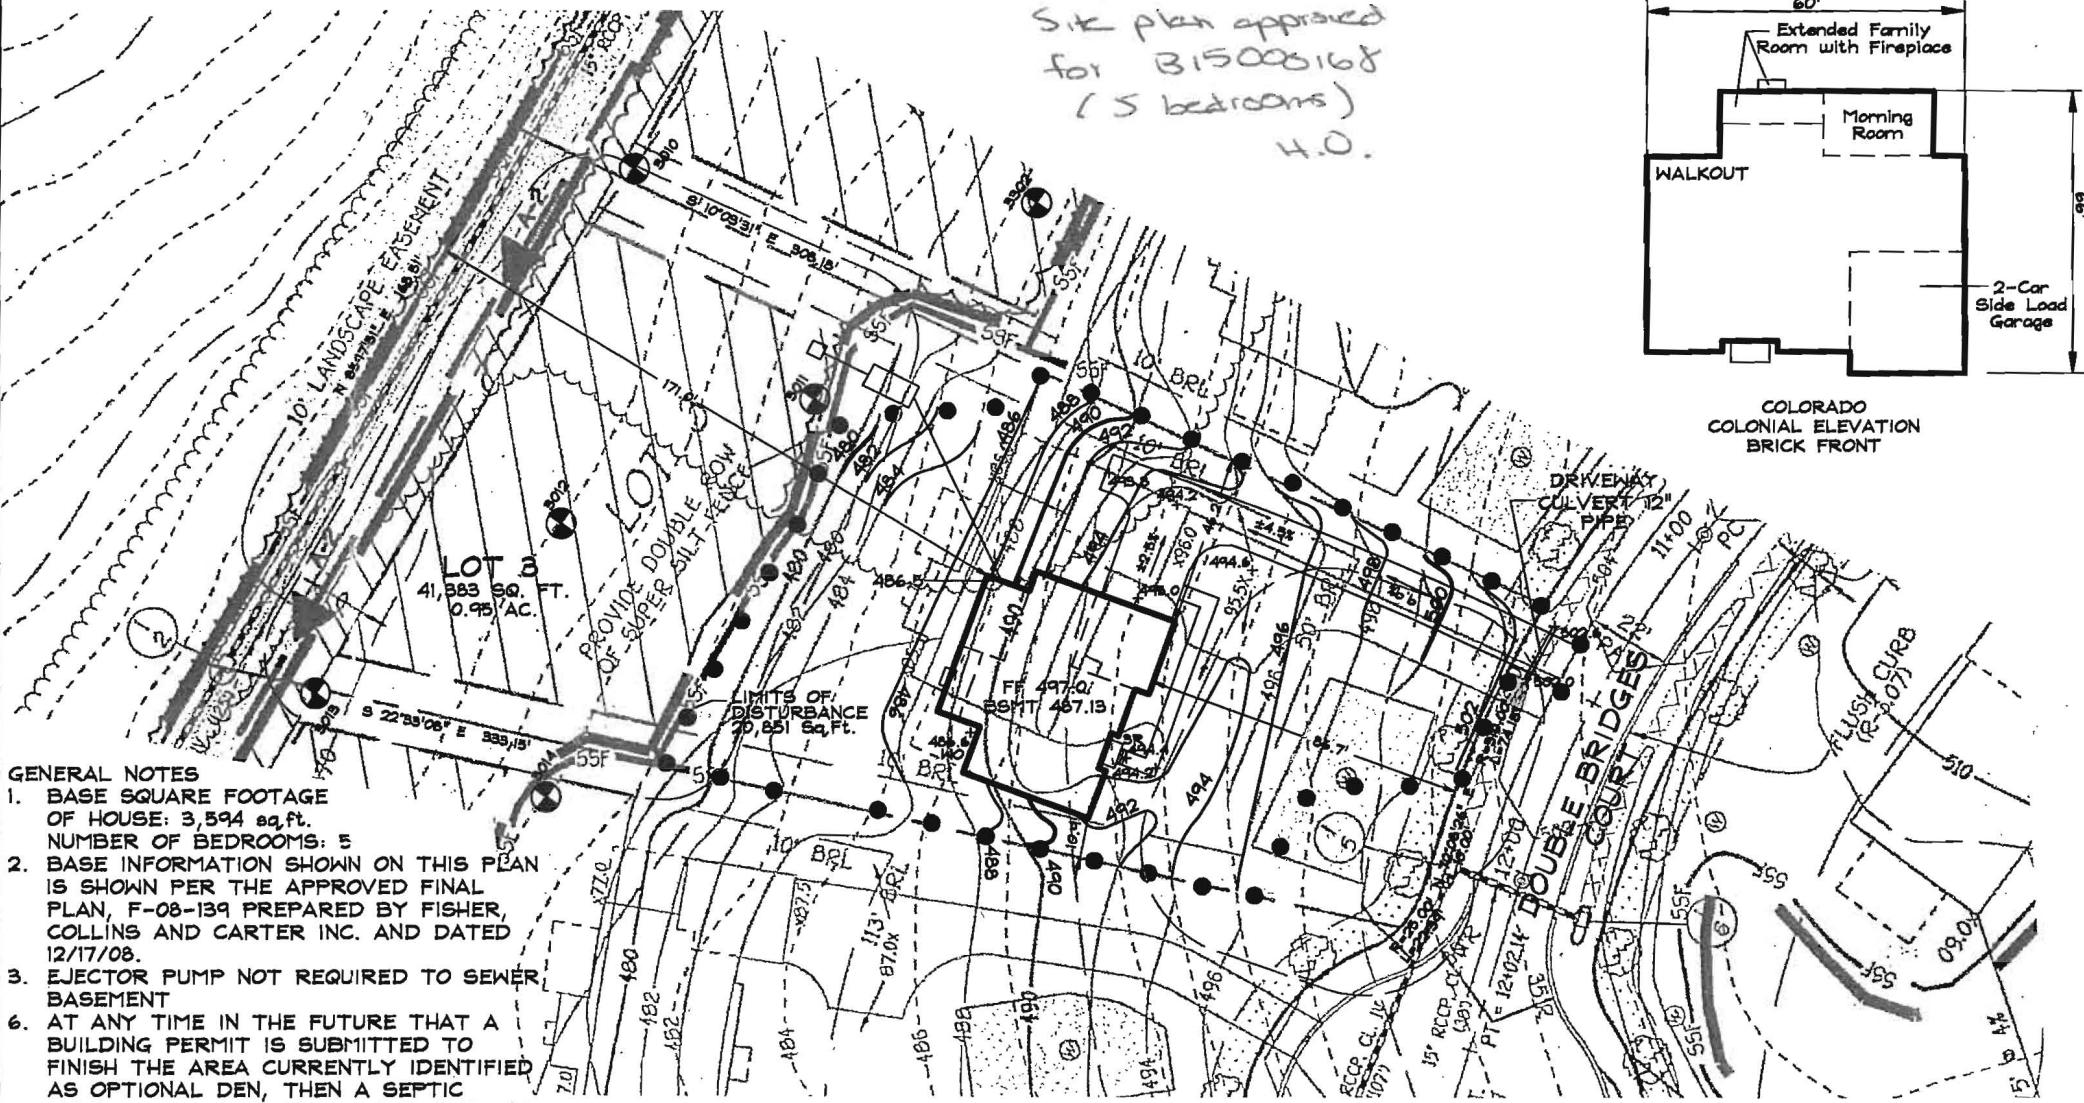

COLORADO
 COLONIAL ELEVATION
 BRICK FRONT

GENERAL NOTES

1. BASE SQUARE FOOTAGE OF HOUSE: 3,594 sq.ft.
 NUMBER OF BEDROOMS: 5
2. BASE INFORMATION SHOWN ON THIS PLAN IS SHOWN PER THE APPROVED FINAL PLAN, F-08-139 PREPARED BY FISHER, COLLINS AND CARTER INC. AND DATED 12/17/08.
3. EJECTOR PUMP NOT REQUIRED TO SEWER BASEMENT
6. AT ANY TIME IN THE FUTURE THAT A BUILDING PERMIT IS SUBMITTED TO FINISH THE AREA CURRENTLY IDENTIFIED AS OPTIONAL DEN, THEN A SEPTIC SYSTEM UPGRADE WILL BE REQUIRED AS FINISHING THE OPTIONAL DEN CREATES A SIXTH BEDROOM PER HOWARD COUNTY CODE 3.801(B).

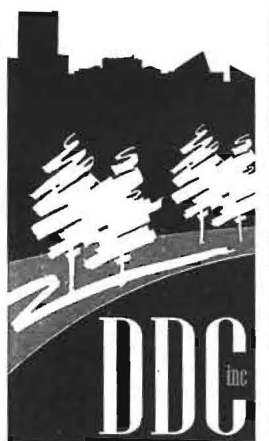

Development Design Consultants

Planners
 Surveyors
 Engineers
 Landscape Architects

192 East Main Street
 Westminster, MD 21157
 410.386.0560
 410.386.0564 (Fax)
 DDC@DDCinc.us
 www.DDCinc.us

DDC JOB#: 06116.5

DATE: 01/12/15

SCALE: 1" = 50'

DES. BY: BKC

DRN. BY: BKC


CHK. BY: BKC

MERIWETHER FARM
 4TH ELECTION DISTRICT HOWARD COUNTY
 TAX MAP 21 PARCEL 24


LOT 3
 15046 DOUBLE BRIDGES COURT
 GLENWOOD, MD 21738
 PLOT PLAN
 KHOV ELEVATION

OWNER/BUILDER: K.HOVNANIAN HOMES
 1802 Brightseat Road
 Landover, Maryland 20785
 (301)683-6268

2/12/15
 Site plan approved
 for B15000168
 (5 bedrooms)
 H.O.

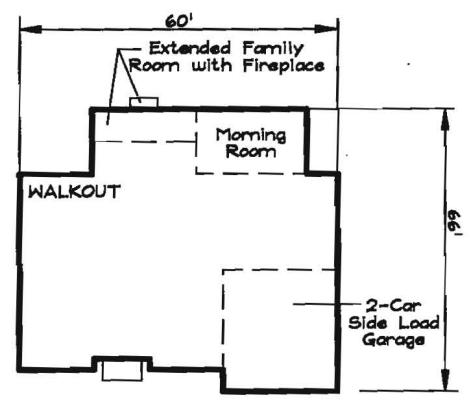


COLORADO
 COLONIAL ELEVATION
 BRICK FRONT

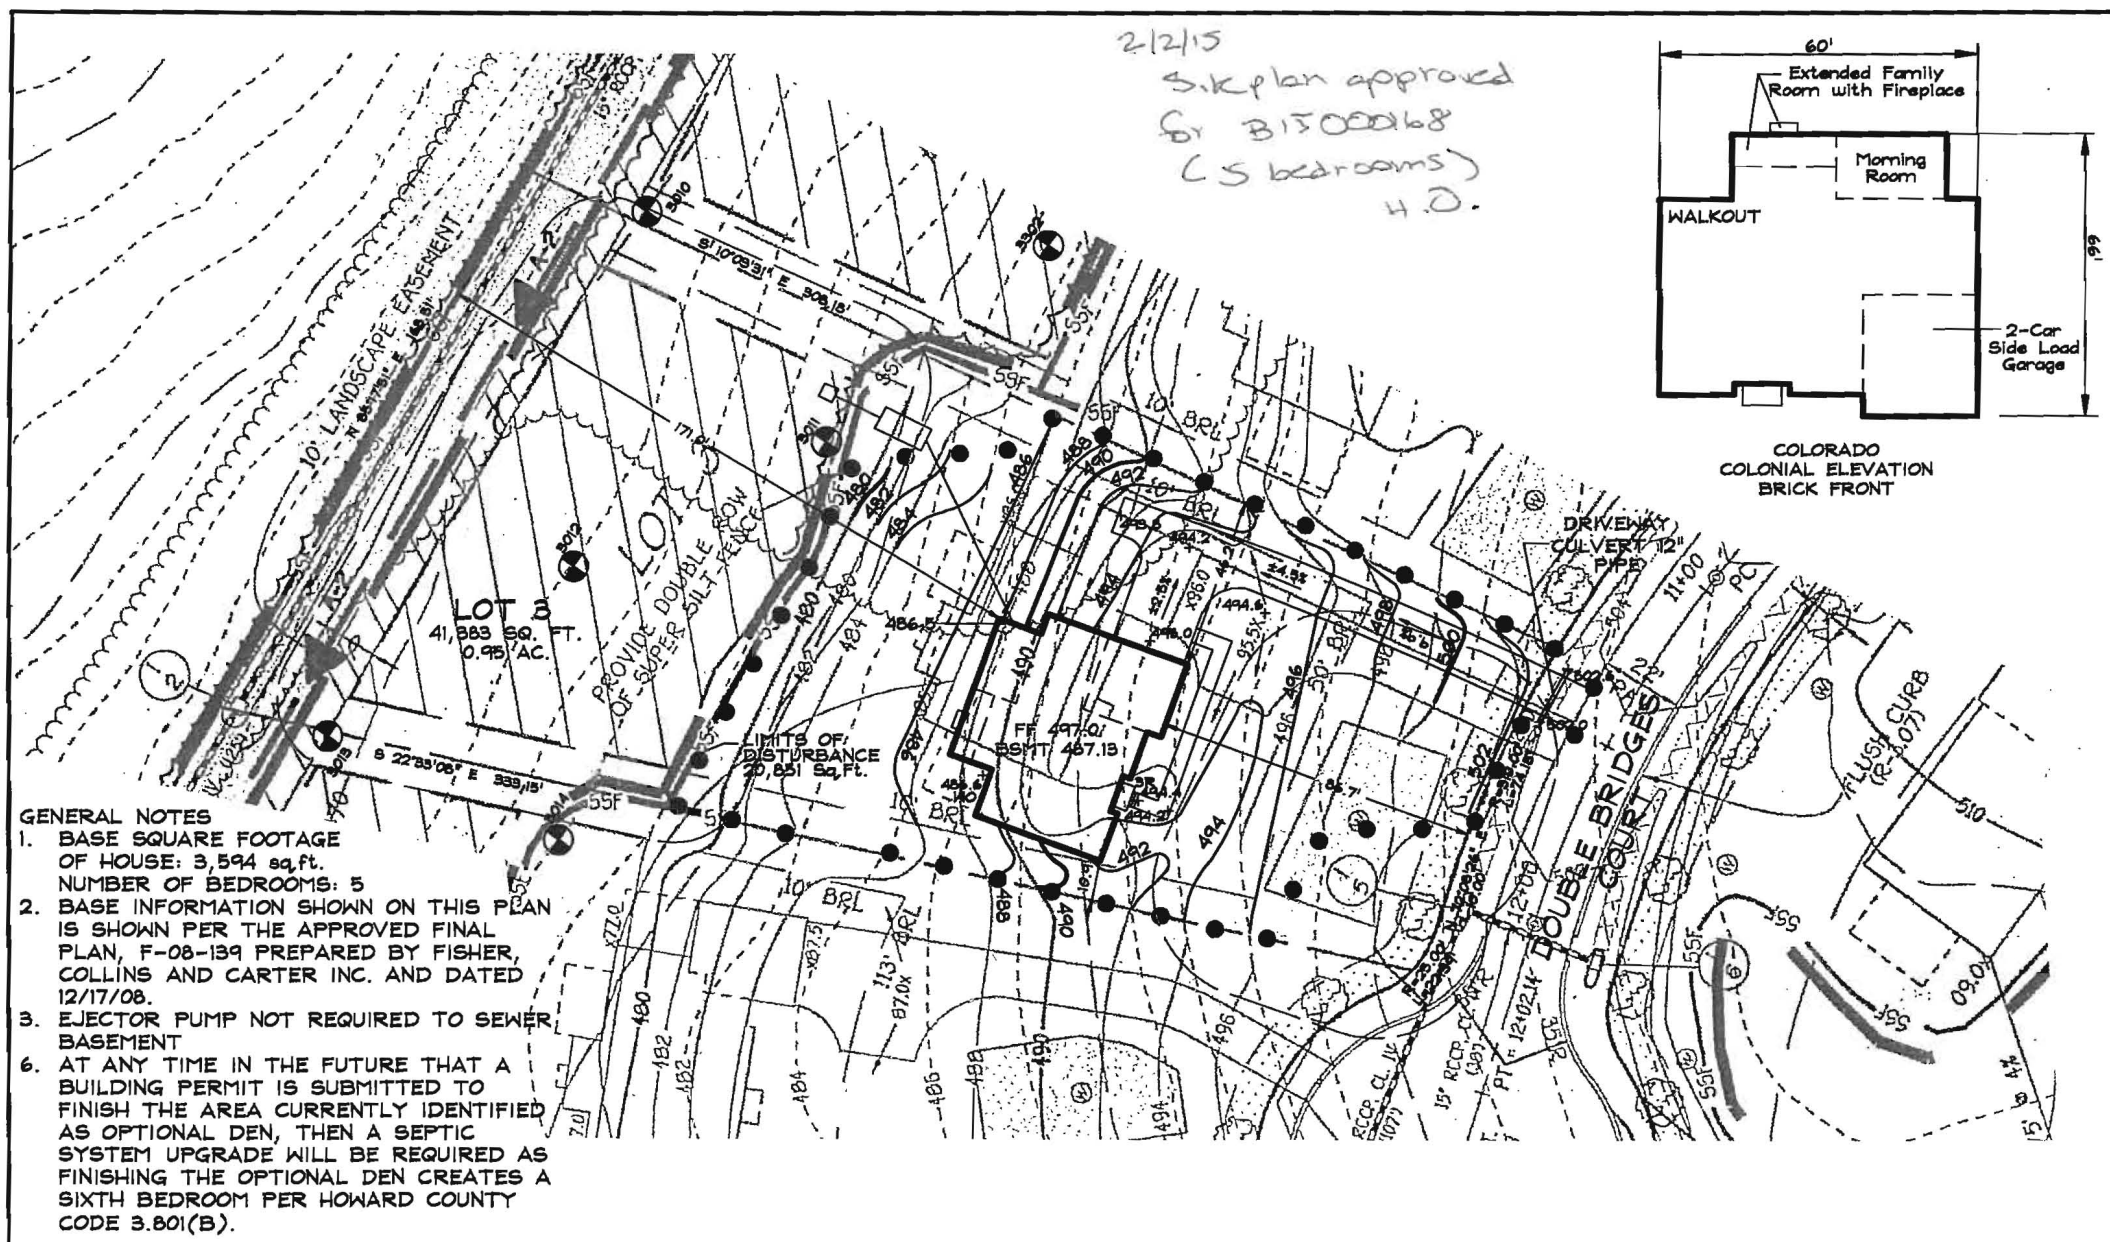

GENERAL NOTES

1. BASE SQUARE FOOTAGE OF HOUSE: 3,594 sq.ft.
 NUMBER OF BEDROOMS: 5
2. BASE INFORMATION SHOWN ON THIS PLAN IS SHOWN PER THE APPROVED FINAL PLAN, F-08-139 PREPARED BY FISHER, COLLINS AND CARTER INC. AND DATED 12/17/08.
3. EJECTOR PUMP NOT REQUIRED TO SEWER BASEMENT
6. AT ANY TIME IN THE FUTURE THAT A BUILDING PERMIT IS SUBMITTED TO FINISH THE AREA CURRENTLY IDENTIFIED AS OPTIONAL DEN, THEN A SEPTIC SYSTEM UPGRADE WILL BE REQUIRED AS FINISHING THE OPTIONAL DEN CREATES A SIXTH BEDROOM PER HOWARD COUNTY CODE 3.801(B).

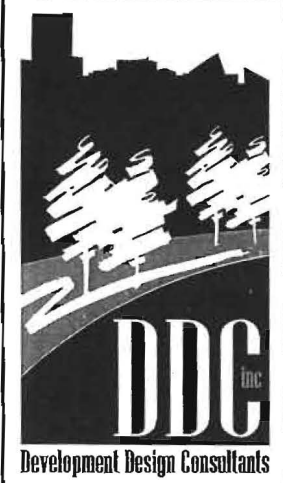

Planners
 Surveyors
 Engineers
 Landscape Architects

192 East Main Street
 Westminster, MD 21157
 410.386.0560
 410.386.0564 (Fax)
 DDC@DDCinc.us
 www.DDCinc.us







DDC JOB#:	06116.5
DATE:	01/12/15
SCALE:	1" = 50'
DES. BY:	BKC
DRN. BY:	BKC
CHK. BY:	BKC

MERIWETHER FARM
 4TH ELECTION DISTRICT HOWARD COUNTY
 TAX MAP 21 PARCEL 24

LOT 3
 15046 DOUBLE BRIDGES COURT
 GLENWOOD, MD 21738
 PLOT PLAN
 KHOV ELEVATION

OWNER/BUILDER: K.HOVNANIAN HOMES
 1802 Brightseat Road
 Landover, Maryland 20785
 (301)683-6268

SCALE:
 1/8" = 1'-0" @ 11 x 17
 1/4" = 1'-0" @ 24 X 36

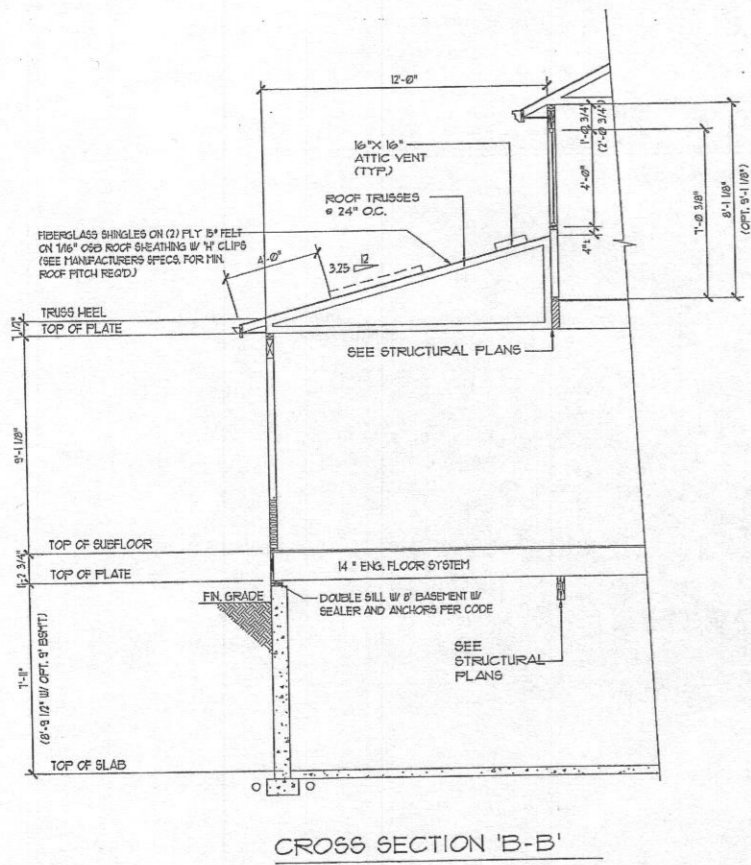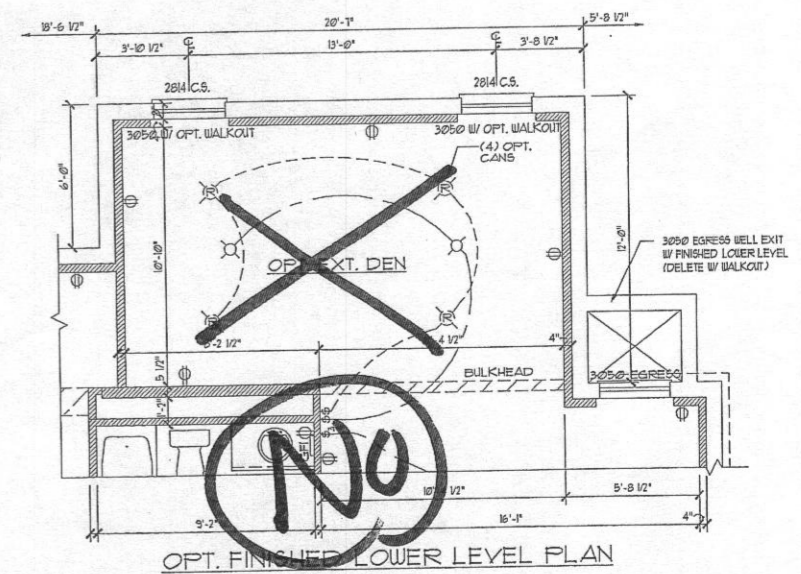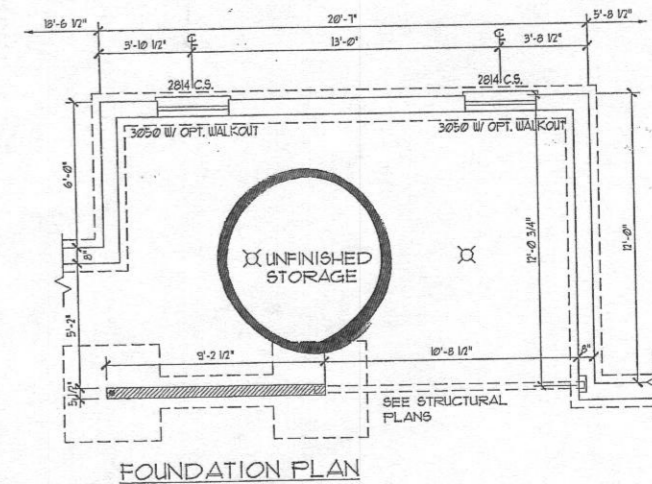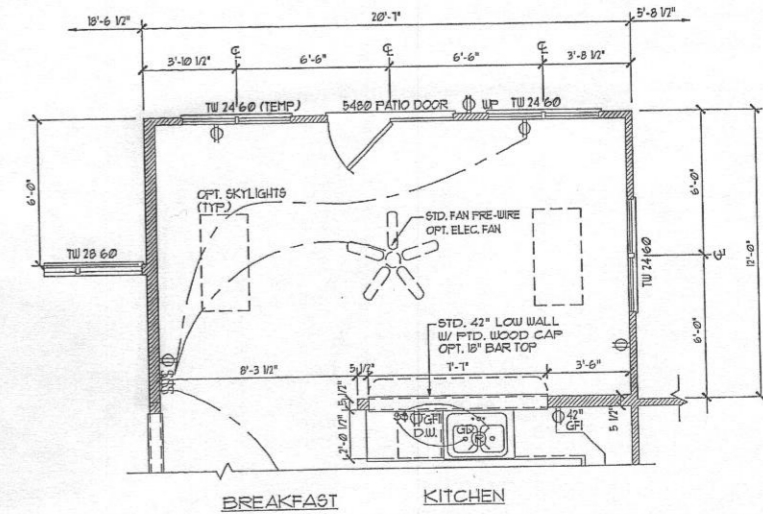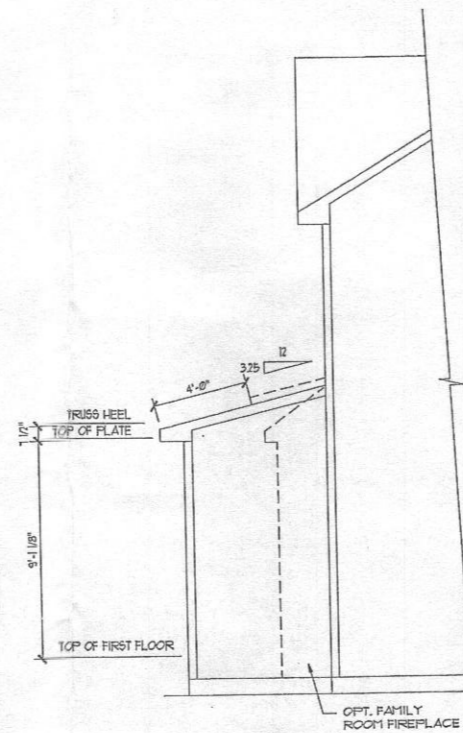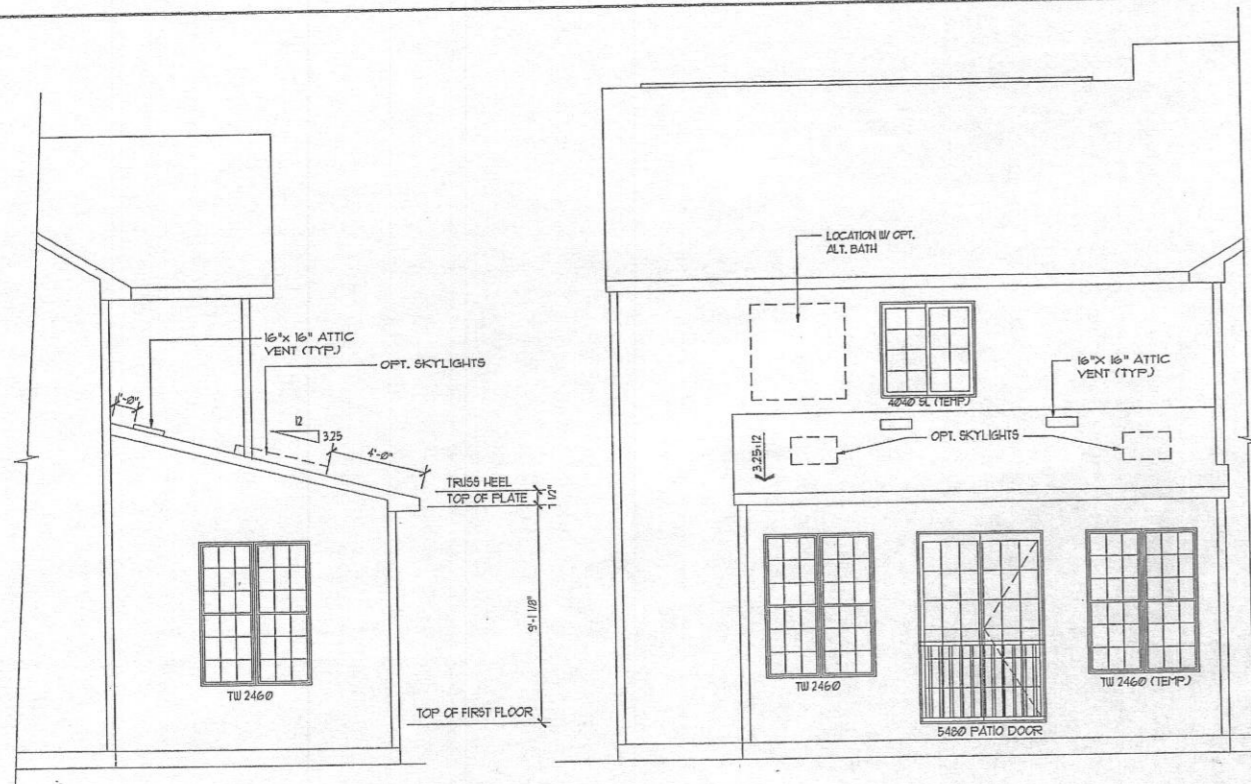

SHEET NUMBER
6F

SCALE

DRAWN BY
AC-RC

DATE
9-22-98


REV.#	DATE	REMARKS
01	09-23-98	17' MORNING ROOM
02	09-23-98	REVISED BASEMENT FINISHES

REV.#	DATE	REMARKS
03	11-11-01	2006 INC CONVERSION
04	01-14-06	0-15-00 JK-200-01
05	01-15-00	JK-200-01
06	11-22-00	JK-200-01
07	02-16-02	436-09

MODEL
COLORADO

SET #

Architecture Collaborative, Inc. expressly reserves its copyright and other property rights in these plans and drawings. These plans and drawings are not to be reproduced in any form or manner without written consent.

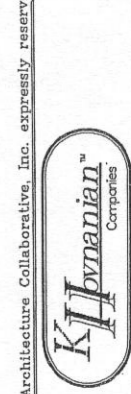

COLORADO
 OPT. MORNING ROOM KV_003_6F

SCALE:
 1/8" = 1'-0" @ 11 x 17
 1/4" = 1'-0" @ 24 X 36









NOTES:
 • W/ OPT. 2ND FLOOR WINDOWS
 REMAIN AT 1'-0" 3/8" HEAD
 HEIGHT W/ WINDOW SIZES AS
 SHOWN
 • SEE ELEVATIONS FOR FOYER
 WINDOW HEAD HEIGHT.

SHEET NUMBER	5A
SCALE	
DRAWN BY	ACI
DATE	02-01-12

REV#	DATE	REVISION

REV#	DATE	REVISION

MODEL	COLORADO
SET #	

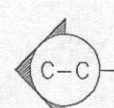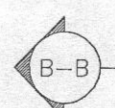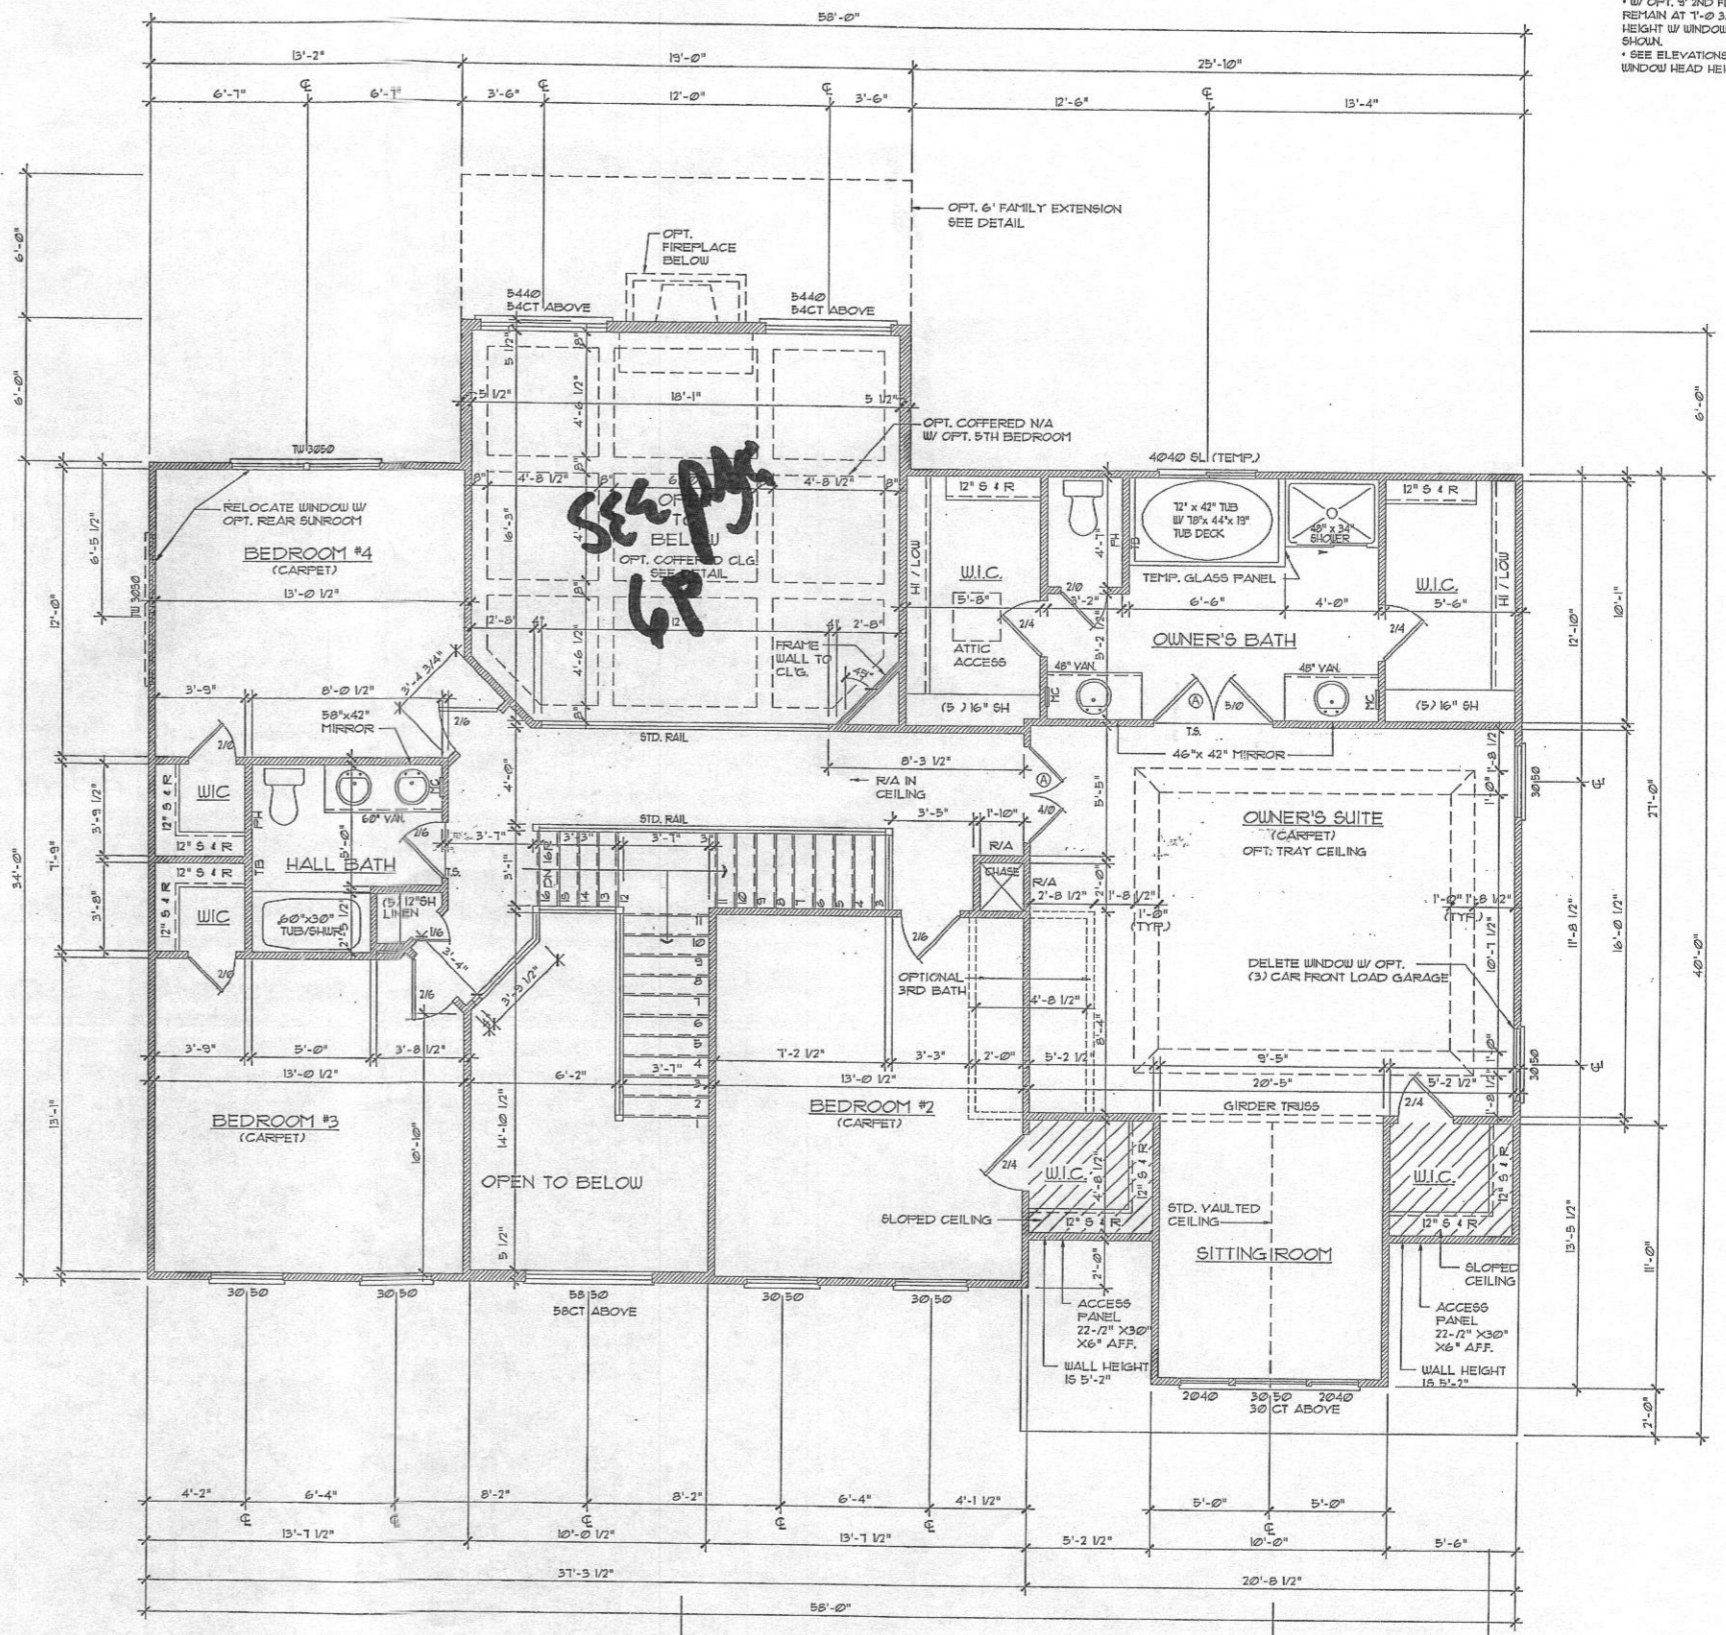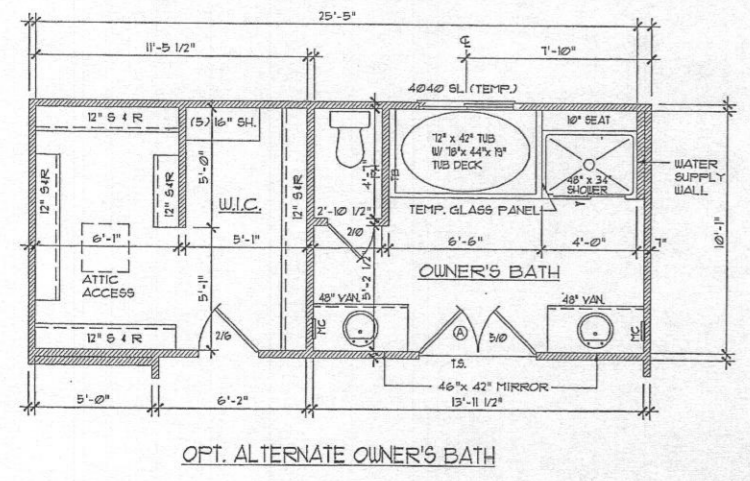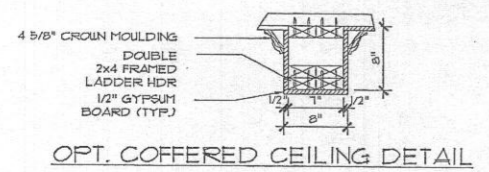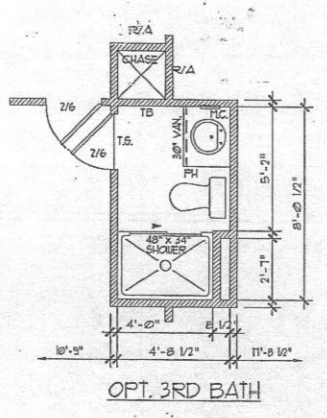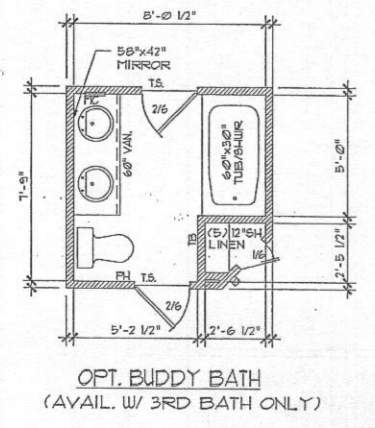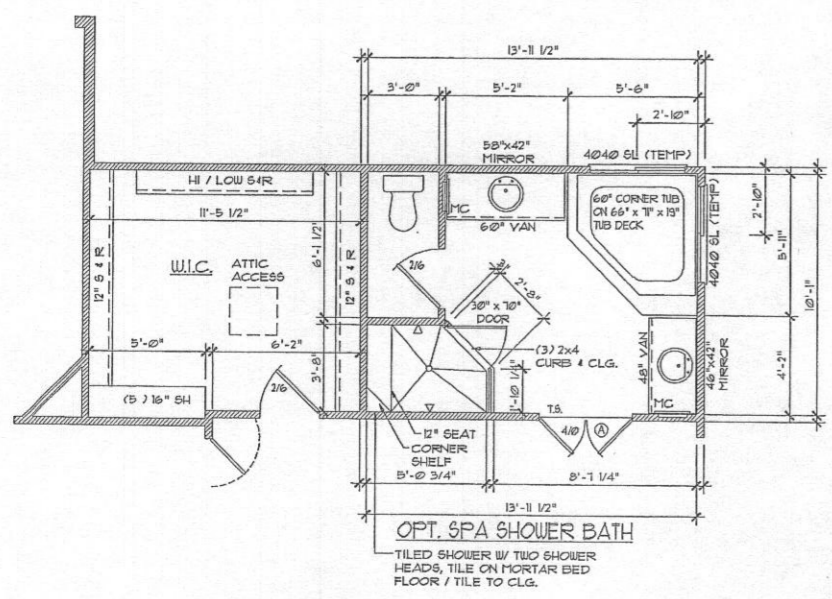

SECOND FLOOR PLAN
 TRADITIONAL ELEVATION

COLORADO
 KV_003_5A

SCALE:
 1/8" = 1'-0" @ 11 x 17
 1/4" = 1'-0" @ 24 X 36

SHEET NUMBER
 4A

SCALE

DRAWN BY
 ACI

DATE
 02-01-12

REV#	DATE	REMARKS


REV#	DATE	REMARKS

MODEL
 COLORADO






SET #




COLORADO
 KV_003_4A

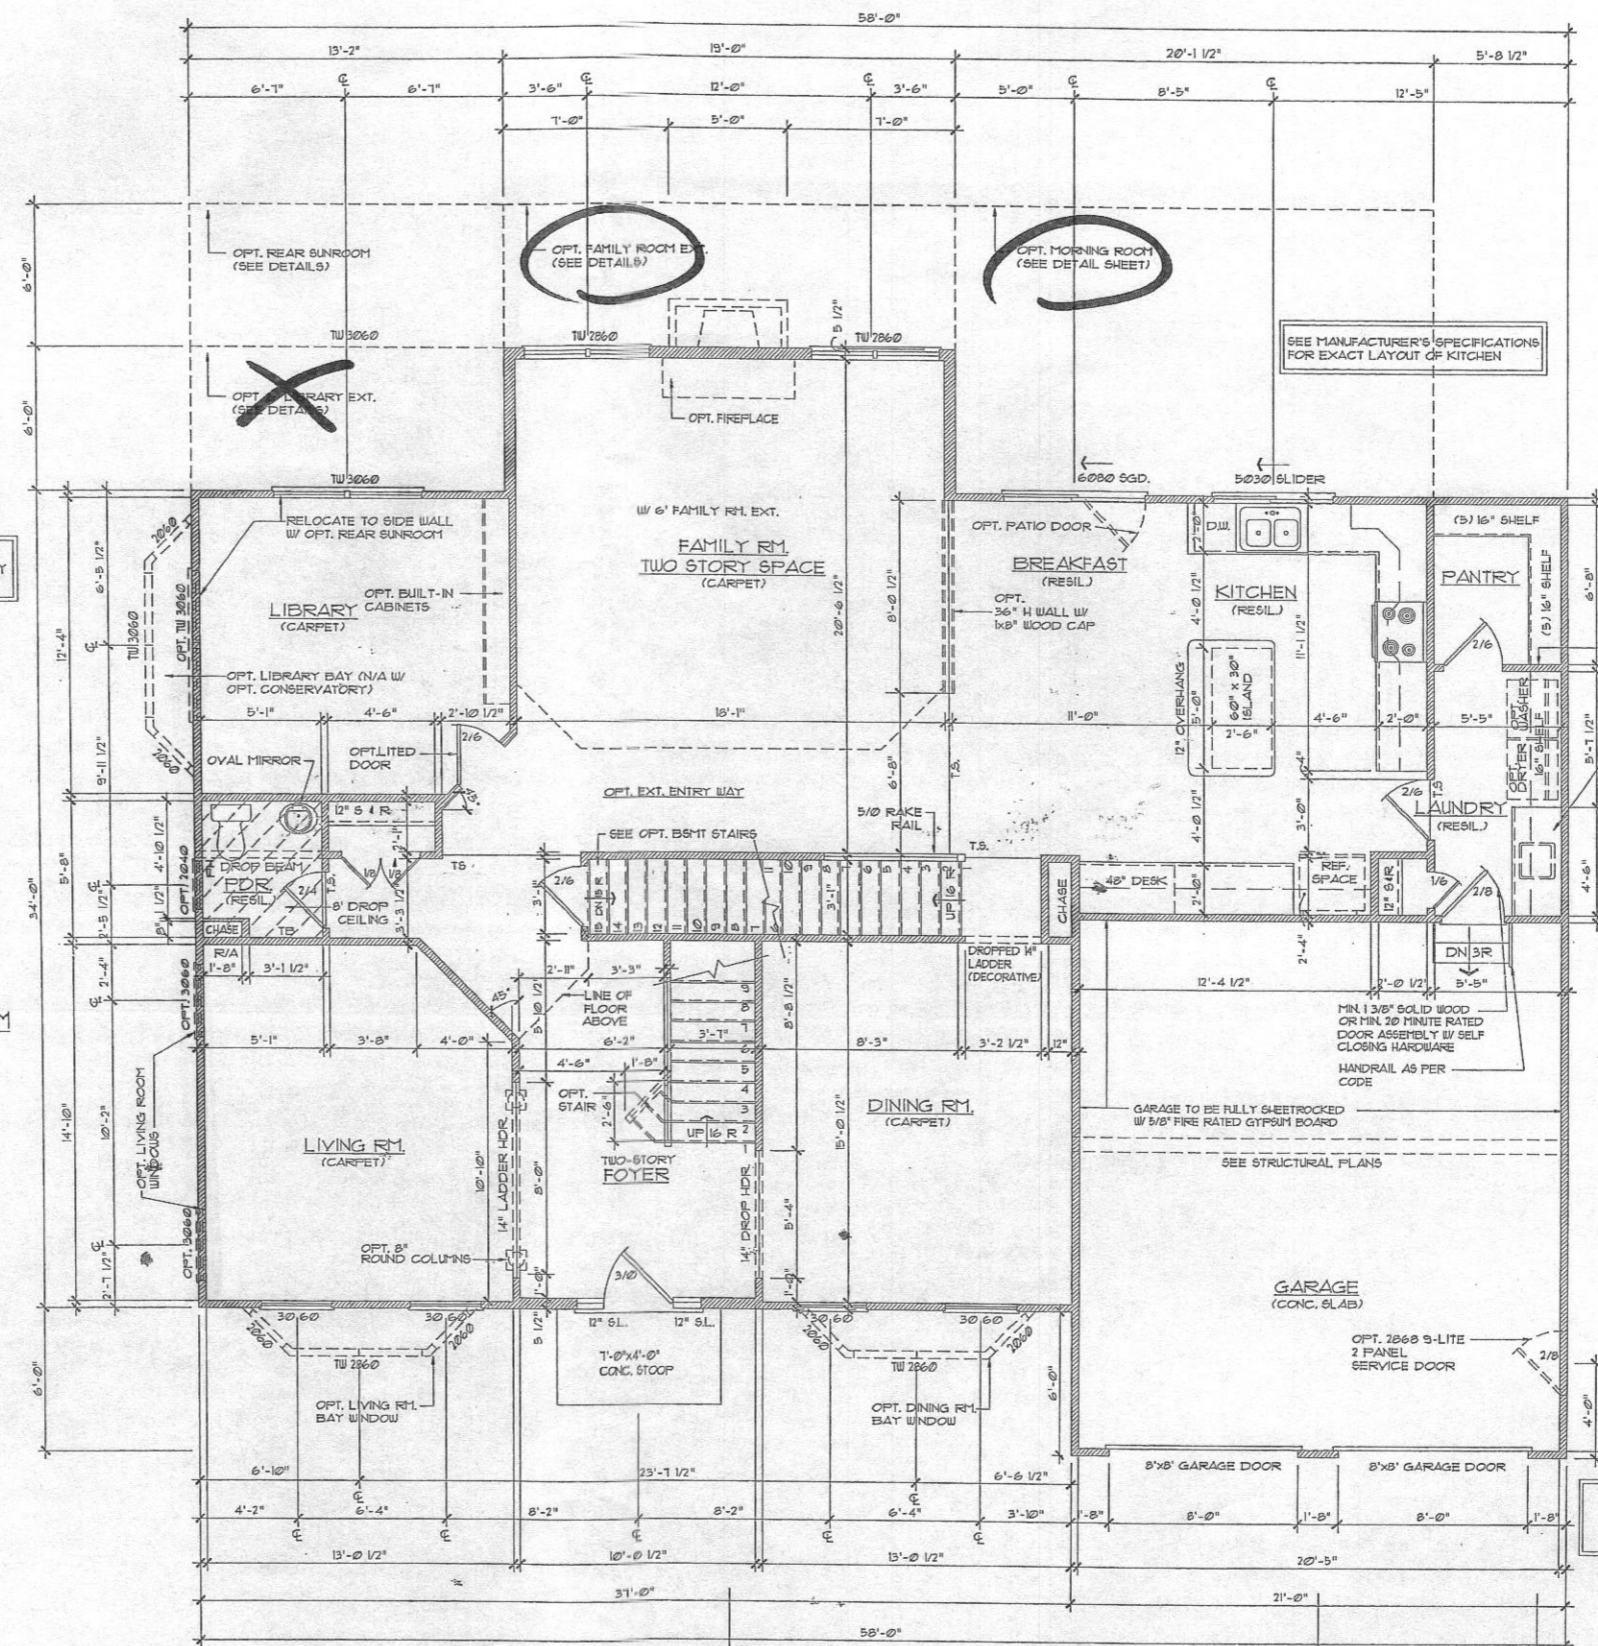

FIRST FLOOR PLAN
 TRADITIONAL ELEVATION

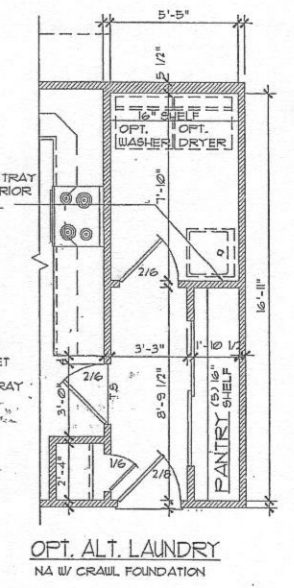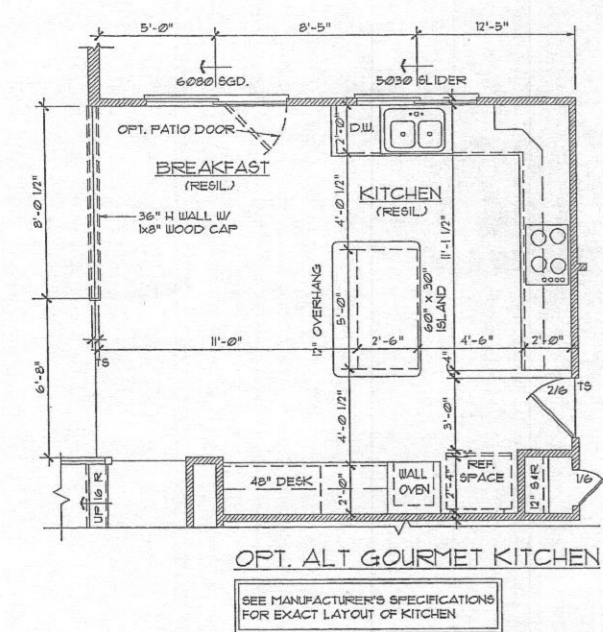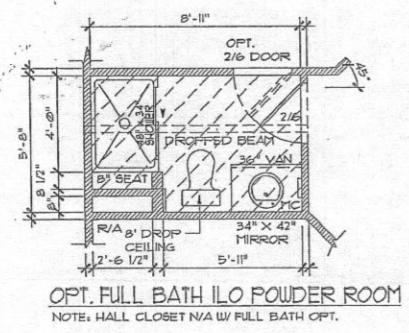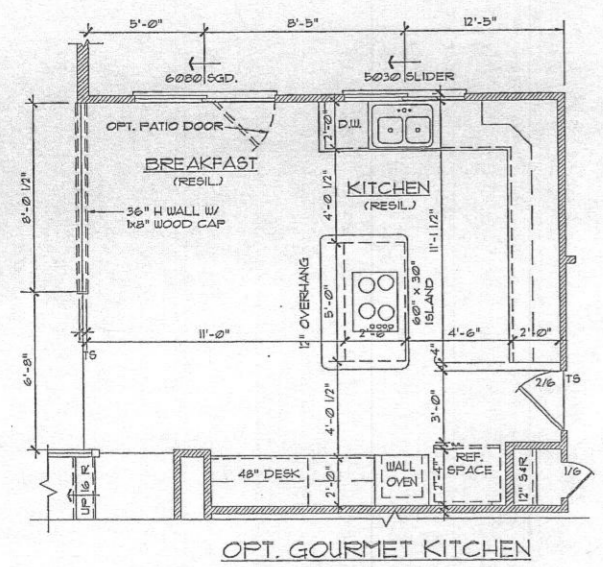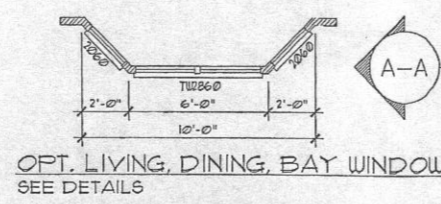

NOTE:
 OPT. SIDE LOAD GARAGE &
 OPT. (3) CAR GARAGE
 (SEE DETAILS)

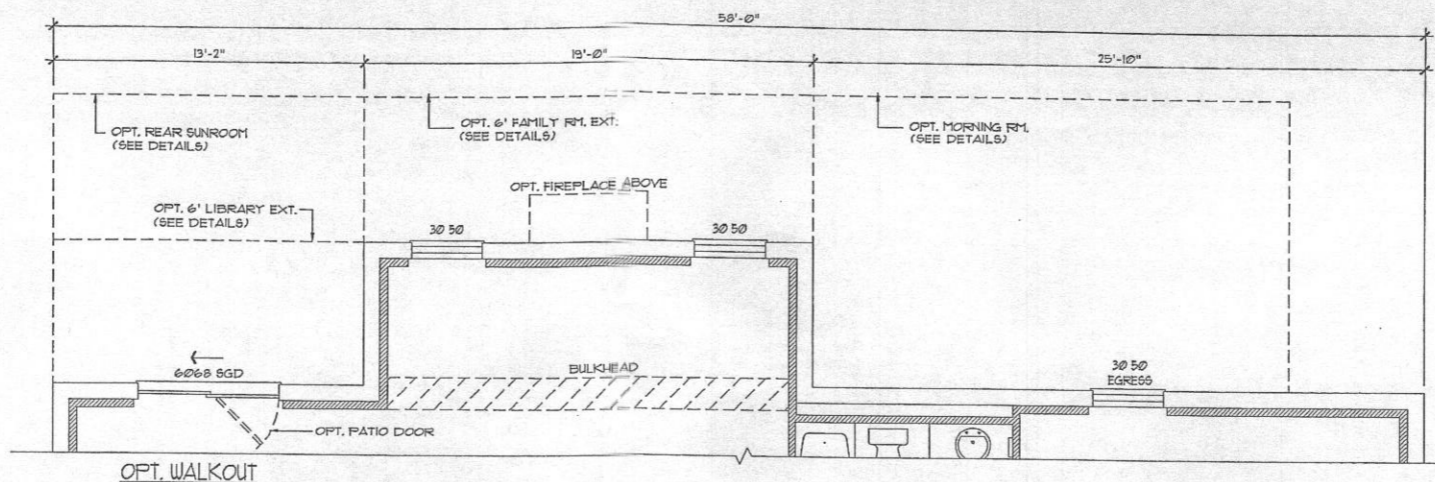


STAIR NOTES:
 8' BASEMENT
 14" FLOOR SYSTEM
 HEIGHT = 9'-1 3/4" (3/4")
 15 EQUAL RISERS
 RISERS = 13 1/4" (MAX)
 TREADS = 10"

STAIR NOTES:
 9' BASEMENT
 14" FLOOR SYSTEM
 HEIGHT = 10'-0 1/4" (3/4")
 16 EQUAL RISERS
 RISERS = 13 1/4" (MAX)
 TREADS = 10"


SCALE:
 1/8" = 1'-0" @ 11 x 17
 1/4" = 1'-0" @ 24 x 36

SHEET NUMBER	3E
SCALE	
DRAWN BY	ACI
DATE	02-01-12


REV.#	DATE	REMARKS

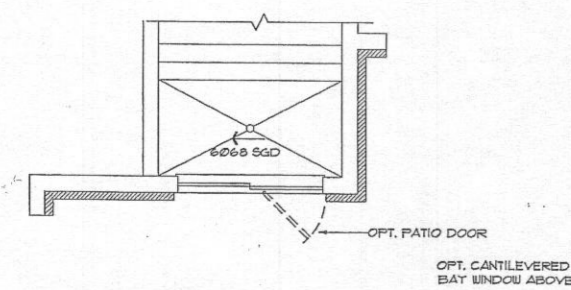

OPT. 6068 SGD AREAWAY

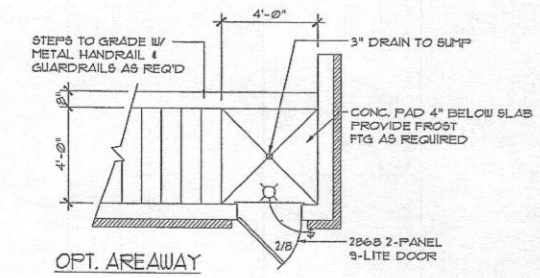

OPT. AREAWAY

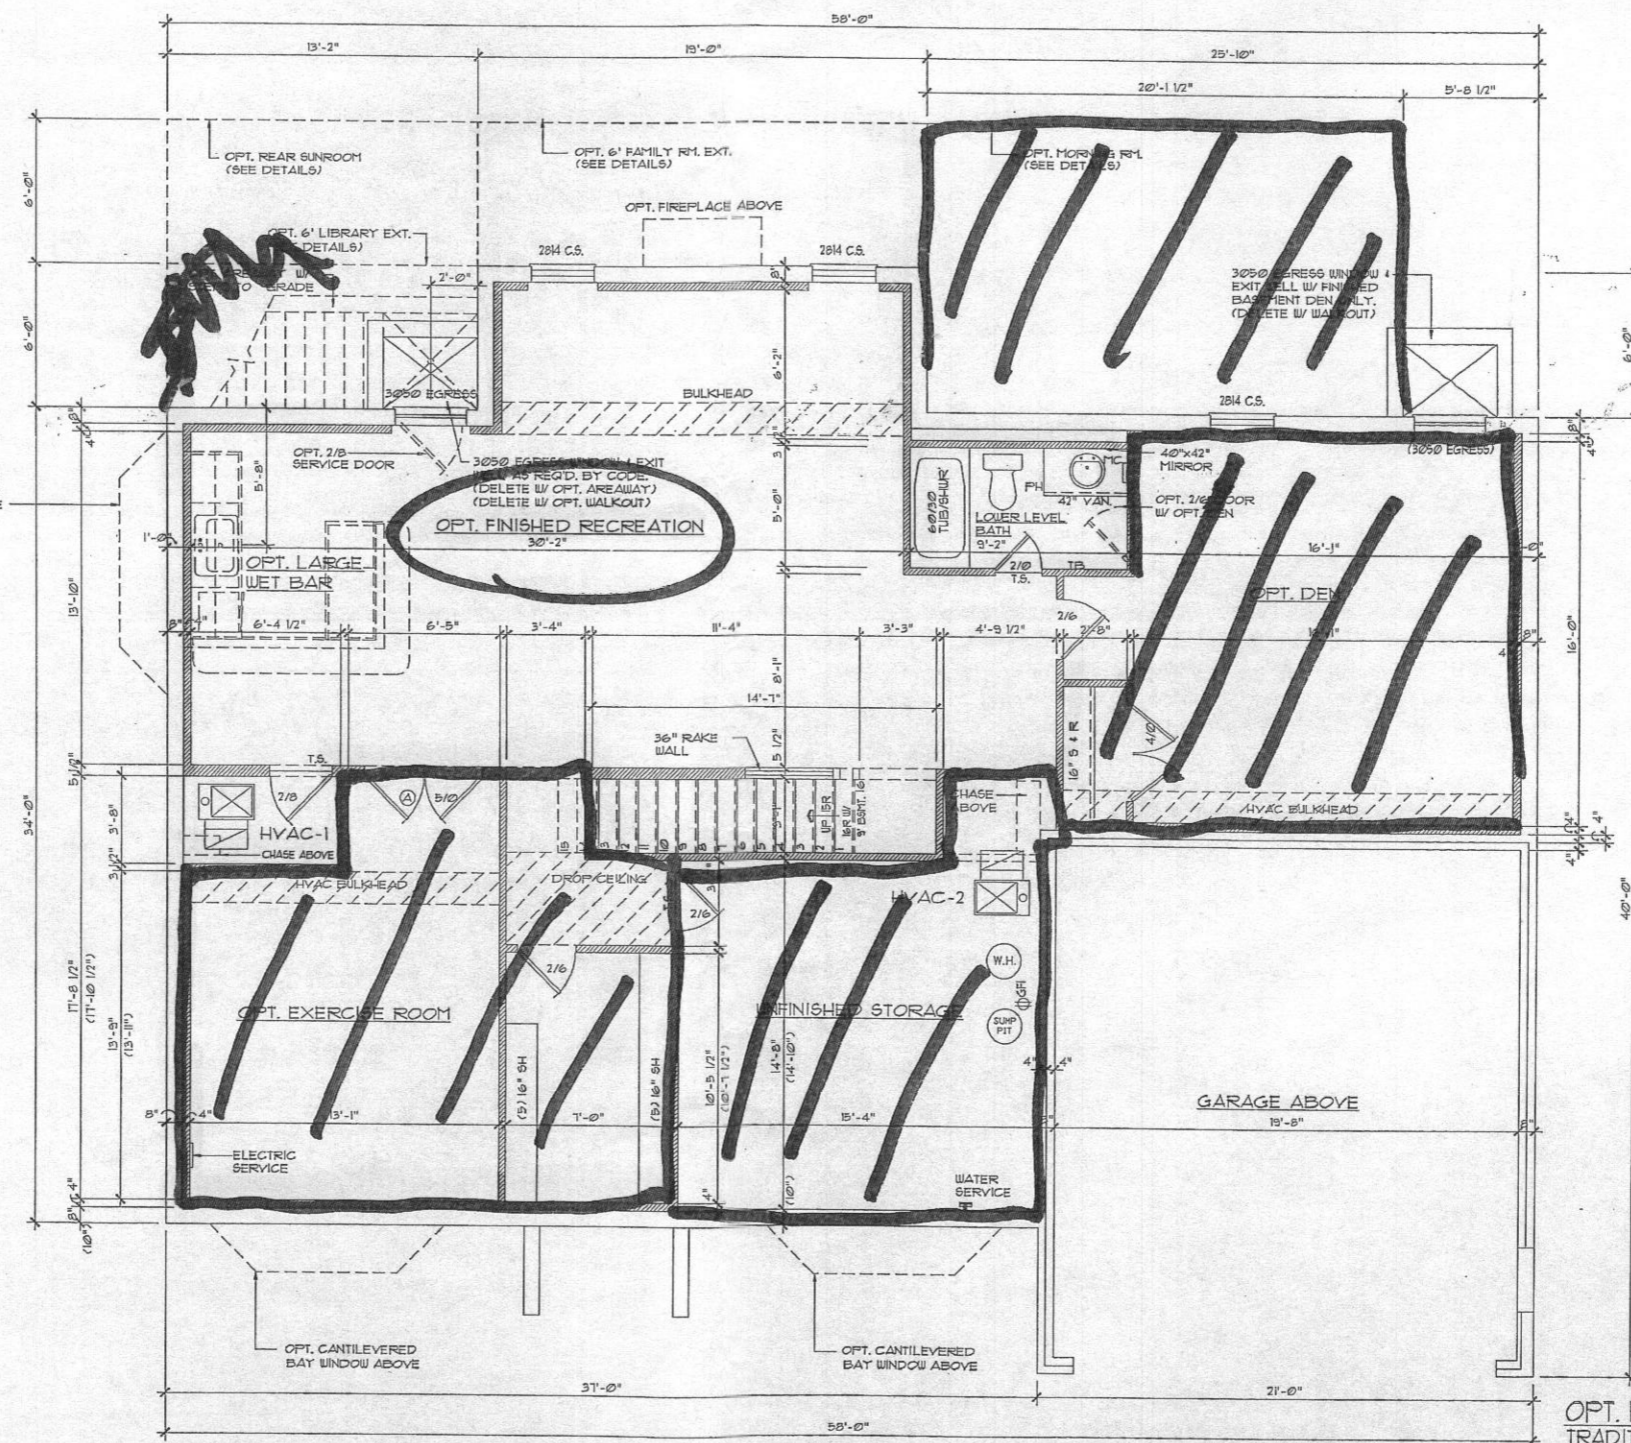

OPT. FINISHED LOWER LEVEL
 TRADITIONAL ELEVATION
 (W/ 8' x 9' EIGHT)

COLORADO
 KV_003_3E




Architecture Collaborative, Inc. expressly reserves its copyright and other property rights in these plans and drawings. These plans and drawings are not to be reproduced in any form or manner without written consent.

Kipmanian
 Companies


SCALE:
 1/8" = 1'-0" @ 11 x 17
 1/4" = 1'-0" @ 24 x 36

STAIR NOTES:
 0' BASEMENT
 1/4" FLOOR SYSTEM
 HEIGHT = 9'-1 3/4" (3/4")
 15 EQUAL RISERS
 RISERS = 13 1/4" (MAX)
 TREADS = 10"
 DBL. SILL W/ 0' BASEMENT

STAIR NOTES:
 0' BASEMENT
 1/4" FLOOR SYSTEM
 HEIGHT = 10'-0 1/4" (3/4")
 16 EQUAL RISERS
 RISERS = 15 6" (MAX)
 TREADS = 10"

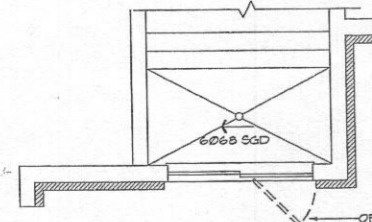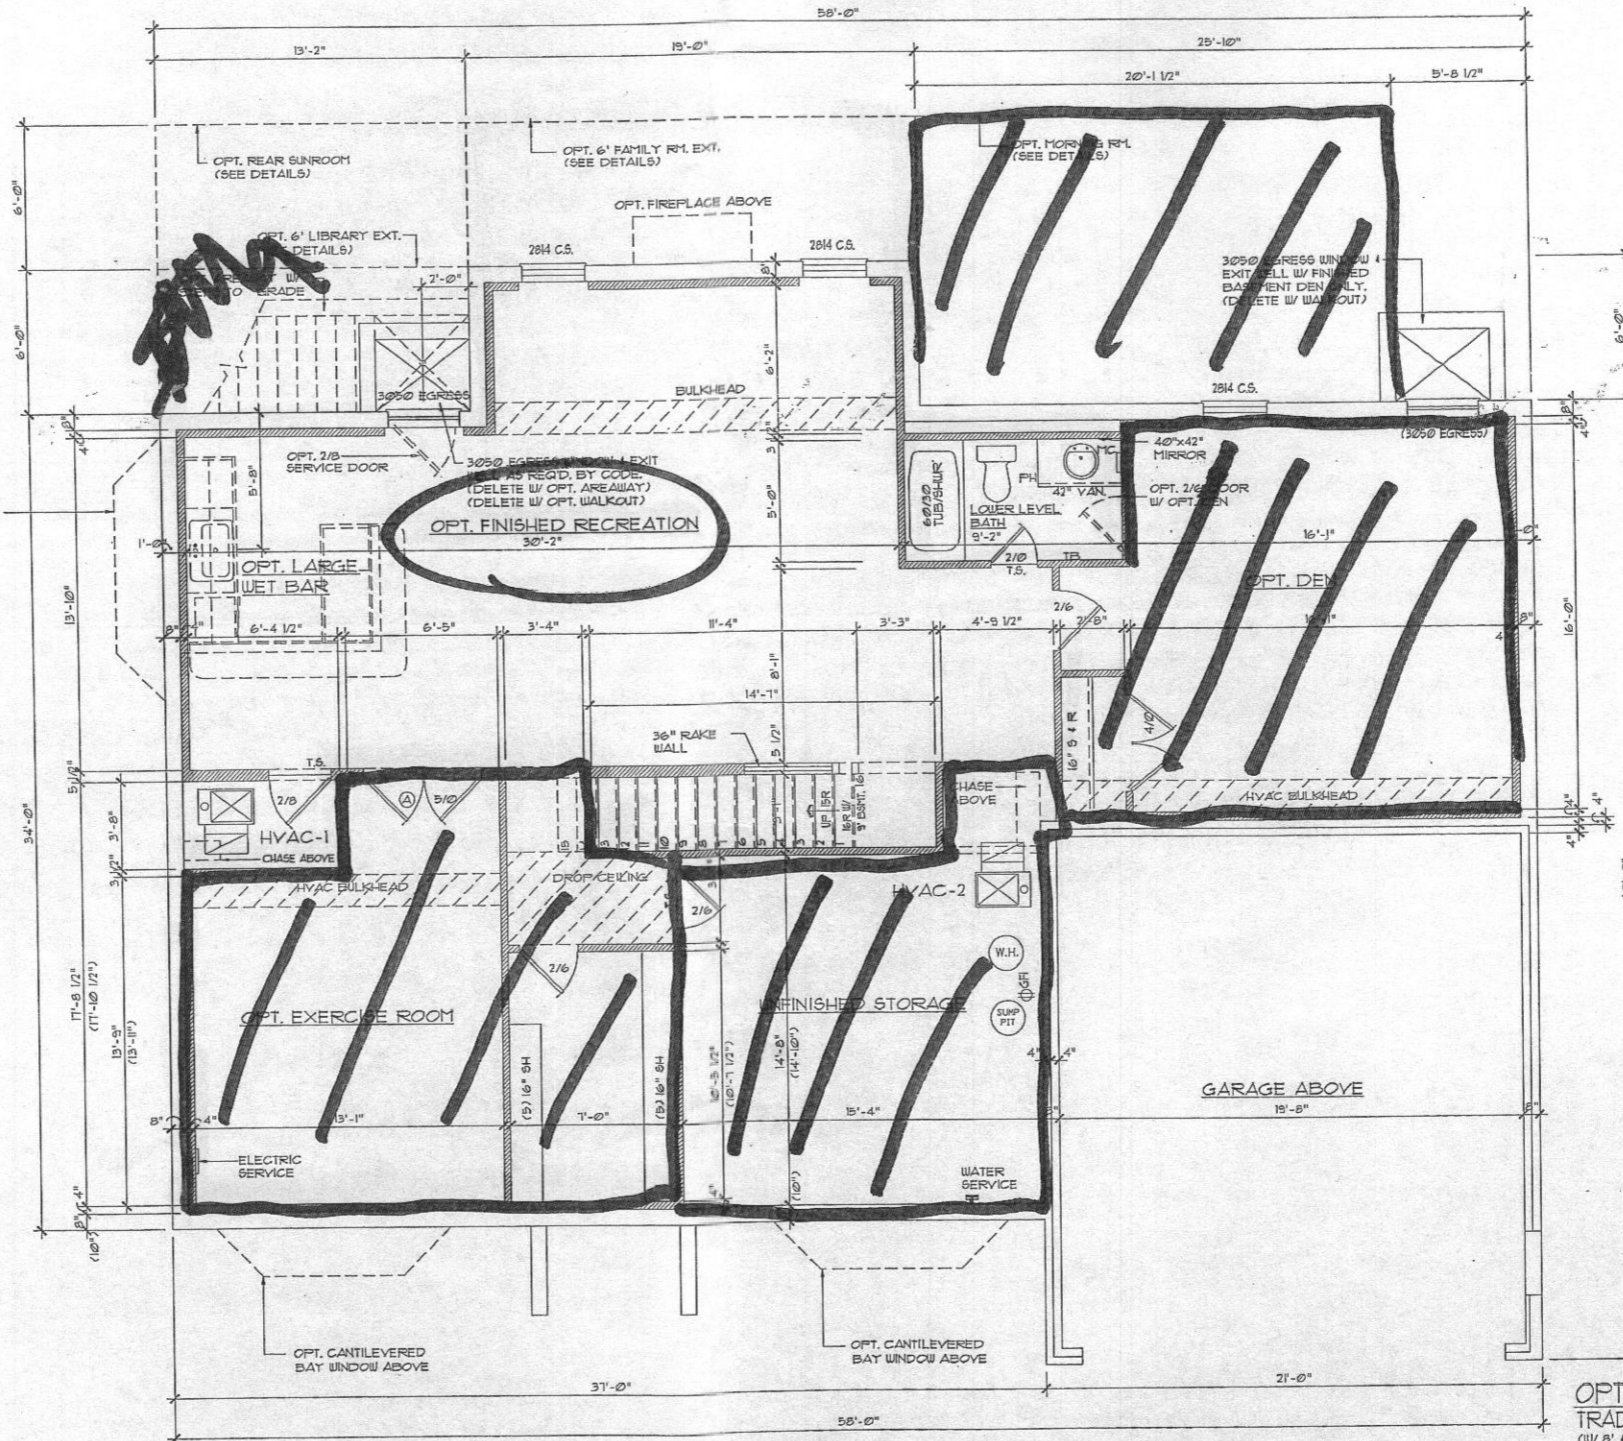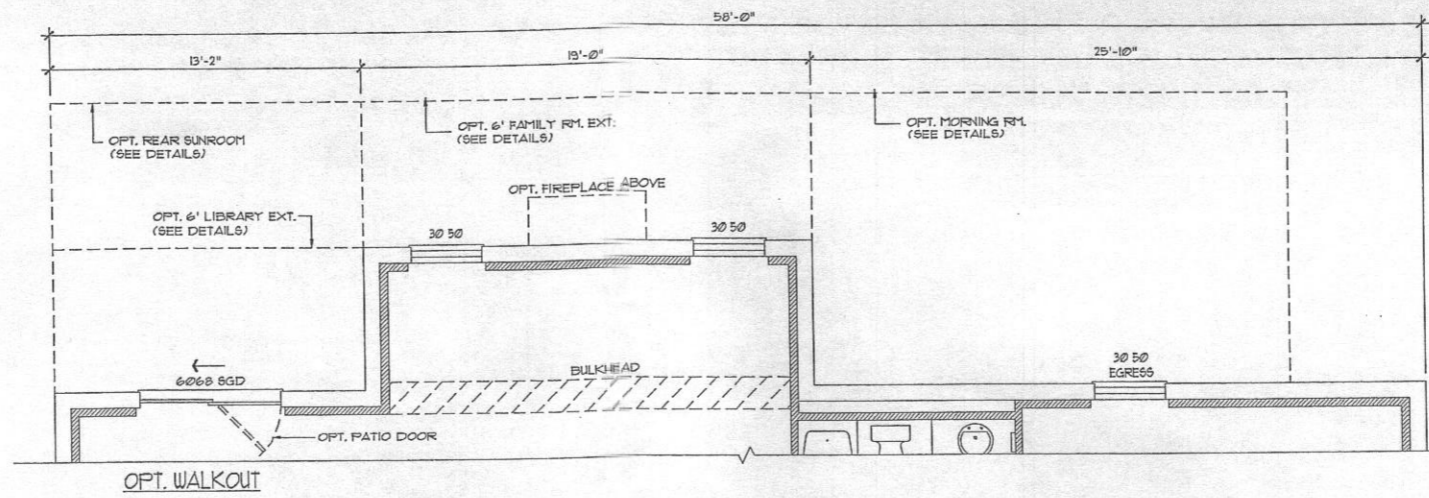

OPT. 6068 SGD AREAWAY

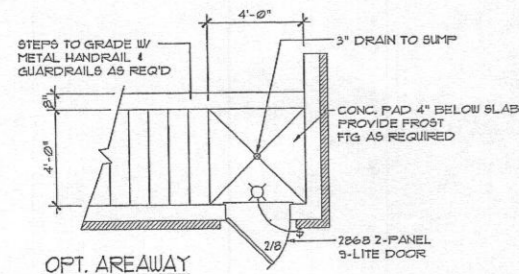

OPT. AREAWAY

Architecture Collaborative, Inc. expressly reserves its copyright and other property rights in these plans and drawings. These plans and drawings are not to be reproduced in any form or manner without written consent.

SHEET NUMBER	3E	
SCALE		
DRAWN BY	ACI	
DATE	02-01-12	
REV#	DATE	REMARKS
1	02-23-12	12 MORNING ROOM
2	02-27-12	12 MORNING ROOM

MODEL COLORADO




KLIPMANIAN
 Companies

OPT. FINISHED LOWER LEVEL
 TRADITIONAL ELEVATION
 (W/ 0' & 0' BSMT.)

COLORADO
 KV_003_3E

SCALE:
 1/8" = 1'-0" @ 11 x 17
 1/4" = 1'-0" @ 24 X 36

NOTES:
 * W/ OPT. 2ND FLOOR WINDOWS
 REMAIN AT 1'-0" 3/8" HEAD
 HEIGHT W/ WINDOW SIZES AS
 SHOWN.
 * SEE ELEVATIONS FOR FOTER
 WINDOW HEAD HEIGHT.

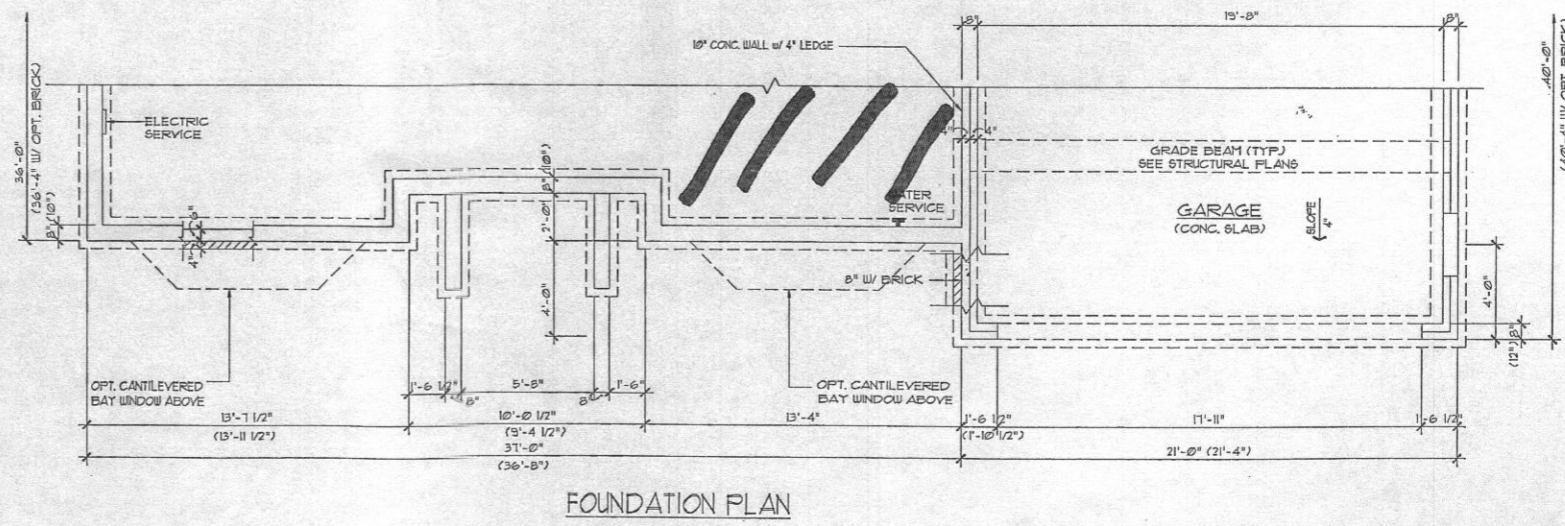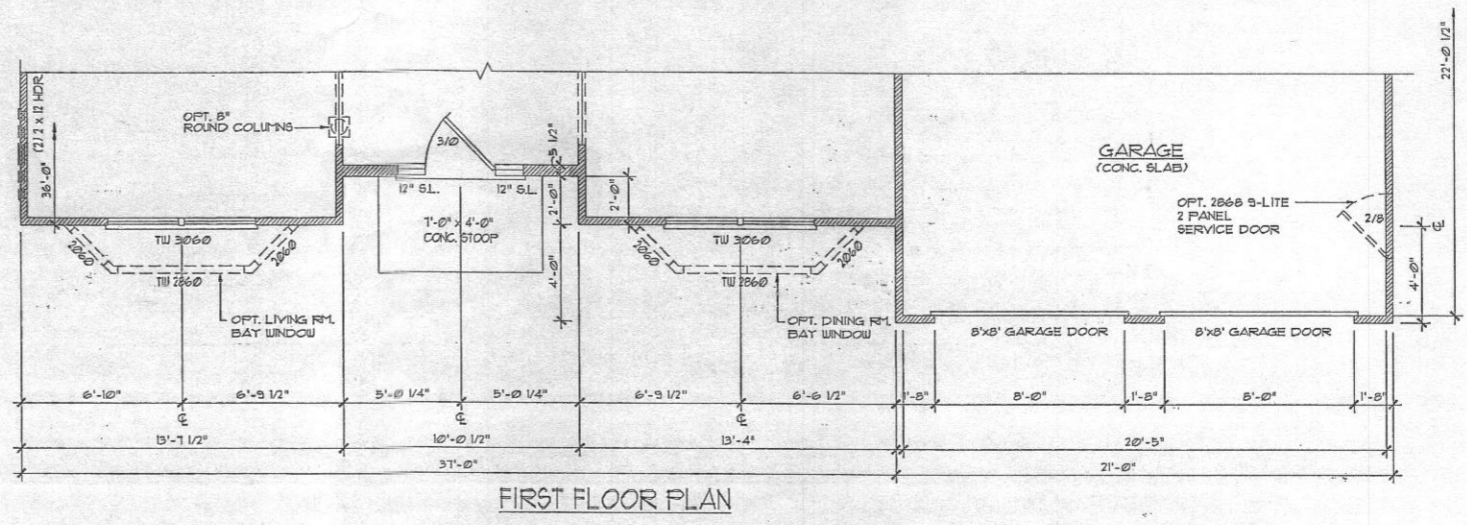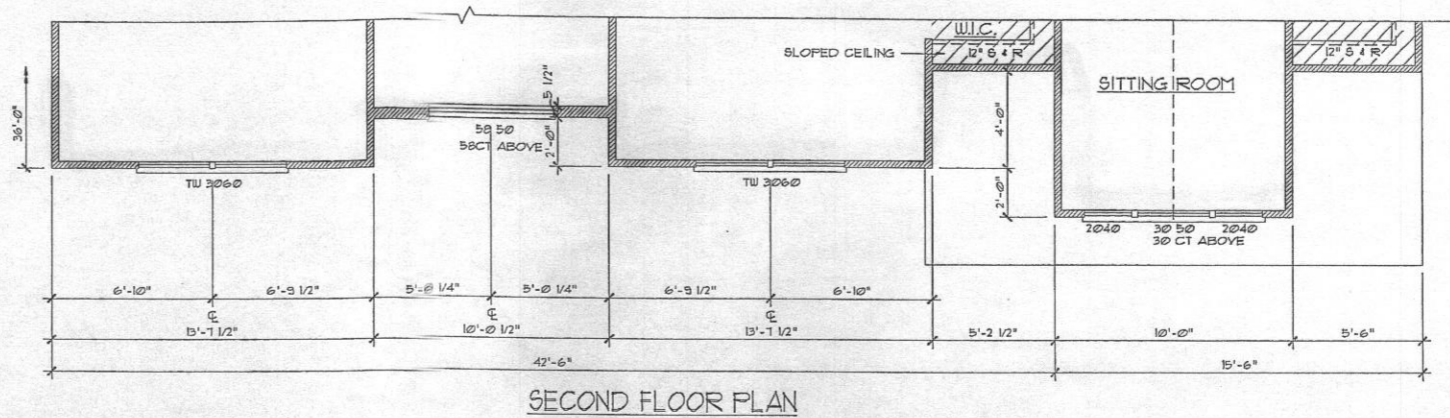

COLONIAL ELEVATION - PARTIAL PLANS

COLORADO
 KV_003_2B3

Architecture Collaborative, Inc. expressly reserves its copyright and other property rights in these plans and drawings. These plans and drawings are not to be reproduced in any form or manner without written consent.

REV.#	DATE	REV.#	DATE	REMARKS
1	1-12-07	2006 INC CONVERSION		
2	12-22-08			
3	4-1-10			

MODEL: COLORADO
 SET #

Kipynian
 Companies

SQUARE FOOTAGE CHART

NAME	AREA
FIRST FLOOR PLAN (TRADITIONAL ELEV.)	1748
SECOND FLOOR PLAN (TRADITIONAL ELEV.)	1708
BASE SQUARE FOOTAGE	3456
COLONIAL ELEVATION	+ 109
COUNTRY ELEVATION	+ 109
GEORGIAN ELEVATION	+ 131
VICTORIAN ELEVATION	+ 162
ELEVATION A	+ 215
ELEVATION B	+ 215
OPT. LIVING RM. / DINING RM BAY WINDOW	+ 16
OPT. SIDE LIBRARY BAY WINDOW	+ 18
ALT. OWNERS SUITE W/ 3-CAR SIDE LOAD GARAGE	+ 5
BEDROOM 5 OVER STD FAMILY ROOM	+ 287
BEDROOM 5 OVER EXT. FAMILY ROOM	+ 395
OPT. SIDE CONSERVATORY	+ 252
OPT. FIRST FLOOR SUITE W/ BATH	+ 331
OPT. FIRST FLOOR SUITE 2 W/ BATH	+ 378
OPT. ALT. FIRST FLOOR SUITE W/ BATH	+ 471
OPT. 6' LIBRARY EXT.	+ 79
OPT. 6' FAMILY ROOM EXT.	+ 120
OPT. 12' MORNING ROOM / DES. KIT. / GRAND MR.	+ 244
OPT. REAR SUNROOM	+ 161
OPT. COMBO 12' MORNING ROOM & 6' F.R. EXT.	(361)
OPT. COMBO 12' MORNING ROOM & 6' F.R. & 6' LIB. EXT.	(440)
OPT. COMBO 12' MORNING ROOM & 6' F.R. & SUNROOM	(519)
OPT. FINISHED BASEMENT (TOTAL BASE HOUSE)	1318
OPT. REC. ROOM	662
OPT. DEN	308
OPT. BATH	49
OPT. EXERCISE ROOM	221
OPT. FINISHED STORAGE CLOSET	79
EXT. REC. RM. W/ 6' LIBRARY EXT.	+ 79
EXT. REC. RM. OPT. 6' FAMILY ROOM EXT.	+ 106
EXT. REC W/ OPT. REAR SUNROOM	+ 153
EXT. REC W/ OPT. 12' MORNING ROOM ONLY	(+ 7)
EXT. DEN W/ OPT. 12' MORNING ROOM	+ 226
EXT. DEN W/ COMBO OPT. 12' MR & 6' FAMILY RM. EXT.	(+ 13)
EXT. REC W/ COMBO OPT. 12' M.R. & 6' F.R. & SUNROOM	(- 5)
EXT. EXERCISE RM. W/ COLONIAL ELEVATION	+ 25
EXT. STORAGE CLOSET W/GEORGIAN ELEVATION	+ 15
EXT. EXERCISE RM. W/ VICTORIAN ELEVATION	+ 25
EXT. EXERCISE RM. W/ ELEVATION A & B	+ 25
EXT. STORAGE CLOSET W/ ELEVATION A & B	+ 7



MID-ATLANTIC AREA

COLORADO

REVISION DATE: 08-11-2014

1CO

2012 INTERNATIONAL RESIDENTIAL CODE

"THE LOCAL JURISDICTION SHALL FILL IN THIS TABLE WITH LOCAL CLIMATIC AND GEOGRAPHIC CRITERIA"

2012 CLIMATIC AND GEOGRAPHIC DESIGN CRITERIA:											
GROUND SNOW LOAD	WIND SPEED (mph)		SEISMIC DESIGN CATAGORY	SUBJECT TO DAMAGE FROM			WINTER DESIGN TEMP.	ICE BARRIER UNDERLAYMENT REQUIRED	FLOOD HAZARDS	AIR FREEZING INDEX	MEAN ANNUAL TEMP
	Speed (mph)	Topographic Effects		Weathering	Frost Line Depth	Termites					
	90		A1B								

SQUARE FOOTAGE CHART (CONT'D)

NAME	AREA
GARAGE 2-CAR	464
GARAGE 2-CAR (W/ ELEVS A & B)	+ 42
GARAGE 3-CAR SIDE LOAD	+ 168
GARAGE 3RD CAR FRONT LOAD	+ 227
UNFINISHED BASEMENT (BASE HOUSE)	1748
UNFIN. BSMT. W/ COLONIAL ELEVATION	+ 55
UNFIN. BSMT. W/ COUNTRY ELEVATION	+ 55
UNFIN. BSMT. W/ GEORGIAN ELEVATION	+ 22
UNFIN. BSMT. W/ ELEVATION	+ 0
UNFIN. BSMT. W/ 6' LIBRARY EXT.	+ 79
UNFIN. BSMT. W/ OPT. 6' FAMILY ROOM EXT.	+ 114
UNFIN. BSMT. W/ OPT. 12' MORNING ROOM	+ 244
UNFIN. BSMT. W/ OPT. REAR SUNROOM	+ 161
UNFIN. BSMT. W/ COMBO OPT. 12' M.R. & 6' FAMILY RM. EXT.	(- 3)
UNFIN. BSMT. W/ COMBO OPT. 12' M.R. & 6' F.R. & SUNROOM	(- 6)
UNFIN. BSMT. W/OPT. SIDE CONSERVATORY	+ 252
UNFIN. BSMT. W/OPT. FIRST FLOOR SUITE W/ BATH	+ 331
UNFIN. BSMT. W/OPT. FIRST FLOOR SUITE 2 W/ BATH	+ 378
UNFIN. BSMT. W/ OPT. ALT. FIRST FLOOR SUITE W/ BATH	+ 471

MEADOWS FARM
LOT 3

*HEALTH DEPARTMENT

B15000168






NOTE: AT ANY TIME IN THE FUTURE THAT A BUILDING PERMIT IS SUBMITTED TO FINISH THE AREA CURRENTLY IDENTIFIED AS OPTIONAL DEN, THEN A SEPTIC SYSTEM UPGRADE WILL BE REQUIRED AS FINISHING THE OPTIONAL DEN CREATES A SIXTH BEDROOM PER HANCOCK COUNTY CODE 3.001 (B) KV_003_3258 COLORADO

ACI


Architecture Collaborative, Inc. expressly reserves its copyright and other property rights in these plans and drawings. These plans and drawings are not to be reproduced in any form or manner without written consent.

1/28/15

SCALE:
 1/8" = 1'-0" @ 11 x 17
 1/4" = 1'-0" @ 24 x 36

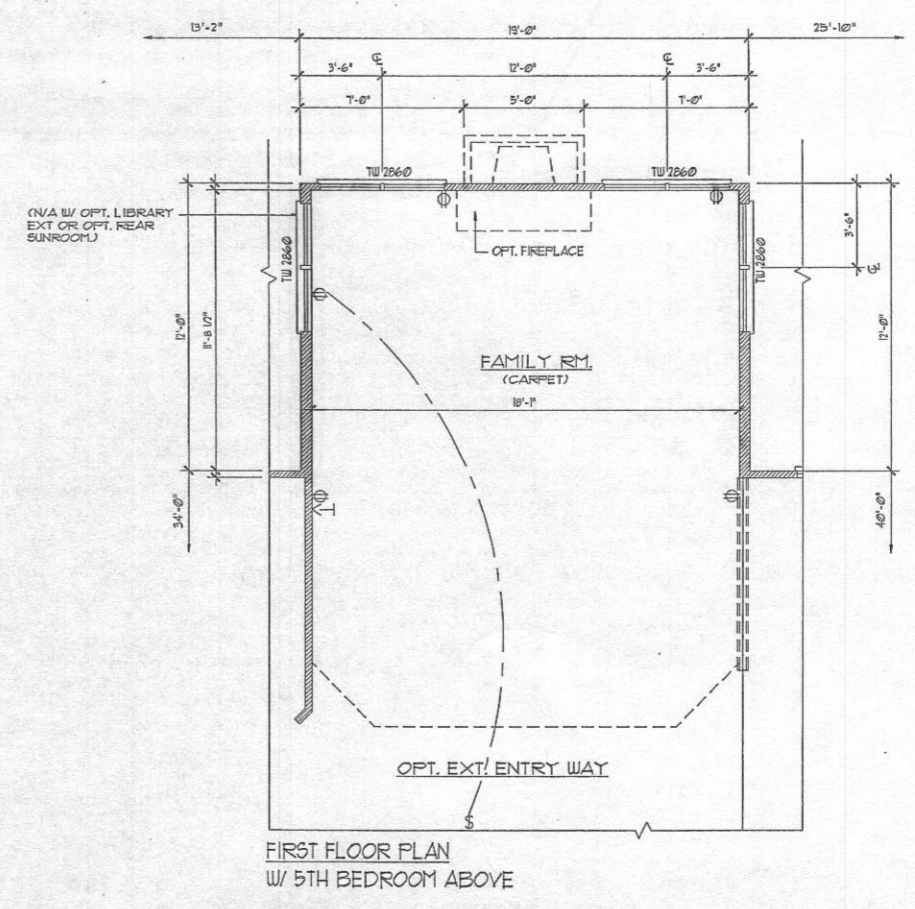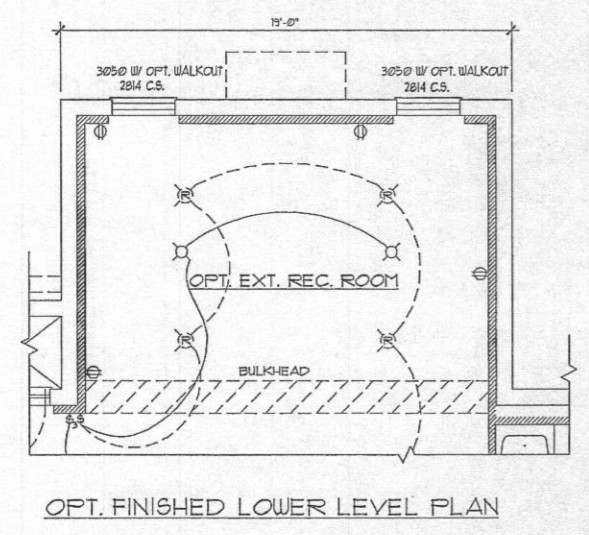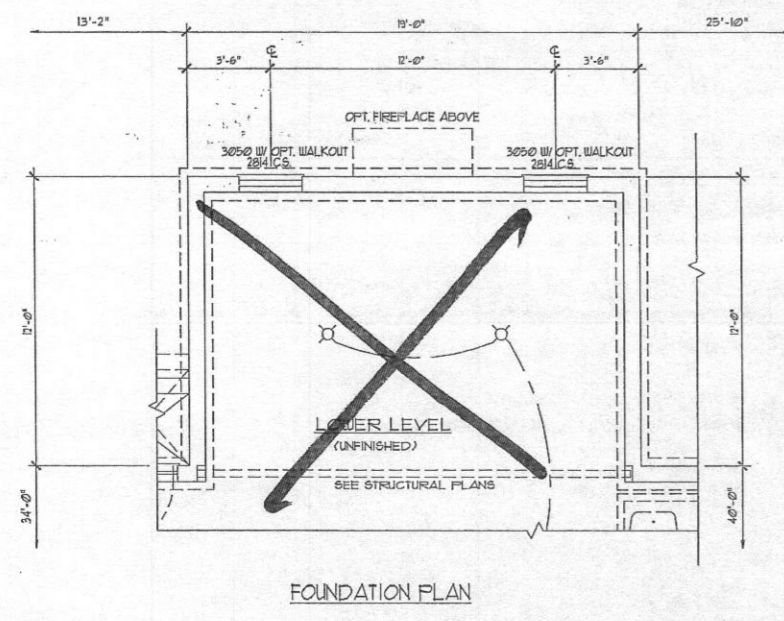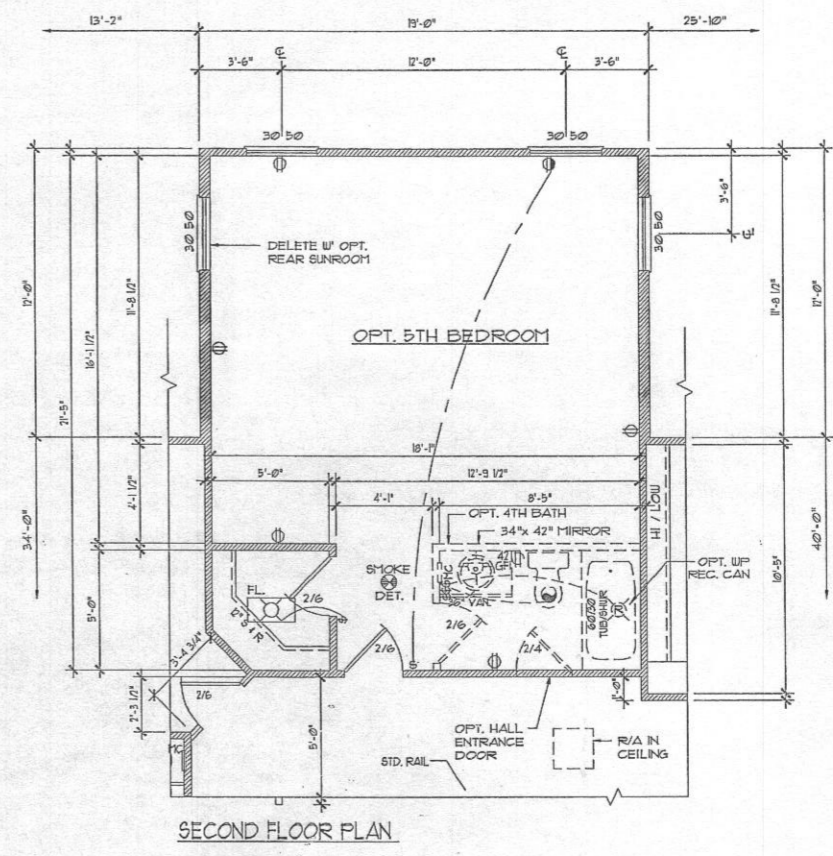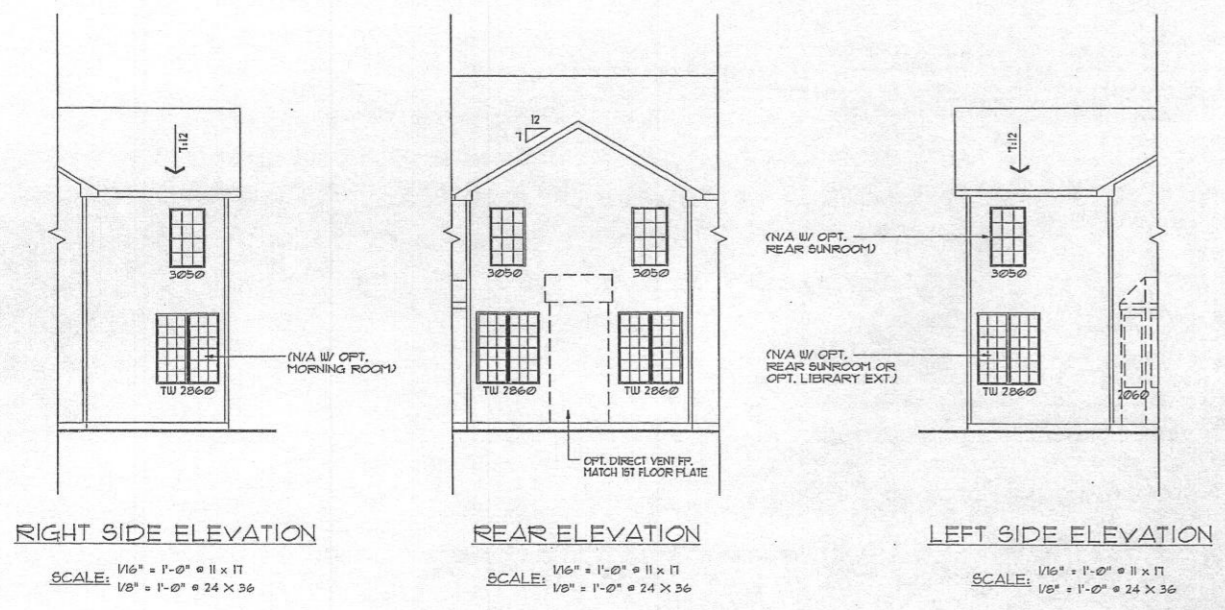

SHEET NUMBER	6P	
SCALE		
DRAWN BY	ACI	
DATE	12-14-99	
REVISIONS		
REV. #	DATE	REMARKS
1	12-14-99	2000 IRC CONVERSION
2	01-14-00	6-36-01
3	01-14-00	AS-15-02
4	12-27-00	12-14-99
MODEL	COLORADO	SET #

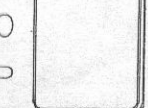

COLORADO
 KV_003_6P

RESIDENTIAL BUILDING PERMIT PERMIT FEE AND EXCISE TAX WORKSHEET

PERMIT NUMBER _____

OWNER CRAFTMAN Home ADDRESS MOORE OAKMONT

CONSTRUCTION PHASE: New Addition _____ Alteration _____ Temporary _____

IRC USE GROUP: R3 DESCRIPTION OF WORK: _____

2 story full bath, 10R, 4FB, 1HS, FRAMING (400)

BUILDING	FRONT	DEPTH	HEIGHT	AREA	AREA
1	64	44	10	2623	
2	64	44	10	2426	
3	64	42	10	2212	
				GSF = <u>7261</u>	OGSF = _____

Footings	Foundation	Walls	Roof	Other
<u>16" x 8"</u>	<u>8" Concrete</u>	<u>NO FINISH FRAMING</u>	<u>FRAMING</u>	

Residential Fee Calculations:

Residential - A building which contains one or more dwelling unit, including boarding houses but not including transient accommodations such as hotels, courts or bed and breakfast inns. Residential includes uses accessory to building units such as attached garages or home occupations, but does not include non-residential uses in mixed use structures.

BPF = 7261 GSF x \$0.18 = \$ 1306.98 Permit Fee x 10% (Tech Fee) = 130.70

ET = 7261 OGSF x \$0.99 = \$ 7188.39 Excise Tax PSFS = 7261 OGSF x \$1.16 = \$ 8422.76

BPF = Building Permit Fee OGSF = Occupiable Gross Square Feet GSF = Gross Square Feet ET = Excise Tax PSFS = Public School Facilities Surcharge
Note: OGSF calculations may differ from GSF calculations when computing excise tax.

<p><u>B</u></p> <p><u>42' x 41' = 1742</u> <u>20' x 23' = 470</u></p> <p><u>MOORAN</u> <u>Summ</u> <u>23' x 12' = 282</u> <u>4' x 15' = 217</u></p> <p><u>CONSERVATORY</u> <u>Retn wing</u> <u>15' x 19' = 292</u> <u>14' x 15' = 210</u></p>	<p><u>1</u></p> <p><u>43' x 41' = 1763</u> <u>20' x 43' = 860</u></p> <p><u>30' x 9' = 190</u></p> <p><u>MOORAN</u> <u>Summ</u> <u>23' x 12' = 282</u> <u>4' x 15' = 217</u></p> <p><u>CONSERVATORY</u> <u>Retn wing</u> <u>8' x 17' = 136</u> <u>22' x 24' = 528</u></p>	<p><u>2</u></p> <p><u>43' x 41' = 1763</u> <u>20' x 43' = 860</u></p> <p><u>OUT</u> <u>116' x 18' = 207</u></p> <p><u>Final ATTN</u> <u>43' x 14' = 623</u> <u>OUT 3256</u> <u>607</u></p>
---	---	--

PERMIT FEE, TECHNOLOGY FEE, SCHOOL SURCHARGE AND EXCISE TAX TOTAL: \$ _____

References: Chapter 285, Acts of the Maryland General Assembly of 1992; Howard County Code Sections 20.503; County Council Resolution 58-2008; 2004 Legislation House Bill 1445; 2006 International Residential Code for One and Two Family Dwellings

BY: [Signature] DATE: 9/1/2010 CHECKED BY: _____ DATE: _____