



Aerial Photo with fence around septic area.
Photo from Bing Maps, bird's eye view



0 25 50 100 200

AERIAL PHOTO FROM 2009 WITH APPROXIMATE FENCE LINES AND EVENT DETAILS. SCALING IS BASED ON EVENT FIELD BEING AT ZERO ELEVATION FOR SCALING PURPOSES AND ANY DISTORTIONS DUE TO DIFFERENCES IN ELEVATION. ADDITIONAL STRUCTURES ADDED 2010-2011 OVERLAID.


Revisions
7/24/2014 - Added No Parking
for Septic Fields.

RED LINES INDICATE
ROUTES ACCESSIBLE
TO APPRATUS

2014
2015 Grand Prix Event Field
Prepared by: Travis Hopkins
Howard Community College
Phone: 443-518-4751
Revised 8/21/2012 v2



Aerial Photo with fence around septic area.
Photo from Bing Maps, bird's eye view

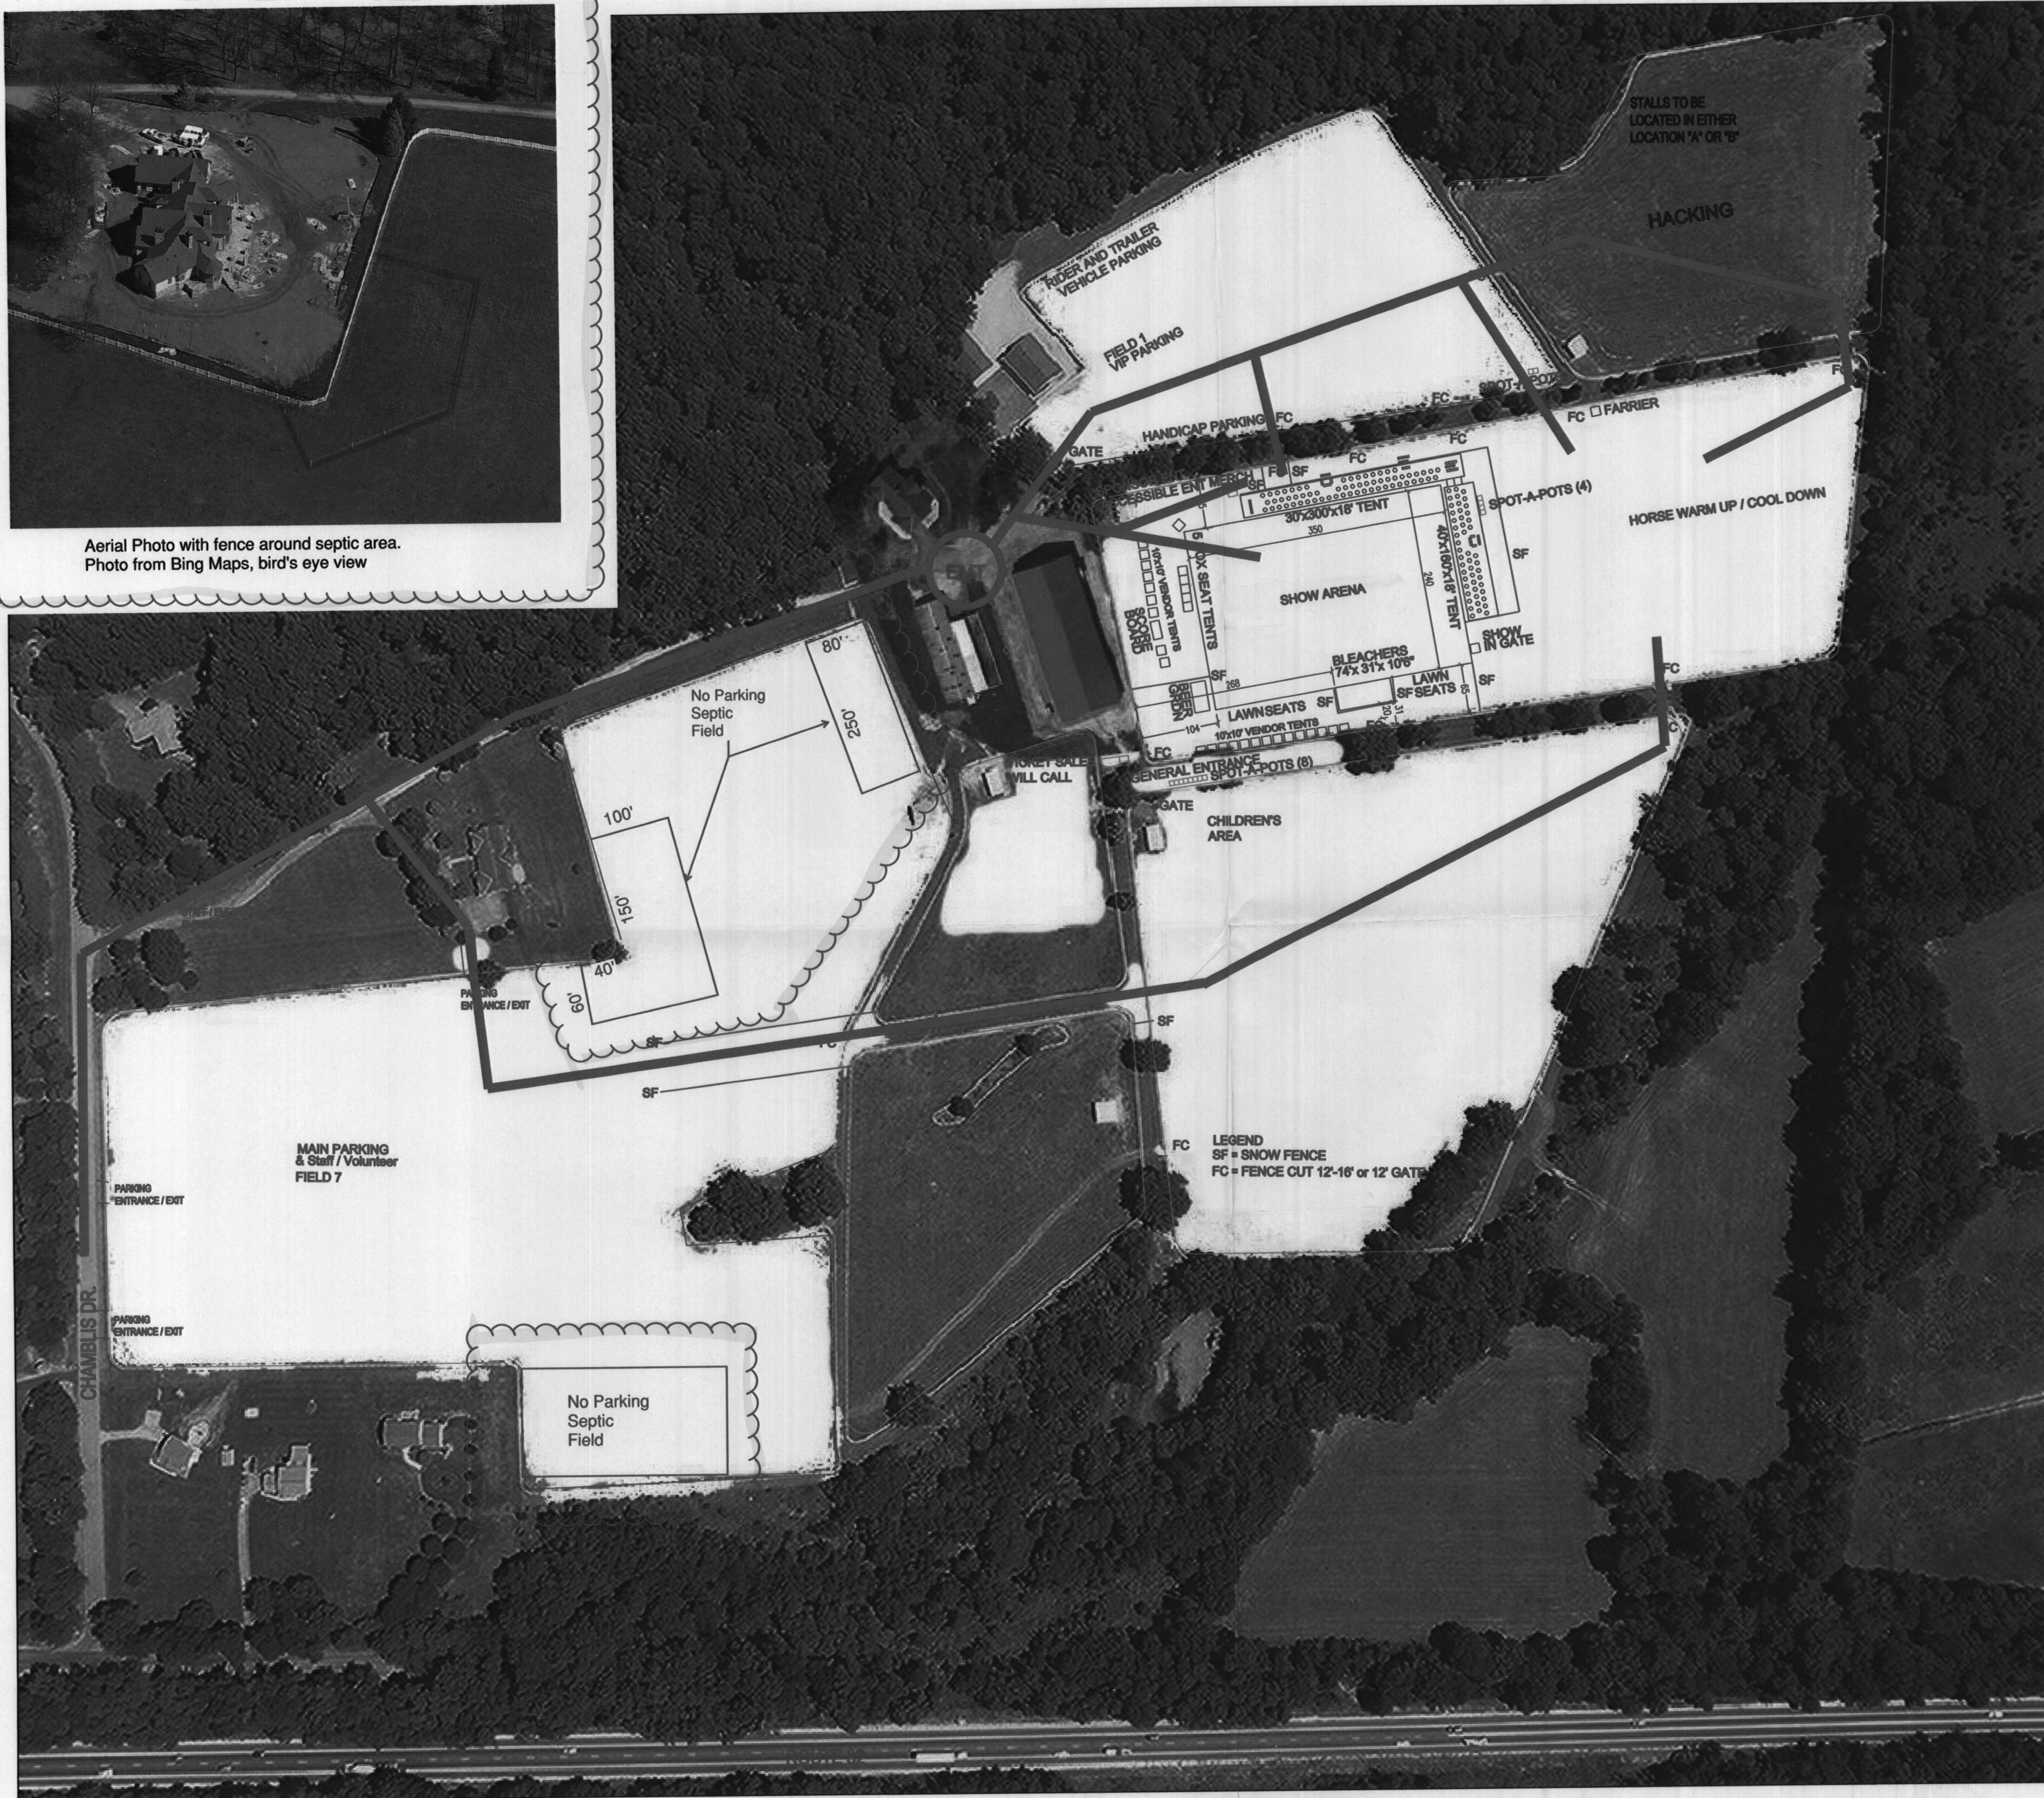

0 25 50 100 200

AERIAL PHOTO FROM 2009 WITH APPROXIMATE FENCE LINES AND EVENT DETAILS. SCALING IS BASED ON EVENT FIELD BEING AT ZERO ELEVATION FOR SCALING PURPOSES AND ANY DISTORTIONS DUE TO DIFFERENCES IN ELEVATION. ADDITIONAL STRUCTURES ADDED 2010-2011 OVERLAID.

Revisions
7/24/2014 - Added No Parking
for Septic Fields.

RED LINES INDICATE
ROUTES ACCESSIBLE
TO APPRATUS

2014 #
2015 Grand Prix Event Field
Prepared by: Travis Hopkins
Howard Community College
Phone: 443-518-4751
Revised 8/21/2012 v2

