

APPLICATION

A 21198

SEWAGE DISPOSAL TESTING

P _____

STATE OF MARYLAND - DEPARTMENT OF HEALTH AND MENTAL HYGIENE

HOWARD COUNTY HEALTH DEPARTMENT
ENVIRONMENTAL HEALTH SERVICES

DISTRICT 4

P. O. BOX 476, ELLICOTT CITY, MARYLAND 21043
TELEPHONE: 465-5000, EXT. 356

DATE 3/10/75

TO: THE COUNTY HEALTH OFFICER
ELLICOTT CITY, MARYLAND

I, HEREBY, APPLY FOR THE NECESSARY TEST IN ORDER TO CONSTRUCT (OR RECONSTRUCT) A SEWAGE DISPOSAL SYSTEM.

PROPERTY OWNER Estate of Georgia Unger

ADDRESS _____

PHONE _____

Any questions call:
Mr. Ed. Kasemeyer
442-2297

PROPERTY LOCATION:

SUBDIVISION far map 14, parcel 160 LOT NO. _____

ROAD AND DESCRIPTION Corner of Carr's Mill Road & Bushy Park Road

SIZE OF LOT 20.562 acres TYPE BLDG. 3 or 4

NUMBER OF BEDROOMS

IF NOT SINGLE RESIDENCE DESCRIBE _____
(Single Fmly. Dwllg.)

THE SYSTEM INSTALLED UNDER THIS APPLICATION IS ACCEPTABLE ONLY UNTIL PUBLIC FACILITIES BECOME AVAILABLE.

SIGNATURE OF APPLICANT /s/ Ed. Kasemeyer


APPROVED BY _____ FOR _____ DATE _____
(KIND OF SYSTEM)

REJECTED BY _____ FOR _____ DATE _____
(KIND OF SYSTEM)

HOLD PENDING FURTHER TESTS _____ DATE _____

REASONS FOR REJECTION OR HOLDING _____

THIS IS NOT A PERMIT

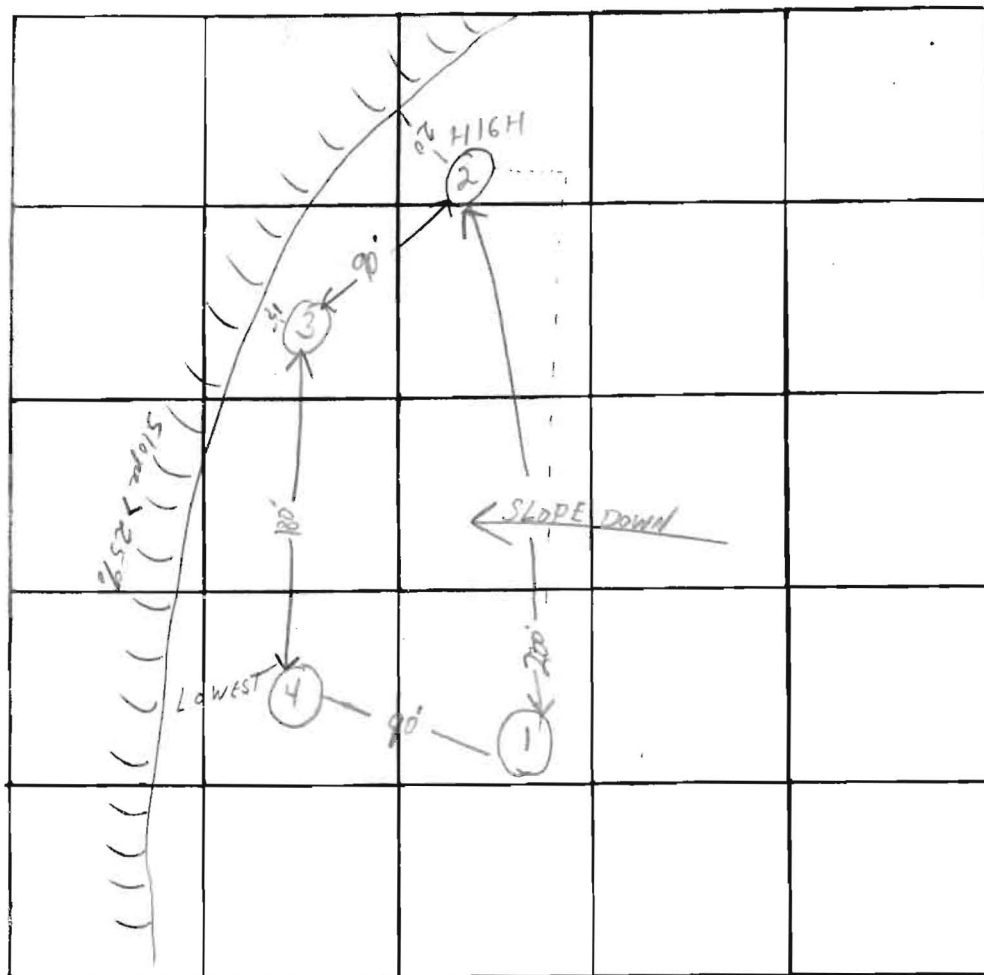

INDICATE NORTH. - NAME ADJOINING ROADWAY AS BASE LINE

BUSHY PK RD

#2 0
CLAY
4 CLAY
LOAM
12 SHALE

#3 0
CLAY
4 CLAY
LOAM
12 SHALE

#4 0
CLAY
4 CLAY
LOAM
12 SHALE

DATE	TEST NO.	DEPTH	PRE-WET		TEST - 1" DROP		TIME
			START	STOP	START	STOP	
3/18/75	1						
	1A	12'	VISUAL				
	2 HIGHEST	4 1/2'	1155	1156	1156	1200	4
	2A	12'	1150	1151	1151	1153	2
	3	12'	1130	1131	1131	1133	2
	3A	4'	1130	1145	1145	1210	25
	4	12'	1112	1114	1114	1117	3
	4A	4'	1112	1122	1122	1141	21

REMARKS

Continuous holes - trenches only

TYPE OF SOIL

Clay Loam + ROTTEN Shale

TESTED BY

HZ - RM

ALSO PRESENT:

Barth

APPLICATION

A 21198

P _____

SEWAGE DISPOSAL TESTING

STATE OF MARYLAND - DEPARTMENT OF HEALTH AND MENTAL HYGIENE

HOWARD COUNTY HEALTH DEPARTMENT
ENVIRONMENTAL HEALTH SERVICESP. O. BOX 476, ELLICOTT CITY, MARYLAND 21043
TELEPHONE: 465-5000, EXT. 356DISTRICT 4DATE 3/10/75TO: THE COUNTY HEALTH OFFICER
ELLICOTT CITY, MARYLAND

I, HEREBY, APPLY FOR THE NECESSARY TEST IN ORDER TO CONSTRUCT (OR RECONSTRUCT) A SEWAGE DISPOSAL SYSTEM.

PROPERTY OWNER Estate of Georgia UngerADDRESS _____ PHONE Any questions call:
Mr. Ed. Kasemeyer
442-2297

PROPERTY LOCATION:

SUBDIVISION tax map 14, parcel 160 LOT NO. _____ROAD AND DESCRIPTION Corner of Carr's Mill Road & Bushy Park RoadSIZE OF LOT 20.562 acres TYPE BLDG. 3 or 4

NUMBER OF BEDROOMS

IF NOT SINGLE RESIDENCE DESCRIBE (Single Fmly. Dwllg.)

THE SYSTEM INSTALLED UNDER THIS APPLICATION IS ACCEPTABLE ONLY UNTIL PUBLIC FACILITIES BECOME AVAILABLE.

SIGNATURE OF APPLICANT /s/ Ed. KasemeyerAPPROVED BY _____ FOR _____ DATE _____
(KIND OF SYSTEM)REJECTED BY _____ FOR _____ DATE _____
(KIND OF SYSTEM)

HOLD PENDING FURTHER TESTS _____ DATE _____

REASONS FOR REJECTION OR HOLDING certify all holes

THIS IS NOT A PERMIT

INDICATE NORTH. — NAME ADJOINING ROADWAY AS BASE LINE

DATE	TEST NO.	DEPTH	PRE-WET		TEST - 1" DROP		TIME
			START	STOP	START	STOP	

REMARKS _____

TYPE OF SOIL _____

TESTED BY _____ ALSO PRESENT: _____

January 27, 1983

TO WHOM IT MAY CONCERN:

RE: Tax Map 14, Parcel 160
Harvey W. Goolsby property

The above referenced property passed the standard percolation tests on March 18, 1975 and is considered a buildable lot.

Very truly yours,

Frank A. Skinner

Frank A. Skinner, Director
Water and Sewerage Program

FAS:hs

R.B.A. Richard Browne

HOWARD COUNTY HEALTH DEPARTMENT

Ellicott City, Maryland 21043

Phone: 465-5000

To: _____

Comments :

- ① due to the percentage of clay to 4-6', \bar{t} for perc tests will be considered to be not less than 20 min.
- ② use trenches only
- ③ Test #2 will be the location of the initial system but move the trench so it is a minimum of 30, preferably 50 ft from the drop-off

From: _____

Date: _____

R.M. 3/18/75

