

Building Permit Application
by oward County Maryland
Dypartment of Inspections, Licenses and Permits
3430 Court House Drive
Permits: 410-313-2455
www.howardcountymd.gov

Date Received: 8-13-14

Permit No.: B14002953


the state of the s					
Building Address: 15130 Bush, Park Road			Property Owner's Name:	aven Carta	
city: Wood bine State: Mdr Zip Code: 21797			Address: 1000 Buch. Park No.		
			City: Wood bine St	ate: /md/ Zip Code: 21797	
1			Phone: 340-417-8	5.5.77 Fax:	
Section: Area: Lot:			Applicant's Name & Mailing Address, (If other than stated herein)		
Section:			Applicant's Name: Amigan Homes Fac- Address: 9812 Cartles C.T.		
Zoning: Map Coordinates: Lot Size:			Cin 12/1/20 H Cottes	tato: Milela Zin Code: 21042	
zoning: wap coordinates: tot size:			Phone: 440 - 9 77 - 8 9	17Fax:	
Existing Use: Single Fan, by home			Email: Carrigan ho.	17 Fax: D Comcast net	
Proposed Use: <u>Netaches Garage</u>			Contractor Company: La		
			Contact Person:	Hell-	
Estimated Construction Cost: \$ 65,000			Address: Same as above		
Description of Work: TO add 3 Car			City: State: Zip Code:		
detached vorace to property			License No.: 358 MAHC -121134		
			Phone: 4(0-971-8927 Fax:		
744 Sqr-ft. Unfinished 2nd			Email: Larrigum homs & comcast-ret		
Occupant or Tenant:					
Was tenant space previously occupied? □Yes □No En			Engineer/Architect Company:	Robert H. Vocel	
Contact Name:			Responsible Design Prof.:		
			Address:		
City: State: Zip Code: City: State: Zip Code:					
Phone: Fax: Phone: 40-461-7666 Fax:					
Email:			Email:		
Commercial Building Characteristics	Residential Building Cha		Utilities		
Height:	SF Dwelling ☐ SF Tow Depth	Width	Water Supply		
No. of stories: Gross area, sq. ft./floor:	1 st floor:	width	☐ Public		
Gross area, sq. re, moor.	2 nd floor:		☑ Private		
Area of construction (sq. ft.):	Basement:		Sewage Disposal	m in the second	
	☐ Finished Basement		☐ Public		
Use group:	☐ Unfinished Basement		2 Private	州安康新州中国 第16	
	☐ Crawl Space		Electric:	No	
Construction type: ☐ Reinforced Concrete	☐ Slab on Grade No. of Bedrooms:		Gas: ☐ Yes 🗹	No	
☐ Structural Steel	Multi-family Dwe	ellina	Heating System	NA	
☐ Másonry	No. of efficiency units:		☐ Electric ☐ Oil		
Wood Frame	No. of 1 BR units:		☐ Natural Gas ☐ Propane	Gas	
☐ State Certifled Modular	No. of 2 BR units:		☐ Other:		
	No. of 3 BR units:		<u>Sprinkler System:</u>	MA	
	Other Structure: Dimensions:		☐ Yes ☐ No		
> Roadside Tree Project Perhit					
□Yes Delo	Roof:		Grading Perm	it Number:	
Roadside Tree Project Parmit 4	☐ State Certified Modula	ar			
	☐ Manufactured Home		Building Shell Perm	it Number:	
THE UNDERSIGNED HEREBY CERTIFIES AND AGREES AS FOLLOWS: (1) THAT HE/SHE IS AUTHORIZED TO MAKE THIS APPLICATION; (2) THAT THE INFORMATION IS CORRECT; (3) THAT HE/SHE WILL COMPLY WITH ALL DESCRIBATIONS OF HOWARD COUNTY WHICH ARE APPLICABLE THERETO; (4) THAT HE/SHE WILL PERFORM NO WORK ON THE ABOVE REFERENCED PROPERTY NOT SPECIFICALLY DESCRIBED IN THIS APPLICATION; (5) THAT HE/SHE GRANTS COUNTY OFFICIALS THE RIGHT TO ENTER ONTO THIS PROPERTY FOR THE PURPOSE OF INSPECTING THE WORK PERMITTED AND POSTING NOTICES. Applicant's Signature Print Name 8-13-14 Date Title/Company					
, 5	Checks Payable to	: DIRECTOR OF F	INANCE OF HOWARD COUNTY		
AFRICATION OF THE PROPERTY OF		LEASE WRITE NEA	ATLY & LEGIBLY**		
		FOR OFFICE	STATE OF THE PARTY		
AGENCI DATE SIGNATURE OF ATTROVAL		INFORMATION	Filling Fee \$ 3.5.00 Permit Fee \$		
State Highways Front:			Tech Fee \$		
Building Officials		Side:		Excise Tax \$	
PSZA (Zoning)			PSFS \$		
All manimum's		setbacks met? Yes No	Guaranty Fund \$ Add'l per Fee \$		
Health Historic District			Total Fees \$		
Is Sediment Control approval required to	4 prometer	Lot Coverage	for New Town Zone:	Sub-Total Paid \$	
☐ CONTINGENCY CONSTRUCTION STAR	T res PNO	SDP/Red-line	approval date:	Balance Due \$ Check # 3970	
				LIPCER # 39//	

Distribution of Copies: White: Building Officials T:\Operations\Updated Forms\Bullding applmp 8.2012.docx Yellow: PSZA, Engineering

Green: PSZA Zoning

Pink: Health

Gold: SHA

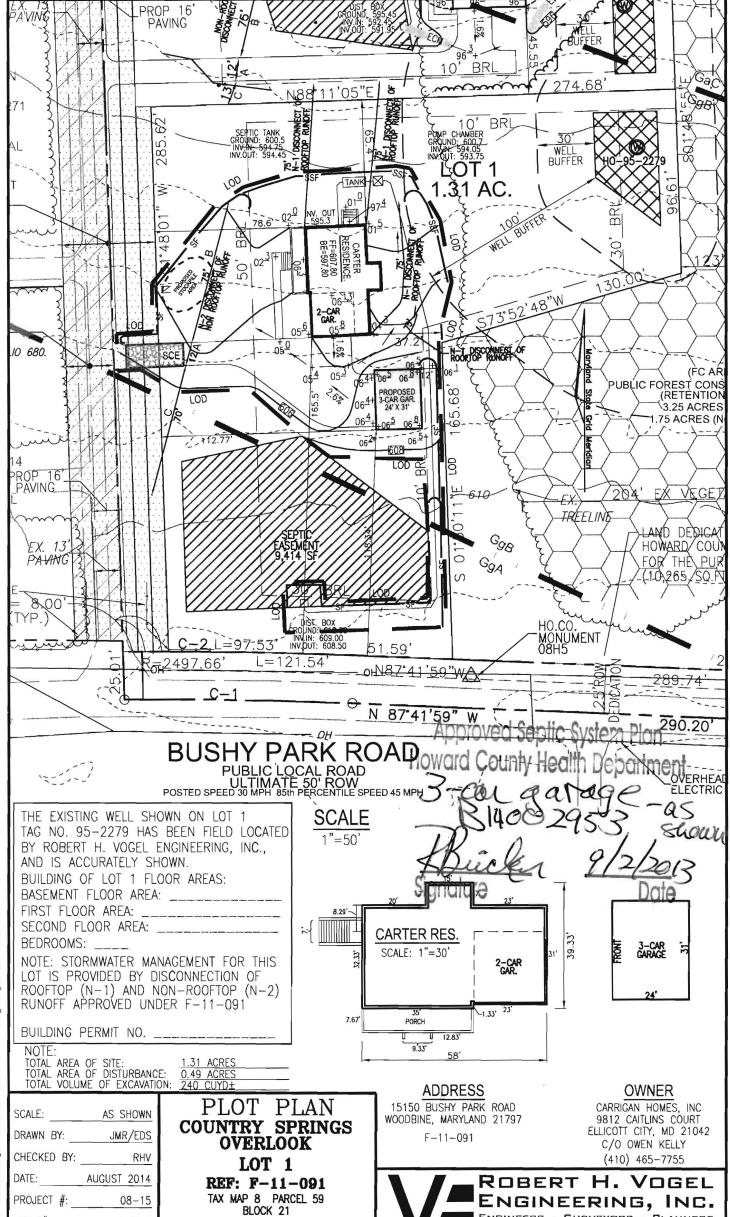

4TH ELECTION DISTRICT HOWARD COUNTY, MARYLAND

ENGINEERS . SURVEYORS . PLANNERS

8407 MAIN STREET TEL: 410.461.7666 ELLICOTT CITY, MD 21043 FAX: 410.461.8961

PLOT PLAN_B.dwg, 8/4/2014 4:22:30 PM SIENGRIDMAISUPPLEMENTALILOT 1

SHEET#: _

1 OF 1