

F A X

**Coleman-Laurienzo, Inc.,
Builders**

26212 Ridge Road
Damascus, MD 20872
301-253-9616
www.clibuild.com



To: Sara Sappington/Howard County
Fax number: 410-313-2648

From: Jill Coleman
Fax number: 301-253-3718

Date: 10/28/08

Regarding:
12950 Byefield Drive, Highland

Phone number for follow-up:
301-253-9616

Comments:

Hi Sara. Please give us a call if you have any questions.

Thanks, Jill

Richen
10/28/08

WELL - 60' from front middle of main,
section of house that is 32' W

(OR)

55' from proposed front porch or piers
OR

68' from front of proposed garage


SEPTIC TANK

20' from rear of exist house at
middle of 12'5 section

(OR)


23' from proposed garage



SCALE 1/4" = 1' 0"

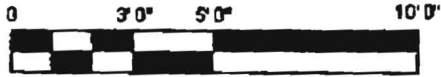

Richmond St

*12950 Byefield Rd
Highland*

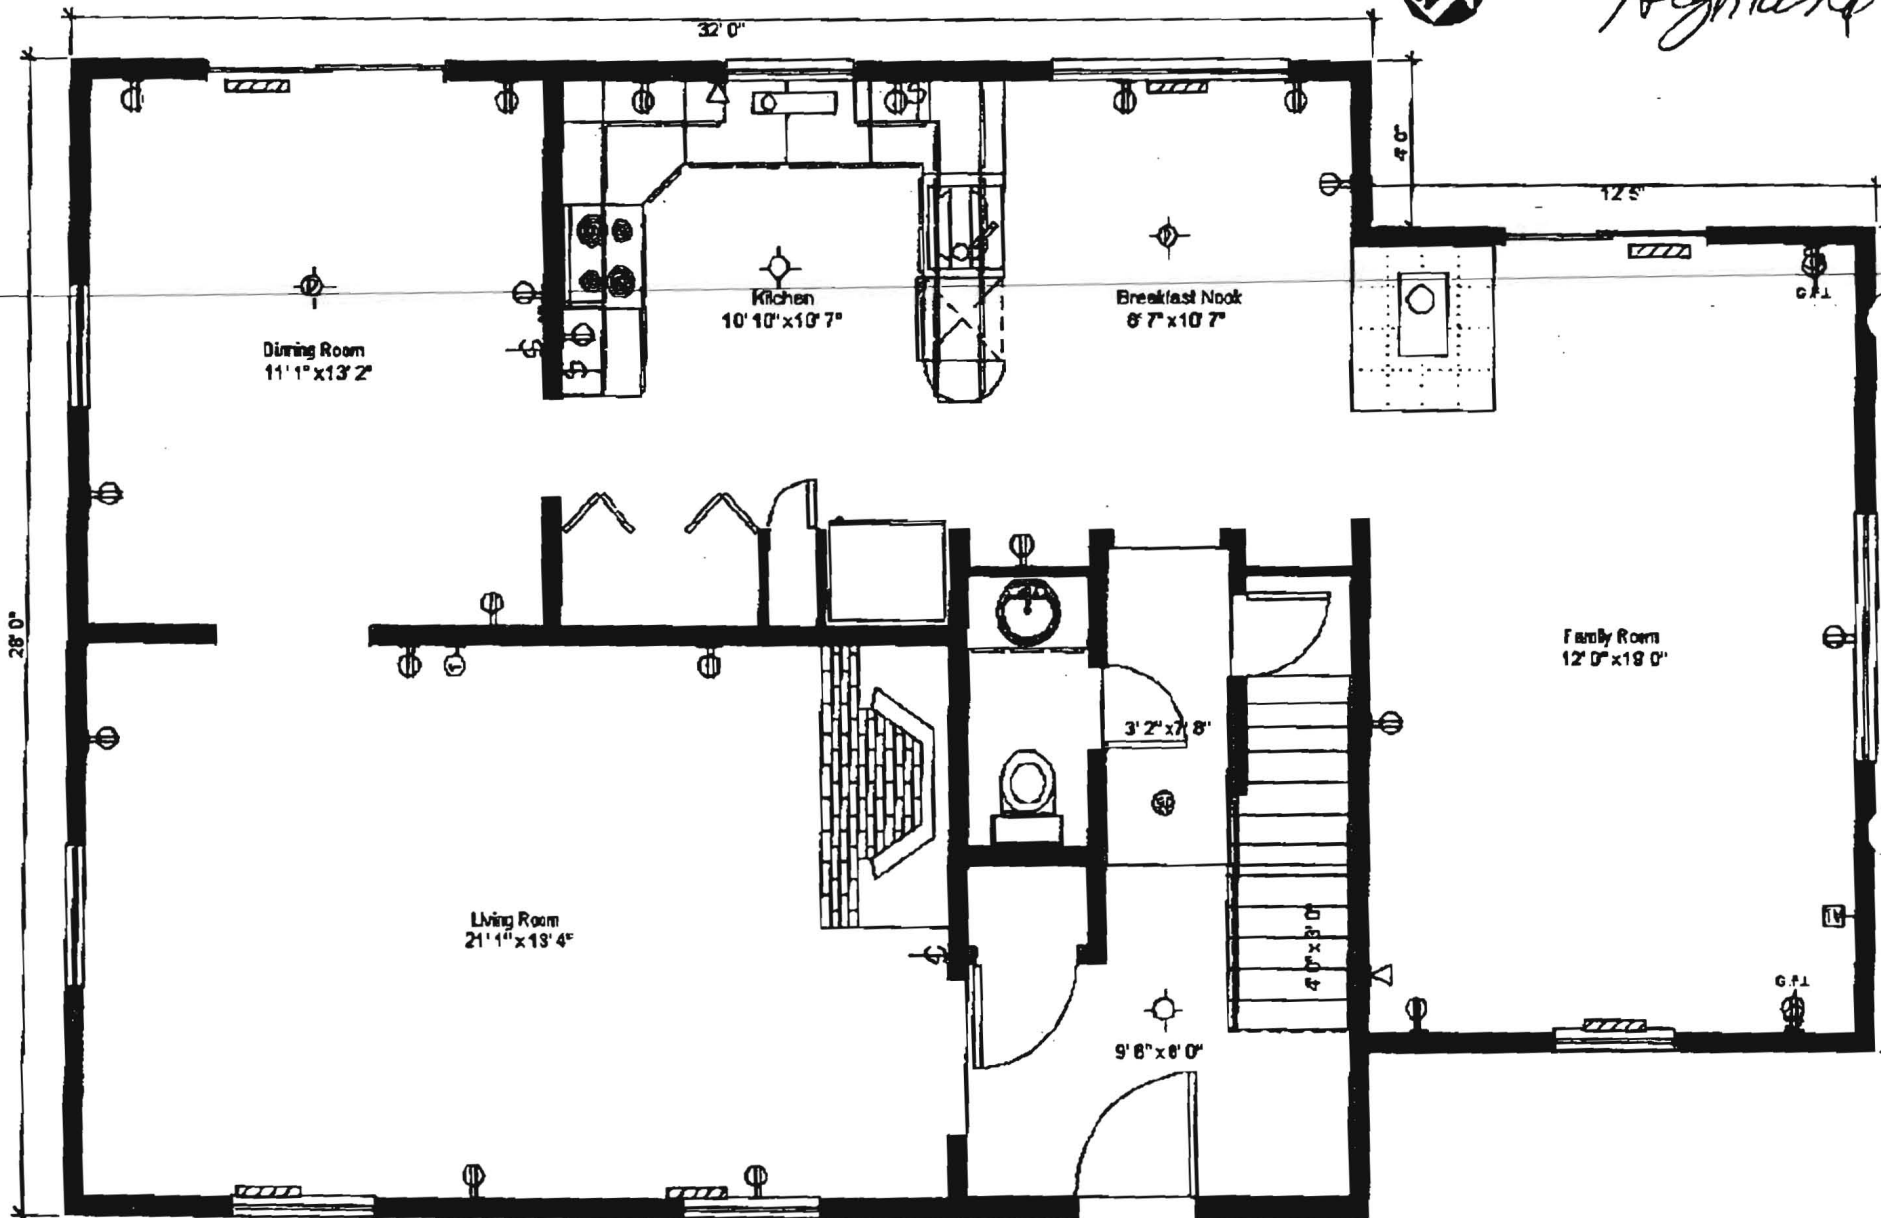

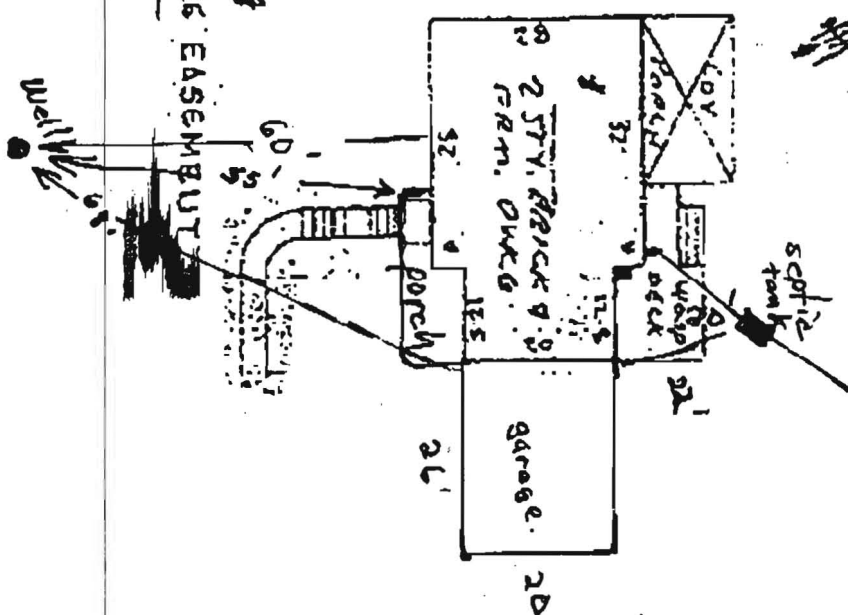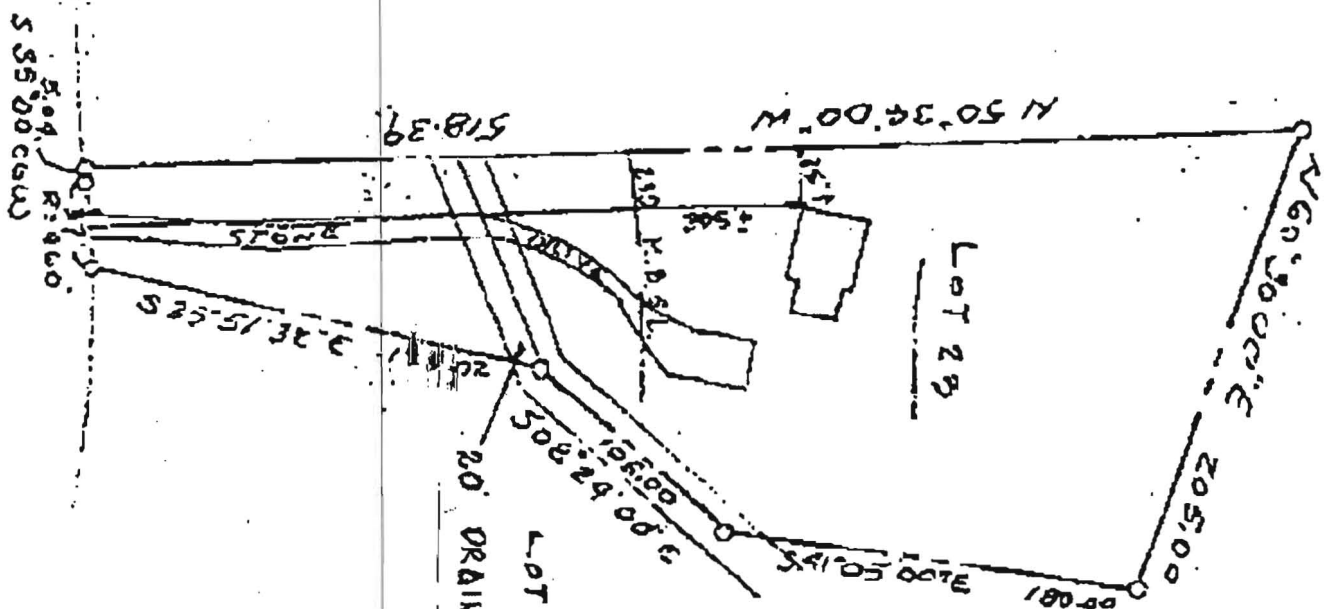

10/28/08