

APPLICATION

SEWAGE DISPOSAL TESTING

MARYLAND STATE DEPARTMENT OF HEALTH

HOWARD COUNTY

ELLICOTT CITY

DISTRICT 5

DATE 10/8/65

*Moved 10' to 105'
soil good today.*

TO: THE COUNTY HEALTH OFFICER
ELLICOTT CITY, MARYLAND

I, HEREBY, APPLY FOR THE NECESSARY TESTS IN ORDER TO CONSTRUCT (OR RECONSTRUCT) A SEWAGE DISPOSAL SYSTEM.

PROPERTY OWNER Thomas G. Oyster

ADDRESS 2419 Reelie Dr. Wheaton Md PHONE 774 9615

PROPERTY LOCATION:

SUBDIVISION HEMLOCK HILL LOT NO. 23

ROAD AND DESCRIPTION Byefield Dr

*Was Lot 7
when tested
Oct 65 but
Building Land
has been changed*

OCCUPANT _____ PHONE _____

PERSON TO CONSTRUCT SYSTEM _____

ADDRESS _____ PHONE _____

SIZE OF LOT _____ TYPE BLDG. 3 or 4

NUMBER OF BEDROOMS

IF NOT SINGLE RESIDENCE DESCRIBE _____

SIGNATURE OF APPLICANT 151 R.W. Dubois

APPROVED BY Raymond Hodge FOR Project DATE 10/14/68

REJECTED BY _____ FOR _____ DATE _____

HOLD PENDING FURTHER TESTS B/H DATE 9 FEB 66

REASONS FOR REJECTION OR HOLDING 9 FEB 66 - Must Hold for (1) Final Plat

(2) Special Plans shows elevation & location of house,
house sewer tank & dry well. 10/14/68 - Final Plat OK
Hold for Plans


THIS IS NOT A PERMIT

-76°57'33"



39°10'39"

39°10'39"

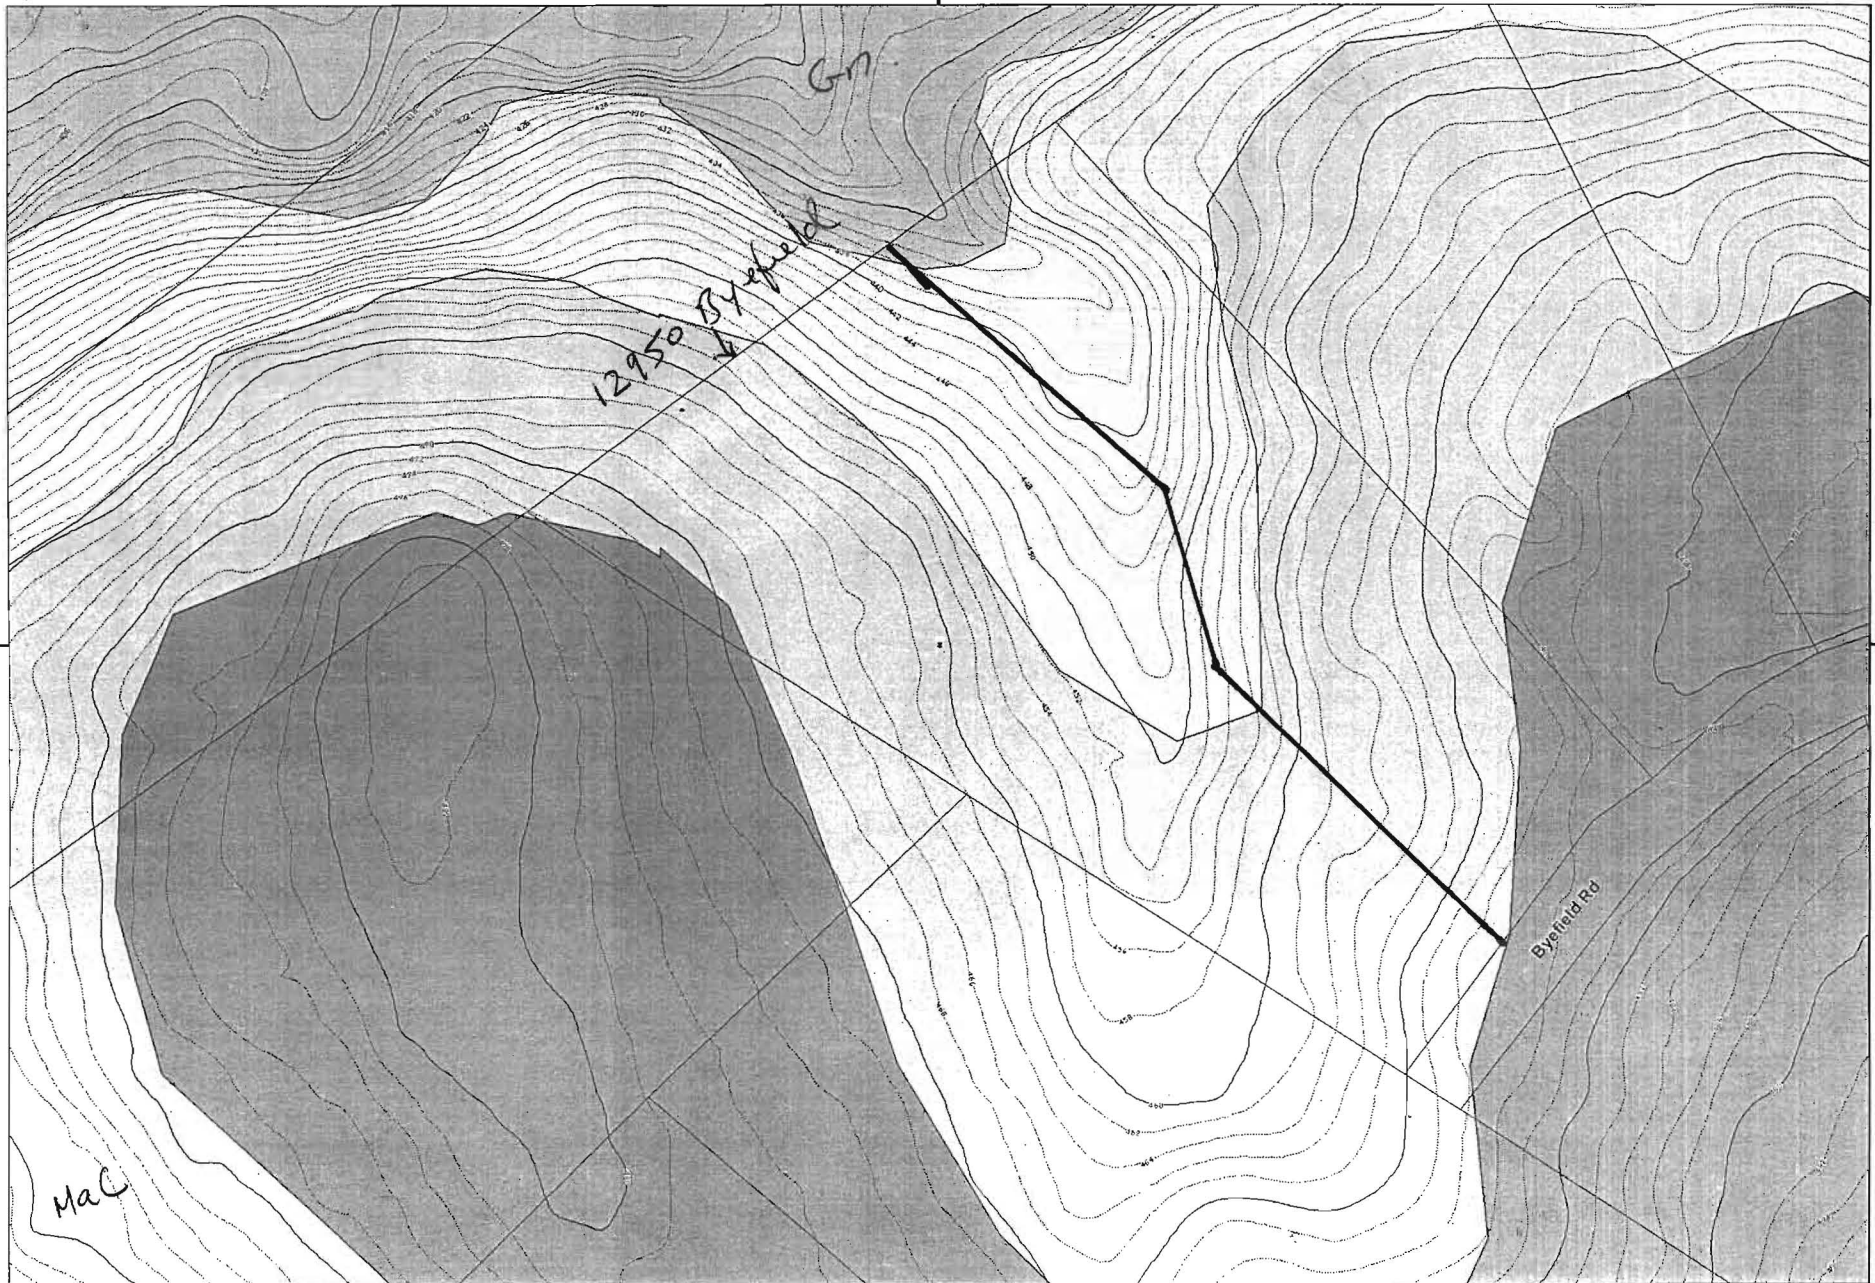

Disclaimer: Howard County, Maryland assumes no responsibility for the accuracy of this report or the information contained herein or derived therefrom. The user assumes all risks and liabilities whatsoever resulting from or arising out of the use of this information. There are no oral agreements or warranties relating to the use of this report.

-76°57'55"

Howard County


Howard County

Topo Map

By:
Office:
Map Width: 910.00 ft.
Print Date: 10/27/2008
Scale: 1 in. = 100 ft. ✕