



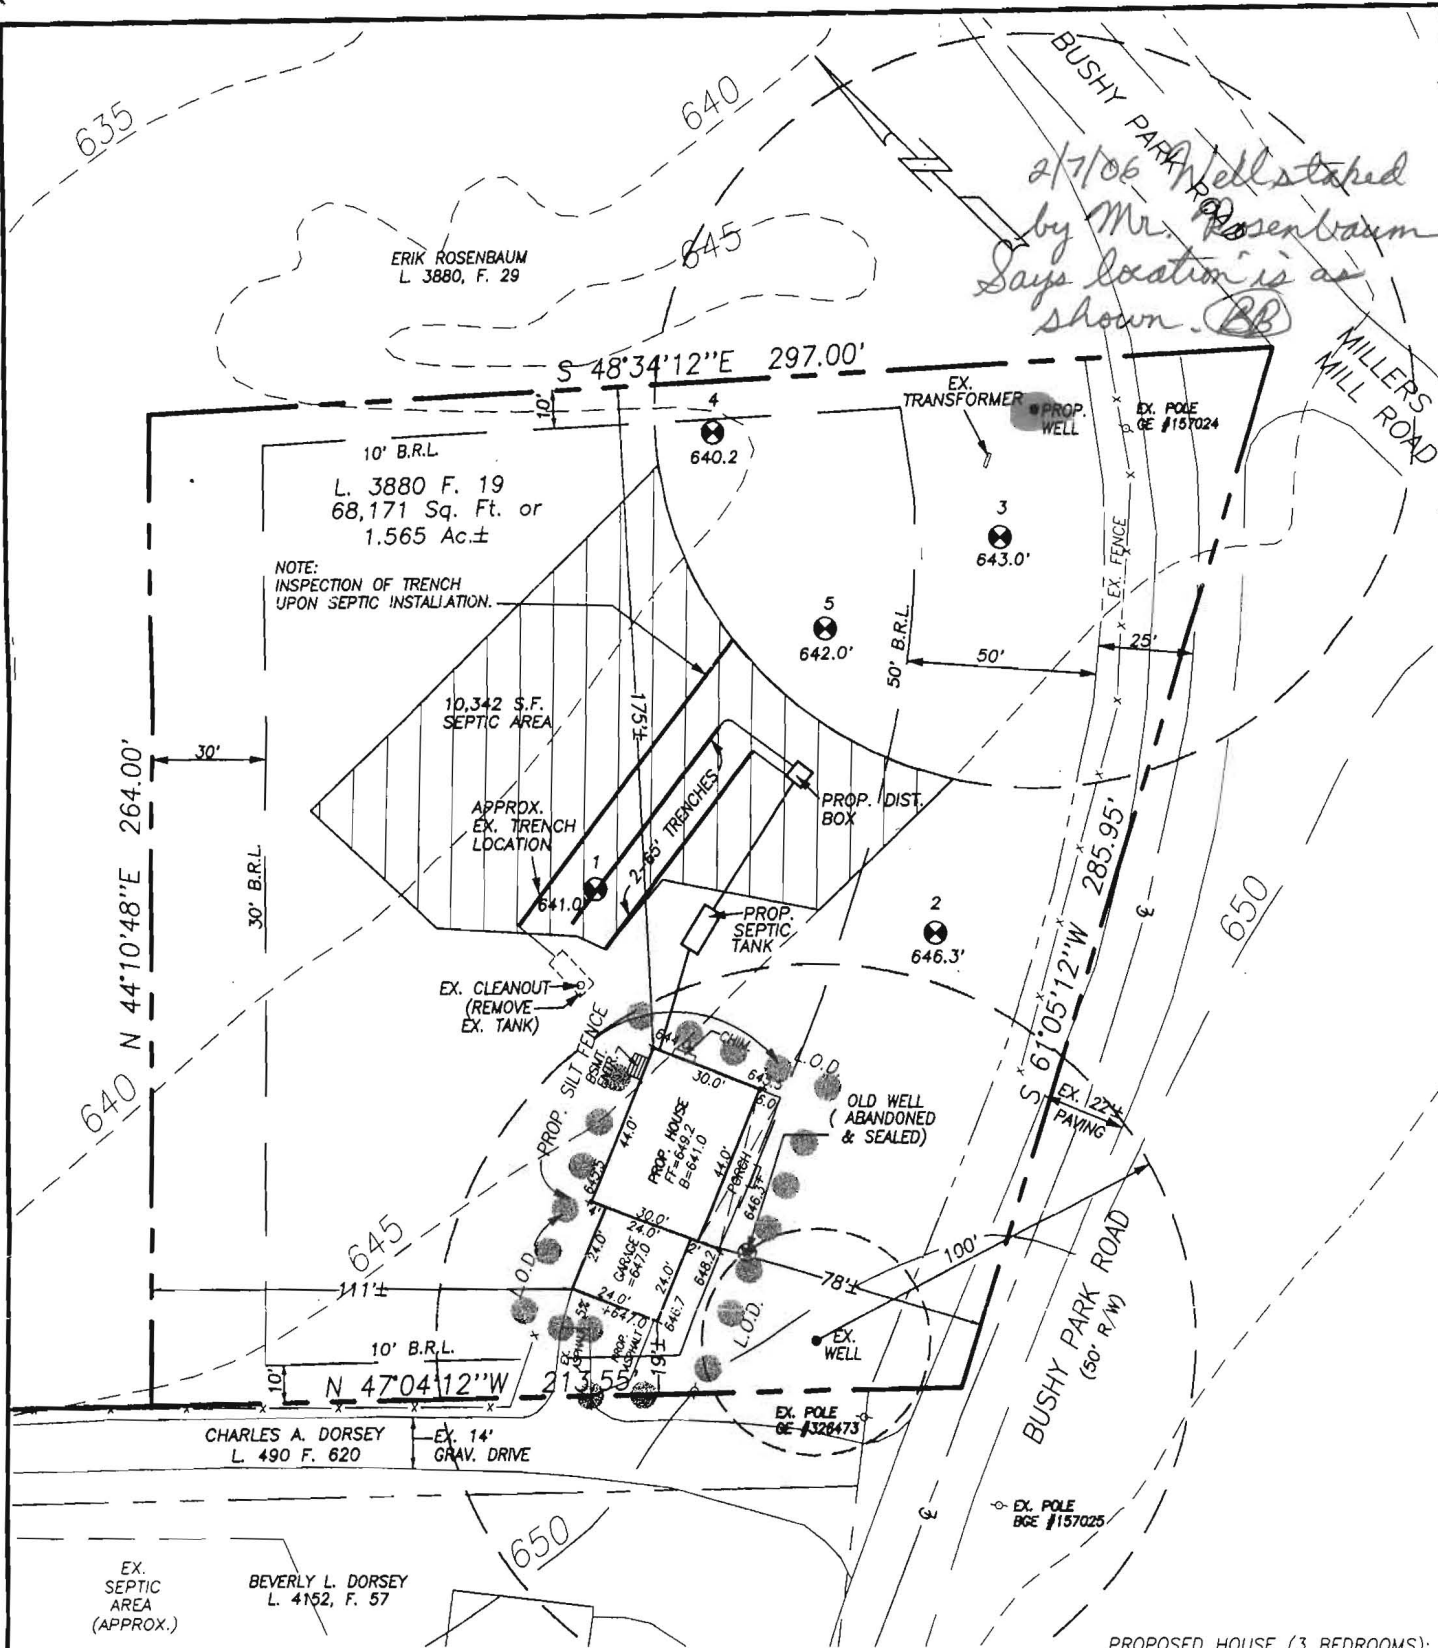

2/1/06 Well staked
by Mr. Rosenbaum
Says location is as
shown. (BB)

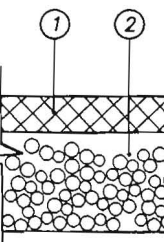


PAVEMENT SECTION
NOT TO SCALE

PROPOSED HOUSE (3 BEDROOMS):
FF ELEV. = 649.2
BSMT. ELEV. = 641.0
GAR. ELEV. = 647.0
INV. OUT = 640.6

PROPOSED SEPTIC TANK:
EX. ELEV. = 643.5
PROP. ELEV. = 643.5
INV. IN = 640.0
INV. OUT = 639.7


PROPOSED DISTRIBUTION BOX:
EX. ELEV. = 643.0
INV. IN = 639.0
INV. OUT = 638.7

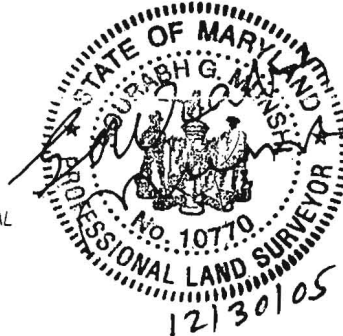

PLOT PLAN
ERIK ROSENBAUM
LIBER 3880 AT FOLIO 19
14806 BUSHY PARK ROAD
FOURTH ELECTION DISTRICT
HOWARD COUNTY, MARYLAND
SCALE: 1" = 50' SEPTEMBER, 2005
REV: 9/20/05 SEPTIC

- NOTES.
1. TOPOGRAPHY: HOWARD COUNTY DATUM
CONTOUR INTERVAL IS FIVE (5) FEET.
 2. TOPOGRAPHY HAS BEEN FIELD VERIFIED BY
VANMAR ASSOCIATES, INC., APRIL, 2005.
 3. THE EXISTING WELL ON SITE (NO TAG) HAS BEEN
FIELD LOCATED BY VANMAR ASSOCIATES, INC., PROFESSIONAL
LAND SURVEYORS AND ACCURATELY SHOWN.
 4. BUILDING RESTRICTION LINES:
FRONT: 50' SIDE: 10' REAR: 30'
 5. DISTURBED AREA (L.O.D.) = 4,600 SQ. FT.
 6. FUTURE SEPTIC REPAIRS WILL REQUIRE PUMPING TO
HIGHER ELEVATION OF SEPTIC AREA.

I CERTIFY THIS PLAT TO BE CORRECT; IT IS THE RESULT
OF AN ACTUAL FIELD SURVEY, BASED ON DATA FOUND
AMONG THE LAND RECORDS OF HOWARD COUNTY,
MARYLAND, AS REFERENCED HEREON.

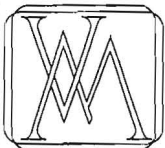

VANMAR ASSOCIATES, INC.
Engineers Surveyors Planners
310 South Main Street P.O. box 328
Mount Airy, Maryland 21771
(301) 829 2890 (301)831 5015 (410) 549 2751

REFERENCE	JOB NO.
LIBER 3880, FOLIO 19	A5-4890

File name: T:\EPI\JOBS\A5-4890\A5-4890S