

8/18/76
8/20/76
8/23/76

PERMIT

SEWAGE DISPOSAL SYSTEM

MARYLAND STATE DEPARTMENT OF HEALTH

HOWARD COUNTY

ELLICOTT CITY

DISTRICT 4th

DATE 8/3/76

INDEXED

Herman Sirk

IS PERMITTED TO INSTALL ALTER X

ADDRESS Jennings Chapel Road, Woodbine, Md. 21797 PHONE 489-4724

A SEWAGE DISPOSAL SYSTEM LOCATED AT

SUBDIVISION ROAD 14806 Bushy Park Road LOT

PROPERTY OWNER Mr. Howard Thomas

ADDRESS Route 1, 14806 Bushy Park Road, Woodbine, Md. 21797

SPECIFICATIONS 3 bedrooms

DRAIN FIELD DEPTH FEET, BOTTOM AREA SQ. FT.

SEEPAGE PITS ABSORBENT SIDE-WALL AREA SQ. FT.

SEPTIC TANK CAPACITY 1000 GALLONS

FOR GARBAGE GRINDER, INCREASE DISPOSAL AREA 22% & TANK CAPACITY 50%.

OTHER REPAIR - Call for inspection when ground is opened up so Sanitarian can recommend repair system.


1000 gal tank, length 75' depth 11ft. 7ft stone

PLANS APPROVED BY Palmer F. Wine DATE 8/3/76

FILL SEPTIC TANK AND DISTRIBUTION BOX WITH WATER BEFORE CALLING FOR AN INSPECTION. COVER NO WORK UNTIL INSPECTED AND APPROVED.

NEITHER THE HOWARD COUNTY COMMISSIONERS NOR THE HEALTH DEPARTMENT IS RESPONSIBLE FOR THE SUCCESSFUL OPERATION OF ANY SYSTEM.

8/23/76

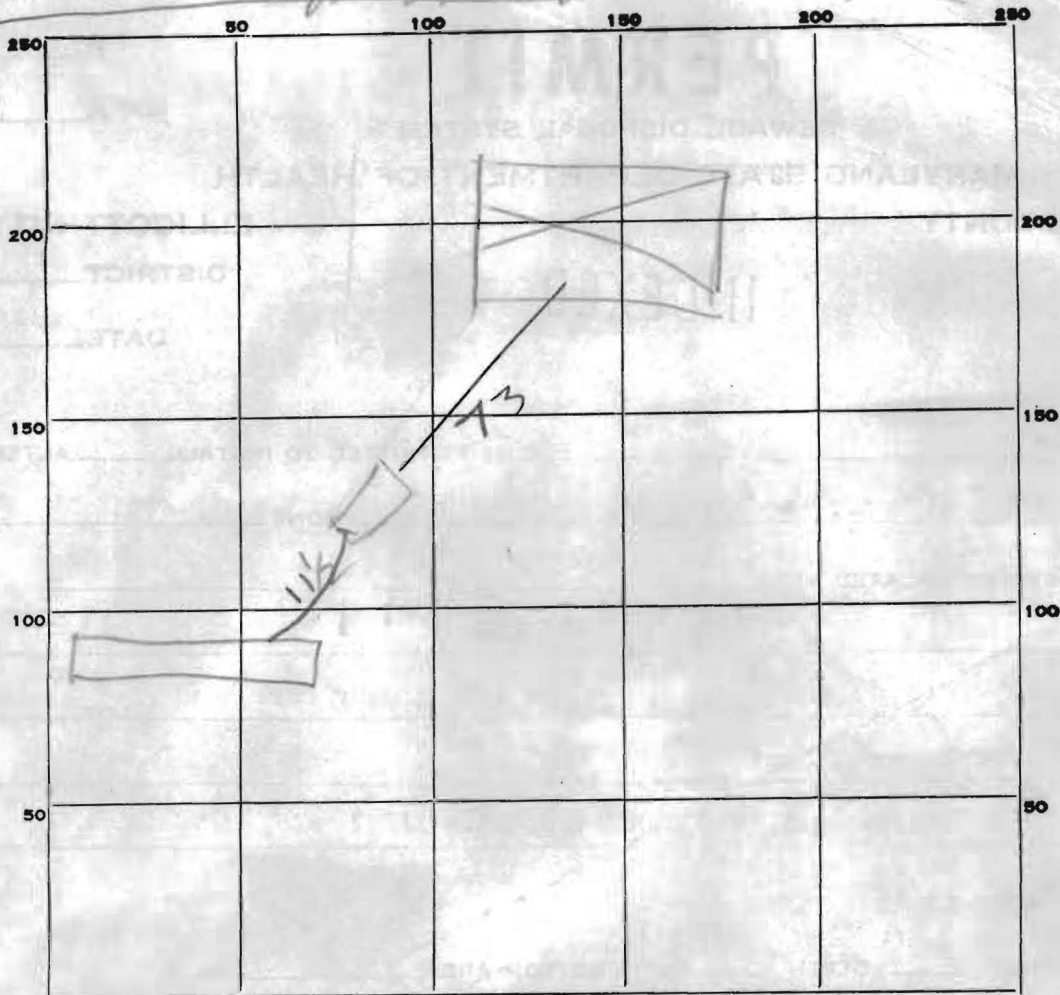

INDICATE NORTH. — NAME ADJOINING ROADWAY AS BASE LINE.

PERMIT CARD _____

SEPTIC TANK, LEVEL OK 1000

CLEANOUTS OK

DISTRIBUTION BOX, LEVEL 76 2 1/2 ft below gran

TILE FIELD, DEPTH 11 1/2 FT. TRENCH WIDTH 2 FT.

GRAVEL DEPTH 7 ft IN. TOTAL LENGTH 75 FT.

NUMBER OF TRENCHES 1

TOTAL SIDE BOTTOM AREA _____

SEEPAGE PITS, INSIDE DIAMETER _____ FT. DEPTH BELOW INLET _____ FT.

ABSORBENT AREA _____ SQ. FT.

REMARKS Trench 75' long 7ft gravel (to be done)

8/23/76 - STONE ADDED RH

WATER WELL 100 FT OR MORE FROM DN

DATE SYSTEM APPROVED 8/23/76

INSPECTOR Raymond Hodges

KEY


- EXISTING RESIDENCE
- EXISTING SEWER TIE
- EXISTING RESIDENCE LOT
- EXISTING LOT AND CHURCH TIE
- RESIDENCE LOT

SCALE 1"=30'

VICINITY MAP

SCALE: 1"=4000'

TAX MAP B BLOCK 22 PARCEL 72

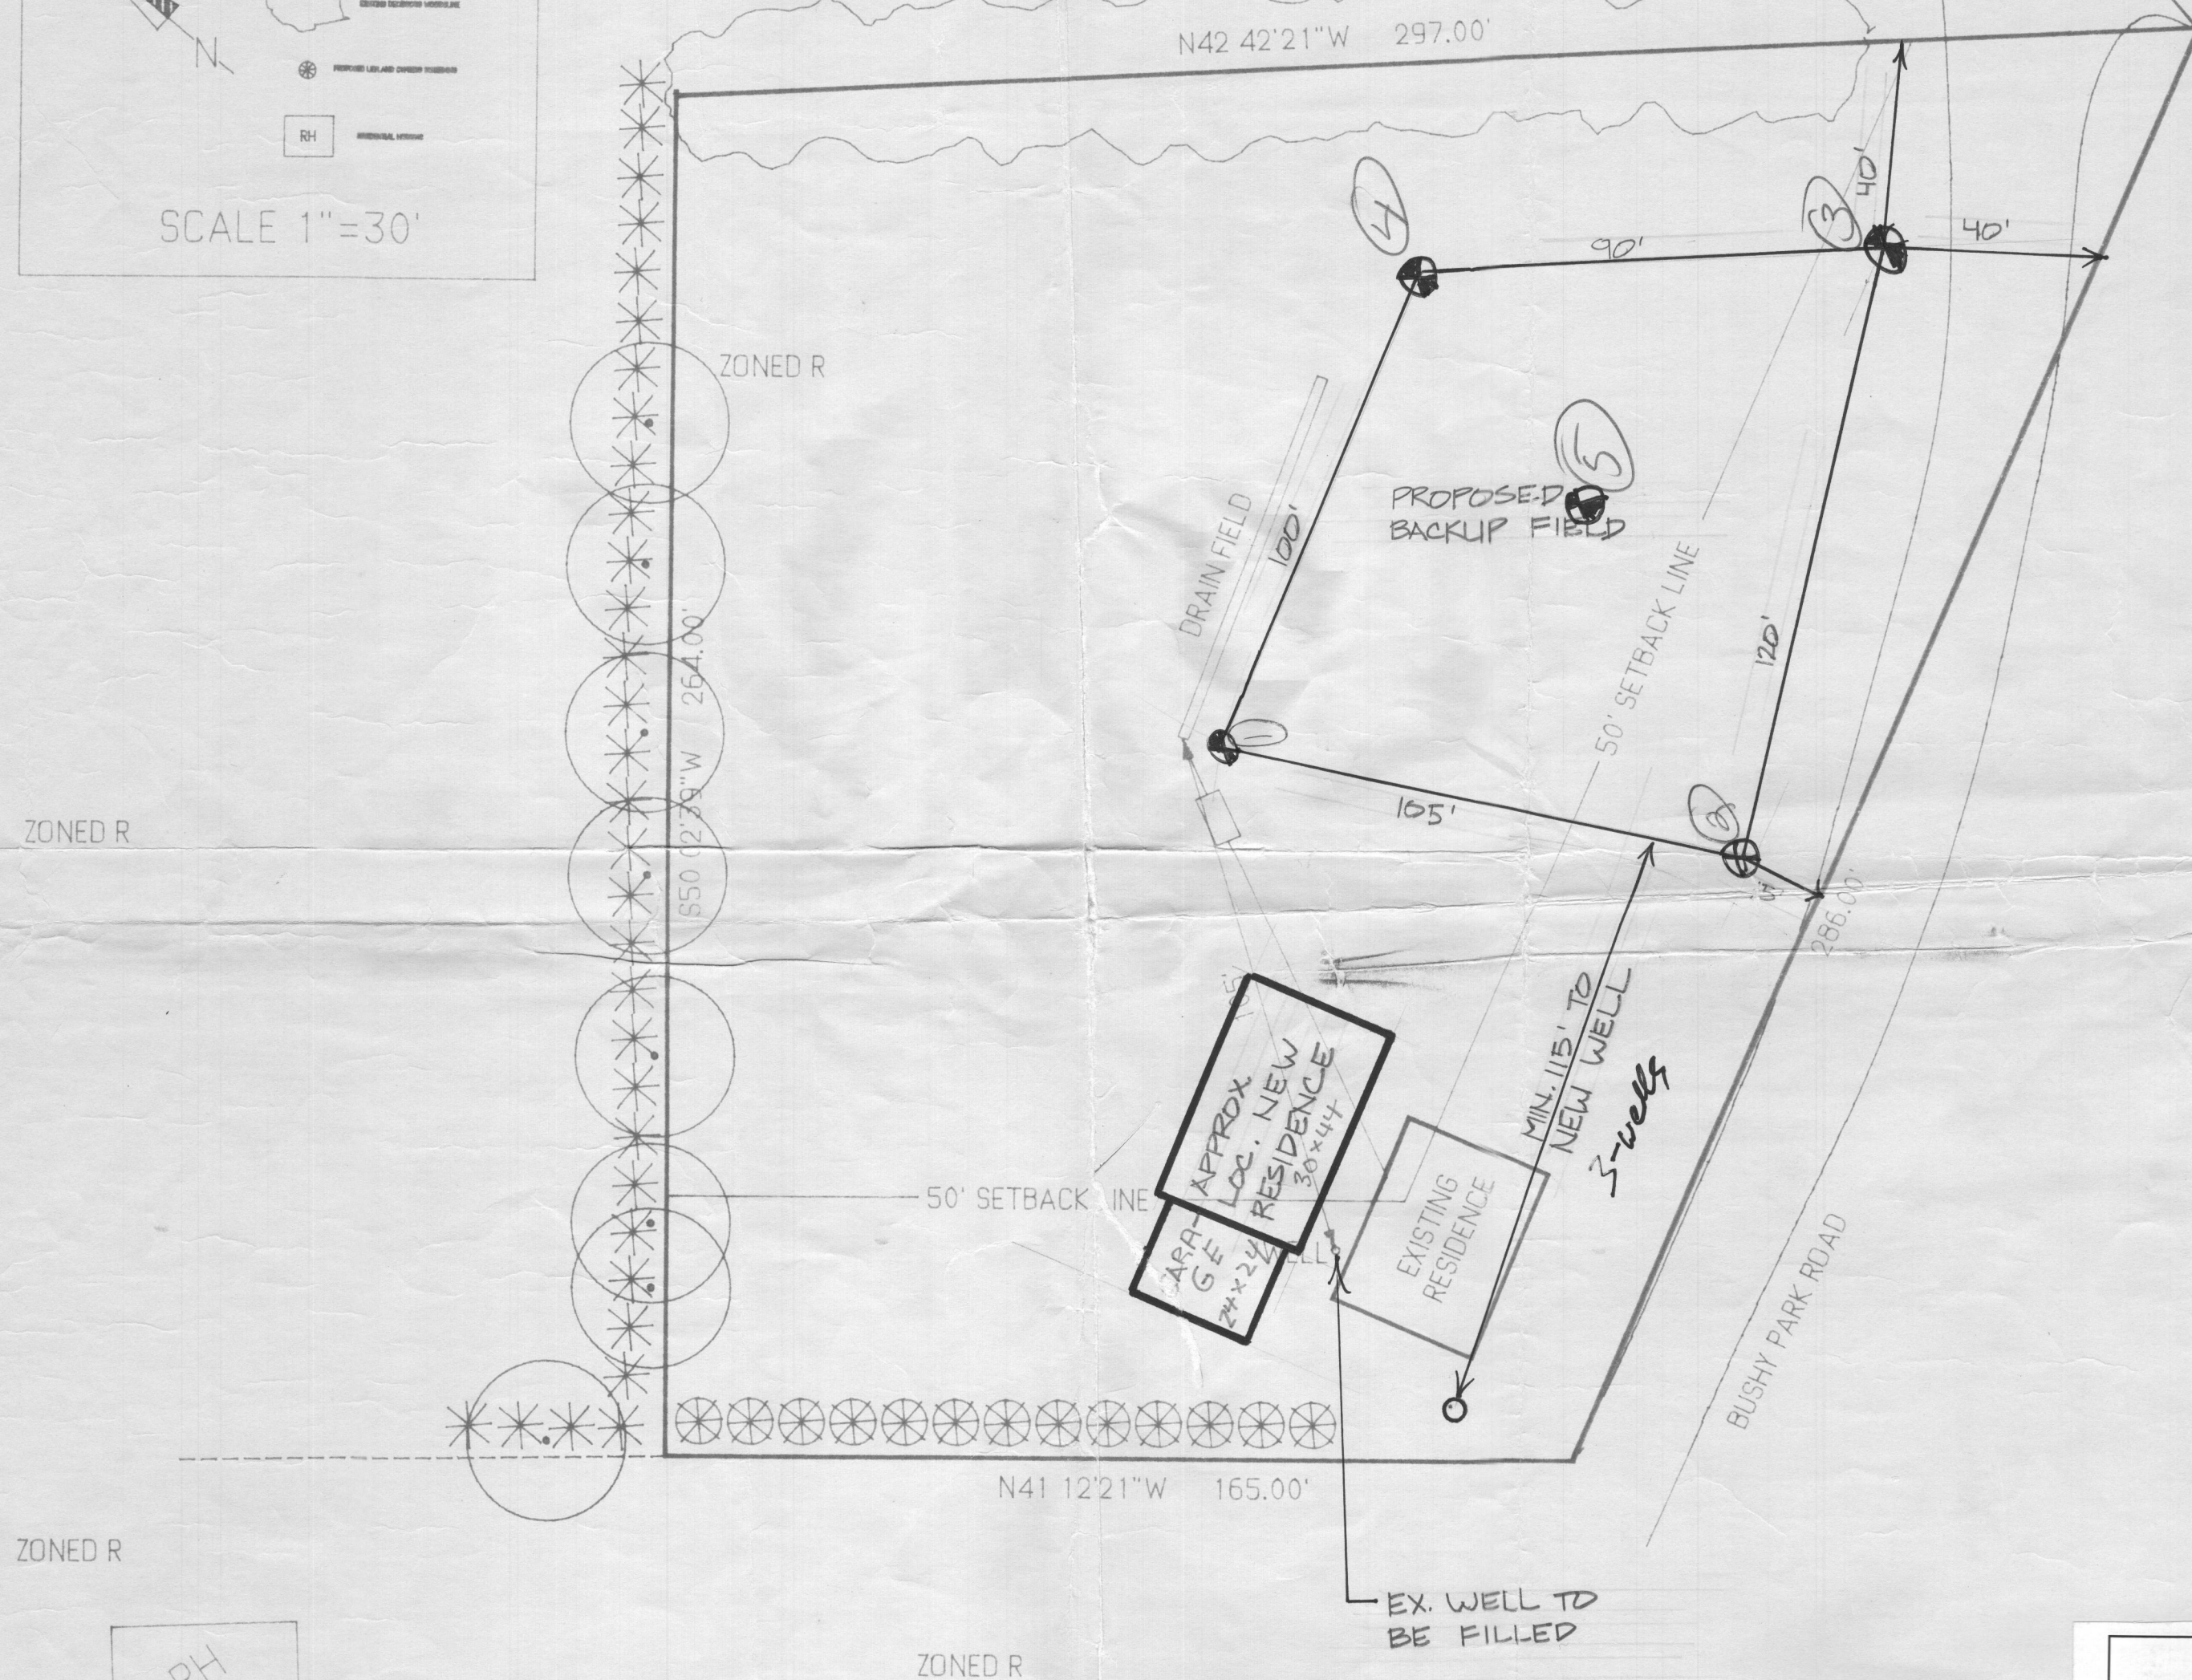

Property Information:		County # Howard	
<u>Erik Rosenbaum</u> Current Owner's Name		<u>14806 Bushy Park Road</u> Address	
<u>N/A</u> Subdivision		<u>N/A</u> Lot #	
<u>Jennifer Thomas</u> All Prior Owner's Name's (if requested or known)		<u>8</u> Tax Map	<u>72</u> Parcel #