

Bureau of Environmental Health
 7178 Gateway Drive Columbia, MD 21046
 (410) 313-2640 Fax (410) 313-2648
 TDD (410) 313-2323 Toll Free 1-866-313-6300
 website: www.hchealth.org

Maura J. Rossman, M.D., Health Officer

RECEIPT DATE: 3-13-15 **ONSITE SEWAGE DISPOSAL SYSTEM**

P 555769

INSTALLATION APPROVAL DATE: 12-28-15 **PERMIT**
 (Kmw)
SEWER HOUSE CONNECTION

A _____

PROPERTY ADDRESS: 5130 Honey Locust Court

SUBDIVISION: Walnut Creek LOT: 39 TAX ID: _____

CONTRACTOR: South Carroll Backhoe EMAIL: scbackhoe@verizon.net

CONTRACTOR ADDRESS: 4410 Salem Bottom Road, Westminster, MD 21157 PHONE: 410-596-3618

PROPERTY OWNER: Trinity Quality Homes EMAIL: _____

OWNER ADDRESS: 3675 Park Avenue, Suite 301, Ellicott City, MD 21043 PHONE: 410-480-0023

NUMBER OF BEDROOMS: 5 HOUSE SQ. FT. _____ CONNECTED TO PUBLIC WATER: YES NO

| | |
|-----------|---|
| LOCATION: | INSTALL 4" SEWER LINE PER APPROVED SITE PLAN. |
| NOTES: | Install SHC and cleanouts per plan. |

ISSUED BY: Hank Oswald ISSUE DATE: 3/13/15 EXPIRATION DATE: 3/13/16


NOTE: HOWARD COUNTY BUREAU OF UTILITIES APPROVAL OF GRINDER PUMP INSTALLATION IS REQUIRED PRIOR TO SEPTIC PERMIT APPROVAL

NOTE: CONTRACTOR MUST SCHEDULE AN INSPECTION AND GAIN APPROVAL OF ALL COMPONENTS PRIOR TO COVERING

NOTE: AN ELECTRICAL PERMIT IS REQUIRED FOR INSTALLATION OF ANY ELECTRICAL COMPONENTS OF THE SYSTEM

**NEITHER THE HOWARD COUNTY COUNCIL NOR THE HEALTH DEPARTMENT IS RESPONSIBLE FOR THE SUCCESSFUL OPERATION OF ANY SYSTEM.
 PERMITTEE RESPONSIBLE FOR OBTAINING FINAL APPROVAL ON THIS PERMIT.
 CALL 410-313-1771 FOR INSPECTION OF SEPTIC SYSTEM.**

NOT TO SCALE

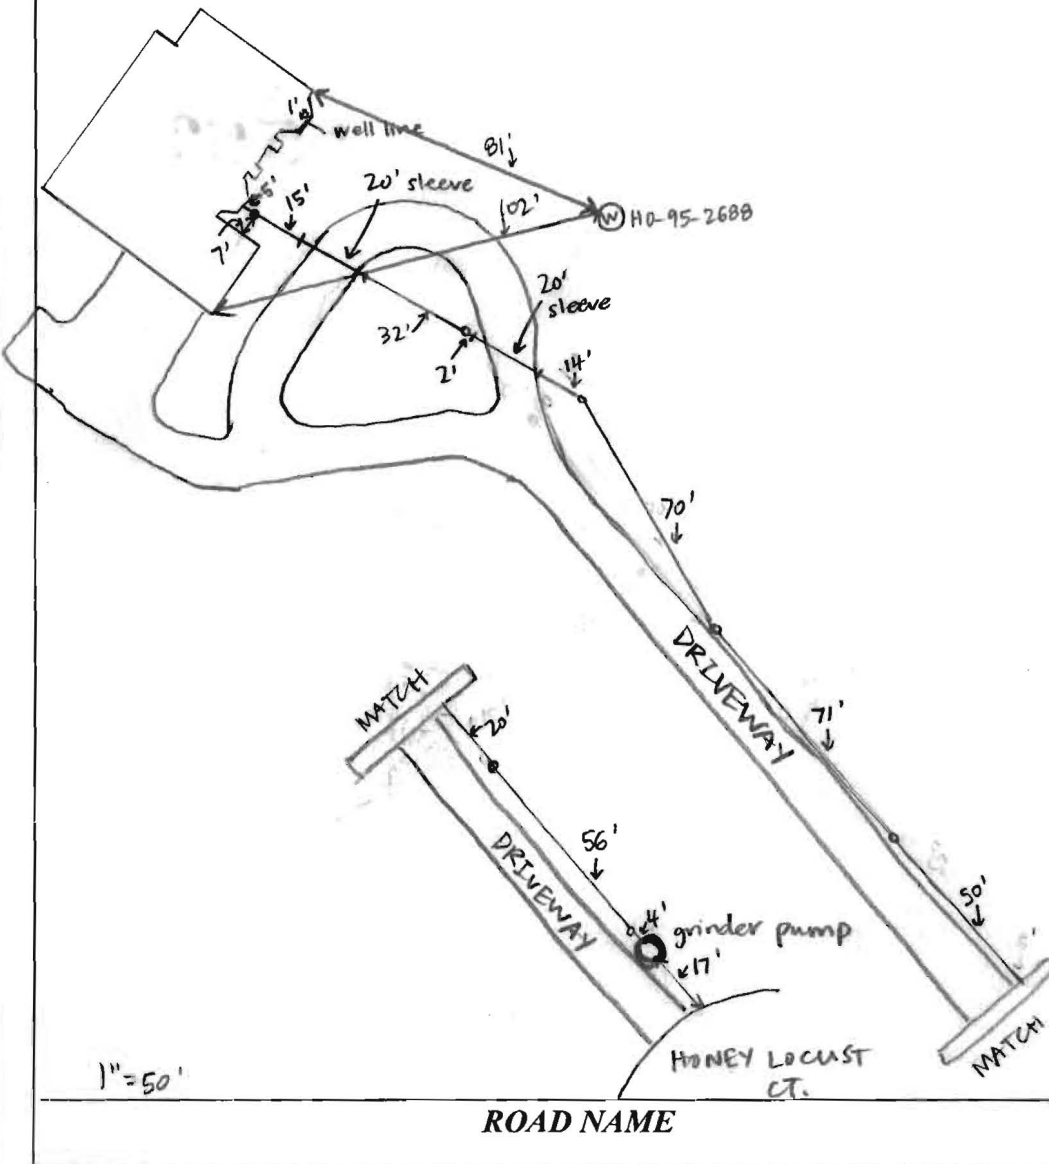

TRENCH/DRAINFIELD DATA

WIDTH INLET BOTTOM

NUMBER OF TRENCHES _____
 TOTAL LENGTH _____
 ABSORPTION AREA _____
 DISTRIBUTION BOX LEVEL _____
 DISTRIBUTION BOX BAFFLE _____
 DISTRIBUTION BOX PORT _____

SEPTIC TANK DATA

SEPTIC TANK I LEVEL _____
 MANUFACTURER _____
 CAPACITY _____ GAL
 SEAM LOC _____
 TANK LID DEPTH _____
 BAFFLES _____
 BAFFLE FILTER _____
 MANHOLE LOC _____
 6" PORT LOC _____
 WATERTIGHT TEST _____
 SLOTTED _____
 DATE ON LID _____

PUMP/SEPTIC TANK LEVEL _____
 MANUFACTURER _____
 CAPACITY _____ GAL
 SEAM LOC _____
 TANK LID DEPTH _____
 BAFFLES _____
 BAFFLE FILTER _____
 MANHOLE LOC _____
 6" PORT LOC _____
 WATERTIGHT TEST _____
 SLOTTED _____
 DATE ON LID _____

PRE-CONSTRUCTION:

INSTALLATION: 3/18/15 Starting SHC at grinder pit and working towards house. Maintaining 1% fall. (SC) 3/19/15 Two more cleanouts installed, more piping laid. Maintaining 1% fall. (SC) 3/23/15 20' pipe laid; S Carrell waiting for Miss Utility to mark gas line. (SC) 3/23/15 50' pipe laid to cleanout before driveway; started digging line from house and planning area under future driveway to have 6" sleeve. (SC) 3/24/15 All pipe installed and connections complete. 20' 6" PVC sleeve under driveway. House connection is under footer, pipe is ~9' deep at house. 2% fall near house, 1% farther out. Needs approval from Bureau of Utilities for grinder pump startup. (SC)

FINAL INSPECTOR

[Signature]

DATE OF APPROVAL

12-28-15

Martin, Sharhonda

From: Baucom, Scott
Sent: Wednesday, December 09, 2015 7:22 AM
To: Harris, Leslie; Wolf, Kevin
Cc: Hart, Amy; Rocco, Anthony; Tuder, Matt; Baker, Brian; Martin, Sharhonda; Williams, Jeffrey; Bozzell, Duane; Bernard, Dana
Subject: U&O Release 5130 Honey Locust Ct.

On the morning of December 8th, Duane Bozzell observed the start-up of a Sewage Grinder Pump at the Walnut Creek Shared Septic System:

Trinity Quality Homes
Walnut Creek, Lot #39
Contract 4530
5130 Honey Locust Ct.
Ellicott City, MD 21042

The Sewage Grinder Pump test was successful ; the Bureau of Utilities releases its hold on this property for U&O.

Scott Baucom
Operations Supervisor I
Howard County DPW, Bureau of Utilities
8270 Old Montgomery Rd.
Columbia, MD 21045
Office (410) 313-4975
FAX (410) 313-4989

