

LEGEND

- - - - - EXISTING 2' CONTOURS
- - - - - EXISTING 10' CONTOURS
- SOIL LINES AND TYPES
- ⊙ DENOTES PROPOSED WELL
- DENOTES PROPOSED HOUSE



NON-BUILDABLE
PARCEL 'J'

PROPERTY OF
STANDISH MELANIE DORSEY
8964/386
PARCEL 82
HOWARD COUNTY AGRICULTURAL
LAND PRESERVATION PROGRAM EASEMENT
(HO-91-12-E)
ZONED RC-DEC

SOILS LEGEND

SOIL	NAME	CLASS
ChB2	Chester silt loam, 3 to 8 percent slopes, moderately eroded	B
EkB2	Eloak silt loam, 3 to 8 percent slopes, moderately eroded	B
MIB2	Minor loam, 3 to 8 percent slopes, moderately eroded	B

- NOTES:**
- * Hydric soils and/or contains hydric inclusions
 - ** May contain hydric inclusions
 - † Generally only within 100-year floodplain areas

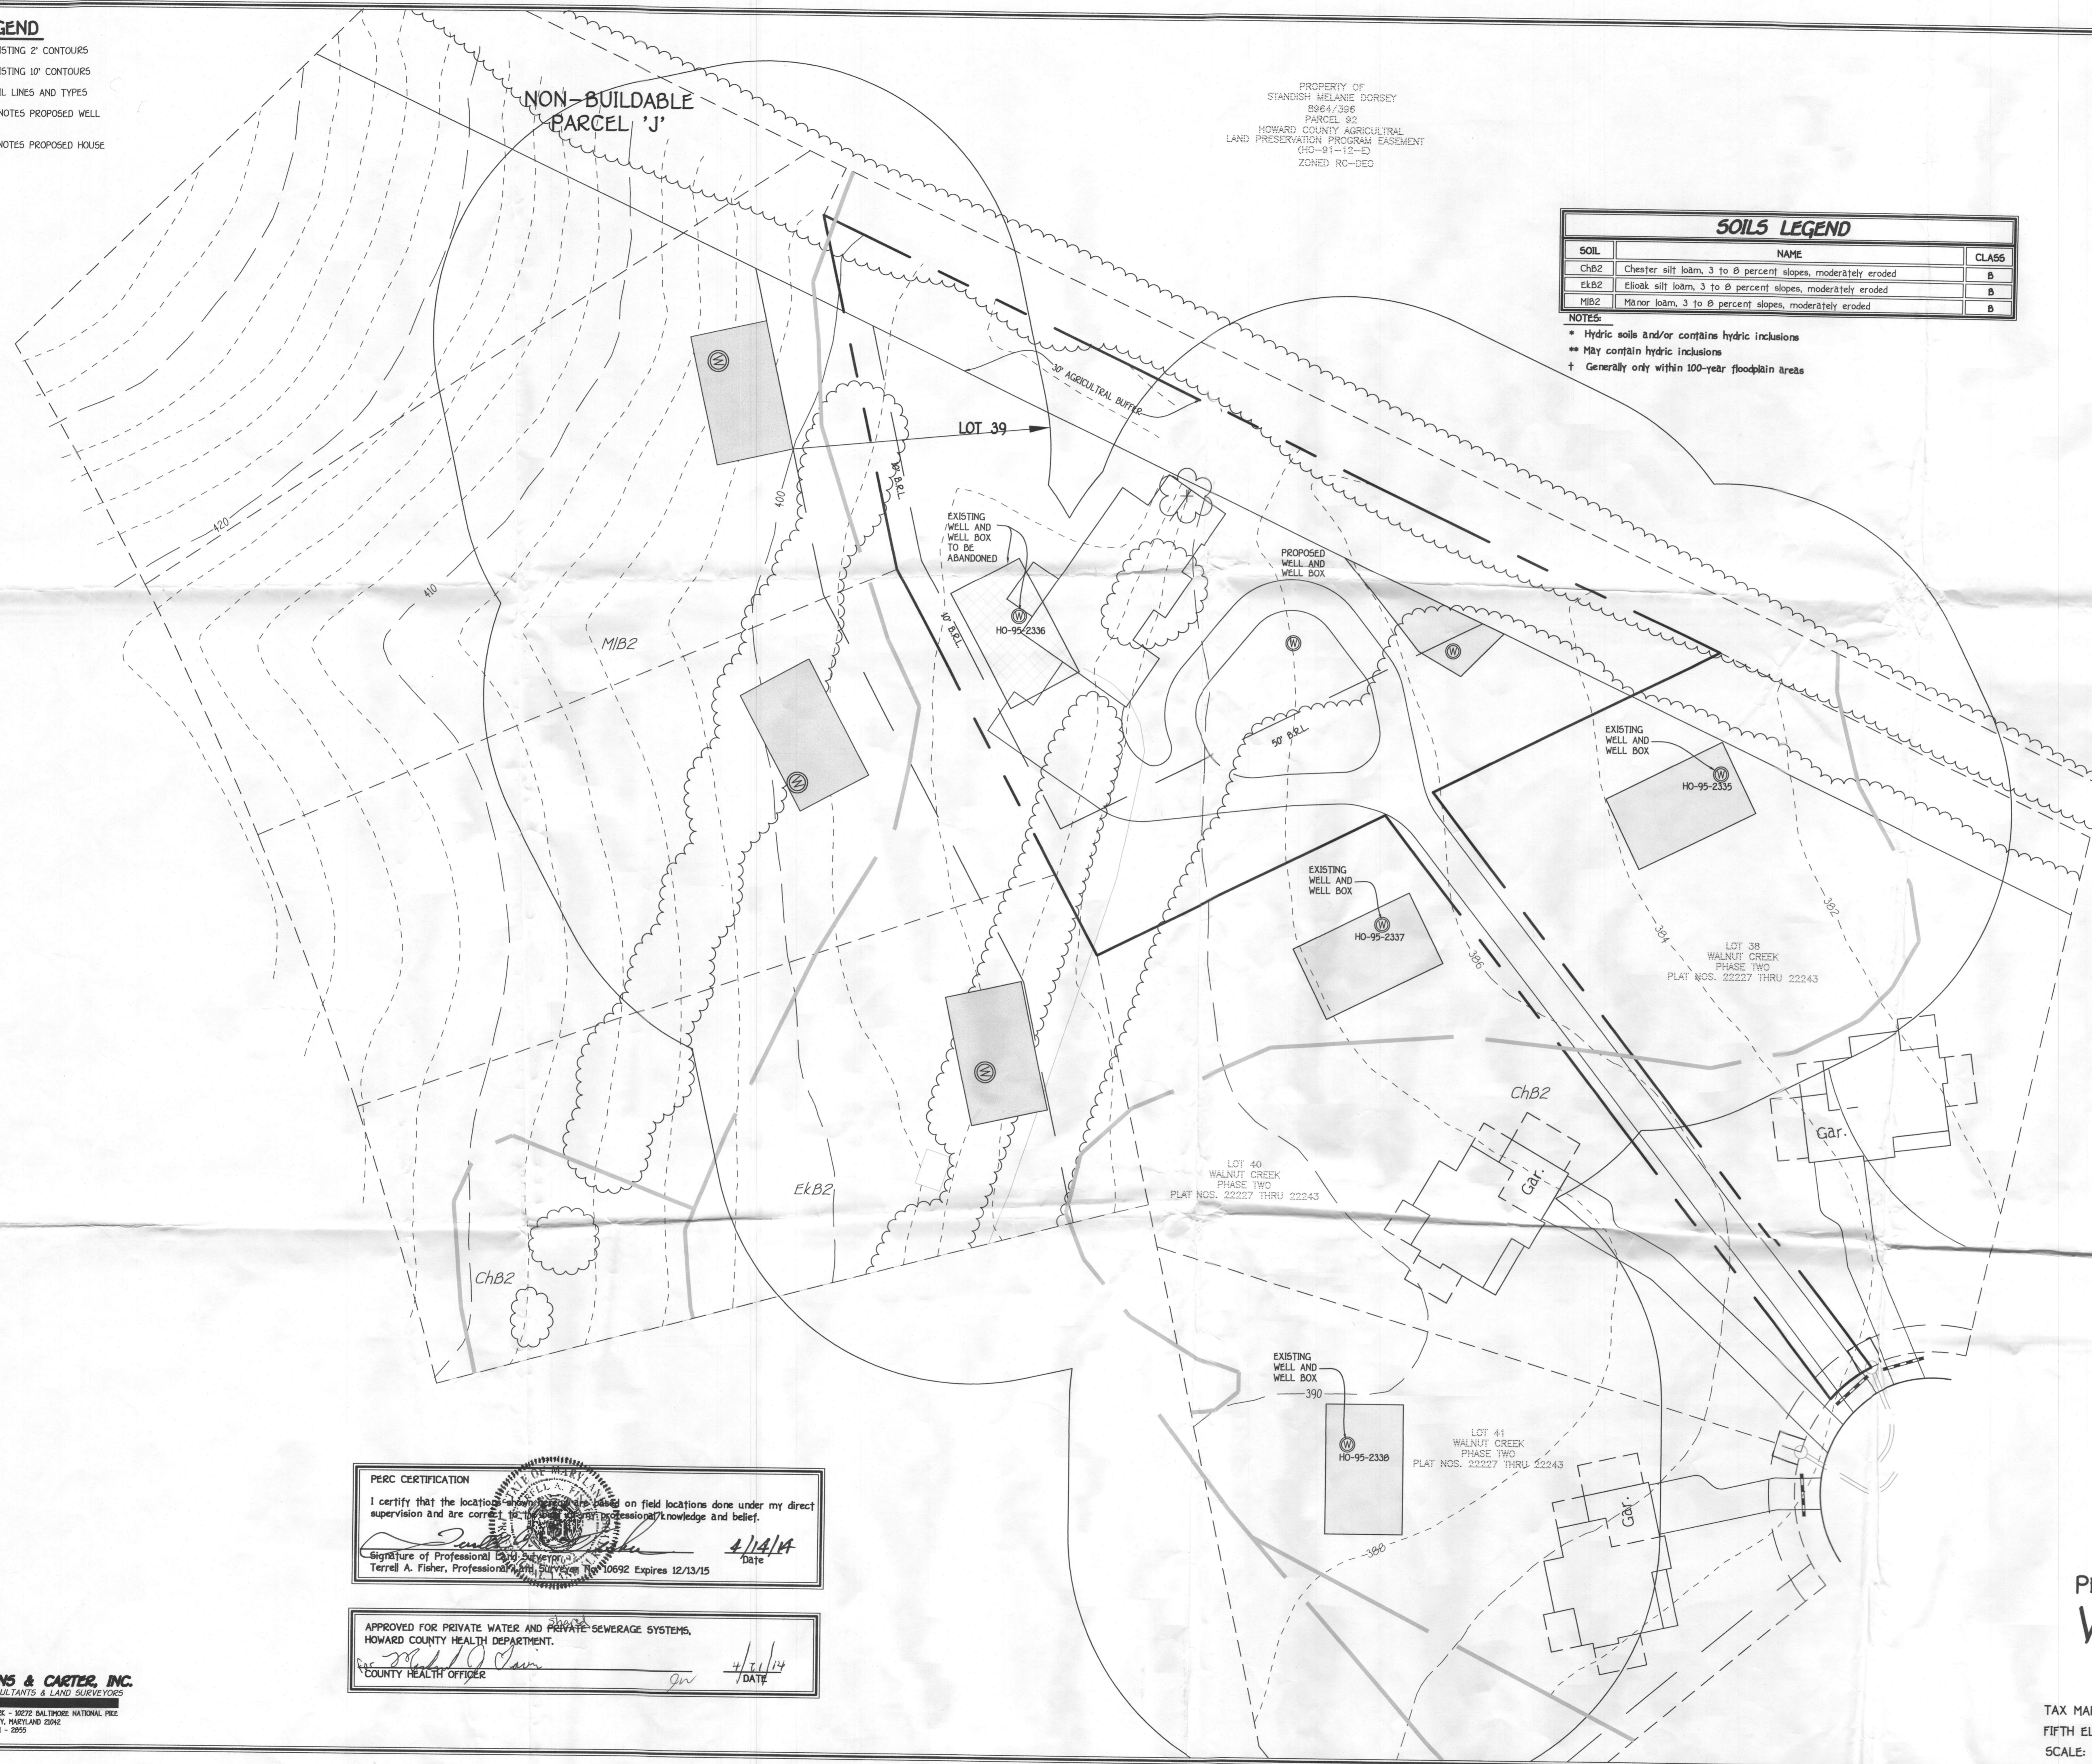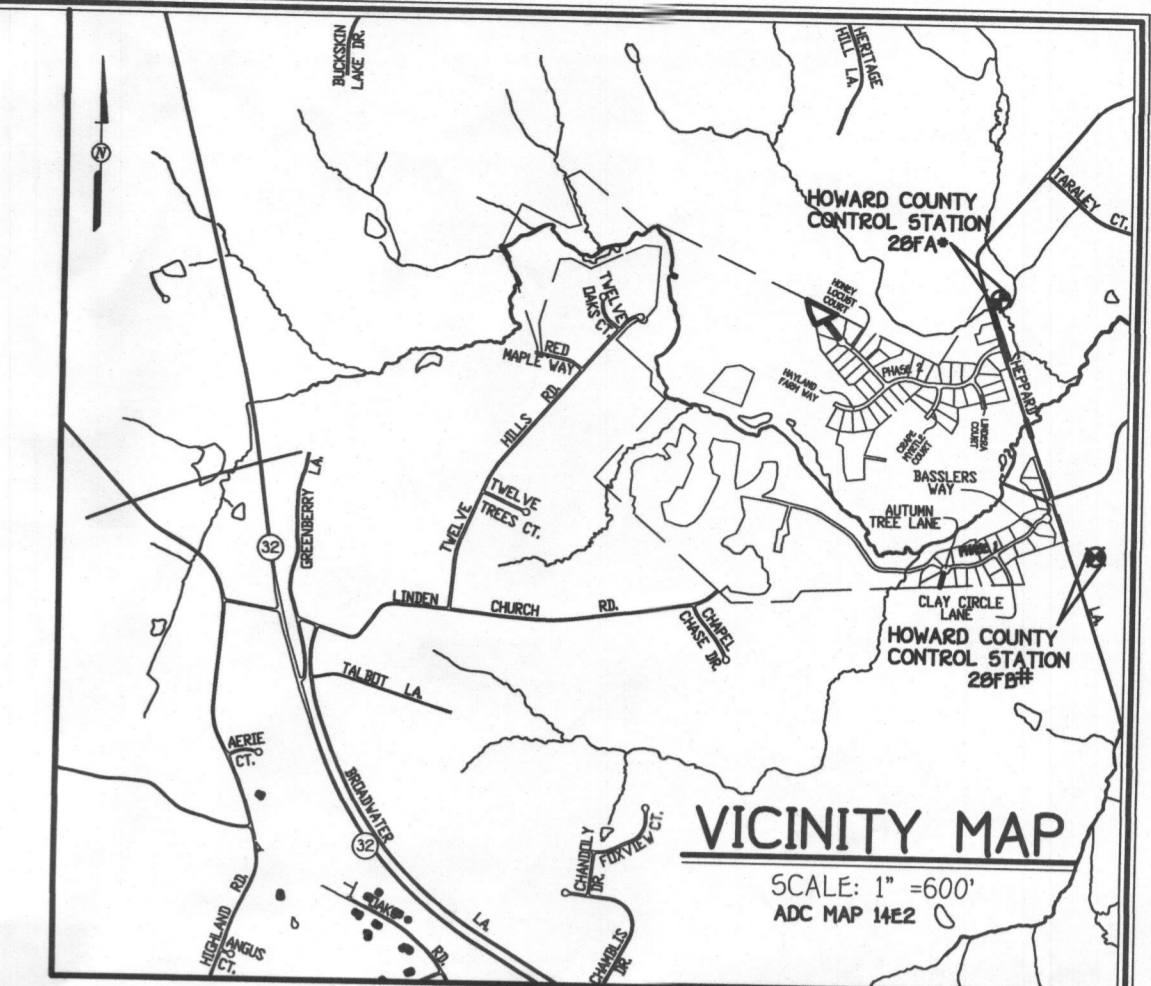

GENERAL NOTES:

1. ADJUSTMENTS TO SEPTIC EASEMENT AREA IS NOT PERMITTED WITHOUT ADDITIONAL TESTING.
2. THE LOT SHOWN HEREON COMPLIES WITH THE MINIMUM OWNERSHIP WIDTH AND LOT AREA AS REQUIRED BY THE MARYLAND STATE DEPARTMENT OF THE ENVIRONMENT.
3. EXISTING WELLS AND/OR SEWERAGE EASEMENTS WITHIN 100 FEET OF THE PROPERTY HAVE BEEN SHOWN FROM ALL REASONABLE EFFORTS.
4. ALL HOUSE SITES SHOWN COMPLY WITH MINIMUM BUILDING RESTRICTION REGULATIONS.
5. TOPOGRAPHIC CONTOURS BASED ON HARFORD AERIAL SURVEYS, INC. DATED FEBRUARY, 2004.
6. THIS PLAT IS BASED ON FIELD RUN MONUMENTED BOUNDARY SURVEY PERFORMED ON OR ABOUT AUGUST, 2004, BY FISHER, COLLINS & CARTER, INC.
7. ANY CHANGES TO A PRIVATE SEWERAGE EASEMENT SHALL REQUIRE A SEWERAGE EASEMENT PLAN.
8. PLAT'S REFERENCE 22227/22243/22243.
9. LOTS 23 THRU 68 OF THIS SUBDIVISION ARE CONNECTED TO THE SHARED SEWAGE DISPOSAL FACILITY GOVERNED BY SECTIONS 18.1200 ET SEQ. OF THE HOWARD COUNTY CODE. THE DEVELOPER IS OBLIGATED TO CONSTRUCT THE FACILITY UNDER THE PROVISION OF THE DEVELOPER AGREEMENT NUMBER 90-444-D DATED APRIL 8, 2009. A BUILDING PERMIT FOR LOTS 23 THRU 68 MAY NOT BE ISSUED UNTIL THE CONSTRUCTION OF THE FACILITY IS COMPLETED. ACTIVITY ON THESE LOTS IS RESTRICTED AND IS SUBJECT TO THE DECLARATION OF COVENANTS, CONDITIONS, RIGHT-OF-ENTRY, AND RESTRICTIONS FOR SHARED SEWAGE DISPOSAL FACILITY INTENDED TO BE RECORDED AMONG THE LAND RECORDS OF HOWARD COUNTY, MARYLAND. LOTS 23 THRU 68 SHALL BE ASSESSED SHARED SEWAGE DISPOSAL FACILITY CHARGES AND ASSESSMENTS PURSUANT TO SECTIONS 20.800 ET SEQ. OF THE HOWARD COUNTY CODE.
10. LOT YIELD IS CONTINGENT ON MEETING ALL REQUIREMENTS OF THE GROUNDWATER APPROPRIATIONS PERMIT AND ANY OTHER STATE OR COUNTY REQUIREMENTS.

THE PURPOSE FOR THIS PLAN IS TO REVISE THE WELL BOX LOCATION ON LOT 39.

PERC CERTIFICATION
I certify that the locations shown hereon are based on field locations done under my direct supervision and are correct to the best of my professional knowledge and belief.
Terrell A. Fisher
Signature of Professional Engineer
Terrell A. Fisher, Professional Engineer No. 10692 Expires 12/13/15
Date: 4/14/14

APPROVED FOR PRIVATE WATER AND PRIVATE SEWERAGE SYSTEMS,
HOWARD COUNTY HEALTH DEPARTMENT.
[Signature]
COUNTY HEALTH OFFICER
Date: 4/14/14

FISHER, COLLINS & CARTER, INC.
CIVIL ENGINEERING CONSULTANTS & LAND SURVEYORS
CONTINENTAL SQUARE OFFICE PARK 10272 BALTIMORE NATIONAL PIKE
ELICOTT CITY, MARYLAND 21042
410.481.2895

TAX MAP #28
FIFTH ELECTION DISTRICT
SCALE: 1"=30'

PARCEL: 49
HOWARD COUNTY, MARYLAND
DATE: April 14, 2014

**PERC RECERTIFICATION PLAT
WALNUT CREEK
PHASE TWO
LOT 39**

LEGEND

- - - - - EXISTING 2' CONTOURS
- - - - - EXISTING 10' CONTOURS
- SOIL LINES AND TYPES
- ⊕ DENOTES PROPOSED WELL
- ⌂ DENOTES PROPOSED HOUSE



NON-BUILDABLE
PARCEL 'J'

PROPERTY OF
STANDISH MELANIE DORSEY
8964/396
PARCEL 92
HOWARD COUNTY AGRICULTURAL
LAND PRESERVATION PROGRAM EASEMENT
(HO-91-12-E)
ZONED RC-DEO

SOILS LEGEND

SOIL	NAME	CLASS
ChB2	Chester silt loam, 3 to 8 percent slopes, moderately eroded	B
EkB2	Elioak silt loam, 3 to 8 percent slopes, moderately eroded	B
MIB2	Marion loam, 3 to 8 percent slopes, moderately eroded	B

- NOTES:**
- Hydric soils and/or contains hydric inclusions
 - ** May contain hydric inclusions
 - † Generally only within 100-year floodplain areas

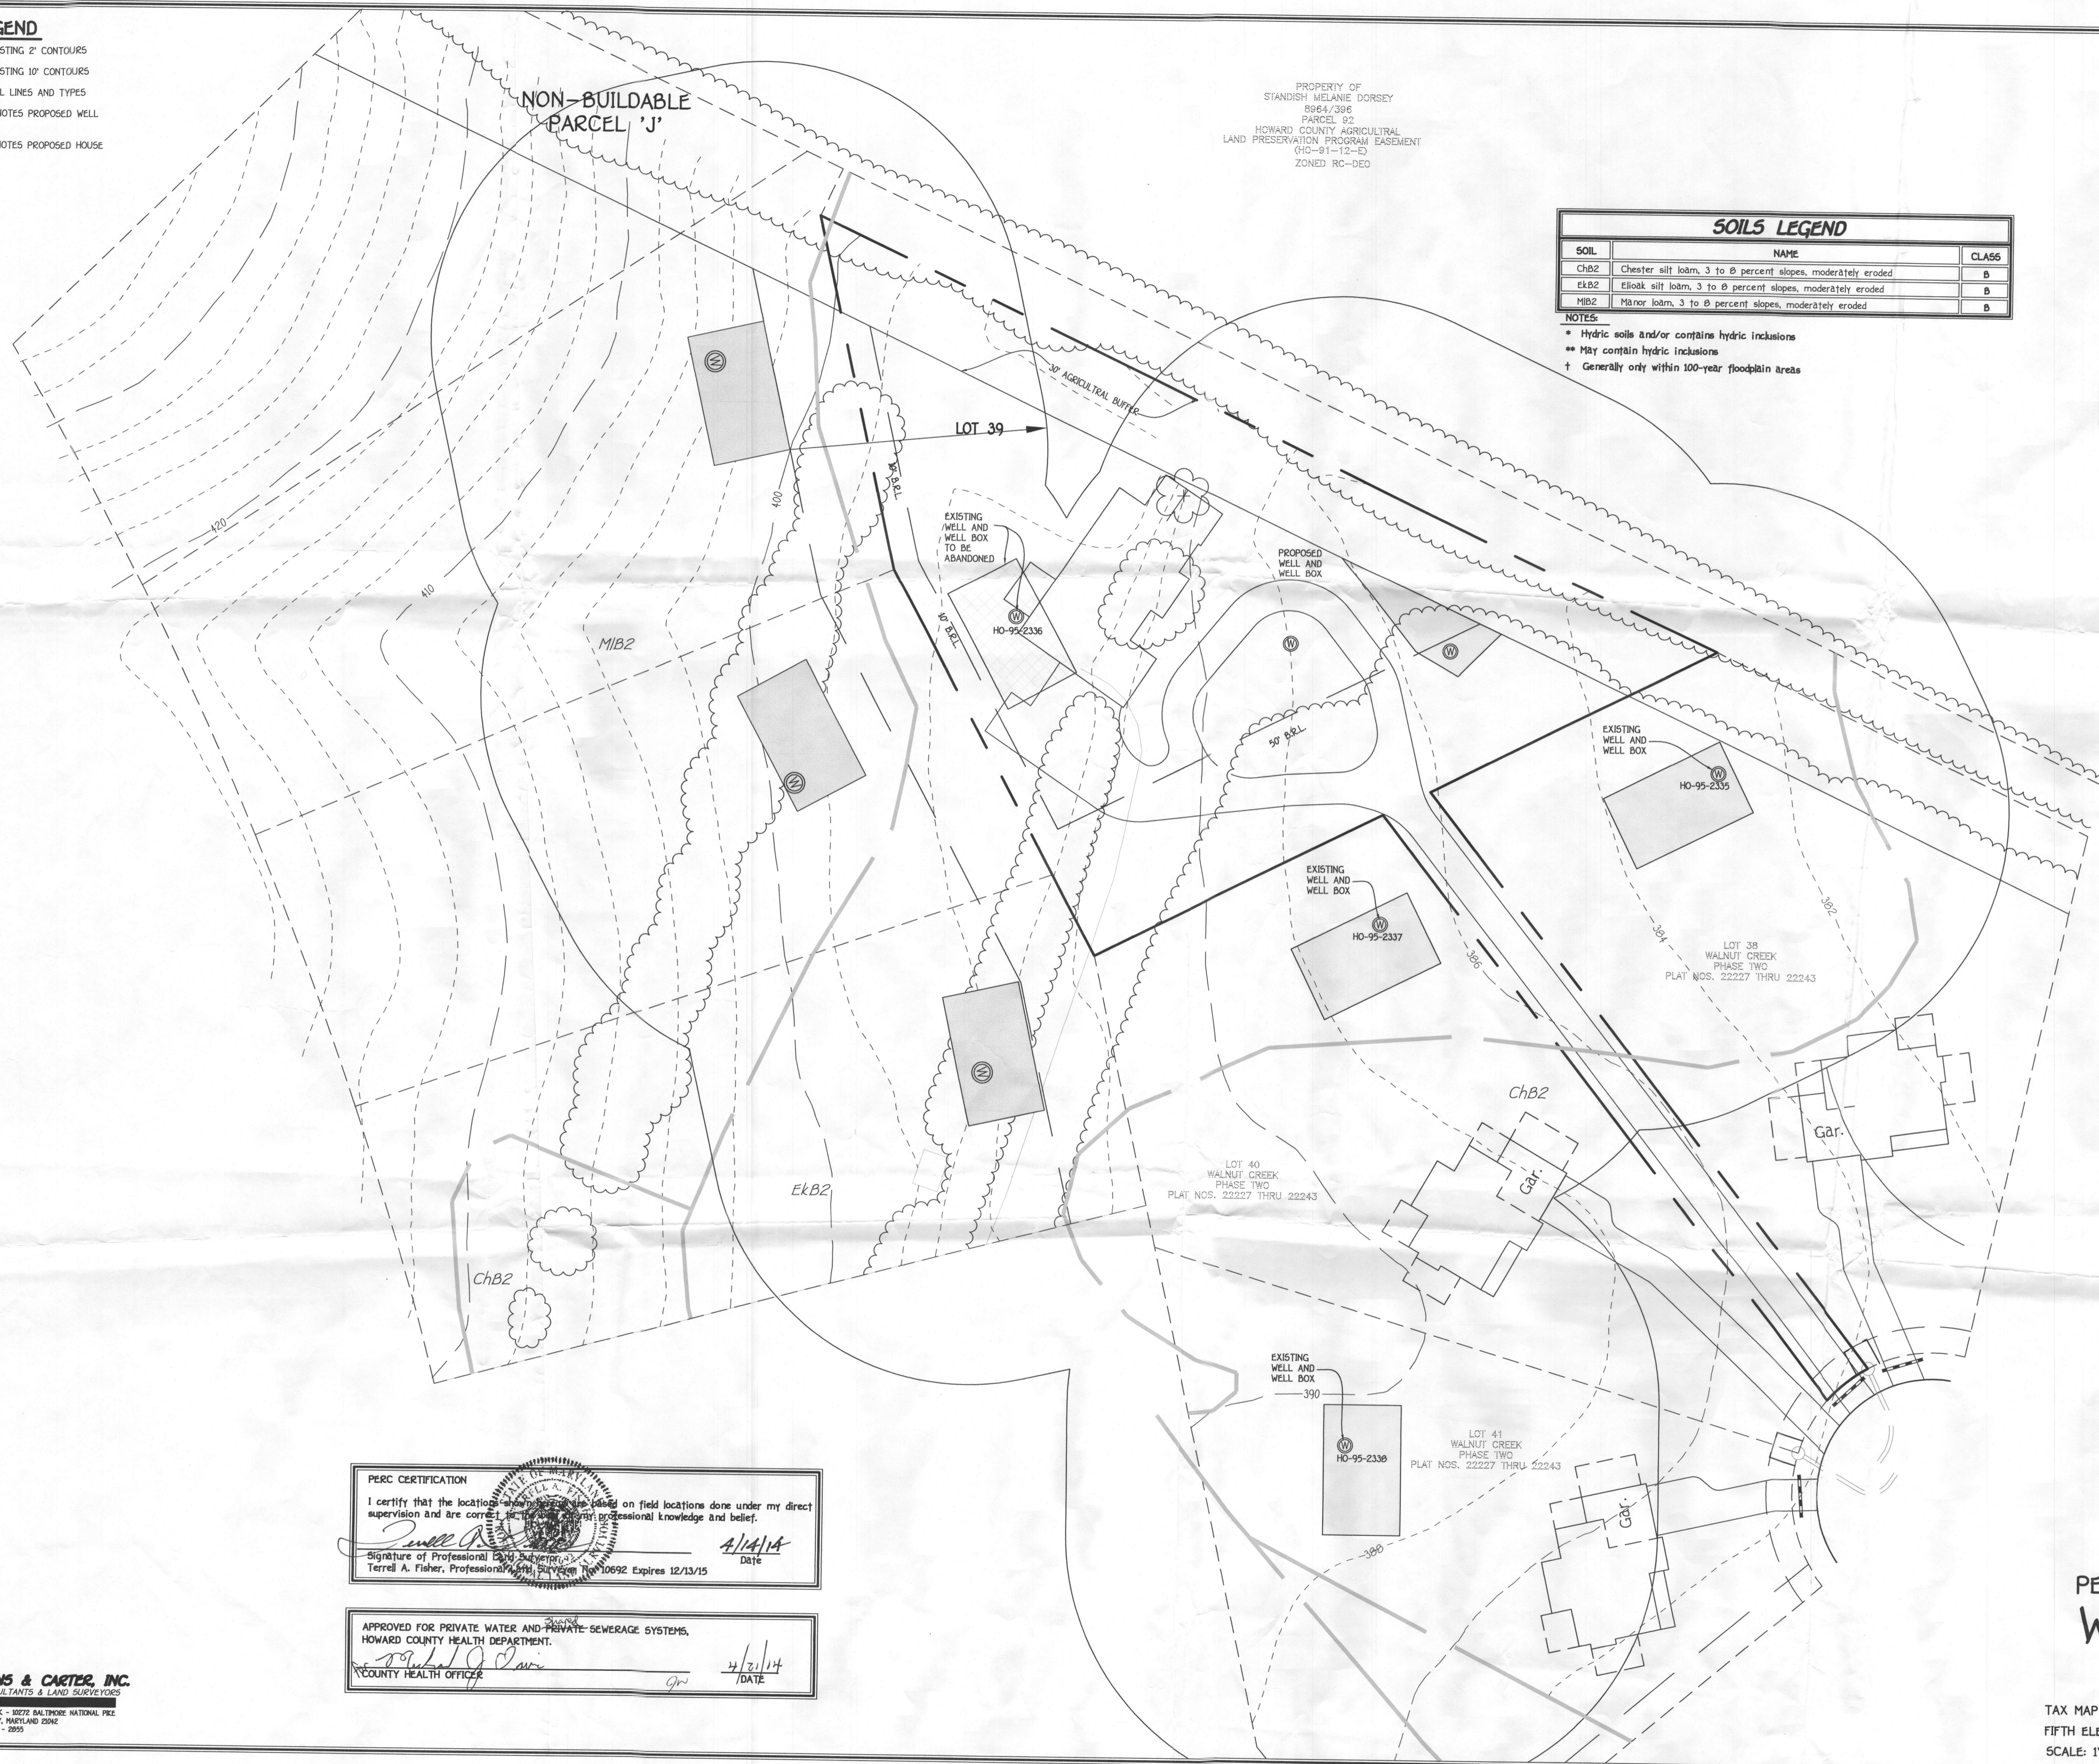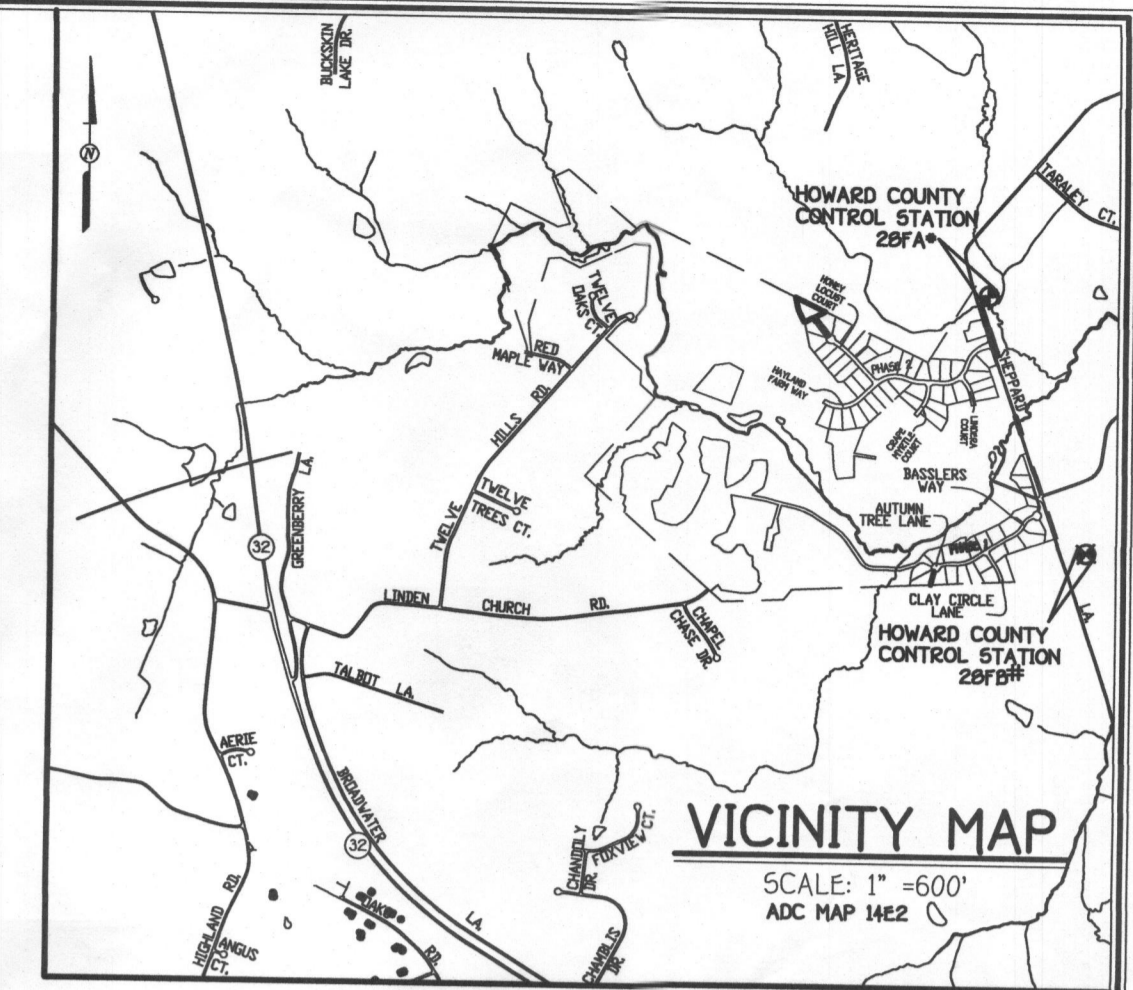

GENERAL NOTES:

1. ADJUSTMENTS TO SEPTIC EASEMENT AREA IS NOT PERMITTED WITHOUT ADDITIONAL TESTING.
2. THE LOT SHOWN HEREON COMPLIES WITH THE MINIMUM OWNERSHIP WIDTH AND LOT AREA AS REQUIRED BY THE MARYLAND STATE DEPARTMENT OF THE ENVIRONMENT.
3. EXISTING WELLS AND/OR SEWERAGE EASEMENTS WITHIN 100 FEET OF THE PROPERTY HAVE BEEN SHOWN FROM ALL REASONABLE EFFORTS. ALL HOUSE SITES SHOWN COMPLY WITH MINIMUM BUILDING RESTRICTION REGULATIONS.
4. TOPOGRAPHIC CONTOURS BASED ON HARFORD AERIAL SURVEYS, INC. DATED FEBRUARY, 2004.
5. THIS PLAT IS BASED ON FIELD RUN MONUMENTED BOUNDARY SURVEY PERFORMED ON OR ABOUT AUGUST, 2004, BY FISHER, COLLINS & CARTER, INC.
6. ANY CHANGES TO A PRIVATE SEWERAGE EASEMENT SHALL REQUIRE A REVISED PERC CERTIFICATION PLAN.
7. PLATS REFERENCE 22227 THRU 22243.
8. LOTS 23 THRU 69 OF THIS SUBDIVISION ARE CONNECTED TO THE SHARED SEWAGE DISPOSAL FACILITY GOVERNED BY SECTIONS 151200 ET SEQ. OF THE HOWARD COUNTY CODE. THE DEVELOPER IS OBLIGATED TO CONSTRUCT THE FACILITY UNDER THE PROVISION OF THE DEVELOPER AGREEMENT NUMBER 50-4441-D DATED APRIL 8, 2009.
9. A BUILDING PERMIT FOR LOTS 23 THRU 69 MAY NOT BE ISSUED UNTIL THE CONSTRUCTION OF THE FACILITY IS COMPLETED. ACTIVITY ON THESE LOTS IS RESTRICTED AND IS SUBJECT TO THE DECLARATION OF COVENANTS, CONDITIONS, RIGHT-OF-ENTRY, AND RESTRICTIONS FOR SHARED SEWAGE DISPOSAL FACILITY INTENDED TO BE RECORDED AMONG THE LAND RECORDS OF HOWARD COUNTY, MARYLAND. LOTS 23 THRU 69 SHALL BE ASSESSED SHARED SEWAGE DISPOSAL FACILITY CHARGES AND ASSESSMENTS PURSUANT TO SECTIONS 20.800 ET SEQ. OF THE HOWARD COUNTY CODE.
10. LOT YIELD IS CONTINGENT ON MEETING ALL REQUIREMENTS OF THE GROUNDWATER APPROPRIATIONS PERMIT AND ANY OTHER STATE OR COUNTY REQUIREMENTS.

PERC CERTIFICATION
I certify that the locations shown on this plat are based on field locations done under my direct supervision and are correct as shown by my professional knowledge and belief.

Terrell A. Fisher
Signature of Professional Civil Engineer
Terrell A. Fisher, Professional Civil Engineer No. 10692 Expires 12/13/15
Date: 4/14/14

APPROVED FOR PRIVATE WATER AND PRIVATE SEWERAGE SYSTEMS,
HOWARD COUNTY HEALTH DEPARTMENT.

Terrell A. Fisher
COUNTY HEALTH OFFICER
Date: 4/21/14

THE PURPOSE FOR THIS PLAN IS TO REVISE THE WELL BOX LOCATION ON LOT 39.

**PERC RECERTIFICATION PLAT
WALNUT CREEK
PHASE TWO
LOT 39**

TAX MAP #28 PARCEL: 49
FIFTH ELECTION DISTRICT HOWARD COUNTY, MARYLAND
SCALE: 1"=30' DATE: April 14, 2014


**NON-BUILDABLE
PARCEL 'J'**

PROPERTY OF
STANDISH MELANIE DORSEY
89647396
PARCEL 92
HOWARD COUNTY AGRICULTURAL
LAND PRESERVATION PROGRAM EASEMENT
(HC-81-12-E)
ZONED RC-DEO



LEGEND

- EXISTING CONTOUR 382
380
- EXISTING TREES TO REMAIN
- SOIL BOUNDARY
- PROPERTY LINE
- PASSED PERC. TEST
- EXISTING WELL FIELD LOCATED W
- PREVIOUS ALTERNATE WELL LOCATION TO BE ELIMINATED W
- APPROVED WELL AREA
- APPROVED WELL AREA TO BE ABANDONED
- PROPOSED WELL AREA

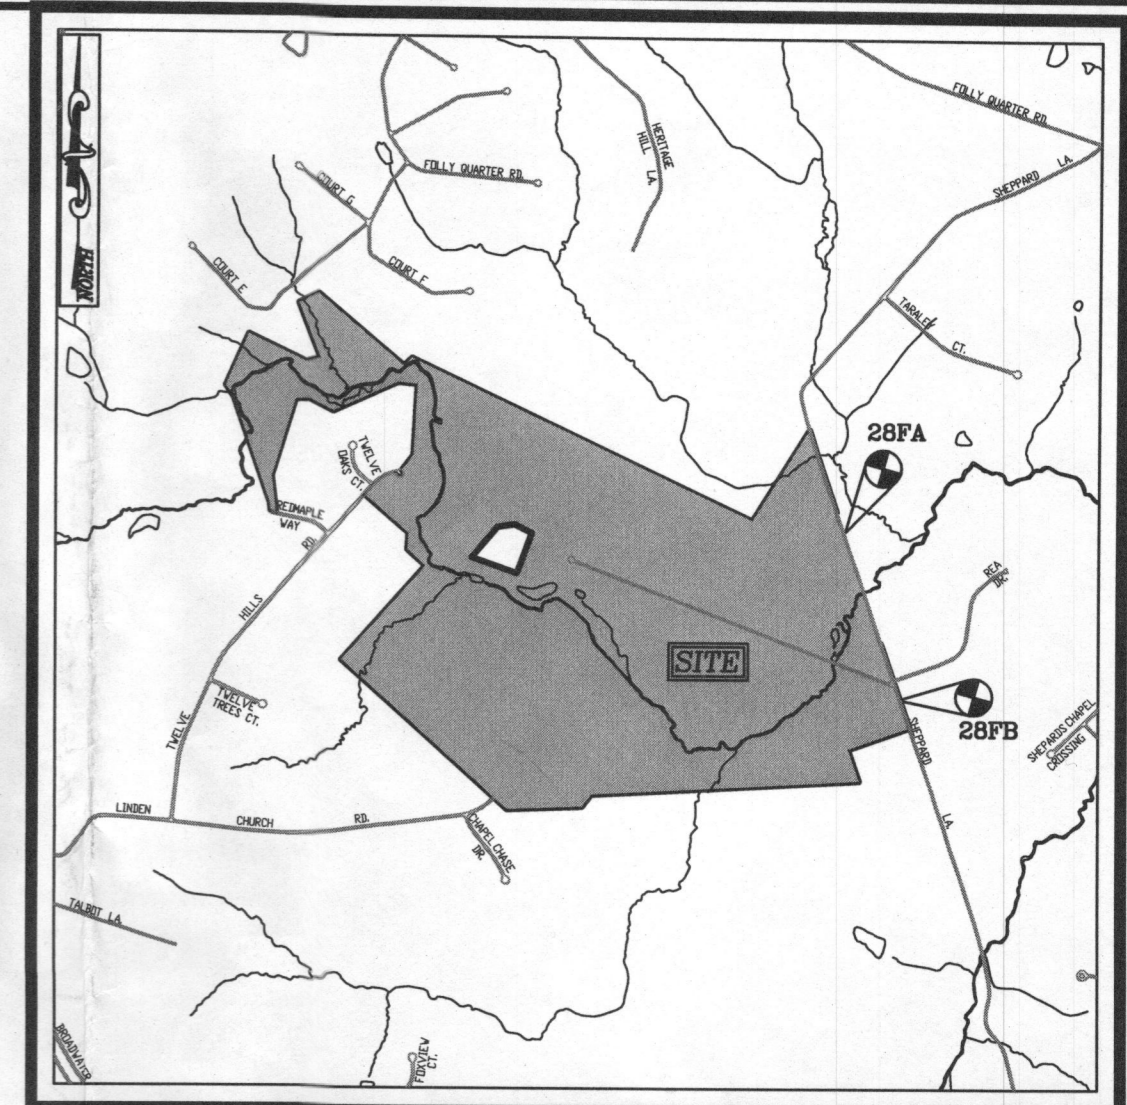

VICINITY MAP
SCALE: 1"=2000'
ADC MAP: 14, E2

GENERAL NOTES:

1. THE PROPERTY OUTLINE IS BASED ON A FIELD RUN SURVEY PERFORMED BY FISHER, COLLINS, & CARTER, INC., DATED AUGUST 2004
2. THE TOPOGRAPHY SHOWN HEREON IS BASED ON AERIAL TOPOGRAPHIC SURVEY PREPARED BY HARFORD AERIAL SURVEYS, INC. DATED FEBRUARY, 2004.
3. ALL EXISTING WELLS SHOWN HEREON HAVE BEEN FIELD LOCATED.
4. THE LOTS SHOWN HEREON COMPLY WITH THE MINIMUM OWNERSHIP WIDTH AND LOT AREA AS REQUIRED BY THE MARYLAND DEPARTMENT OF THE ENVIRONMENT.
5. ALL WELLS AND SEPTIC SYSTEMS WITHIN 100' FROM THE PROPERTY BOUNDARIES HAVE BEEN SHOWN.
6. ANY CHANGE TO A PRIVATE SEWERAGE EASEMENT SHALL REQUIRE REVISED PERCOLATION CERTIFICATION PLAN.

OWNER/DEVELOPER
TRINITY HOMES
3675 PARK AVENUE, SUITE 301
ELLCOTT CITY, MARYLAND 21043
(410) 480-0023

REVISED PERCOLATION CERTIFICATION PLAN
WALNUT CREEK - PHASE TWO
LOT 39

TAX MAP 28
BLOCK 11
5TH ELECTION DISTRICT
PARCEL 49
ZONED RC-DEO & RR-DEO
HOWARD COUNTY, MARYLAND

ROBERT H. VOGEL ENGINEERING, INC.
ENGINEERS • SURVEYORS • PLANNERS
8407 MAIN STREET
ELLCOTT CITY, MD 21043
TEL: 410.461.7666
FAX: 410.461.8961

SOILS LEGEND		
SYMBOL	NAME / DESCRIPTION	SOIL GROUP
BeA	BENEVOLO SILT LOAM, 0 TO 3 PERCENT SLOPES	B
BeB	BENEVOLO SILT LOAM, 3 TO 8 PERCENT SLOPES	B
BeC	BENEVOLO SILT LOAM, 8 TO 15 PERCENT SLOPES	B
Co	CODORUS AND HATBORO SILT LOAMS, 0 TO 3 PERCENT SLOPES	C
Ha	HATBORO-CODORUS SILT LOAMS, 0 TO 3 PERCENT SLOPES	D
MaC	MANOR LOAM, 8 TO 15 PERCENT SLOPES	B
WhA	WILTSHIRE SILT LOAM, 0 TO 3 PERCENT SLOPES	C
WhB	WILTSHIRE SILT LOAM, 3 TO 8 PERCENT SLOPES	C

NOTE: USDA WEB SOIL SURVEY

APPROVED: FOR PRIVATE WATER AND PRIVATE SEWAGE SYSTEM.

COUNTY HEALTH OFFICER
DATE

NOTE:
THE PURPOSE OF THIS REVISED PERCOLATION CERTIFICATION PLAN IS TO REVISE THE WELL ENVELOPE ON LOT 39.

PERCOLATION CERTIFICATION:
I CERTIFY THAT THE LOCATIONS SHOWN HEREON ARE BASED ON FIELD LOCATIONS DONE UNDER MY DIRECT SUPERVISION, AND ARE CORRECT, TO THE BEST OF MY PROFESSIONAL KNOWLEDGE AND BELIEF.

Thomas M. Hofeman, Jr.
THOMAS M. HOFEMAN, JR.
LAND SURVEYOR No. 267
2-3-15
DATE


DESIGN BY: RHV
DRAWN BY: JMR
CHECKED BY: RHV
DATE: FEBRUARY 2015
SCALE: 1"=50'
W.O. NO.: 13-21

1 SHEET OF 1

K:\Projects\13-21\ENGR\REVISED PERC PLANS\PHASE II\LOT 39.dwg, 2/2/2015 5:44:59 PM


**NON-BUILDABLE
PARCEL 'J'**

PROPERTY OF
STANDISH MELANIE DORSEY
8964/396
PARCEL 92
HOWARD COUNTY AGRICULTURAL
LAND PRESERVATION PROGRAM EASEMENT
(HC-91-12-E)
ZONED RC-DEO

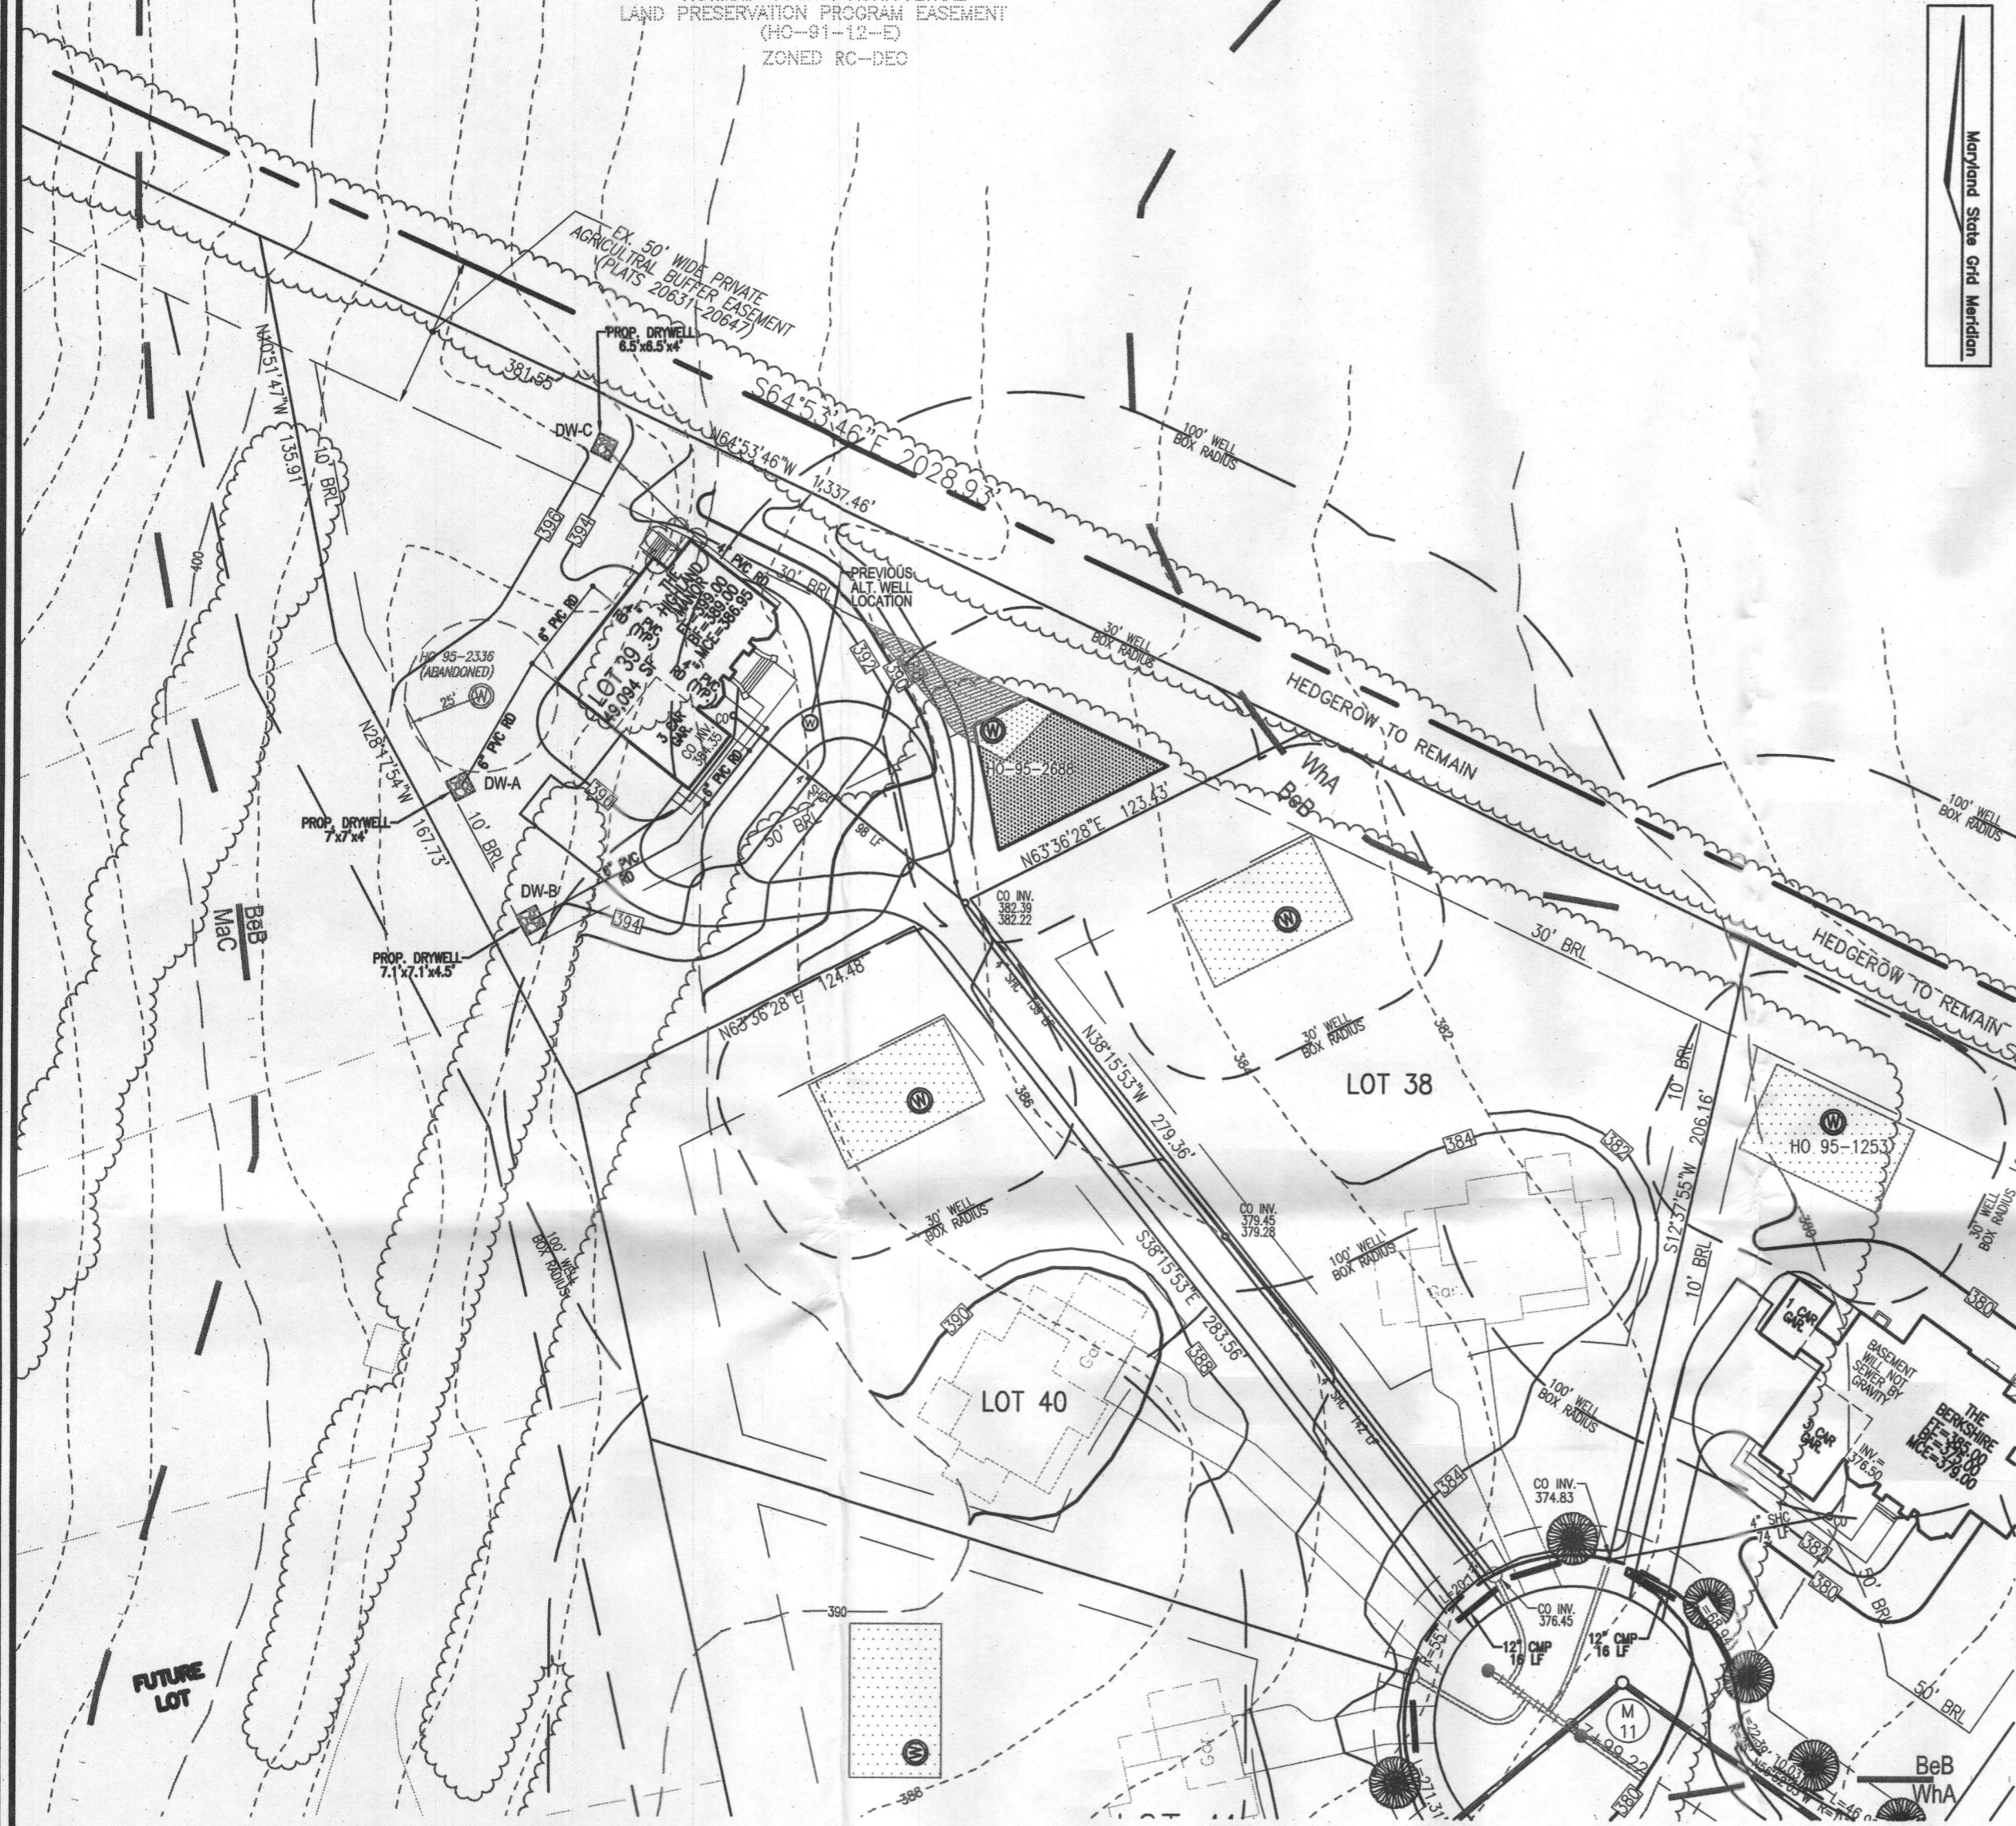

LEGEND

- EXISTING CONTOUR 382
- EXISTING TREES TO REMAIN 380
- SOIL BOUNDARY
- PROPERTY LINE
- PASSED PERC. TEST
- EXISTING WELL FIELD LOCATED
- PREVIOUS ALTERNATE WELL LOCATION TO BE ELIMINATED
- APPROVED WELL AREA
- APPROVED WELL AREA TO BE ABANDONED
- PROPOSED WELL AREA

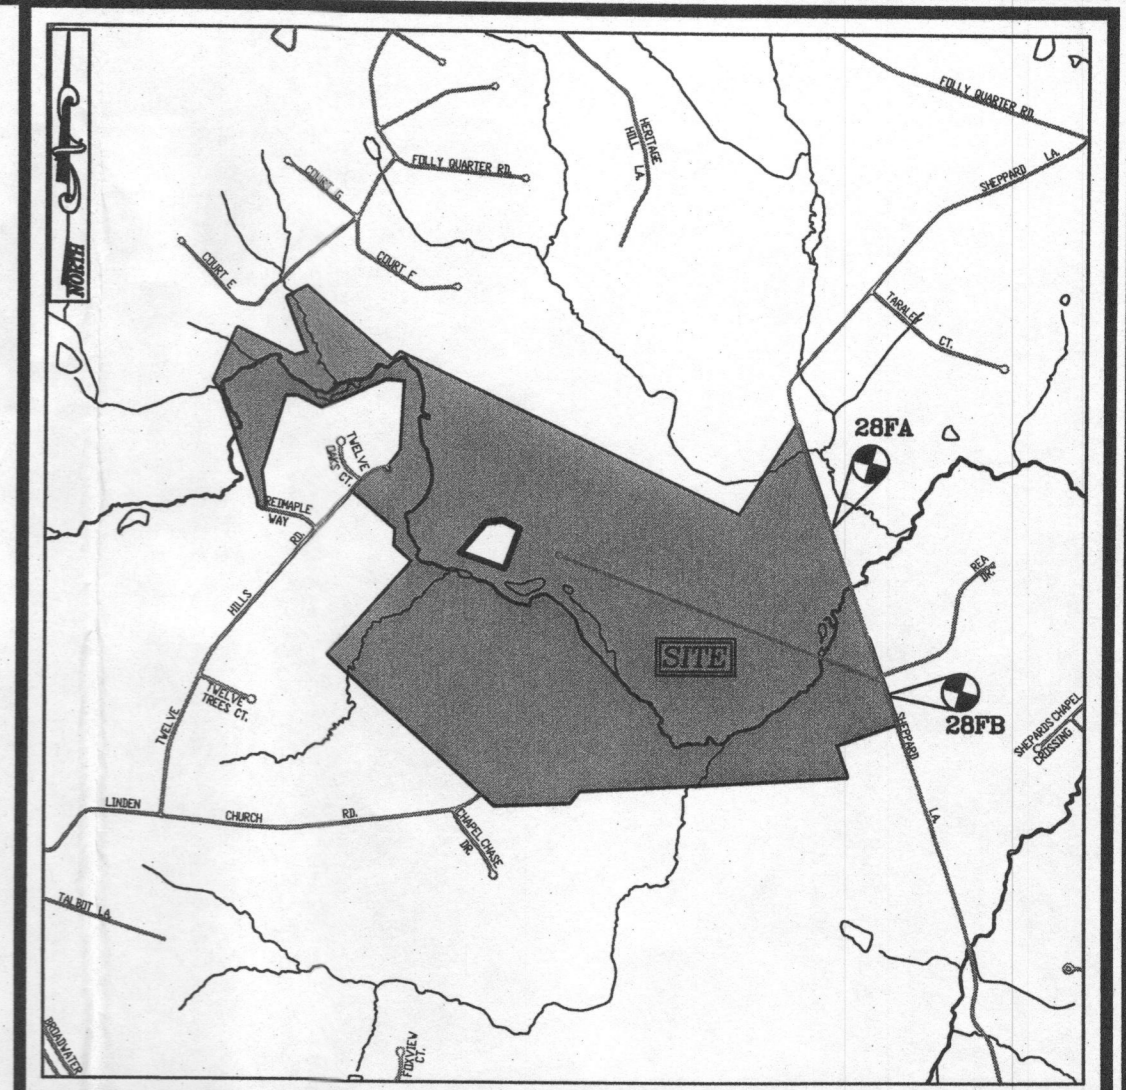

VICINITY MAP

SCALE: 1"=2000'
ADC MAP: 14, E2

GENERAL NOTES:

1. THE PROPERTY OUTLINE IS BASED ON A FIELD RUN SURVEY PERFORMED BY FISHER, COLLINS, & CARTER, INC., DATED AUGUST 2004
2. THE TOPOGRAPHY SHOWN HEREON IS BASED ON AERIAL TOPOGRAPHIC SURVEY PREPARED BY HARFORD AERIAL SURVEYS, INC. DATED FEBRUARY, 2004.
3. ALL EXISTING WELLS SHOWN HEREON HAVE BEEN FIELD LOCATED.
4. THE LOTS SHOWN HEREON COMPLY WITH THE MINIMUM OWNERSHIP WIDTH AND LOT AREA AS REQUIRED BY THE MARYLAND DEPARTMENT OF THE ENVIRONMENT.
5. ALL WELLS AND SEPTIC SYSTEMS WITHIN 100' FROM THE PROPERTY BOUNDARIES HAVE BEEN SHOWN.
6. ANY CHANGE TO A PRIVATE SEWERAGE EASEMENT SHALL REQUIRE A REVISED PERCOLATION CERTIFICATION PLAN.

OWNER/DEVELOPER

TRINITY HOMES
3675 PARK AVENUE, SUITE 301
ELLCOTT CITY, MARYLAND 21043
(410) 480-0023

REVISED PERCOLATION CERTIFICATION PLAN

**WALNUT CREEK - PHASE TWO
LOT 39**

TAX MAP 28
BLOCK 11
5TH ELECTION DISTRICT

PARCEL 49
ZONED RC-DEO & RR-DEO
HOWARD COUNTY, MARYLAND

**ROBERT H. VOGEL
ENGINEERING, INC.**
ENGINEERS • SURVEYORS • PLANNERS
8407 MAIN STREET
ELLCOTT CITY, MD 21043
TEL: 410.461.7666
FAX: 410.461.8961

SOILS LEGEND		
SYMBOL	NAME / DESCRIPTION	SOIL GROUP
BeA	BENEVOLA SILT LOAM, 0 TO 3 PERCENT SLOPES	B
BeB	BENEVOLA SILT LOAM, 3 TO 8 PERCENT SLOPES	B
BeC	BENEVOLA SILT LOAM, 8 TO 15 PERCENT SLOPES	B
Co	CODORUS AND HATBORO SILT LOAMS, 0 TO 3 PERCENT SLOPES	C
Ha	HATBORO-CODORUS SILT LOAMS, 0 TO 3 PERCENT SLOPES	D
MaC	MANOR LOAM, 8 TO 15 PERCENT SLOPES	B
WhA	WILTSHIRE SILT LOAM, 0 TO 3 PERCENT SLOPES	C
WhB	WILTSHIRE SILT LOAM, 3 TO 8 PERCENT SLOPES	C

NOTE: USDA WEB SOIL SURVEY

APPROVED: FOR PRIVATE WATER AND PRIVATE SEWAGE SYSTEM.

COUNTY HEALTH OFFICER

DATE

NOTE:
THE PURPOSE OF THIS REVISED PERCOLATION CERTIFICATION PLAN IS TO REVISE THE WELL ENVELOPE ON LOT 39.

PERCOLATION CERTIFICATION:
I CERTIFY THAT THE LOCATIONS SHOWN HEREON ARE BASED ON FIELD LOCATIONS DONE UNDER MY DIRECT SUPERVISION, AND ARE CORRECT, TO THE BEST OF MY PROFESSIONAL KNOWLEDGE AND BELIEF.

Thomas M. Hofeman, Jr.
THOMAS M. HOFEMAN, JR.
LAND SURVEYOR No. 267

2-3-15
DATE


DESIGN BY: RHV
DRAWN BY: JMR
CHECKED BY: RHV
DATE: FEBRUARY 2015
SCALE: 1"=50'
W.O. NO.: 13-21

1 SHEET OF 1

ROBERT H. VOGEL, PE No.16193

**NON-BUILDABLE
PARCEL 'J'**


PROPERTY OF
STANDISH MELANIE DORSEY
8864/386
PARCEL 92
HOWARD COUNTY AGRICULTURAL
LAND PRESERVATION PROGRAM EASEMENT
(HG-91-12-E)
ZONED RC-DEO

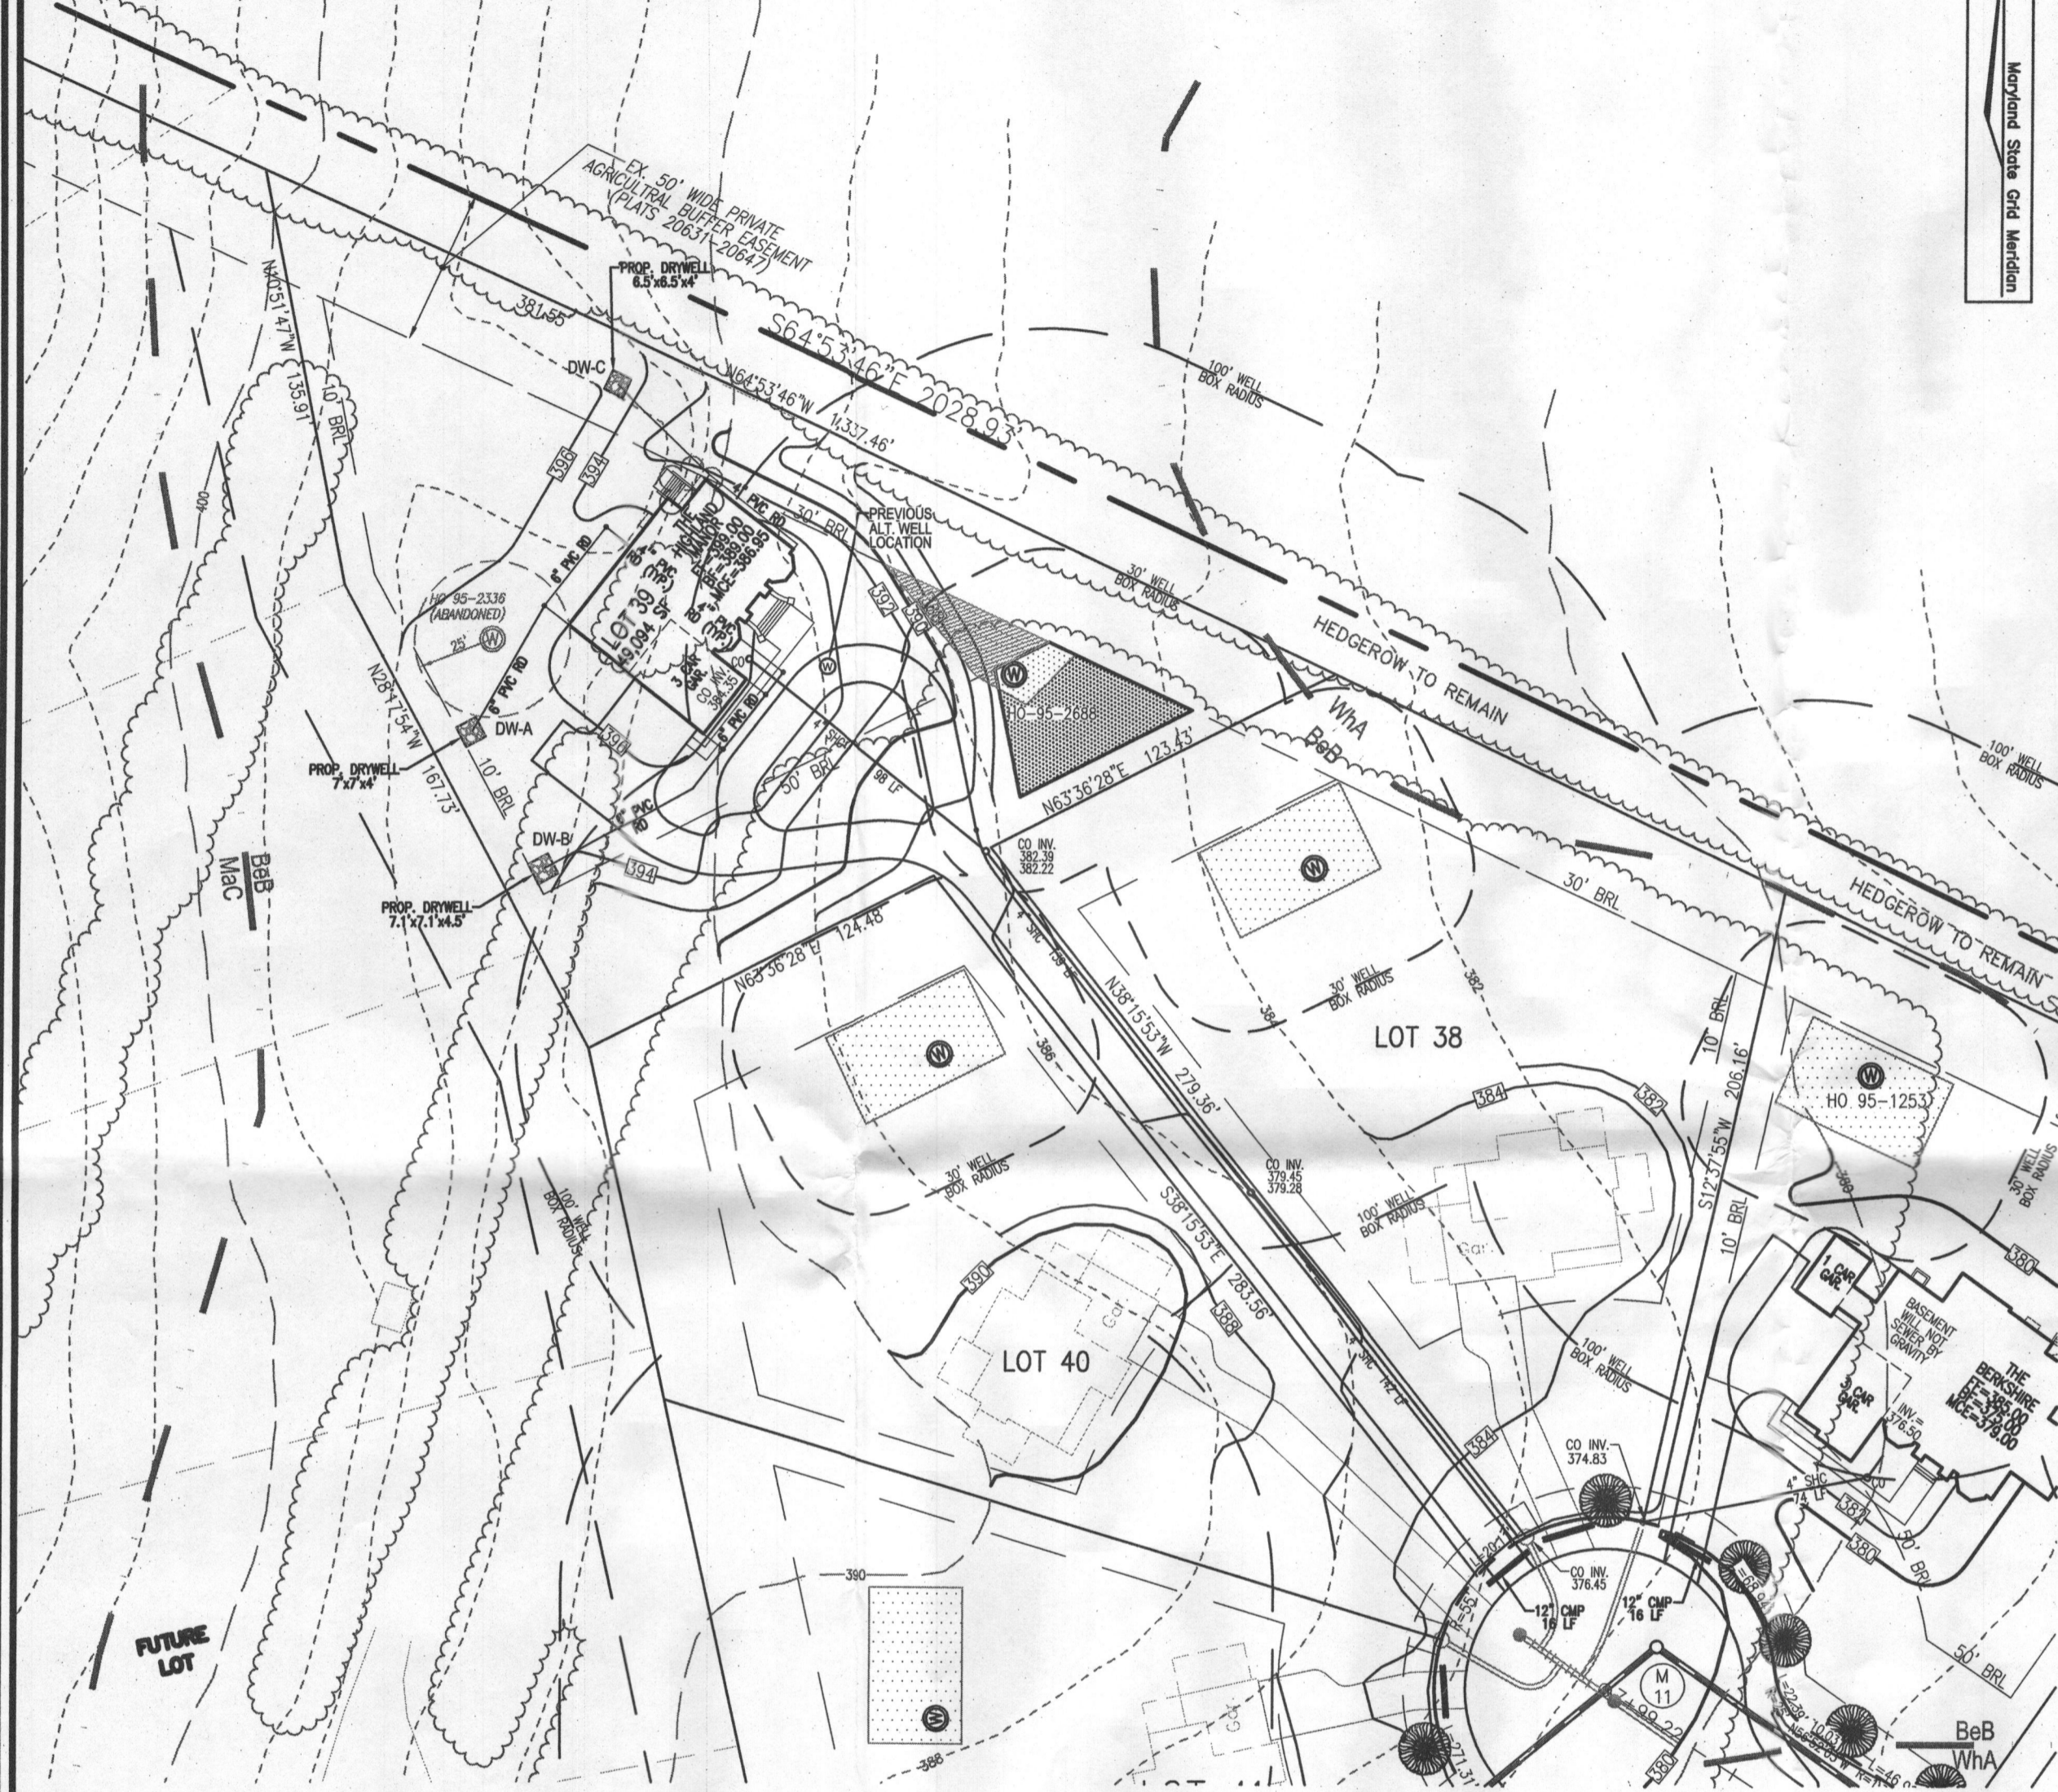

Maryland State Grid Meridian

LEGEND

- EXISTING CONTOUR 382
380
- EXISTING TREES TO REMAIN [Symbol]
- SOIL BOUNDARY [Symbol]
- PROPERTY LINE [Symbol]
- PASSED PERC. TEST [Symbol]
- EXISTING WELL FIELD LOCATED [Symbol]
- PREVIOUS ALTERNATE WELL LOCATION TO BE ELIMINATED [Symbol]
- APPROVED WELL AREA [Symbol]
- APPROVED WELL AREA TO BE ABANDONED [Symbol]
- PROPOSED WELL AREA [Symbol]

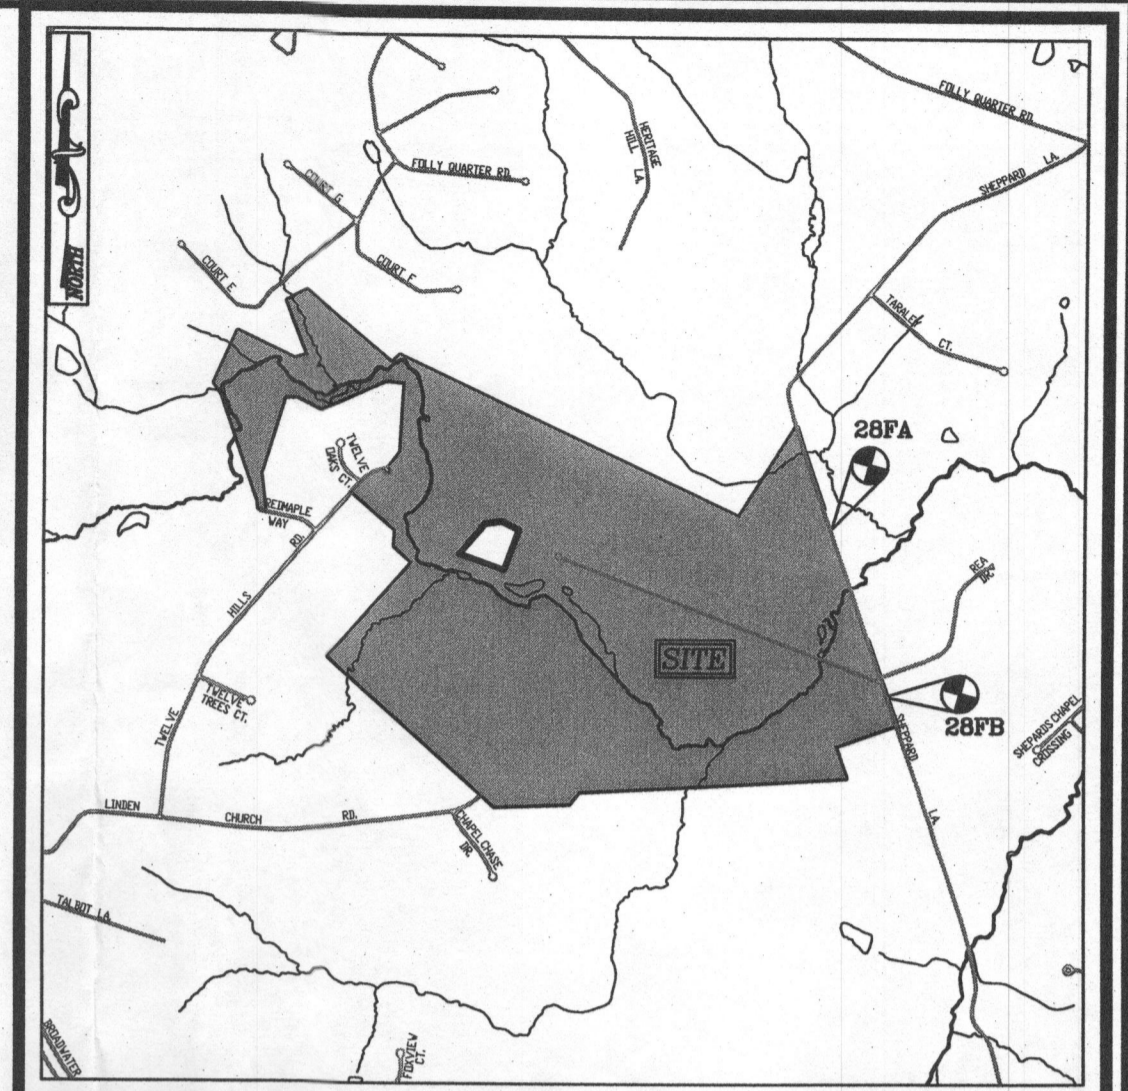

VICINITY MAP

SCALE: 1"=2000'
ADC MAP: 14, E2

GENERAL NOTES:

1. THE PROPERTY OUTLINE IS BASED ON A FIELD RUN SURVEY PERFORMED BY FISHER, COLLINS, & CARTER, INC., DATED AUGUST 2004
2. THE TOPOGRAPHY SHOWN HEREON IS BASED ON AERIAL TOPOGRAPHIC SURVEY PREPARED BY HARFORD AERIAL SURVEYS, INC. DATED FEBRUARY, 2004.
3. ALL EXISTING WELLS SHOWN HEREON HAVE BEEN FIELD LOCATED.
4. THE LOTS SHOWN HEREON COMPLY WITH THE MINIMUM OWNERSHIP WIDTH AND LOT AREA AS REQUIRED BY THE MARYLAND DEPARTMENT OF THE ENVIRONMENT.
5. ALL WELLS AND SEPTIC SYSTEMS WITHIN 100' FROM THE PROPERTY BOUNDARIES HAVE BEEN SHOWN.
6. ANY CHANGE TO A PRIVATE SEWERAGE EASEMENT SHALL REQUIRE A REVISED PERCOLATION CERTIFICATION PLAN.

OWNER/DEVELOPER

TRINITY HOMES
3675 PARK AVENUE, SUITE 301
ELLCOTT CITY, MARYLAND 21043
(410) 480-0023

REVISED PERCOLATION CERTIFICATION PLAN

**WALNUT CREEK - PHASE TWO
LOT 39**

TAX MAP 28
BLOCK 11
5TH ELECTION DISTRICT

PARCEL 49
ZONED RC-DEO & RR-DEO
HOWARD COUNTY, MARYLAND

**ROBERT H. VOGEL
ENGINEERING, INC.**
ENGINEERS • SURVEYORS • PLANNERS
8407 MAIN STREET TEL: 410.461.7666
ELLCOTT CITY, MD 21043 FAX: 410.461.8961

SYMBOL	NAME / DESCRIPTION	SOIL GROUP
BeA	BENEVOLO SILT LOAM, 0 TO 3 PERCENT SLOPES	B
BeB	BENEVOLO SILT LOAM, 3 TO 8 PERCENT SLOPES	B
BeC	BENEVOLO SILT LOAM, 8 TO 15 PERCENT SLOPES	B
Co	CODORUS AND HATBORO SILT LOAMS, 0 TO 3 PERCENT SLOPES	C
Ha	HATBORO-CODORUS SILT LOAMS, 0 TO 3 PERCENT SLOPES	D
MaC	MANOR LOAM, 8 TO 15 PERCENT SLOPES	B
WhA	WILTSHIRE SILT LOAM, 0 TO 3 PERCENT SLOPES	C
WhB	WILTSHIRE SILT LOAM, 3 TO 8 PERCENT SLOPES	C

NOTE: USDA WEB SOIL SURVEY

APPROVED: FOR PRIVATE WATER AND PRIVATE SEWAGE SYSTEM.

NOTE:
THE PURPOSE OF THIS REVISED PERCOLATION CERTIFICATION PLAN IS TO REVISE THE WELL ENVELOPE ON LOT 39.

PERCOLATION CERTIFICATION:

I CERTIFY THAT THE LOCATIONS SHOWN HEREON ARE BASED ON FIELD LOCATIONS DONE UNDER MY DIRECT SUPERVISION, AND ARE CORRECT, TO THE BEST OF MY PROFESSIONAL KNOWLEDGE AND BELIEF.


Thomas M. Hofeman, Jr.
THOMAS M. HOFEMAN, JR.
LAND SURVEYOR No. 267
DATE: 2-3-15

COUNTY HEALTH OFFICER _____ DATE _____

DESIGN BY: _____ RHV
DRAWN BY: _____ JMR
CHECKED BY: _____ RHV
DATE: FEBRUARY 2015
SCALE: 1"=50'
W.O. NO.: 13-21


**NON-BUILDABLE
PARCEL 'J'**

PROPERTY OF
STANDISH MELANIE DORSEY
8964/396
PARCEL 92
HOWARD COUNTY AGRICULTURAL
LAND PRESERVATION PROGRAM EASEMENT
(HC-91-12-E)
ZONED RC-DEO

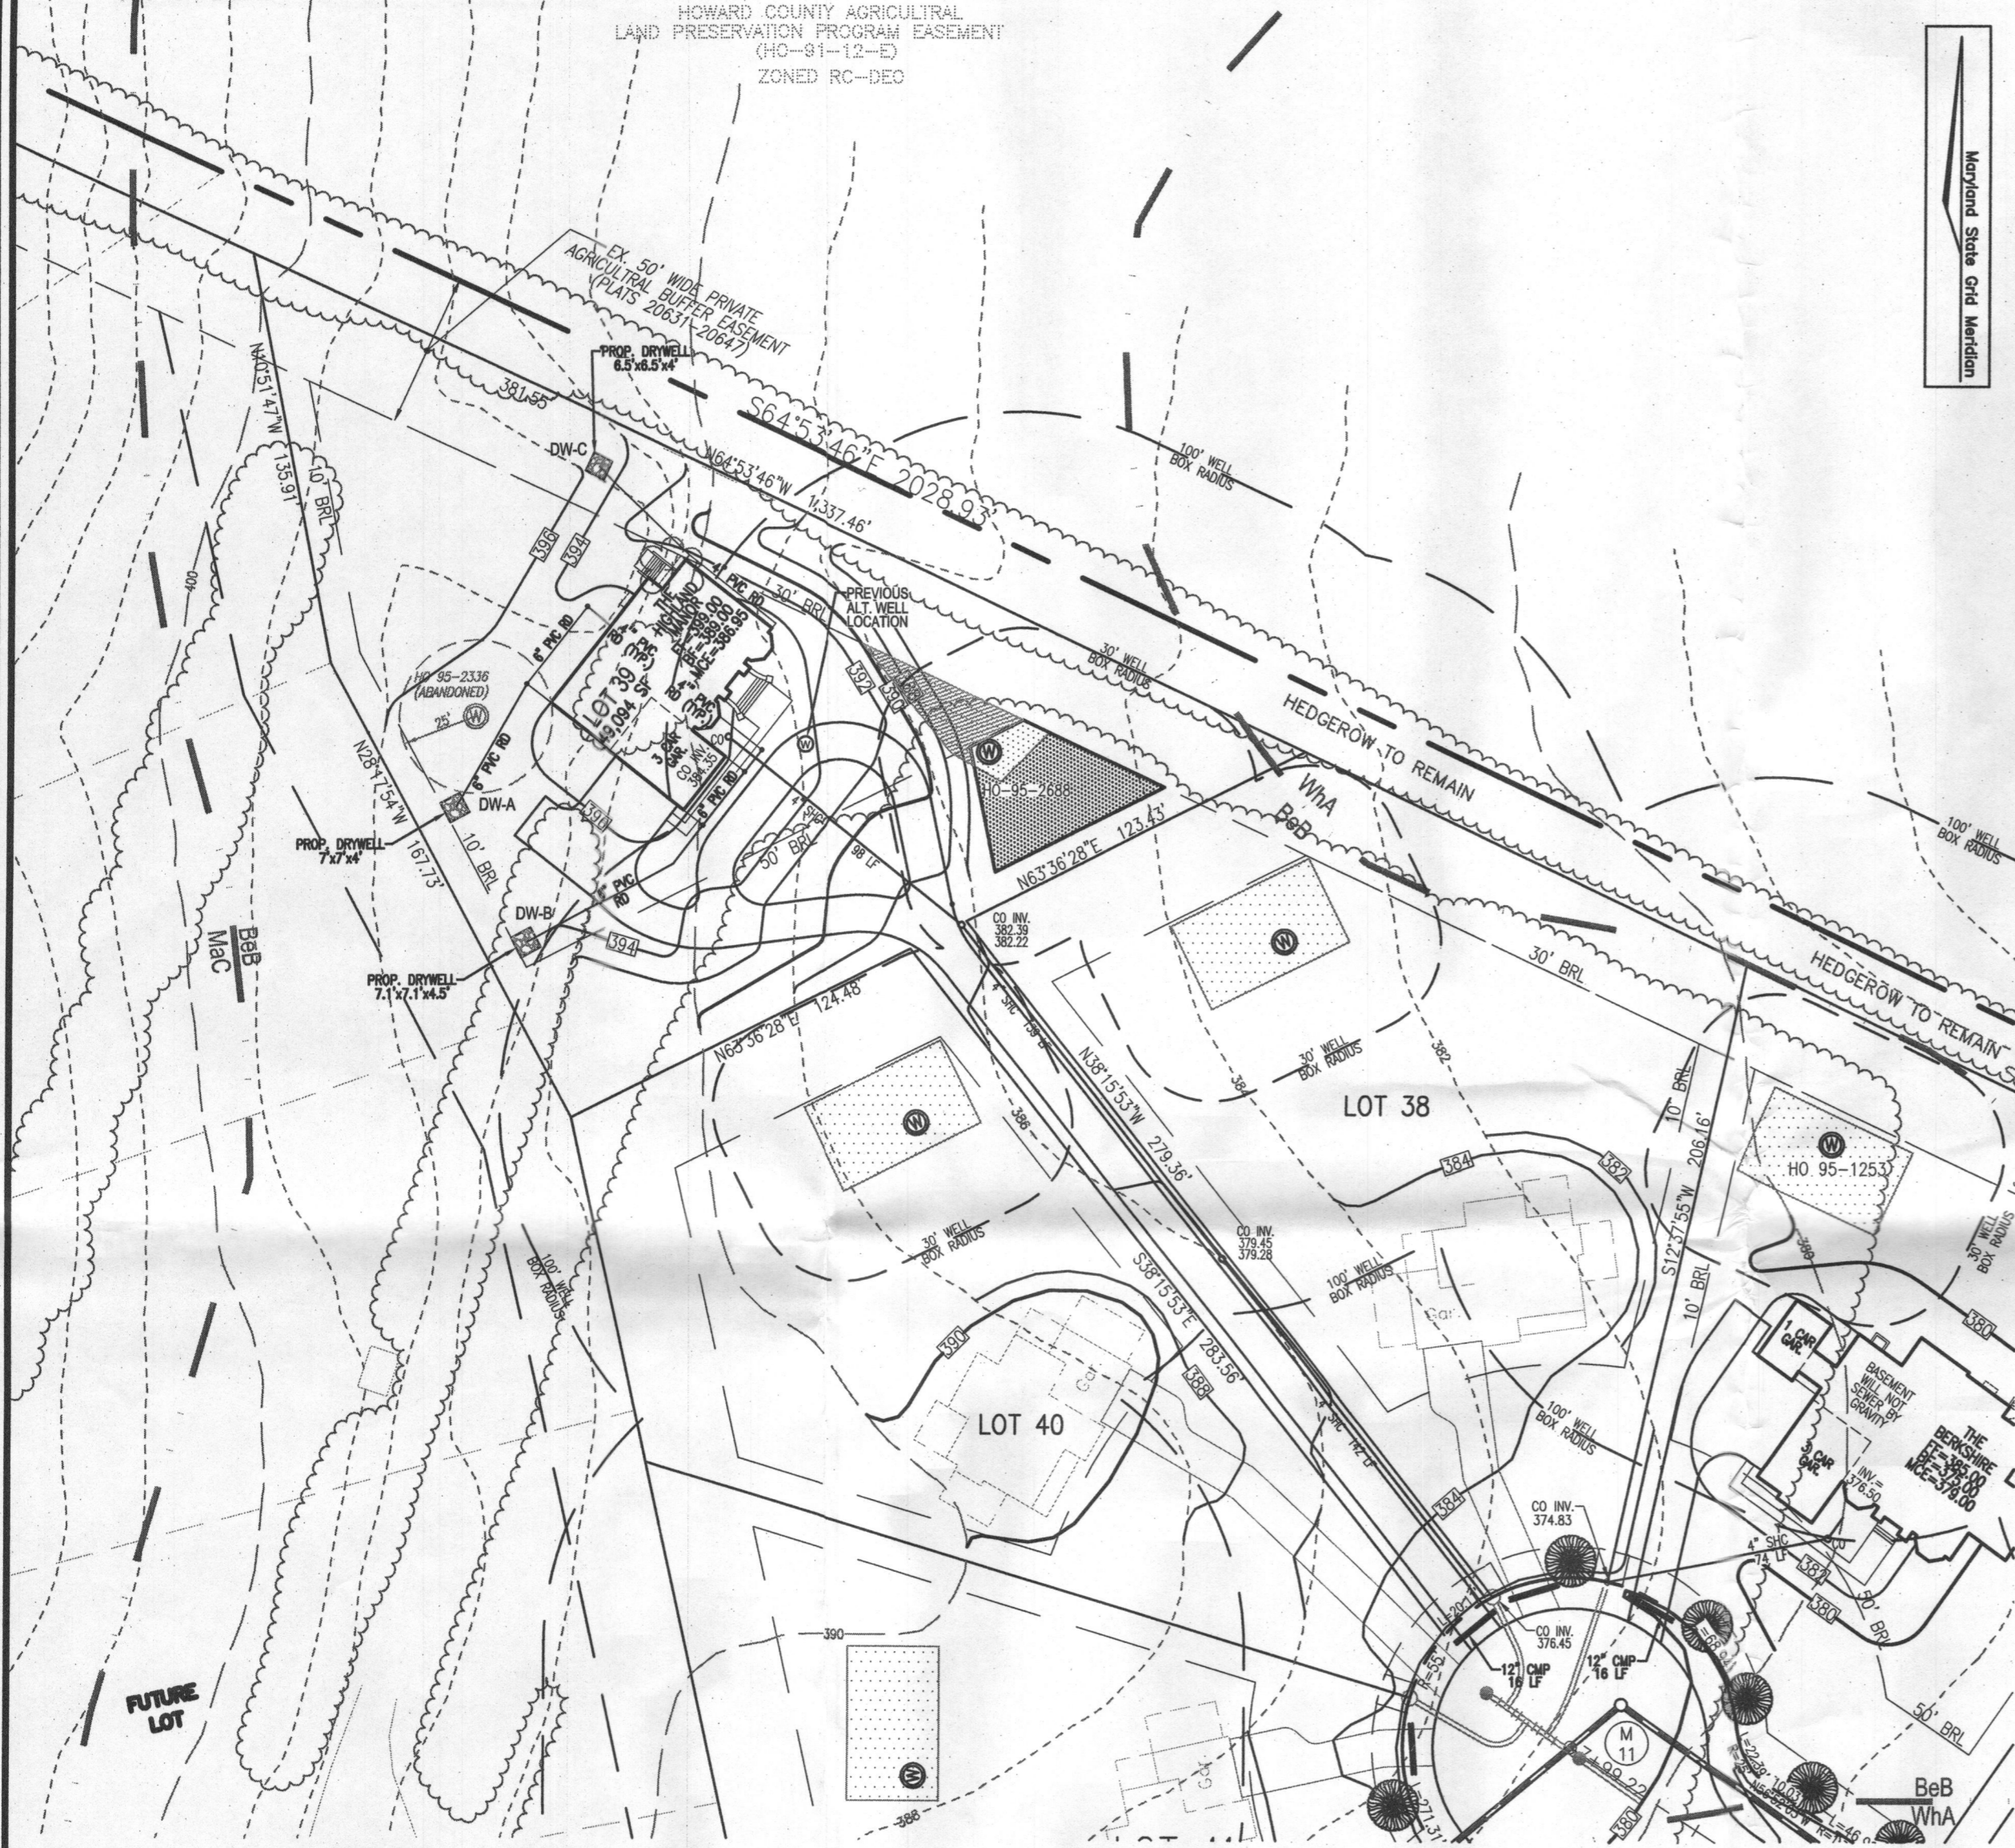

LEGEND

- EXISTING CONTOUR 382
- EXISTING TREES TO REMAIN 380
- SOIL BOUNDARY
- PROPERTY LINE
- PASSED PERC. TEST +
- EXISTING WELL FIELD LOCATED W
- PREVIOUS ALTERNATE WELL LOCATION TO BE ELIMINATED W PREVIOUS ALT. WELL LOCATION
- APPROVED WELL AREA
- APPROVED WELL AREA TO BE ABANDONED
- PROPOSED WELL AREA

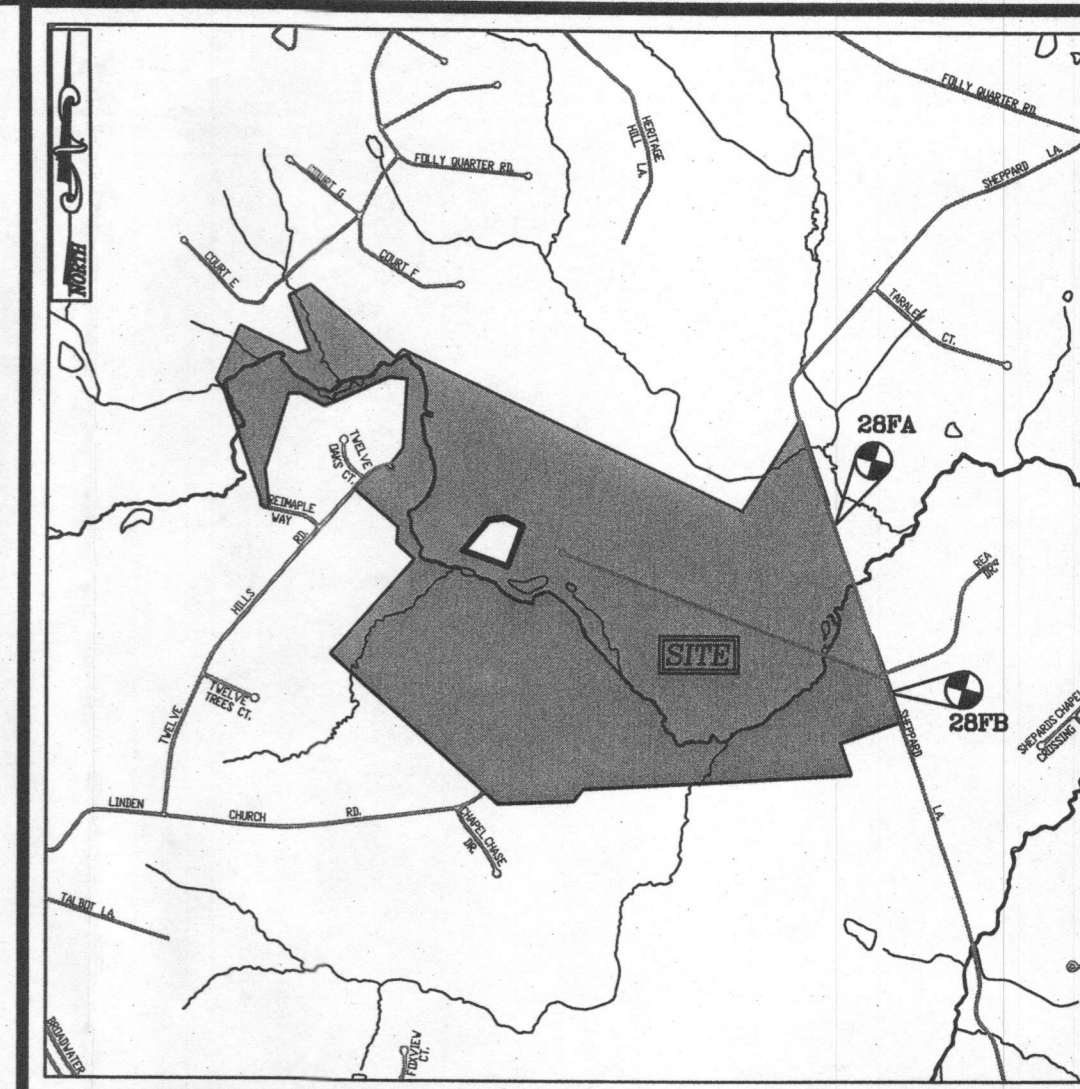

VICINITY MAP

SCALE: 1"=2000'
ADC MAP: 14, E2

GENERAL NOTES:

1. THE PROPERTY OUTLINE IS BASED ON A FIELD RUN SURVEY PERFORMED BY FISHER, COLLINS, & CARTER, INC., DATED AUGUST 2004
2. THE TOPOGRAPHY SHOWN HEREON IS BASED ON AERIAL TOPOGRAPHIC SURVEY PREPARED BY HARFORD AERIAL SURVEYS, INC. DATED FEBRUARY, 2004.
3. ALL EXISTING WELLS SHOWN HEREON HAVE BEEN FIELD LOCATED.
4. THE LOTS SHOWN HEREON COMPLY WITH THE MINIMUM OWNERSHIP WIDTH AND LOT AREA AS REQUIRED BY THE MARYLAND DEPARTMENT OF THE ENVIRONMENT.
5. ALL WELLS AND SEPTIC SYSTEMS WITHIN 100' FROM THE PROPERTY BOUNDARIES HAVE BEEN SHOWN.
6. ANY CHANGE TO A PRIVATE SEWERAGE EASEMENT SHALL REQUIRE A REVISED PERCOLATION CERTIFICATION PLAN.

OWNER/DEVELOPER

TRINITY HOMES
3675 PARK AVENUE, SUITE 301
ELLCOTT CITY, MARYLAND 21043
(410) 480-0023

REVISED PERCOLATION CERTIFICATION PLAN

**WALNUT CREEK - PHASE TWO
LOT 39**

TAX MAP 28
BLOCK 11
5TH ELECTION DISTRICT

PARCEL 49
ZONED RC-DEO & RR-DEO
HOWARD COUNTY, MARYLAND

**ROBERT H. VOGEL
ENGINEERING, INC.**
ENGINEERS • SURVEYORS • PLANNERS
8407 MAIN STREET TEL: 410.461.7666
ELLCOTT CITY, MD 21043 FAX: 410.461.8961

SOILS LEGEND		
SYMBOL	NAME / DESCRIPTION	SOIL GROUP
BeA	BENEVOLO SILT LOAM, 0 TO 3 PERCENT SLOPES	B
BeB	BENEVOLO SILT LOAM, 3 TO 8 PERCENT SLOPES	B
BeC	BENEVOLO SILT LOAM, 8 TO 15 PERCENT SLOPES	B
Co	CODORUS AND HATBORO SILT LOAMS, 0 TO 3 PERCENT SLOPES	C
Ha	HATBORO-CODORUS SILT LOAMS, 0 TO 3 PERCENT SLOPES	D
MaC	MANOR LOAM, 8 TO 15 PERCENT SLOPES	B
WhA	WILTSHIRE SILT LOAM, 0 TO 3 PERCENT SLOPES	C
WhB	WILTSHIRE SILT LOAM, 3 TO 8 PERCENT SLOPES	C

NOTE: USDA WEB SOIL SURVEY

NOTE:
THE PURPOSE OF THIS REVISED PERCOLATION CERTIFICATION PLAN IS TO REVISE THE WELL ENVELOPE ON LOT 39.

PERCOLATION CERTIFICATION:
I CERTIFY THAT THE LOCATIONS SHOWN HEREON ARE BASED ON FIELD LOCATIONS DONE UNDER MY DIRECT SUPERVISION, AND ARE CORRECT, TO THE BEST OF MY PROFESSIONAL KNOWLEDGE AND BELIEF.

Thomas M. Hofeman, Jr.
THOMAS M. HOFEMAN, JR.
LAND SURVEYOR No. 267
2-3-15
DATE




APPROVED: FOR PRIVATE WATER AND PRIVATE SEWAGE SYSTEM.

COUNTY HEALTH OFFICER DATE

DESIGN BY: RHV
DRAWN BY: JMR
CHECKED BY: RHV
DATE: FEBRUARY 2015
SCALE: 1"=50'
W.O. NO.: 13-21

**NON-BUILDABLE
PARCEL 'J'**

PROPERTY OF
STANDISH MELANIE DORSEY
8864/396
PARCEL 92
HOWARD COUNTY AGRICULTURAL
LAND PRESERVATION PROGRAM EASEMENT
(HC-91-12-E)
ZONED RC-DEO

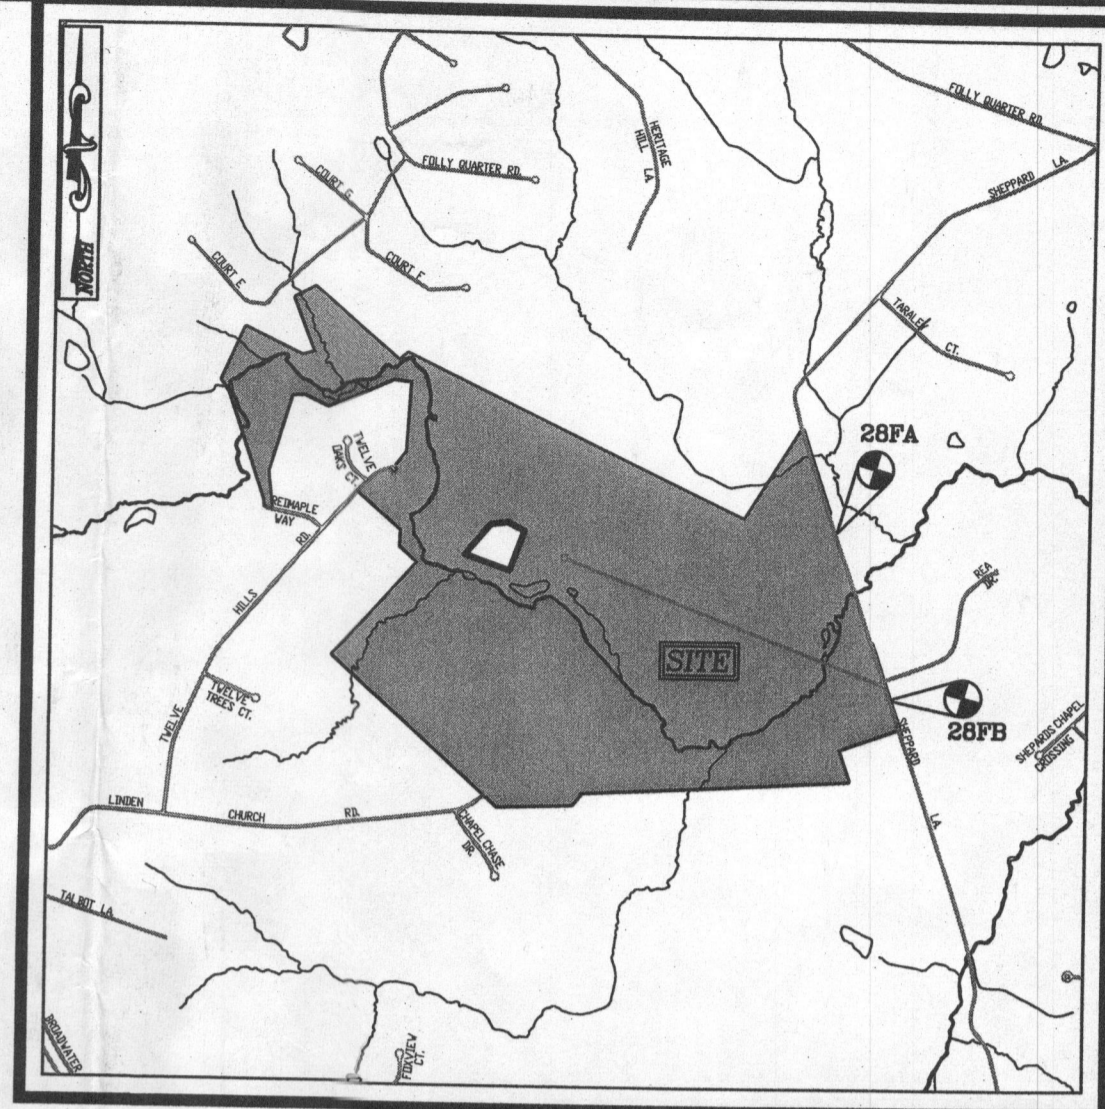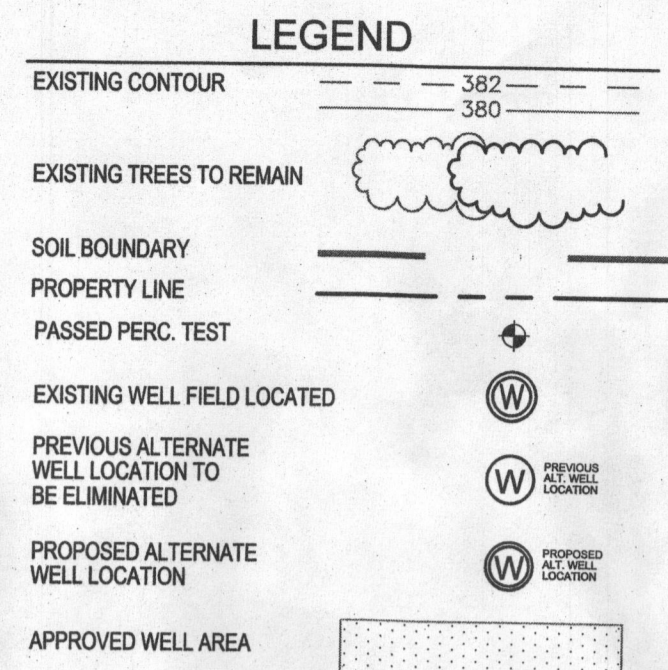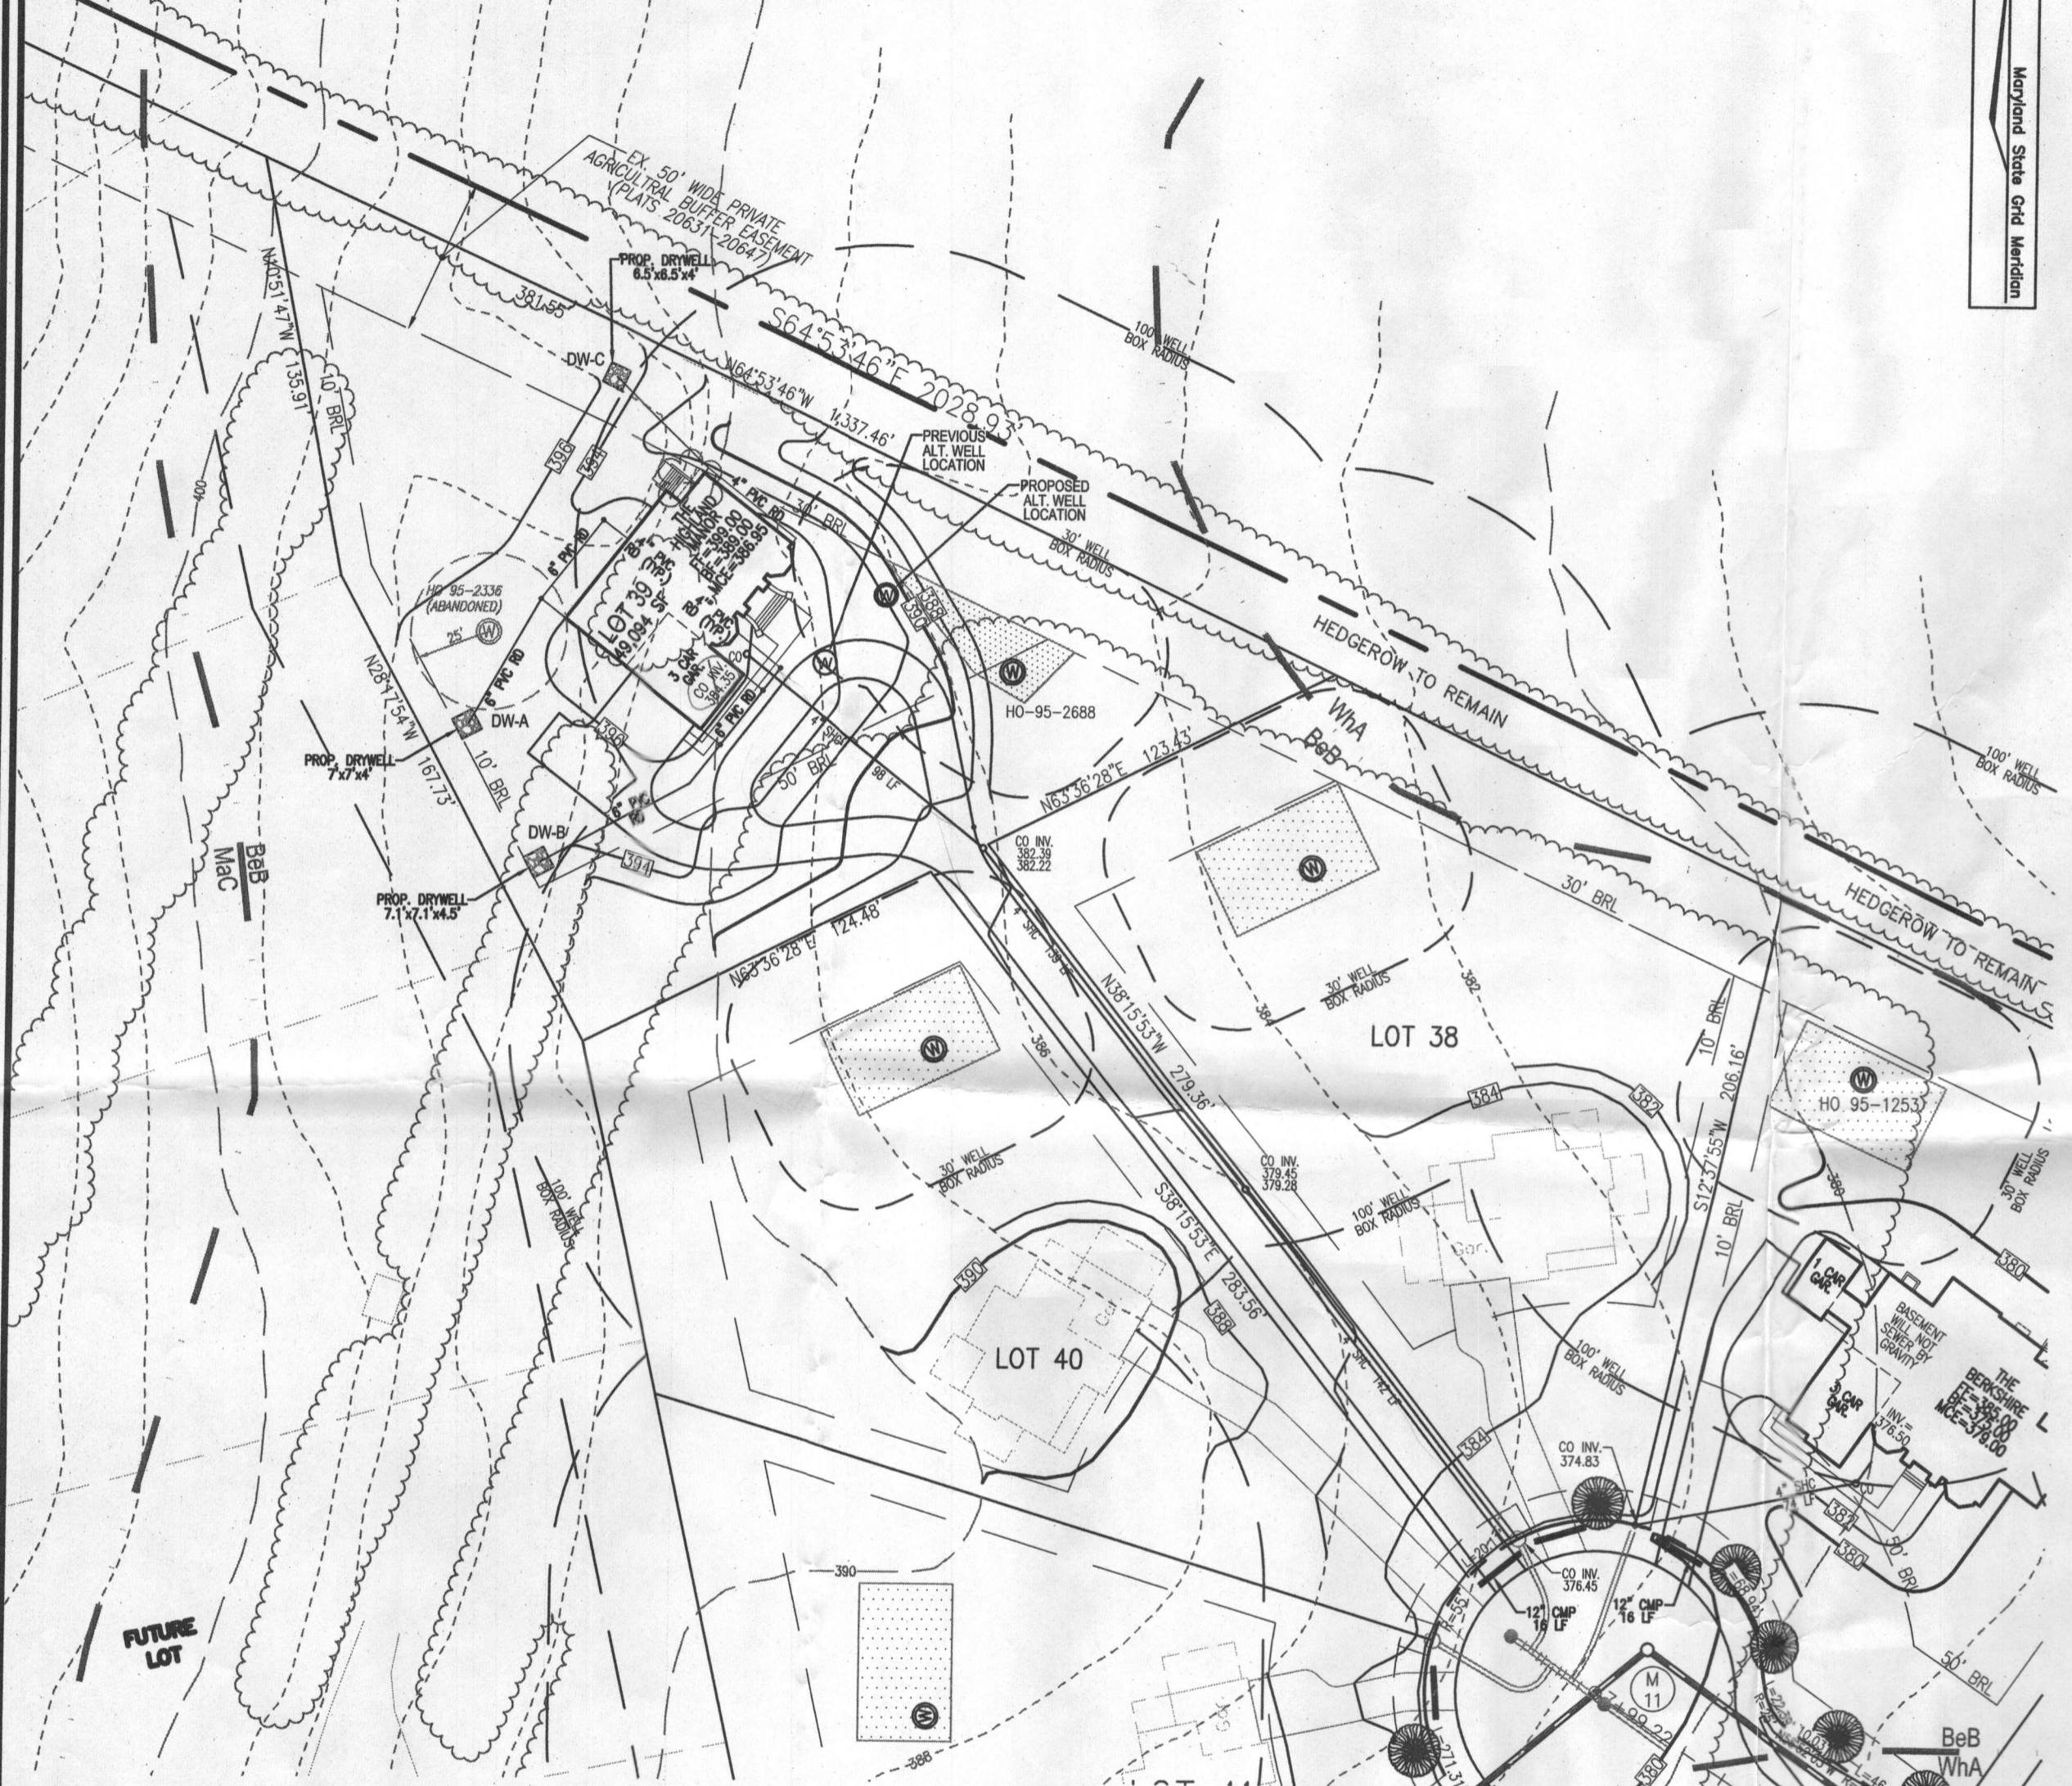

VICINITY MAP
SCALE: 1"=2000'
ADC MAP: 14, E2

- GENERAL NOTES:**
1. THE PROPERTY OUTLINE IS BASED ON A FIELD RUN SURVEY PERFORMED BY FISHER, COLLINS, & CARTER, INC., DATED AUGUST 2004
 2. THE TOPOGRAPHY SHOWN HEREON IS BASED ON AERIAL TOPOGRAPHIC SURVEY PREPARED BY HARFORD AERIAL SURVEYS, INC. DATED FEBRUARY, 2004.
 3. ALL EXISTING WELLS SHOWN HEREON HAVE BEEN FIELD LOCATED.
 4. THE LOTS SHOWN HEREON COMPLY WITH THE MINIMUM OWNERSHIP WIDTH AND LOT AREA AS REQUIRED BY THE MARYLAND DEPARTMENT OF THE ENVIRONMENT.
 5. ALL WELLS AND SEPTIC SYSTEMS WITHIN 100' FROM THE PROPERTY BOUNDARIES HAVE BEEN SHOWN.
 6. ANY CHANGE TO A PRIVATE SEWERAGE EASEMENT SHALL REQUIRE A REVISED PERCOLATION CERTIFICATION PLAN.

OWNER/DEVELOPER
TRINITY HOMES
3675 PARK AVENUE, SUITE 301
ELLCOTT CITY, MARYLAND 21043
(410) 480-0023

REVISED PERCOLATION CERTIFICATION PLAN
WALNUT CREEK - PHASE TWO
LOT 39

TAX MAP 28
BLOCK 11
5TH ELECTION DISTRICT

PARCEL 49
ZONED RC-DEO & RR-DEO
HOWARD COUNTY, MARYLAND

ROBERT H. VOGEL ENGINEERING, INC.
ENGINEERS • SURVEYORS • PLANNERS
8407 MAIN STREET
ELLCOTT CITY, MD 21043
TEL: 410.461.7666
FAX: 410.461.8961

SOILS LEGEND

SYMBOL	NAME / DESCRIPTION	SOIL GROUP
BeA	BENEVOLA SILT LOAM, 0 TO 3 PERCENT SLOPES	B
BeB	BENEVOLA SILT LOAM, 3 TO 8 PERCENT SLOPES	B
BeC	BENEVOLA SILT LOAM, 8 TO 15 PERCENT SLOPES	B
Co	CODORUS AND HATBORO SILT LOAMS, 0 TO 3 PERCENT SLOPES	C
Ha	HATBORO-CODORUS SILT LOAMS, 0 TO 3 PERCENT SLOPES	D
MaC	MANOR LOAM, 8 TO 15 PERCENT SLOPES	C
WhA	WILTSHIRE SILT LOAM, 0 TO 3 PERCENT SLOPES	B
WhB	WILTSHIRE SILT LOAM, 3 TO 8 PERCENT SLOPES	C

NOTE: USDA WEB SOIL SURVEY

NOTE:
THE PURPOSE OF THIS REVISED PERCOLATION CERTIFICATION PLAN IS TO RELOCATE THE PROPOSED ALTERNATE WELL ON LOT 39.

PERCOLATION CERTIFICATION:
I CERTIFY THAT THE LOCATIONS SHOWN HEREON ARE BASED ON FIELD LOCATIONS DONE UNDER MY DIRECT SUPERVISION, AND ARE CORRECT, TO THE BEST OF MY PROFESSIONAL KNOWLEDGE AND BELIEF.

Thomas M. Hoffman, Jr.
THOMAS M. HOFFMAN, JR.
LAND SURVEYOR No. 267

2-5-15
DATE

APPROVED: FOR PRIVATE WATER AND PRIVATE SEWAGE SYSTEM.

W. R. W. for Maria Rodman
COUNTY HEALTH OFFICER

2/5/2015
DATE

DESIGN BY: RHV
DRAWN BY: JMR
CHECKED BY: RHV
DATE: FEBRUARY 2015
SCALE: 1"=50'
W.O. NO.: 13-21

1 SHEET OF 1

ROBERT H. VOGEL, PE No.16193

K:\Project\113-21\ENGR\REVISED PERC PLANS\PHASE II\LOT 39.dwg, 2/5/2015 10:28:45 AM