

*4-17-73 Labeled
100 ft. apart
radius 100 ft.*
Preliminary
2/8/73 A.M.
9:30

APPLICATION

A 17910
P _____
DISTRICT 4
DATE 1/31/73

SEWAGE DISPOSAL TESTING

STATE OF MARYLAND - DEPARTMENT OF HEALTH AND MENTAL HYGIENE
HOWARD COUNTY HEALTH DEPARTMENT
ENVIRONMENTAL HEALTH SERVICES
P. O. BOX 476, ELLICOTT CITY, MARYLAND 21043
TELEPHONE: 465-5000, EXT. 356

Septic Tank - 1000 gal
*5/4/73 Dry Well - dig pit 15 ft by 12' diameter
100 ft in rest of pit with 9" dia. dry well to base of effluent
depth below the first 4 1/2 ft of org. grade. Max. depth
permitted for dry well is 12 ft below org. grade.*
*Place Dry Well - 11' off from rear lot line and 45'
from right sideline as shown facing lot from the front*

TO: THE COUNTY HEALTH OFFICER
ELLICOTT CITY, MARYLAND

I, HEREBY, APPLY FOR THE NECESSARY TEST IN ORDER TO CONSTRUCT (OR RECONSTRUCT) A SEWAGE DISPOSAL SYSTEM.

PROPERTY OWNER William Frances Mitchell
ADDRESS 2202 Duvall Road, Woodbine, Maryland PHONE 286-2493-489-

PROPERTY LOCATION:

SUBDIVISION _____ LOT NO. _____
ROAD AND DESCRIPTION beside 2202 Duvall Road - big yellow house off A. E. Mullinix Rd.
2nd one in on right.

SIZE OF LOT 1.000 acre TYPE BLDG. 3
NUMBER OF BEDROOMS (Single Fmly. dwllg.)
IF NOT SINGLE RESIDENCE DESCRIBE _____

THE SYSTEM INSTALLED UNDER THIS APPLICATION IS ACCEPTABLE ONLY UNTIL PUBLIC FACILITIES BECOME AVAILABLE.

SIGNATURE OF APPLICANT William Francis Mitchell

APPROVED BY Dr. Managha FOR Dry Well DATE 5-10-73
(KIND OF SYSTEM)

REJECTED BY _____ FOR _____ DATE _____
(KIND OF SYSTEM)


HOLD PENDING FURTHER TESTS _____ DATE _____

REASONS FOR REJECTION OR HOLDING 2/8/73 Hold for supervisor certification of rolls + plot

THIS IS NOT A PERMIT

TEST

APPLICATION

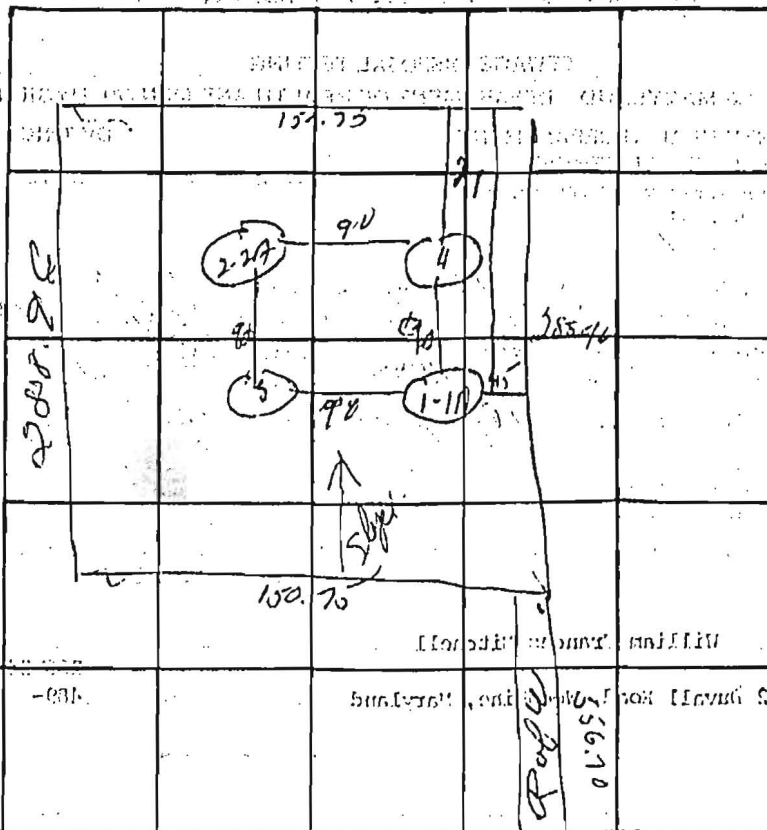

INDICATE NORTH - NAME ADJOINING ROADWAY AS BASE LINE.

INDICATE NORTH - NAME ADJOINING ROADWAY AS BASE LINE.

DATE	TEST NO.	DEPTH	PRE-WET		TEST - 1" DROP		TIME
			START	STOP	START	STOP	
5/10/70	1	12'	1 33	1 52	1 52	2 18	25 min
(.p.11.1)	1A	4'	1 53	1 36	1 36	1 46	10 min
	2	4'	1 40	1 42	1 42	1 49	7 min
	2A	15'	1 39	1 51	1 51	2 11	28 min

REMARKS 1-1A

TYPE OF SOIL _____

TESTED BY _____ ALSO PRESENT: _____