

FILE *2/1/74 Hold for inspection*
P. 19388
17910
A
10/16/74 C.B.S.
2/4/74 Hold for call per F.F. + C.B.S.
19388

PERMIT

SEWAGE DISPOSAL SYSTEM

MARYLAND STATE DEPARTMENT OF HEALTH

HOWARD COUNTY

ELLICOTT CITY C.B.S. C.B.S.

DISTRICT 4th

DATE 12/28/73 *2/11/74*

INDEXED

Howard Pickett

IS PERMITTED TO INSTALL ALTER

ADDRESS Watersville Road, Mt. Airy, Md.

PHONE 829-0543 *10/2/74*

A SEWAGE DISPOSAL SYSTEM LOCATED AT

SUBDIVISION 2202 Duvall Road ROAD see application for directions LOT

PROPERTY OWNER William Frances Mitchell

ADDRESS 2202 Duvall Rd., Woodbine, Md.

SPECIFICATIONS 3 - Bedrooms

DRAIN FIELD DEPTH FEET, BOTTOM AREA SQ. FT.

SEEPAGE PITS ABSORBENT SIDE-WALL AREA SQ. FT.

SEPTIC TANK CAPACITY 1000 GALLONS

FOR GARBAGE GRINDER, INCREASE DISPOSAL AREA 22% & TANK CAPACITY 50%.

OTHER Dry Well -- dig pit 15 ft. sq. set block and top for 12' diameter and fill in rest of pit with gravel. Dry Well to have 8 ft. effective depth below the first 4 1/2 ft. of original grade. Maximum depth permitted for Dry Well is 12 1/2 ft. below original grade.

Place Dry Well - 110 ft. from rear lot line and 45' from right sideline as seen when facing lot from the front.

NOTE: ALL PIPE FROM HOUSE TO DRY WELL MUST BE CAST IRON.

PERMIT VOID AFTER THREE YEARS.

NOTE: INSTALL STAND PIPE ON SEPTIC TANK AND DRY WELL.


PLANS APPROVED BY Donald W. Monaghan

DATE 5-10-73

FILL SEPTIC TANK AND DISTRIBUTION BOX WITH WATER BEFORE CALLING FOR AN INSPECTION. COVER NO WORK UNTIL INSPECTED AND APPROVED.

NEITHER THE HOWARD COUNTY COMMISSIONERS NOR THE HEALTH DEPARTMENT IS RESPONSIBLE FOR THE SUCCESSFUL OPERATION OF ANY SYSTEM.

(7/9/72 this is a rear lot)
(of repair)
INSPECTOR
DATE SYSTEM APPROVED
17910
2/1/74

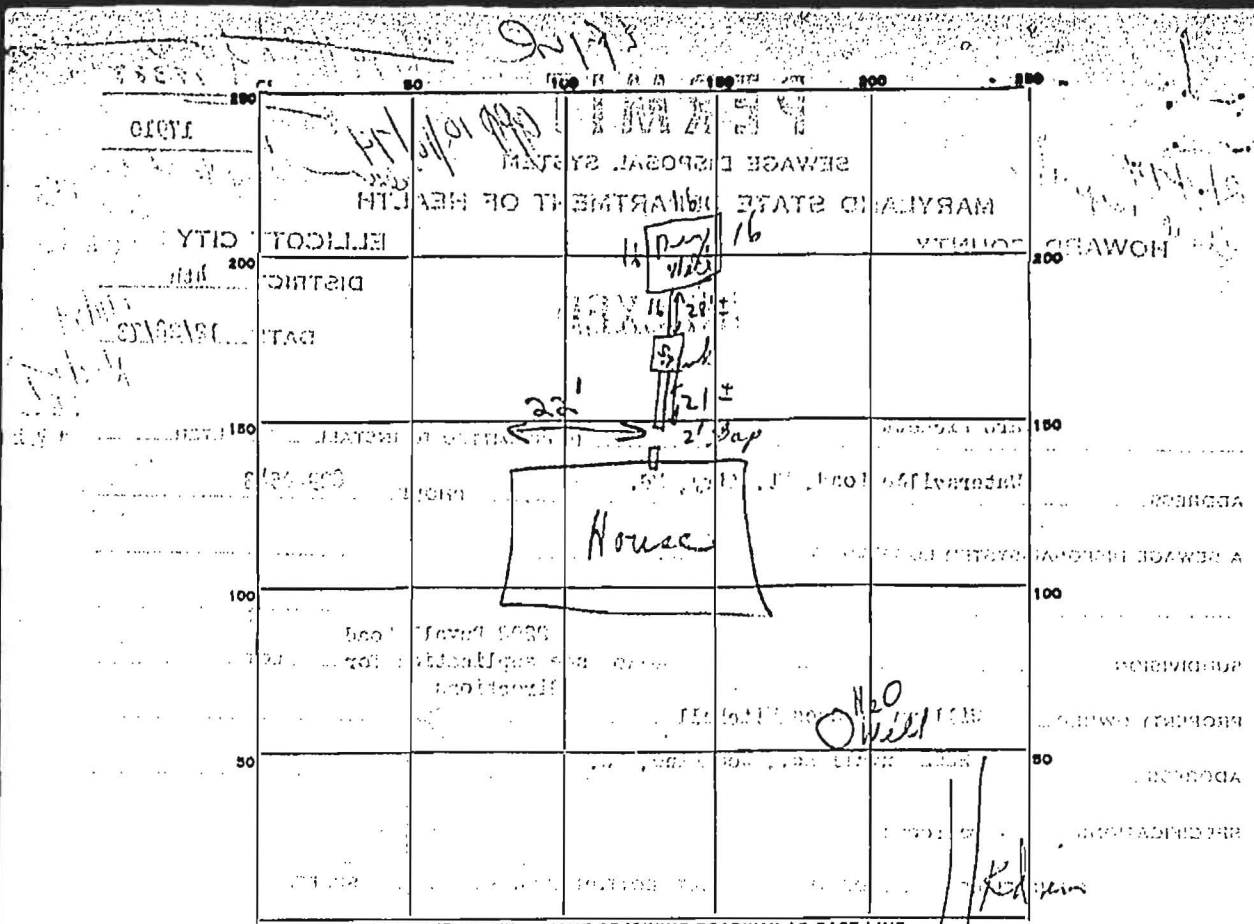

PERMIT CARD Yes S.P.T. / P.W.

SEPTIC TANK, LEVEL OK CLEANOUTS OK / OK

DISTRIBUTION BOX, LEVEL _____

TILE FIELD, DEPTH _____ FT. TRENCH WIDTH _____ FT.

GRAVEL DEPTH _____ IN. TOTAL LENGTH _____ FT.

NUMBER OF TRENCHES _____ TOTAL BOTTOM AREA _____

SEEPAGE PITS, INSIDE DIAMETER 6 1/2 FT. DEPTH BELOW INLET 8 FT.

ABSORBENT AREA 512 ± SQ. FT.

REMARKS: 2/1/74 Pipes from House not connected to pipe from Septic Tank. Hold for suspension. Help notes to call when pipe is connected from house to septic tank. CBS.

2/11/74 No changes CBS + H.Z. 10/7/74 Checked with Mrs. Mitchell she stated husband completed system and he is to write notes concerning same. H. Water rights.

DATE SYSTEM APPROVED 10/16/74 INSPECTOR [Signature]

Hold for letter CBS