
WATER WELL ABANDONMENT-SEALING REPORT FORM

SUBMIT COPIES OF COMPLETED FORM TO:

- * COUNTY ENVIRONMENTAL AGENCY (contact MDE, WMA if address needed)
- * WELL OWNER
- * MDE, WATER MANAGEMENT ADMINISTRATION, WELL PROGRAM

DATE WELL ABANDONED: Aug 13 2014 (month/day/year)

* PERMIT NUMBER OF ABANDONED WELL (if any)

* PERMIT NUMBER OF REPLACEMENT WELL:

* PERSON ABANDONING WELL: Ralph E Mayne WELL DRILLER'S LICENSE NUMBER: 117

CIRCLE: MWD / MSD / MGD

* OWNER'S NAME: Waverly Investment


* WELL LOCATION:

COUNTY: Howard
NEAREST TOWN: Clarksville Columbia Md
TAX MAP BLOCK PARCEL
SUBDIVISION: 2/A
SECTION: 2/A LOT: 2/A
STREET ADDRESS: 10437 CLARKSVILLE PIKE

LATITUDE 3 9 . 23545 -

LONGITUDE 7 6 . 87408 -

SITE LOCATION MAP

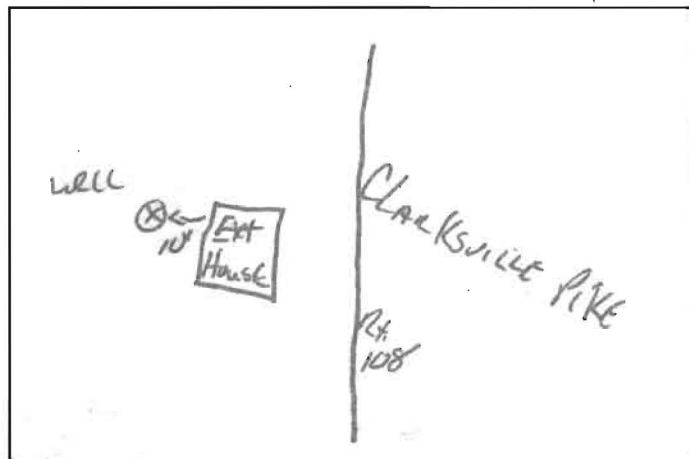

* TYPE OF WELL BEING ABANDONED:

☒ DRILLED ☐ JETTED
☐ BORED ☐ HAND DUG
☐ OTHER (specify)

* USE CODE: DOMESTIC

☐ IRRIGATION ☐ MUNICIPAL/PUBLIC
☐ TEST/OBSERVATION ☐ INDUSTRIAL
☐ ☐ GEOTHERMAL

* TYPE OF CASING:

☒ STEEL ☐ PLASTIC
☐ CONCRETE ☐ OTHER (specify)

SIZE OF CASING: 6 INCHES IN DIAMETER

DEPTH OF WELL: 42 FEET DEEP

WAS ANY CASING REMOVED? ☐ YES ☒ NO

If yes, length removed, in feet:

WAS CASING RIPPED OR PERFORATED? ☐ YES ☒ NO

LOG OF SEALING MATERIAL

MATERIAL	FEET	
	FROM	TO
<u>Cement</u>	<u>42</u>	<u>2</u>
<u>Top Soil</u>	<u>2</u>	<u>0</u>
VOLUME OF MATERIAL USED		
<u>15 bags cement</u>		