
 WATER WELL ABANDONMENT-SEALING REPORT FORM

SUBMIT COPIES OF COMPLETED FORM TO:

- * COUNTY ENVIRONMENTAL AGENCY (contact MDE, WMA if address needed)
- * WELL OWNER
- * MDE, WATER MANAGEMENT ADMINISTRATION, WELL PROGRAM

OK
 12/29/15 SC

DATE WELL ABANDONED: 12-23-14 (month/day/year) 21045

* PERMIT NUMBER OF ABANDONED WELL (if any) _____


* PERMIT NUMBER OF REPLACEMENT WELL: _____

* PERSON ABANDONING WELL: Aiken Crompton WELL DRILLER'S LICENSE NUMBER: 009
 CIRCLE: MWD / MSD / MGD

* OWNER'S NAME: William Nguyen

* WELL LOCATION:
 COUNTY: Howard
 NEAREST TOWN: Columbia
 TAX MAP 0031 BLOCK 0019 PARCEL 0619
 SUBDIVISION: Pfeiffer Corner
 SECTION: _____ LOT: _____
 STREET ADDRESS: 5620 Waterloo Rd

SITE LOCATION MAP

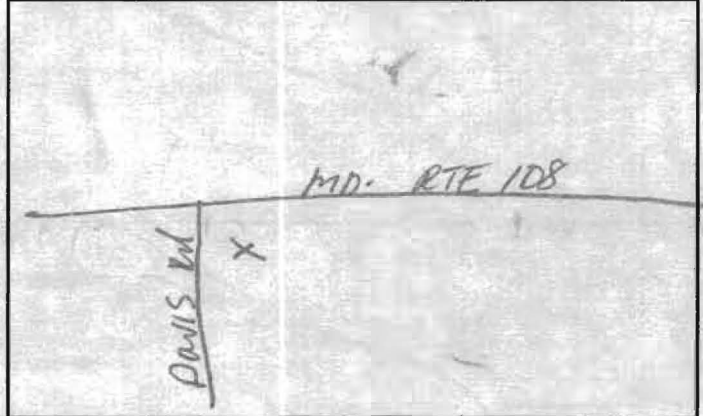

LATITUDE 3 9.217453
 LONGITUDE 7 6.807090

- * TYPE OF WELL BEING ABANDONED:
 DRILLED JETTED
 BORED HAND DUG
 OTHER (specify) _____

LOG OF SEALING MATERIAL

| MATERIAL | FEET | |
|---------------|-----------|-----------|
| | FROM | TO |
| <u>Cement</u> | <u>-6</u> | <u>95</u> |

- * USE CODE:
 DOMESTIC MUNICIPAL/PUBLIC
 IRRIGATION INDUSTRIAL
 TEST/OBSERVATION GEOTHERMAL

- * TYPE OF CASING:
 STEEL PLASTIC
 CONCRETE OTHER (specify) _____

SIZE OF CASING: _____ INCHES IN DIAMETER

DEPTH OF WELL: 95 FEET DEEP

WAS ANY CASING REMOVED? YES NO
 If yes, length removed, in feet: _____

WAS CASING RIPPED OR PERFORATED? YES NO

VOLUME OF MATERIAL USED

SIGNATURE-MASTER WELL DRILLER OR SUPERVISING SANITARIAN Aiken Crompton LICENSE# 009 MWD / MSD / MGS 12-23-14 DATE

COUNTY