

MARYLAND DEPARTMENT OF THE ENVIRONMENT, WATER MANAGEMENT ADMINISTRATION
1800 Washington Blvd., Baltimore, Maryland 21230 (410) 537-3784

WATER WELL ABANDONMENT-SEALING REPORT FORM

SUBMIT COPIES OF COMPLETED FORM TO:

- * COUNTY ENVIRONMENTAL AGENCY (contact MDE, WMA if address needed)
- * WELL OWNER
- * MDE, WATER MANAGEMENT ADMINISTRATION, WELL PROGRAM

OK
12/29/15 SC

DATE WELL ABANDONED: 3-12-13 (month/day/year)

* PERMIT NUMBER OF ABANDONED WELL (if any)

* PERMIT NUMBER OF REPLACEMENT WELL:

HO-95-0672

* PERSON ABANDONING WELL: Allen Compton

WELL DRILLER'S LICENSE NUMBER: 009

CIRCLE: MWD ~~MSD~~ ~~MGD~~

* OWNER'S NAME: Goodier Broker Homes

* WELL LOCATION:

SITE LOCATION MAP

COUNTY: Howard

NEAREST TOWN: Woodbine

TAX MAP BLOCK PARCEL


SUBDIVISION: Belle Haven

SECTION: 19 LOT: 19

STREET ADDRESS: 2819 Bridle Wreath Ct

LATITUDE 3

LONGITUDE 7

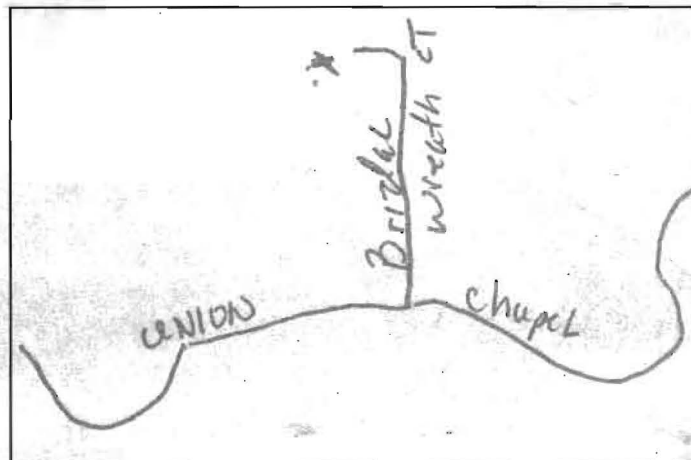

Allen Compton

* TYPE OF WELL BEING ABANDONED:

DRILLED JETTED
BORED HAND DUG
OTHER (specify)

LOG OF SEALING MATERIAL

* USE CODE: DOMESTIC

IRRIGATION MUNICIPAL/PUBLIC
TEST/OBSERVATION INDUSTRIAL
GEOTHERMAL

* TYPE OF CASING:

STEEL PLASTIC
CONCRETE OTHER (specify)

SIZE OF CASING: 6 INCHES IN DIAMETER

DEPTH OF WELL: 90 FEET DEEP

WAS ANY CASING REMOVED? YES ✓ NO

If yes, length removed, in feet: _____

WAS CASING RIPPED OR PERFORATED? YES ✓ NO

MATERIAL	FEET	
	FROM	TO
<u>Cement</u>	<u>-3</u>	<u>90</u>
VOLUME OF MATERIAL USED		
<u>2.5 yards</u>		

