
 WATER WELL ABANDONMENT-SEALING REPORT FORM

SUBMIT COPIES OF COMPLETED FORM TO:

- * COUNTY ENVIRONMENTAL AGENCY (contact MDE, WMA if address needed)
- * WELL OWNER
- * MDE, WATER MANAGEMENT ADMINISTRATION, WELL PROGRAM

OK
 12/19/08

DATE WELL ABANDONED: 8-28-12 (month/day/year)

* PERMIT NUMBER OF ABANDONED WELL (if any) _____

* PERMIT NUMBER OF REPLACEMENT WELL: _____

* PERSON ABANDONING WELL: George Ertzday WELL DRILLER'S LICENSE NUMBER: 040

* OWNER'S NAME: JOANNE ODEGARD CIRCLE: MWD MSD / MGD

* WELL LOCATION:

COUNTY: Howard

NEAREST TOWN: Glenely

TAX MAP _____ BLOCK 8 PARCEL _____

SUBDIVISION: _____


SECTION: _____ LOT: _____

STREET ADDRESS: 13176 Golly Quarter Rd

LATITUDE 39.266144

LONGITUDE 76.920647

SITE LOCATION MAP

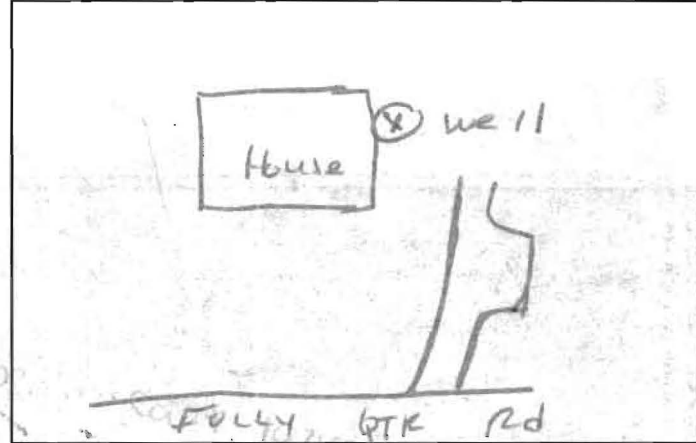

* TYPE OF WELL BEING ABANDONED:

- DRILLED
- JETTED
- BORED
- HAND DUG
- OTHER (specify) _____

LOG OF SEALING MATERIAL

* USE CODE: DOMESTIC

- IRRIGATION
- TEST/OBSERVATION
- MUNICIPAL/PUBLIC
- INDUSTRIAL
- GEOTHERMAL

* TYPE OF CASING:

- STEEL
- CONCRETE
- PLASTIC
- OTHER (specify) _____

SIZE OF CASING: _____ INCHES IN DIAMETER

DEPTH OF WELL: 10 FEET DEEP

WAS ANY CASING REMOVED? YES NO

If yes, length removed, in feet: _____

WAS CASING RIPPED OR PERFORATED? YES NO

MATERIAL	FEET	
	FROM	TO
concrete	10	2
DIRT	2	0
VOLUME OF MATERIAL USED		
<u>5 1/2 yds</u>		

COUNTY

